

BLACK HILLS POWER, INC.

TO

THE BANK OF NEW YORK MELLON,

As Trustee

---

SECOND  
SUPPLEMENTAL INDENTURE

Dated as of October 27, 2009

---

Supplemental to Restated and Amended  
Indenture of Mortgage and Deed of Trust  
Dated as of September 1, 1999

First Mortgage Bonds, 6.125%  
Series AF Due 2039

SECOND SUPPLEMENTAL INDENTURE, dated as of the 27<sup>th</sup> day of October, 2009, between Black Hills Power, Inc. (formerly known as Black Hills Corporation), a corporation duly organized and existing under the laws of the State of South Dakota (the "Company") and THE BANK OF NEW YORK MELLON, a corporation organized and existing under the laws of the State of New York, as Trustee under the Indenture hereinafter mentioned (the "Trustee").

WHEREAS, in order to secure an authorized issue of First Mortgage Bonds of the Company, the Company has executed and delivered a Restated and Amended Indenture of Mortgage and Deed of Trust to JPMorgan Chase Bank, N.A. (formerly known as The Chase Manhattan Bank), as Trustee (the successor of which is The Bank of New York Mellon), dated as of September 1, 1999, as supplemented and amended by a First Supplemental Indenture, dated as of August 13, 2002 (as so amended the "Indenture").

WHEREAS, pursuant to the provisions of the Indenture, First Mortgage Bonds are presently outstanding and continue to be secured by the Indenture as follows:

<u>Series</u>	<u>Principal Amount Outstanding</u>
Series Y, 9.49%, due June 15, 2018	\$ 2,520,000
Series Z, 9.35%, due May 29, 2021	19,980,000
Series AC, 8.06%, due February 1, 2010	30,000,000
Series AE, 7.23% due August 15, 2032	<u>75,000,000</u>
	\$127,500,000

; and

WHEREAS, as permitted by the Indenture, the Company, by resolutions of its Board of Directors duly adopted, has determined to create a new series of bonds to be known as its "First Mortgage Bonds, 6.125% Series AF Due 2039" (herein called the "Series AF Bonds"), to be initially authenticated and delivered in the aggregate principal amount of \$180,000,000 in the form, having the characteristics and being entitled to the benefits as in the Indenture or as in this Supplemental Indenture provided; and

WHEREAS, the Company, in exercise of the powers and authority conferred upon and reserved to it under and by virtue of the provisions of the Indenture, and particularly the provisions contained in Articles Two and Sixteen thereof, and pursuant to appropriate resolutions of its Board of Directors, has duly resolved and determined to make, execute and deliver to the Trustee a Second Supplemental Indenture in the form hereof (herein sometimes referred to as "this Supplemental Indenture") for the purposes herein provided; and

WHEREAS, all conditions and requirements necessary to make this Supplemental Indenture a valid, binding and legal instrument in accordance with its terms have been done, performed and fulfilled, and the execution and delivery hereof have been in all respects duly authorized;

NOW THEREFORE, in consideration of the premises and of one dollar to it duly paid by the Trustee at or before the ensembling and delivery of these presents, the receipt whereof is hereby acknowledged, and of other good and valuable consideration, in order to establish the terms of the Series AF Bonds, the Company hereby further covenants and agrees to and with the Trustee and its successors in the trust under the Indenture for the benefit of all those who shall from time to time hold the Series AF Bonds as follows:

The Company does hereby ratify and confirm its Mortgage and Pledge to the Trustee of all property described in the Indenture and does hereby grant, bargain, sell, release, convey, assign, transfer, mortgage, pledge and set over unto the Trustee, and to its successors and assigns forever, the property described in Annex A to this Supplemental Indenture acquired by the Company and not specifically described under the Indenture which property shall be incorporated into the terms of Exhibit A to the Indenture as if more fully set forth therein.

## ARTICLE ONE

### DEFINITIONS

SECTION 1.01. General. For all purposes of this Supplemental Indenture:

(a) capitalized terms used herein without definition shall have the meanings specified in the Indenture;

(b) all references herein to Articles and Sections, unless otherwise specified, refer to the corresponding Articles and Sections of this Supplemental Indenture;

(c) the terms "herein," "hereof," "hereunder" and other words of similar import refer to this Supplemental Indenture; and

(d) in the event of a conflict between any definition set forth in the Indenture and any definition set forth in this Supplemental Indenture, the definition set forth in this Supplemental Indenture shall control.

SECTION 1.02. Definitions. The following definitions shall apply to this Supplemental Indenture:

"Business Day" means any day other than a Saturday or Sunday and other than a day on which banking institutions in Rapid City, South Dakota, or New York, New York, are authorized or obligated by law or executive order to close.

"Comparable Treasury Issue" means the United States Treasury security selected by an Independent Investment Banker as having a maturity comparable to the remaining term of the Series AF Bonds to be redeemed that would be utilized, at the time of selection and in accordance with customary financial practice, in pricing new issues of corporate debt securities of comparable maturity to the remaining term of the Series AF Bonds.

"Comparable Treasury Price" means the average of two Reference Treasury Dealer Quotations obtained with respect to any redemption date.

"Depository" means The Depository Trust Company, a New York corporation, or any successor thereto.

"Global Bond" shall have the meaning set forth in Section 2.05(a) hereof.

"Independent Investment Banker" means RBC Capital Markets Corporation, RBS Securities Inc. or one of the Reference Treasury Dealers appointed by the Company.

"Reference Treasury Dealer" means RBC Capital Markets Corporation, RBS Securities Inc. and their successors; provided, however, that if RBC Capital Markets Corporation, RBS Securities Inc. or any of their successors shall cease to be a primary United States government securities dealer (a "Primary Treasury Dealer"), the Company will substitute for it another nationally recognized investment bank that is a Primary Treasury Dealer.

"Reference Treasury Dealer Quotations" means, with respect to each Reference Treasury Dealer and any redemption date, the average, as determined by the Independent Investment Banker, of the bid and asked prices for the Comparable Treasury Issue (expressed in each case as a percentage of its principal amount) quoted in writing to the Independent Investment Banker at 5:00 p.m., New York City time, on the third Business Day preceding such redemption date.

"Treasury Rate" means, for any redemption date, (i) the yield, under the heading which represents the average for the immediately preceding week, appearing in the most recently published statistical release designated "H.15(519)" or any successor publication which is published weekly by the Board of Governors of the Federal Reserve System and which establishes yields on actively traded United States Treasury securities adjusted to constant maturity under the caption "Treasury Constant Maturities," for the maturity corresponding to the Comparable Treasury Issue (if no maturity is within three months before or after the remaining term of the Series AF Bonds, yields for the two published maturities most closely corresponding to the Comparable Treasury Issue shall be determined and the Treasury Rate shall be interpolated or extrapolated from such yields on a straight line basis, rounding to the nearest month) or (ii) if such release (or any successor release) is not published during the week preceding the calculation date or does not contain such yields, the rate per annum equal to the semiannual equivalent yield to maturity of the Comparable Treasury Issue, calculated using a price for the Comparable Treasury Issue (expressed as a percentage of its principal amount) equal to the Comparable Treasury Price. The Treasury Rate shall be calculated on the third Business Day preceding the redemption date.

## ARTICLE TWO

### TERMS AND CONDITIONS OF SERIES AF BONDS

#### SECTION 2.01. General.

(a) There is hereby created a series of Bonds, known as and entitled "First Mortgage Bonds, 6.125% Series AF Due 2039," and the form thereof shall be as provided in this Supplemental Indenture.

(b) The aggregate principal amount of Series AF Bonds which may be authenticated and delivered and outstanding under the Indenture and this Supplemental Indenture shall be limited in aggregate principal amount to \$180,000,000, except as provided under Section 2.02 of the Indenture. The Series AF Bonds shall bear interest at the rate of 6.125% per annum until the principal thereof becomes due and payable and shall bear interest on overdue principal (including any overdue mandatory prepayment of principal) and premium, if any, and (to the extent legally enforceable) on any overdue installment of interest at the rate of 7.125% per annum until such overdue principal, premium or interest shall be paid. The Series AF Bonds shall mature November 1, 2039.

(c) The Series AF Bonds shall be registered Bonds without coupons in denominations of \$100,000 and any multiples of \$1,000 which may be executed by the Company and delivered to the Trustee for authentication and delivery. The date of commencement of the first interest period for the Series AF Bonds shall be the date of initial authentication and delivery thereof. The Series AF Bonds shall be dated as provided in Section 2.06 of the Indenture. All Series AF Bonds shall bear interest from their respective issue dates. The principal and interest shall be due and payable as provided in the Bond form set forth in Section 2.02 of this Supplemental Indenture. The principal of, premium, if any, and interest on the Series AF Bonds shall be payable at the principal corporate trust office of the Trustee, in the Borough of Manhattan, The City of New York, in any coin or currency of the United States of America which at the time of payment shall be legal tender for the payment of public and private debts. The Series AF Bonds shall be subject to redemption only as provided in Section 2.03 of this Supplemental Indenture and Section 8.08 of the Indenture.

(d) Without limiting the other indemnities provided to the Trustee, the Company shall indemnify and save the Trustee harmless from any liabilities and costs incurred by the Trustee arising out of the making of the final payment when due of the principal owing on any of the Series AF Bonds without the surrender of such Bond to the Trustee.

(e) The Trustee is hereby appointed Registrar in respect of the Series AF Bonds, and the principal corporate trust office of the Trustee in the Borough of Manhattan, The City of New York, is hereby designated as the office or agency of the Company in said Borough where notices or demands in respect of Series AF Bonds may be served.

SECTION 2.02. Form of Bonds. The text of the Series AF Bonds, and the certificate of authentication of the Trustee to be executed thereon, are to be substantially in the following forms, respectively:

[FORM OF GLOBAL BOND]

Unless this Bond is presented by an authorized representative of The Depository Trust Company, a New York corporation ("DTC"), to the issuer or its agent for registration of transfer, exchange or payment, and any Bond issued is registered in the name of Cede & Co. or in such other name as is requested by an authorized representative of DTC (and any payment is made to Cede & Co. or to such other entity as is requested by an authorized representative of DTC), ANY TRANSFER, PLEDGE OR OTHER USE HEREOF FOR VALUE OR OTHERWISE BY OR TO ANY PERSON IS WRONGFUL inasmuch as the registered owner hereof, Cede & Co., has an interest herein.

Unless and until it is exchanged in whole or in part for Bonds in definitive registered form, this Bond may not be transferred except as a whole by the Depository to the nominee of the Depository or by a nominee of the Depository to the Depository or another nominee of the Depository or by the Depository or any such nominee to a successor Depository or a nominee of such successor Depository.

No. \_\_\_\_\_  
CUSIP No. 092114 AB3

\$180,000,000

BLACK HILLS POWER, INC.

FIRST MORTGAGE BOND, 6.125%  
SERIES AF DUE 2039

BLACK HILLS POWER, INC. (hereinafter called the "Company"), a corporation organized and existing under the laws of the State of South Dakota, for value received, hereby promises to pay to CEDE & CO., or registered assigns, on the 1st day of November, 2039, at the principal corporate trust office of the Trustee, in the Borough of Manhattan, The City of New York, ONE HUNDRED AND EIGHTY MILLION DOLLARS, in any coin or currency of the United States of America which at the time of payment shall be legal tender for the payment of public and private debts, and to pay interest thereon from the date hereof, at the rate of 6.125 percent, per annum (computed on the basis of a 360-day year of 12 thirty-day months), payable at said principal office of the Trustee in like coin or currency semi-annually on May 1 and November 1 in each year until the principal hereof shall have become due and payable, and thereafter if default be made in the payment of such principal and premium, if any, and on any overdue installment of interest, at the rate of 7.125 percent, per annum until the overdue principal, premium or interest shall be paid.

This Bond shall not be valid or become obligatory for any purpose until the certificate of authentication hereon shall have been signed by the Trustee, or its successor as Trustee, under the Indenture.

This Bond is one of an authorized issue of Bonds of the Company known as its "First Mortgage Bonds," issued and to be issued in one or more series under, and all equally and ratably secured (except as any sinking, amortization, improvement, renewal or other analogous fund, established in accordance with the provisions of the Indenture hereinafter mentioned, may afford additional security for the Bonds of any particular series) by a Restated and Amended Indenture of Mortgage and Deed of Trust, dated as of September 1, 1999, executed by the Company to JPMorgan Chase Bank, N.A. (formerly known as The Chase Manhattan Bank), as Trustee (the successor to which is The Bank of New York Mellon), as supplemented and amended by a First Supplemental Indenture, dated as of August 13, 2002 and as supplemented and amended by a Second Supplemental Indenture, dated as of October 27, 2009 (said Restated Indenture as so supplemented and amended being hereinafter collectively called the "Indenture"), to which Indenture and all further instruments supplemental thereto reference is hereby made for a description of the properties mortgaged and pledged, the nature and extent of the security, the rights of the holders of said Bonds and the coupons appurtenant to coupon Bonds, if any, and of the Trustee and of the Company in respect of such security, and the terms and conditions upon which said Bonds are and are to be issued and secured.

To the extent permitted by the Indenture and as provided therein, with the consent of the Company and upon the written consent or affirmative vote of at least sixty-six and two-thirds percent in principal amount of the Bonds then outstanding and entitled to consent, and of not less than sixty-six and two-third percent, in principal amount of the Bonds then outstanding and entitled to consent of each series affected thereby in case one or more but less than all of the series of Bonds issued under the Indenture are so affected, the rights and obligations of the Company and of the holders of Bonds and coupons appurtenant to coupon Bonds, if any, and the terms and provisions of the Indenture and of any instrument supplemental thereto may be modified from time to time, provided that no such modification or alteration shall be made which would postpone the date fixed herein or in the Indenture for the payment of the principal of, or any installment of interest on, the Bonds, or reduce the principal of, or the rate of interest payable on, the Bonds, or reduce the percentage of the principal amount of Bonds the consent of which is required for the authorization of any such modification or alteration, without the consent of all of the holders affected thereby. The rights, duties or immunities of the Trustee shall not be modified without the written consent of the Trustee.

As provided in the Indenture, said Bonds are issuable in series which may vary as in the Indenture provided or permitted. This Bond is one of a series of Bonds authorized by the Second Supplemental Indenture and entitled "First Mortgage Bonds, 6.125% Series AF Due 2039" (the "Series AF Bonds").

Pursuant to the provisions of Section 8.05 of the Indenture, the Company may request the Trustee to apply moneys deposited with the Trustee ("Trust Moneys") for various reasons toward the redemption of those Bonds, including payment of premium and accrued interest, selected by the Company. In the Second Supplemental Indenture, the Company has covenanted that the Bonds may only be called for redemption by the Company, as a whole at any time or in part from time to time, at a redemption price equal to the greater of (i) 100% of the principal amount of Series AF Bonds to be redeemed or (ii) the sum of the present values of the remaining scheduled payments of principal and interest thereon (exclusive of interest accrued to the date of redemption) discounted, at the then current Treasury Rate (as defined in the

Supplemental Indenture) plus 25 basis points, to the date of redemption on a semiannual basis (assuming a 360-day year consisting of twelve 30-day months) plus in each case, accrued and unpaid interest on the principal amount being redeemed to the date of redemption.

Notice of each redemption shall be mailed to all registered owners not less than thirty nor more than fifty days before the redemption date.

Pursuant to the provisions of Section 8.08 of the Indenture, the Series AF Bonds are further subject to redemption, in whole or in part, by the Trustee applying certain Trust Moneys which have been held by the Trustee for a period of over two years. Any such redemption is made pro rata among the series of Bonds then outstanding in the ratio of principal amount. Redemption is at 100 percent of principal, plus any premium due at the time of redemption and accrued interest to the redemption date.

If this Bond or any portion thereof (\$1,000 or a multiple) shall be duly called for redemption as provided in the Indenture, this Bond or such portion thereof shall (unless the Company shall default in the payment of the redemption price) cease to bear interest from and after the date fixed for redemption.

Upon any partial redemption of this Bond, this Bond may, at the option of the registered holder hereof, be either (a) surrendered to the Trustee in exchange for one or more new Series AF Bonds for the principal amount of the unredeemed portion of this Bond or (b) submitted to the Trustee for notation hereon by the Trustee of the payment of the portion of the principal hereof so called for redemption.

If an Event of Default, as defined in the Indenture, shall occur, the principal of this Bond may become or be declared due and payable, in the manner and with the effect provided in the Indenture.

A certificate in global form representing all or a portion of the Bonds may not be transferred except as a whole by the Depository for such series to a nominee of such Depository or by a nominee of such Depository to such Depository or another nominee of such Depository or by such Depository or any such nominee to a successor Depository for such Bonds or a nominee of such successor Depository.

The Series AF Bonds are issuable as fully registered Bonds without coupons of the denominations of \$100,000 and any multiple of \$1,000 which may be executed by the Company and delivered to the Trustee for authentication and delivery. The Series AF Bonds, upon surrender thereof to the Trustee at its principal corporate trust office in the Borough of Manhattan, The City of New York, are exchangeable for other Bonds of the same series in such authorized denomination or denominations in the same aggregate principal amount, as may be requested by the holders surrendering the same.

The Company and the Trustee may deem and treat the person in whose name this Bond is registered as the absolute owner hereof, for the purpose of receiving payment of or on account of the principal hereof and interest due hereon, and neither the Company nor the Trustee shall be affected by any notice to the contrary. Interest payable herein shall be paid to the person in whose name the Bond is registered at the close of business on the April 15 or October 15



(whether or not on a business day) next preceding the interest payment date, except for defaulted interest and unmatured accrued interest on the Series AF Bonds called for redemption on a date other than an interest payment date.

No recourse shall be had for the payment of the principal of or the interest on this Bond, or for any claim based hereon or otherwise in respect hereof or of the Indenture or of any indenture supplemental thereto, against any incorporator, stockholder, director or officer, as such, past, present or future, of the Company or of any predecessor or successor corporation, either directly or through the Company or any predecessor or successor corporation, whether by virtue of any constitution, statute or rule of law, or by the enforcement of any assessment or penalty or by any legal or equitable proceeding or otherwise howsoever; all such liability being, by the acceptance hereof and as a part of the consideration for the issuance hereof, expressly waived and released by every holder hereof, as more fully provided in the Indenture; provided, however, that nothing herein or in the Indenture contained shall be taken to prevent recourse to and the enforcement of the liability, if any, of any shareholder or any stockholder or subscriber to capital stock upon or in respect of shares of capital stock not fully paid up.

IN WITNESS WHEREOF, the Company has caused this Bond to be signed in its name by its President or one of its Vice Presidents, and its corporate seal to be impressed or imprinted hereon and attested by its Secretary or one of its Assistant Secretaries.

Dated:

BLACK HILLS POWER, INC.

By: \_\_\_\_\_  
Name:  
Title:

ATTEST:

\_\_\_\_\_  
Secretary

(TRUSTEE'S CERTIFICATE OF AUTHENTICATION)

This is one of the Bonds, of the series designated therein, described in the within mentioned Indenture.

THE BANK OF NEW YORK MELLON, as  
Trustee

By: \_\_\_\_\_  
Authorized Signatory

SECTION 2.03. Optional Redemption.

(a) Notwithstanding the provisions of Section 8.05 of the Indenture, the Series AF Bonds, upon the mailing of notice and in the manner provided in Section 10.03 of the Indenture, shall be redeemable at the option of the Company, as a whole at any time or in part from time to time, at a redemption price equal to the greater of (i) 100% of the principal amount of Series AF Bonds to be redeemed or (ii) the sum of the present values of the remaining scheduled payments of principal and interest thereon (exclusive of interest accrued to the date of redemption) discounted, at the then current Treasury Rate plus 25 basis points, to the date of redemption on a semiannual basis (assuming a 360-day year consisting of twelve 30-day months) plus in each case, accrued and unpaid interest on the principal amount being redeemed to the date of redemption.

(b) Notwithstanding the provisions of Section 10.03 of the Indenture, in case of the redemption at any time of less than all the outstanding Series AF Bonds, the particular Bonds or parts thereof to be redeemed shall be selected by the Trustee from the outstanding Series AF Bonds not previously called for redemption as nearly as practicable pro rata among the registered holders of the Series AF Bonds according to the respective principal amounts of such Bonds, provided that the portions of the principal of Series AF Bonds at any time so selected for redemption in part shall be equal to \$1,000 or a multiple thereof. In connection with any such pro rata selection, the Trustee may make such adjustments upwards or downwards by no more than \$1,000 such that the Series AF Bonds shall be redeemed in authorized denominations, provided, further, that notwithstanding the foregoing provisions for pro rata selection of Series AF Bonds for redemption, beneficial interests in the Series AF Bonds evidenced by a Global Bond (as defined in Section 2.05(a)) may be selected for redemption by the Depositary in accordance with its procedures therefor, which may provide for the use of an impartial lottery.

(c) Notwithstanding that Section 8.05 of the Indenture authorizes the Company to request the Trustee to apply Trust Moneys toward the redemption of Bonds to be selected by the Company, the Company does hereby covenant that the Company will not request the Trustee to apply any Trust Moneys to the redemption of the Series AF Bonds except pursuant to Section 2.03(a) of this Supplemental Indenture.

(d) Notwithstanding anything to the contrary contained in Section 10.03 of the Indenture, the notice of the foregoing redemption need not set forth the redemption price but only the manner of calculation thereof. The Company shall give the Trustee written notice of such redemption price promptly after the calculation thereof and the Trustee shall have no responsibility for such calculation.

SECTION 2.04. No Sinking Fund. The Series AF Bonds are not entitled to the benefit of any sinking fund.

SECTION 2.05. Bonds to be Issued in Global Form.

(a) The Series AF Bonds will be initially represented by one or more Bonds in global form (the "Global Bonds"). The Company hereby designates The Depository Trust Company as the initial Depository for the Global Bonds. The Global Bonds will be deposited with the Trustee, as custodian for the Depository. Unless and until it is exchanged in whole or in part for Bonds in certificated form, the Global Bonds may not be transferred except as a whole by the Depository to a nominee of the Depository or by a nominee of the Depository to the Depository or another nominee of the Depository or by the Depository or any such nominee to a successor Depository for the Bonds or a nominee of such successor Depository. The Depository may surrender the Global Bonds in exchange in whole or in part for Bonds in certificated form on such terms as are acceptable to the Company and the Depository.

(b) If at any time the Depository for the Global Bonds notifies the Company that it is unwilling or unable to continue as Depository for such Global Bonds or if at any time the Depository for the Series AF Bonds shall no longer be eligible or in good standing under the Securities Exchange Act of 1934, as amended, or other applicable statute or regulation, the Company shall appoint a successor Depository with respect to such Global Bonds. If a successor Depository for such Global Bonds is not appointed by the Company within 90 days after the Company receives such notice or becomes aware of such ineligibility, the Series AF Bonds shall no longer be represented by Global Bonds and, subject to Section 2.07 of the Indenture, the Company will execute, and the Trustee, upon receipt of a Written Order of the Company for the authentication and delivery of individual Bonds in exchange for such Global Bonds, will authenticate and deliver individual Bonds of like tenor and terms in definitive form in an aggregate principal amount equal to the principal amount of such Global Bonds in exchange for such Global Bonds.

(c) Subject to the procedures of the Depository, the Company may at any time and in its sole discretion determine that the Series AF Bonds issued or issuable in the form of one or more Global Bonds shall no longer be represented by such Global Bond or Bonds. In such event, subject to Section 2.07 of the Indenture and to such procedures, the Company will execute, and the Trustee, upon receipt of a Written Order of the Company for the authentication and delivery of individual Bonds in exchange in whole or in part for such Global Bonds, will authenticate and deliver individual Bonds of like tenor and terms in definitive form in an aggregate principal amount equal to the principal amount of such Global Bonds in exchange for such Global Bonds.

(d) In any exchange provided for in Section 2.05(b) or (c), the Company will execute and the Trustee will authenticate and deliver individual Bonds in definitive registered form in authorized denominations. Upon the exchange of Global Bonds for individual Bonds, such Global Bonds shall be canceled by the Trustee. Series AF Bonds issued in exchange for Global Bonds pursuant to this Section 2.05 shall be registered in such names and in such authorized denominations as the Depository for such Global Bonds, pursuant to instructions from its direct or indirect participants or otherwise, shall instruct the Trustee. The Trustee shall deliver such Bonds to the Persons in whose names such Bonds are so registered.

(e) Neither the Company, the Trustee nor any agent of the Company or the Trustee shall have any responsibility or liability for any aspect of the records relating to or payments

made on account of beneficial ownership interests in a Global Bond or for maintaining, supervising or reviewing any records relating to such beneficial ownership interests.

## ARTICLE THREE

### MISCELLANEOUS

SECTION 3.01. Outstanding Bonds. The aggregate principal amount of Bonds which, immediately after the authentication and delivery of the Series AF Bonds to be issued under this Supplemental Indenture, will be outstanding under the provisions of, and secured by, the Indenture, as amended by this Supplemental Indenture, will be \$307,500,000, consisting of \$127,500,000 aggregate principal amount of the Bonds of Series Y, Z, AC and AE hereinbefore set forth in the second recital of this Supplemental Indenture and \$180,000,000 aggregate principal amount of Series AF Bonds hereby created.

SECTION 3.02. Receipt of Supplemental Indenture. The Company, by the execution hereof, acknowledges that a true copy of this Supplemental Indenture has been delivered to and received by it.

SECTION 3.03. Ratification of Indenture. Except as amended by this Supplemental Indenture, all the provisions, terms and conditions of the Indenture shall continue in full force and effect. The Company does hereby ratify and confirm its mortgage and pledge to the Trustee of that property, real, personal and mixed described in the Indenture as being subject to the Lien of the Indenture.

SECTION 3.04. Sufficiency of Supplemental Indenture. The Trustee makes no representation as to the validity or sufficiency of this Supplemental Indenture.

SECTION 3.05. Counterparts. This Supplemental Indenture may be executed in several counterparts, all or any of which may be treated for all purposes as one original and shall constitute and be one and the same instrument.

SECTION 3.06. Governing Law. This Supplemental Indenture and each Series AF Bond shall be governed by and construed in accordance with the laws of the State of South Dakota without regard to the choice of law principles thereof. Notwithstanding the foregoing, the immunities and standard of care of the Trustee, Registrar and paying agent in connection with the administration of trusts and duties hereunder shall be governed by and construed in accordance with the laws of the State of New York.

IN WITNESS WHEREOF, BLACK HILLS POWER, INC. has caused this Supplemental Indenture to be executed on its behalf by its Chairman of the Board or its President or one of its Vice Presidents and its corporate seal to be hereto affixed and to be attested by its Secretary or an Assistant Secretary, and THE BANK OF NEW YORK MELLON, in evidence of its acceptance of the trust hereby created, has caused this Supplemental Indenture to be executed on its behalf by one of its Vice Presidents or Assistant Vice Presidents and its corporate seal to be hereto affixed and to be attested by one of its Vice Presidents, all as of the day and year first above written.

BLACK HILLS POWER, INC.

By: David R. Emery  
Name: David R. Emery  
Title: Chairman & CEO

ATTEST  
William D. Bushon  
Secretary

Signed, sealed and delivered by  
BLACK HILLS POWER, INC.  
in the presence of:

Lucretia Steckler  
Lishi Hartwell

THE BANK OF NEW YORK MELLON, as  
Trustee

By: \_\_\_\_\_  
Name:  
Title:

ATTEST:  
\_\_\_\_\_

Signed, sealed and delivered by  
THE BANK OF NEW YORK MELLON, as Trustee  
in the presence of:

\_\_\_\_\_  
\_\_\_\_\_

BLACK HILLS POWER, INC.

By: \_\_\_\_\_  
Name:  
Title:


ATTEST:

\_\_\_\_\_  
Secretary

Signed, sealed and delivered by  
BLACK HILLS POWER, INC.  
in the presence of:



\_\_\_\_\_  
\_\_\_\_\_

THE BANK OF NEW YORK MELLON, as  
Trustee

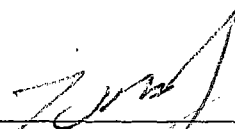By:   
Name: LAURENCE J. O'BRIEN  
Title: VICE PRESIDENT

ATTEST:  
  
CHRISTOPHER GREENE  
VICE PRESIDENT

Signed, sealed and delivered by  
THE BANK OF NEW YORK MELLON, as Trustee  
in the presence of:

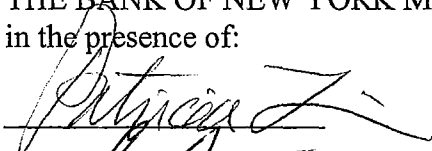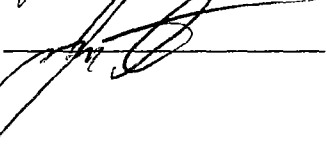  
\_\_\_\_\_  
  
\_\_\_\_\_

STATE OF SOUTH DAKOTA     )  
   ) ss.:  
 COUNTY OF PENNINGTON     )

On this 27<sup>th</sup> day of October, 2009, before me, LeeAnn Steckler, the undersigned officer, personally appeared David R. Emery, to me personally known, who acknowledged himself to be, and being by me duly sworn, did say that he is the Chairman and Chief Executive Officer of BLACK HILLS POWER, INC., a corporation, and that the seal affixed to the foregoing instrument is the corporate seal of said corporation and that said instrument was executed by, and signed in the name of, the corporation, by him, as such Chairman and Chief Executive Officer and sealed on behalf of the corporation by authority of its Board of Directors for the purposes therein contained, and the said David R. Emery acknowledged the same as the free act and deed of said corporation.

IN WITNESS WHEREOF, I hereunto set my hand and official seal.



*LeeAnn Steckler*  
 \_\_\_\_\_  
 Notary Public  
 My Commission expires 06-23-2011

STATE OF NEW YORK     )  
   ) ss.:  
 COUNTY OF NEW YORK     )

On this \_\_\_\_ day of October, 2009, before me, Carlos Luciano, the undersigned officer, personally appeared Laurence J. O'Brien, to me personally known, who acknowledged himself to be, and being by me duly sworn, did say that he is a Vice President of THE BANK OF NEW YORK MELLON, a corporation, and that the seal affixed to the foregoing instrument is the corporate seal of said corporation and that said instrument was executed by, and signed in the name of, the corporation, by him, as such Vice President, and sealed on behalf of the corporation by authority of its Board of Directors for the purposes therein contained, and the said Laurence J. O'Brien acknowledged the same as the free act and deed of said corporation.

IN WITNESS WHEREOF, I hereunto set my hand and official seal.

[Notarial Seal]

STATE OF SOUTH DAKOTA     )  
  ) ss.:  
COUNTY OF PENNINGTON     )

On this \_\_\_\_ day of October, 2009, before me, LeeAnn Steckler, the undersigned officer, personally appeared David R. Emery, to me personally known, who acknowledged himself to be, and being by me duly sworn, did say that he is the Chairman and Chief Executive Officer of BLACK HILLS POWER, INC., a corporation, and that the seal affixed to the foregoing instrument is the corporate seal of said corporation and that said instrument was executed by, and signed in the name of, the corporation, by him, as such Chairman and Chief Executive Officer and sealed on behalf of the corporation by authority of its Board of Directors for the purposes therein contained, and the said David R. Emery acknowledged the same as the free act and deed of said corporation.

IN WITNESS WHEREOF, I hereunto set my hand and official seal.

[Notarial Seal]

\_\_\_\_\_  
Notary Public  
My Commission expires \_\_\_\_\_

STATE OF NEW YORK     )  
  ) ss.:  
COUNTY OF NEW YORK     )

On this 27<sup>th</sup> day of October, 2009, before me, Carlos Luciano, the undersigned officer, personally appeared Laurence J. O'Brien, to me personally known, who acknowledged himself to be, and being by me duly sworn, did say that he is a Vice President of THE BANK OF NEW YORK MELLON, a corporation, and that the seal affixed to the foregoing instrument is the corporate seal of said corporation and that said instrument was executed by, and signed in the name of, the corporation, by him, as such Vice President, and sealed on behalf of the corporation by authority of its Board of Directors for the purposes therein contained, and the said Laurence J. O'Brien acknowledged the same as the free act and deed of said corporation.

IN WITNESS WHEREOF, I hereunto set my hand and official seal.

[Notarial Seal]

*Carlos R. Luciano*  
CARLOS R. LUCIANO  
Notary Public, State of New York  
No. 41-4765897  
Qualified in Queens County  
Commission Expires April 30, 2010



ANNEX A TO SECOND  
SUPPLEMENTAL INDENTURE

LEGAL DESCRIPTIONS OF REAL PROPERTY

LANDS IN PENNINGTON COUNTY, SOUTH DAKOTA

1. That portion of the Northwest Quarter of the Southwest Quarter (NW1/4SW 1/4) of Section 24 in Township 1 North of Range 7 East of the Black Hills Meridian, in the City of Rapid City, Pennington County, South Dakota, lying south of Lot H1, as shown on the plat filed in Highway Plat Book 6, Page 11; and
2. The Southwest Quarter of the Southwest Quarter (SW1/4SW1/4) of Section 24 in Township 1 North of Range 7 East of the Black Hills Meridian, in the City of Rapid City, Pennington County, South Dakota; EXCEPTING therefrom Highway 16 Bypass; ALSO EXCEPTING therefrom Lot H1, as shown on the plat filed in Highway Plat Book 6, Page 22; AND EXCEPTING therefrom Lot H2, as shown on the plat filed in Highway Plat Book 11, Page 129.

LANDS IN MEADE COUNTY, SOUTH DAKOTA

1. B.H.P. & L. Utility Lot, formerly a portion of Lot 4 of the NE1/4SE1/4 of Section 36 in Township 5 North of Range 5 East of the Black Hills Meridian, Meade County, South Dakota, as shown on the plat filed in Plat Book 20, Page 243.
2. Piedmont Valley Substation Lot, a portion of Lot 8, Blk 1, Cooper's Subdivision, located in the (NW1/4NE1/4) of section 15 in Township 3 North of Range 6 East of the Black Hills Meridian, Meade County, South Dakota, as shown on the plat filed in Plat Book 20, Page 53.
3. Lot B of Lot 3 Lot MK-4 Brink Addition to the City of Sturgis, located in the SW1/4SE1/4 of Section 5 in Township 5 North of Range 5 East of the Black Hills Meridian, Meade County, South Dakota, as shown by the plat filed in Plat Book 20, Page 175.

LANDS IN BUTTE COUNTY, SOUTH DAKOTA

1. Tract C, Tract D and Tract E, located in the Southeast Quarter (SE 1/4) of Section 10, Township 8 North, Range 2 East of the Black Hills Meridian, City of Belle Fourche, Butte County, South Dakota, as shown on the plat recorded in Plat Book 5, page 18;

EXCEPTING therefrom that part of Tract C and Tract D deeded to Floyd Cooper in instrument recorded December 22, 1949, in Book 137, Page 137; AND EXCEPTING therefrom that part of Tract C deeded to Alber W. Turbiville and Alice L. Turbiville in instrument recorded October 24, 1961, in Book 156, Page 585.

#### LANDS IN FALL RIVER COUNTY, SOUTH DAKOTA

1. Tract Minnekahta Substation, together with a private access easement, located in the Northeast Quarter (NE1/4) of Section 18 Township 7 South Range 4 East of the Black Hills Meridian, Fall River County, South Dakota, as shown on the plat recorded in Book 22 of Plats, Page 83.

#### LANDS IN WESTON COUNTY, WYOMING



1. A Tract of land which lays in the SWNE of Section 29, Township 45 North, Range 61 West in Weston County, Wyoming, Tax Parcel ID 2856, more particularly described as follows: commencing at the NW corner of Block 11, original City of Newcastle; thence South 60° 53' 15" West for a distance of 680 ft to the railroad property boundary, thence North 29° 06' 45" West for a distance of 20 ft, thence North 00° 07' 25" West for 92.11 ft to the North side of West Main Street, thence North 60° 53' 15" East for 227.03 ft to the Southeast corner of the B.H.P. & L. Co. tract; thence North 29° 06' 45" West for 50.00 ft to the true point of beginning; thence North 60° 53' 15" East for 39.50 ft to a point; thence North 29° 06' 45" West for 49.00 ft to an aluminum capped rebar; thence North 60° 53' 15" East for a distance of 61.50 ft to an aluminum capped rebar; thence North 29° 06' 45" West for 160.00 ft to an aluminum capped rebar; thence South 60° 53' 15" West for 101.00 ft to an aluminum capped rebar; thence South 32° 31' 59" West for 58.98 ft to an aluminum capped rebar on East boundary of West Railroad Avenue; thence South 00° 07' 25" East along said East boundary of West Railroad Avenue for 110.00 ft to an aluminum capped rebar on North boundary of B.H.P.& L. tract; thence North 60° 53' 15" East for 105.63 ft to an aluminum capped rebar, at the most Northerly corner of B.H.P.& L. tract; thence South 29° 06' 45" East for a distance of 85.00 ft to an "x" in concrete drain & the point of beginning. Said tract contains 0.606 acres, more or less.

RIGHT OF WAY EASEMENTS OVER  
LANDS IN CAMPBELL COUNTY, WYOMING

[See attachment.]

**RIGHT OF WAY EASEMENT  
BLACK HILLS POWER, INC.  
SECTION 20, T. 44 N., R. 74 W., 6TH P.M.  
CAMPBELL COUNTY, WYOMING**

<b>RECORD OWNER</b>	<b>FOOTAGE</b>	<b>RODS</b>
JESSE DALE RUBY TRUST & MAX L RUBY REVOCABLE TRUST	4116.9'	249.51'

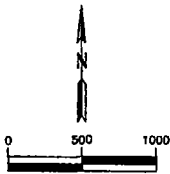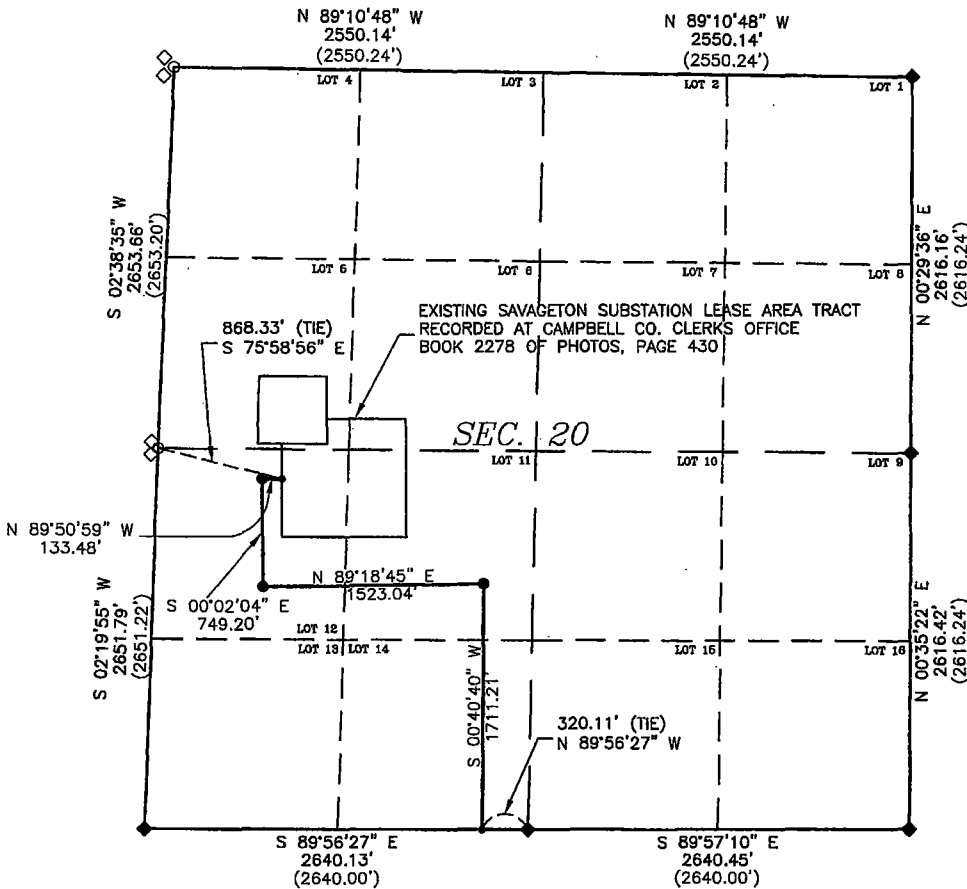

- LEGEND:**
- ◆ 1991 B.L.M. BRASS CAP
  - ◇ REFERENCE MARKER
  - CALCULATED CORNER POSITION (NOT SET)
  - ( ) RECORDED DISTANCE
  - CENTERLINE OF RIGHT OF WAY EASEMENT
  - BEGINNING AND END OF ALIGNMENT DESCRIPTION
  - POWER LINE PI LOCATION

**BASIS OF BEARING:**  
NAD 83 WYOMING STATE PLANE,  
EAST ZONE-GRID

**LEGAL DESCRIPTION:**

The following is a legal description for a 125 foot wide easement located in portions of Lot 11 (NE 1/4 SW 1/4), Lot 12 (NW 1/4 SW 1/4) and Lot 14 (SE 1/4 SW 1/4) of Section 20, Township 44 North, Range 74 West of the 6th P.M., Campbell County, Wyoming. Said easement being 62.5 feet on each side of the following described centerline:

Commencing at the West 1/4 corner of said Section 20, said corner being referenced with two B.L.M. reference markers, thence S 75°58'56" E, a distance of 868.33 feet to the True Point of Beginning of said easement centerline;

Thence along said centerline N 89°50'59" W, a distance of 133.48 feet; Thence along said centerline S 00°02'04" E, a distance of 749.20 feet; Thence along said centerline N 89°18'45" E, a distance of 1523.04 feet; Thence along said centerline S 00°40'40" W, a distance of 1711.21 feet to a point on the South line of said Section 20, said point being N 89°56'27" W, a distance of 320.11 feet from the South 1/4 corner of said Section 20, being a 1991 B.L.M. Brass cap.

Said easement centerline being 4116.93 feet in length, more or less with side lines shortened or extended to the recorded boundary.



**CERTIFICATE OF SURVEYOR:**  
I, THEODORE L. MCMAHON, BEING A PROFESSIONAL LAND SURVEYOR, REGISTERED UNDER THE LAWS OF THE STATE OF WYOMING, DO HEREBY CERTIFY THAT THE MAP HEREON REPRESENTS AN ACTUAL SURVEY MADE BY MYSELF AND OR BY PERSONNEL OF KNIGHT TECHNOLOGIES INCORPORATED UNDER MY DIRECT SUPERVISION AND THAT SAID PLAT AND LEGAL DESCRIPTION SHOWN ARE ACCURATELY REPRESENTED.

PREPARED FOR:  
BLACK HILLS POWER, INC.  
625 9th STREET  
P.O. BOX 1400  
RAPID CITY, SD 57709



**RIGHT OF WAY EASEMENT**  
JESSE DALE RUBY TRUST  
MAX L RUBY REVOCABLE TRUST  
SEC. 20, T. 44 N., R. 74 W.  
CAMPBELL COUNTY, WYOMING

PREPARED BY:  
KNIGHT TECHNOLOGIES, INC.  
201 W. Lakeway Rd.  
Suite 200  
Gillette, WY 82718  
Office: (307) 682-8547





DATE: 05-14-09	DESIGNED BY: KTI
SCALE: 1" = 1000'	DRAWN BY: KTI/PK
CNTR INTRVL: N/A	APPROVED BY: KTI/TLM
REVISION:	DATE: / /

**NOTE:**  
ALL CENTERLINE BEARINGS AND DISTANCES HEREIN ARE CONSIDERED TO BE MORE OR LESS. THE CENTERLINE OF THE POWERLINE AS CONSTRUCTED IS THE CENTER LINE OF THE 125' WIDE EASEMENT BEING 62.5' ON EACH SIDE

**RIGHT OF WAY EASEMENT  
BLACK HILLS POWER, INC.  
SECTION 29, T. 44 N., R. 74 W., 6TH P.M.  
CAMPBELL COUNTY, WYOMING**

<b>RECORD OWNER</b>	<b>FOOTAGE</b>	<b>RODS</b>
JESSE DALE RUBY TRUST & MAX L RUBY REVOCABLE TRUST	5349.0'	324.18

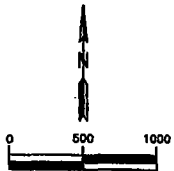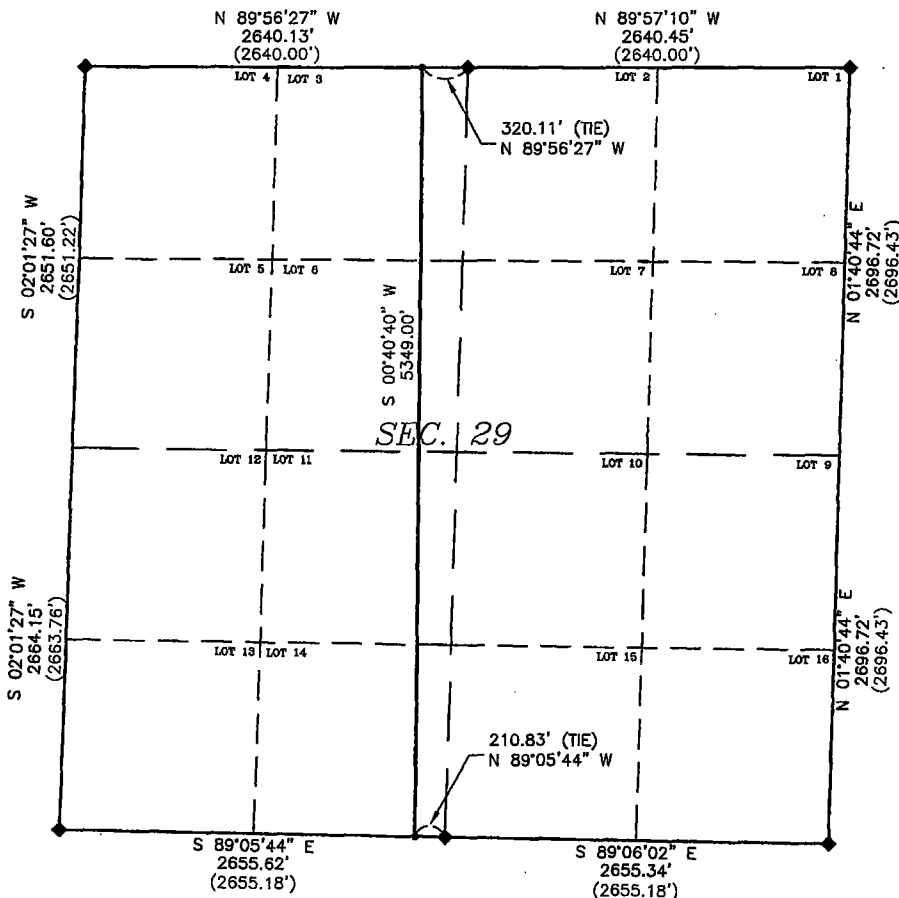

**LEGEND:**

- ◆ 1991 B.L.M. BRASS CAP
- ( ) RECORDED DISTANCE
- CENTERLINE OF RIGHT OF WAY EASEMENT
- BEGINNING AND END OF ALIGNMENT DESCRIPTION

**BASIS OF BEARING:**  
NAD 83 WYOMING STATE PLANE,  
EAST ZONE-GRID


**LEGAL DESCRIPTION:**

The following is a legal description for a 125 foot wide easement located in portions of Lot 3 (NE 1/4 NW 1/4), Lot 6 (SE 1/4 NW 1/4), Lot 11 (NE 1/4 SW 1/4) and Lot 14 (SE 1/4 SW 1/4) of Section 29, Township 44 North, Range 74 West of the 6th P.M., Campbell County, Wyoming. Said easement being 62.5 feet on each side of the following described centerline:

Commencing at the North 1/4 corner of said Section 29, said corner being monumented with a 1991 B.L.M. Brass cap, thence N 89°56'27" W, a distance of 320.11 feet to the True Point of Beginning of said easement centerline;

Thence along said centerline S 00°40'40" W, a distance of 5349.00 feet to a point on the South line of said Section 29, said point being N 89°05'44" W, a distance of 210.83 feet from the South 1/4 corner of said Section 29, being a 1991 B.L.M. Brass cap.

Said easement centerline being 5349.00 feet in length, more or less with side lines shortened or extended to the recorded boundary.

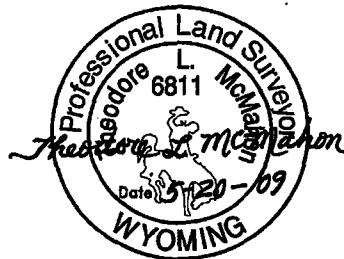

**CERTIFICATE OF SURVEYOR:**  
I, THEODORE L. MCMAHON, BEING A PROFESSIONAL LAND SURVEYOR, REGISTERED UNDER THE LAWS OF THE STATE OF WYOMING, DO HEREBY CERTIFY THAT THE MAP HEREON REPRESENTS AN ACTUAL SURVEY MADE BY MYSELF AND OR BY PERSONNEL OF KNIGHT TECHNOLOGIES INCORPORATED UNDER MY DIRECT SUPERVISION AND THAT SAID PLAT AND LEGAL DESCRIPTION SHOWN ARE ACCURATELY REPRESENTED.

**NOTE:**  
ALL CENTERLINE BEARINGS AND DISTANCES HEREIN ARE CONSIDERED TO BE MORE OR LESS. THE CENTERLINE OF THE POWERLINE AS CONSTRUCTED IS THE CENTER LINE OF THE 125' WIDE EASEMENT BEING 62.5' ON EACH SIDE

PREPARED BY:  
KNIGHT TECHNOLOGIES, INC.  
201 W. Lakeway Rd.  
Suite 200  
Gillette, WY 82718  
Office: (307) 682-8547



PREPARED FOR:  
BLACK HILLS POWER, INC.  
626 9th STREET  
P.O. BOX 1400  
RAPID CITY, SD 57709





<b>RIGHT OF WAY EASEMENT JESSE DALE RUBY TRUST MAX L RUBY REVOCABLE TRUST SEC. 29, T. 44 N., R. 74 W. CAMPBELL COUNTY, WYOMING</b>	
DATE: 05-14-09	DESIGNED BY: KTI
SCALE: 1" = 1000'	DRAWN BY: KTI/PK
CNTR INTRVL: N/A	APPROVED BY: KTI/TLM
REVISION:	DATE: / /

**RIGHT OF WAY EASEMENT  
BLACK HILLS POWER, INC.**

SECTION 32, T. 44 N., R. 74 W., 6TH P.M.  
CAMPBELL COUNTY, WYOMING

RECORD OWNER	FOOTAGE	RODS
JESSE DALE RUBY TRUST & MAX L RUBY REVOCABLE TRUST	5274.4'	319.66

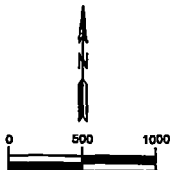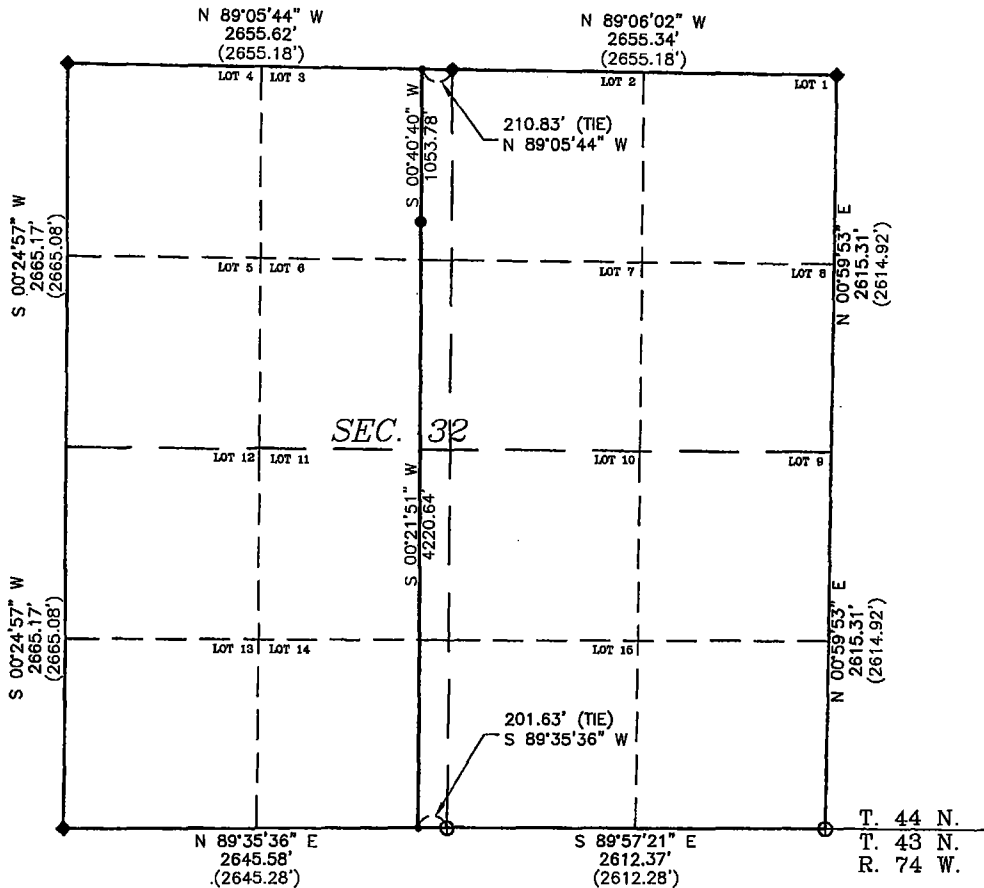

- LEGEND:**
- ◆ 1991 B.L.M. BRASS CAP
  - ⊕ 1989 ALUMINUM CAP, LS 538
  - ( ) RECORDED DISTANCE
  - CENTERLINE OF RIGHT OF WAY EASEMENT
  - BEGINNING AND END OF ALIGNMENT DESCRIPTION
  - POWER LINE PI LOCATION

**BASIS OF BEARING:**  
NAD 83 WYOMING STATE PLANE,  
EAST ZONE--GRID


**LEGAL DESCRIPTION:**

The following is a legal description for a 125 foot wide easement located in portions of Lot 3 (NE 1/4 NW 1/4), Lot 6 (SE 1/4 NW 1/4), Lot 11 (NE 1/4 SW 1/4) and Lot 14 (SE 1/4 SW 1/4) of Section 32, Township 44 North, Range 74 West of the 6th P.M., Campbell County, Wyoming. Said easement being 62.5 feet on each side of the following described centerline:

Commencing at the North 1/4 corner of said Section 32, said corner being monumented with a 1991 B.L.M. Brass cap, thence N 89°05'44" W, a distance of 210.83 feet to the True Point of Beginning of said easement centerline;

Thence along said centerline S 00°40'40" W, a distance of 1053.78 feet; Thence along said centerline S 00°21'51" W, a distance of 4220.64 feet to a point on the South line of said Section 32, said point being S 89°35'36" W, a distance of 201.63 feet from the South 1/4 corner of said Section 32, being a 1989 LS 538 Aluminum cap.

Said easement centerline being 5274.42 feet in length, more or less with side lines shortened or extended to the recorded boundary.

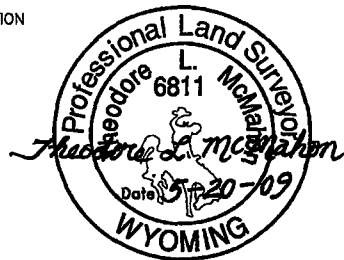

**CERTIFICATE OF SURVEYOR:**  
I, THEODORE L. MCMAHON, BEING A PROFESSIONAL LAND SURVEYOR, REGISTERED UNDER THE LAWS OF THE STATE OF WYOMING, DO HEREBY CERTIFY THAT THE MAP HEREON REPRESENTS AN ACTUAL SURVEY MADE BY MYSELF AND OR BY PERSONNEL OF KNIGHT TECHNOLOGIES INCORPORATED UNDER MY DIRECT SUPERVISION AND THAT SAID PLAT AND LEGAL DESCRIPTION SHOWN ARE ACCURATELY REPRESENTED.

PREPARED FOR:  
BLACK HILLS POWER, INC.  
626 9th STREET  
P.O. BOX 1400  
RAPID CITY, SD 57709

**RIGHT OF WAY EASEMENT  
JESSE DALE RUBY TRUST  
MAX L RUBY REVOCABLE TRUST  
SEC. 32, T. 44 N., R. 74 W.  
CAMPBELL COUNTY, WYOMING**

**NOTE:**  
ALL CENTERLINE BEARINGS AND DISTANCES HEREIN ARE CONSIDERED TO BE MORE OR LESS. THE CENTERLINE OF THE POWERLINE AS CONSTRUCTED IS THE CENTER LINE OF THE 125' WIDE EASEMENT BEING 62.5' ON EACH SIDE



PREPARED BY:  
KNIGHT TECHNOLOGIES, INC.  
201 W. Lakeway Rd.  
Suite 200  
Gillette, WY 82718  
Office: (307) 682-8547



DATE: 05-14-08	DESIGNED BY: KTI
SCALE: 1" = 1000'	DRAWN BY: KTI/PK
CNTR INTVL: N/A	APPROVED BY: KTI/TLM
REVISION:	DATE: / /

**RIGHT OF WAY EASEMENT  
BLACK HILLS POWER, INC.  
SECTION 5, T. 43 N., R. 74 W., 6TH P.M.  
CAMPBELL COUNTY, WYOMING**

RECORD OWNER	FOOTAGE	RODS
JESSE DALE RUBY TRUST & MAX L RUBY REVOCABLE TRUST	5400.7	327.32

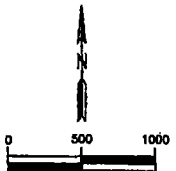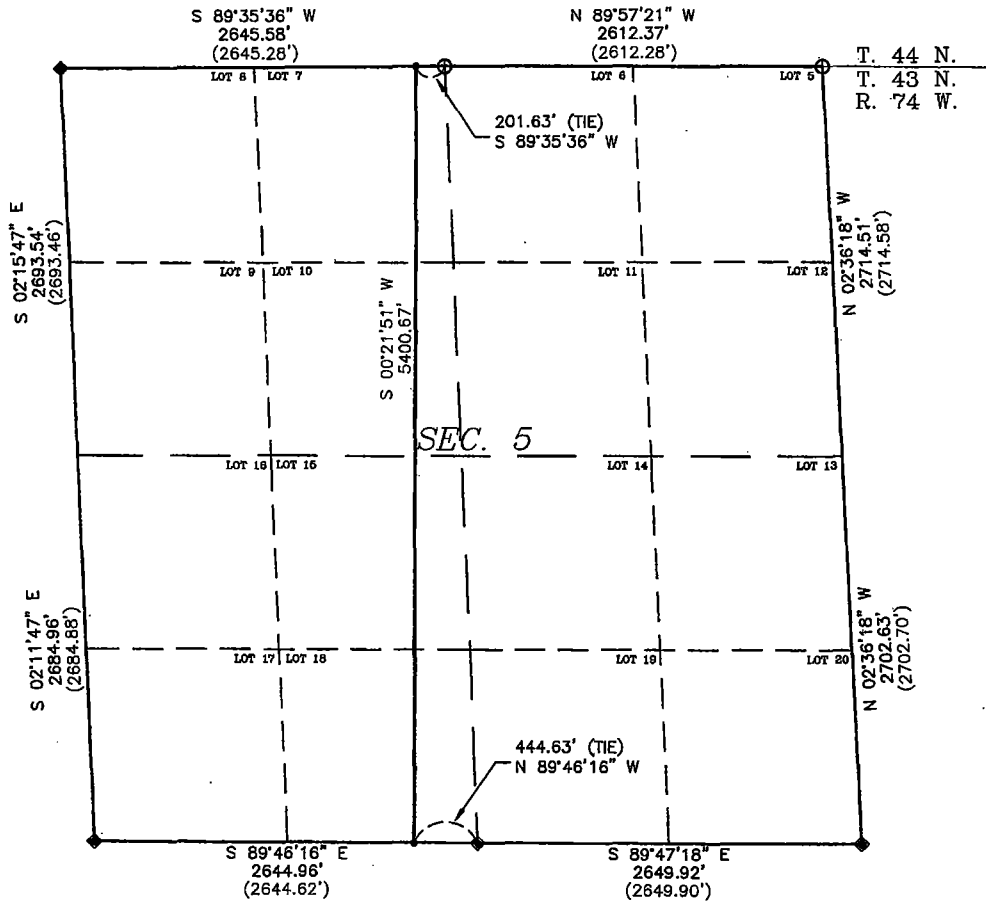

- LEGEND:**
- ◆ 1991 B.L.M. BRASS CAP
  - ◆ 1992 B.L.M. BRASS CAP
  - ⊕ 1989 ALUMINUM CAP, LS 538
  - ( ) RECORDED DISTANCE
  - CENTERLINE OF RIGHT OF WAY EASEMENT
  - BEGINNING AND END OF ALIGNMENT DESCRIPTION

**BASIS OF BEARING:**  
NAD 83 WYOMING STATE PLANE,  
EAST ZONE-GRID

**LEGAL DESCRIPTION:**

The following is a legal description for a 125 foot wide easement located in portions of Lot 7 (NE 1/4 NW 1/4), Lot 10 (SE 1/4 NW 1/4), Lot 15 (NE 1/4 SW 1/4), Lot 18 (SE 1/4 SW 1/4) of Section 5, Township 43 North, Range 74 West of the 6th P.M., Campbell County, Wyoming. Said easement being 62.5 feet on each side of the following described centerline:

Commencing at the North 1/4 corner of said Section 5, said corner being monumented with a 1989 LS 538 Aluminum cap, thence S 89°35'36" W, a distance of 201.63 feet to the True Point of Beginning of said easement centerline;

Thence along said centerline S 00°21'51" W, a distance of 5400.67 feet to a point on the South line of said Section 5, said point being N 89°46'16" W, a distance of 444.63 feet from the South 1/4 corner of said Section 5, being a 1992 B.L.M. Brass cap.

Said easement centerline being 5400.67 feet in length, more or less with side lines shortened or extended to the recorded boundary.



**CERTIFICATE OF SURVEYOR:**  
I, THEODORE L. MCMAHON, BEING A PROFESSIONAL LAND SURVEYOR, REGISTERED UNDER THE LAWS OF THE STATE OF WYOMING, DO HEREBY CERTIFY THAT THE MAP HEREON REPRESENTS AN ACTUAL SURVEY MADE BY MYSELF AND OR BY PERSONNEL OF KNIGHT TECHNOLOGIES INCORPORATED UNDER MY DIRECT SUPERVISION AND THAT SAID PLAT AND LEGAL DESCRIPTION SHOWN ARE ACCURATELY REPRESENTED.

**NOTE:**  
ALL CENTERLINE BEARINGS AND DISTANCES HEREIN ARE CONSIDERED TO BE MORE OR LESS. THE CENTERLINE OF THE POWERLINE AS CONSTRUCTED IS THE CENTER LINE OF THE 125' WIDE EASEMENT BEING 62.5' ON EACH SIDE



PREPARED BY:  
**KNIGHT TECHNOLOGIES, INC.**  
201 W. Lakeway Rd.  
Suite 200  
Gillette, WY 82718  
Office: (307) 682-8547

PREPARED FOR:  
**BLACK HILLS POWER, INC.**  
825 9th STREET  
P.O. BOX 1460  
RAPID CITY, SD 57709

<b>RIGHT OF WAY EASEMENT</b>	
JESSE DALE RUBY TRUST MAX L RUBY REVOCABLE TRUST SEC. 5, T. 43 N., R. 74 W. CAMPBELL COUNTY, WYOMING	
DATE: 05-14-09	DESIGNED BY: KTY
SCALE: 1" = 1000'	DRAWN BY: KTI/PK
CNTR INTRVL: N/A	APPROVED BY: KTI/TLM
REVISION:	DATE: / /

**RIGHT OF WAY EASEMENT  
BLACK HILLS POWER, INC.  
SECTION 8, T. 43 N., R. 74 W., 6TH P.M.  
CAMPBELL COUNTY, WYOMING**

RECORD OWNER PUMPKIN BUTTE RANCH, LLC	FOOTAGE 5316.0'	RODS 322.18
--	--------------------	----------------

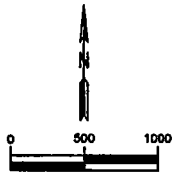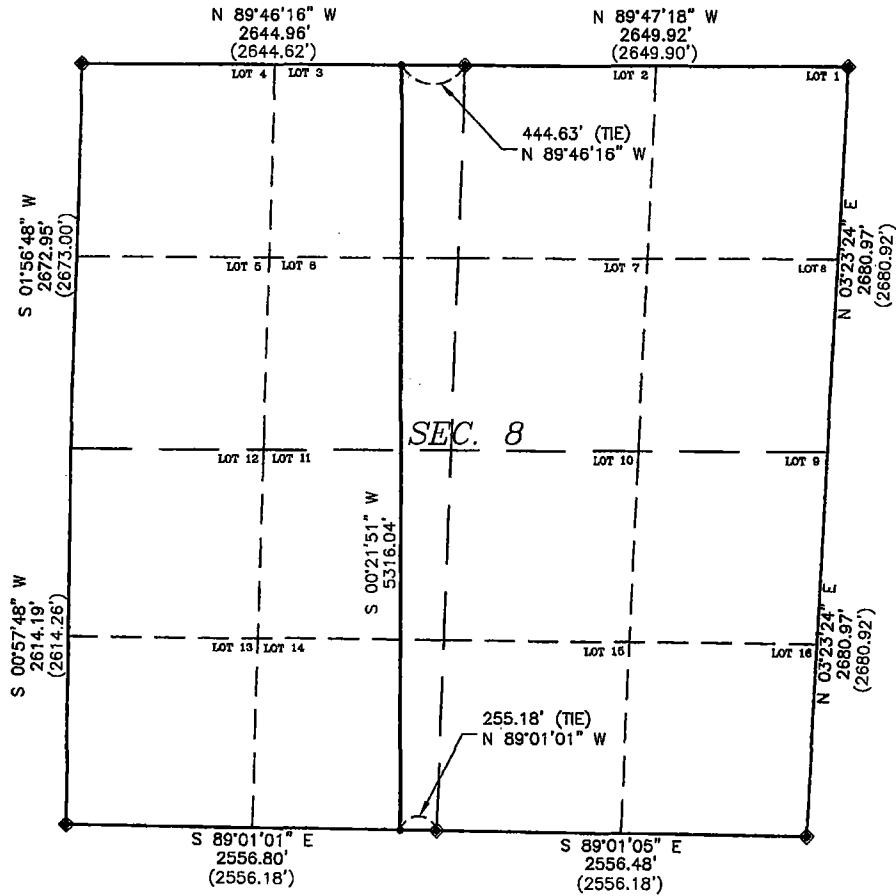

- LEGEND:**
- ◆ 1992 B.L.M. BRASS CAP
  - ( ) RECORDED DISTANCE
  - CENTERLINE OF RIGHT OF WAY EASEMENT
  - BEGINNING AND END OF ALIGNMENT DESCRIPTION

**BASIS OF BEARING:**  
NAD 83 WYOMING STATE PLANE,  
EAST ZONE-GRID


**LEGAL DESCRIPTION:**

The following is a legal description for a 125 foot wide easement located in portions of Lot 3 (NE 1/4 NW 1/4), Lot 6 (SE 1/4 NW 1/4), Lot 11 (NE 1/4 SW 1/4), Lot 14 (SE 1/4 SW 1/4) of Section 8, Township 43 North, Range 74 West of the 6th P.M., Campbell County, Wyoming. Said easement being 62.5 feet on each side of the following described centerline:

Commencing at the North 1/4 corner of said Section 8, said corner being monumented with a 1992 B.L.M. Brass cap, thence N 89°46'16" W, a distance of 444.63 feet to the True Point of Beginning of said easement centerline;

Thence along said centerline S 00°21'51" W, a distance of 5316.04 feet to a point on the South line of said Section 8, said point being N 89°01'01" W, a distance of 255.18 feet from the South 1/4 corner of said Section 8, being a 1992 B.L.M. Brass cap.

Said easement centerline being 5316.04 feet in length, more or less with side lines shortened or extended to the recorded boundary.

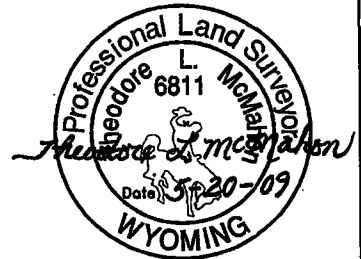

**CERTIFICATE OF SURVEYOR:**  
I, THEODORE L. MCMAHON, BEING A PROFESSIONAL LAND SURVEYOR, REGISTERED UNDER THE LAWS OF THE STATE OF WYOMING, DO HEREBY CERTIFY THAT THE MAP HEREON REPRESENTS AN ACTUAL SURVEY MADE BY MYSELF AND OR BY PERSONNEL OF KNIGHT TECHNOLOGIES INCORPORATED UNDER MY DIRECT SUPERVISION AND THAT SAID PLAT AND LEGAL DESCRIPTION SHOWN ARE ACCURATELY REPRESENTED.

PREPARED FOR:  
BLACK HILLS POWER, INC.  
625 9th STREET  
P.O. BOX 1400  
RAPID CITY, SD 57709

**RIGHT OF WAY EASEMENT  
PUMPKIN BUTTE RANCH, LLC**

SEC. 8, T. 43 N., R. 74 W.  
CAMPBELL COUNTY, WYOMING

**NOTE:**  
ALL CENTERLINE BEARINGS AND DISTANCES HEREIN ARE CONSIDERED TO BE MORE OR LESS. THE CENTERLINE OF THE POWERLINE AS CONSTRUCTED IS THE CENTER LINE OF THE 125' WIDE EASEMENT BEING 62.5' ON EACH SIDE

PREPARED BY:  
KNIGHT TECHNOLOGIES, INC.  
201 W. Lakeway Rd.  
Suite 200  
Gillette, WY 82718  
Office: (307) 682-8547





DATE: 05-14-09	DESIGNED BY: KTI
SCALE: 1" = 1000'	DRAWN BY: KTI/PK
CNTR INTVL: N/A	APPROVED BY: KTI/TLM
REVISION:	DATE: / /



**RIGHT OF WAY EASEMENT  
BLACK HILLS POWER, INC.  
SECTION 17, T. 43 N., R. 74 W., 6TH P.M.  
CAMPBELL COUNTY, WYOMING**

RECORD OWNER	FOOTAGE	RODS
C JAMES SPOMER AND CARLENE VAN BUGGENUM SPOMER	5346.2'	324.01

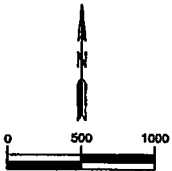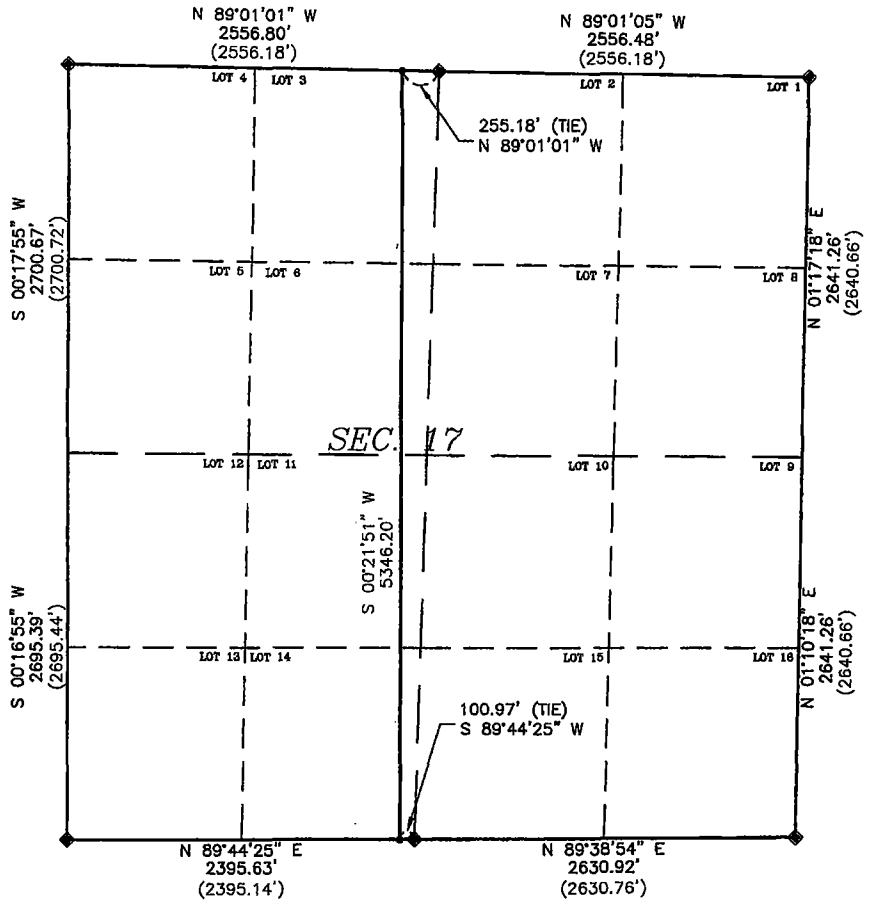

- LEGEND:**
- ◆ 1992 B.L.M. BRASS CAP
  - ( ) RECORDED DISTANCE
  - CENTERLINE OF RIGHT OF WAY EASEMENT
  - BEGINNING AND END OF ALIGNMENT DESCRIPTION

**BASIS OF BEARING:**  
NAD 83 WYOMING STATE PLANE,  
EAST ZONE—GRID


**LEGAL DESCRIPTION:**

The following is a legal description for a 125 foot wide easement located in portions of Lot 3 (NE 1/4 NW 1/4), Lot 6 (SE 1/4 NW 1/4), Lot 11 (NE 1/4 SW 1/4), Lot 14 (SE 1/4 SW 1/4) of Section 17, Township 43 North, Range 74 West of the 6th P.M., Campbell County, Wyoming. Said easement being 62.5 feet on each side of the following described centerline:

Commencing at the North 1/4 corner of said Section 17, said corner being monumented with a 1992 B.L.M. Brass cap, thence N 89°01'01" W, a distance of 255.18 feet to the True Point of Beginning of said easement centerline;

Thence along said centerline S 00°21'51" W, a distance of 5346.20 feet to a point on the South line of said Section 17, said point being S 89°44'25" W, a distance of 100.97 feet from the South 1/4 corner of said Section 17, being a 1992 B.L.M. Brass cap.

Said easement centerline being 5346.20 feet in length, more or less with side lines shortened or extended to the recorded boundary.

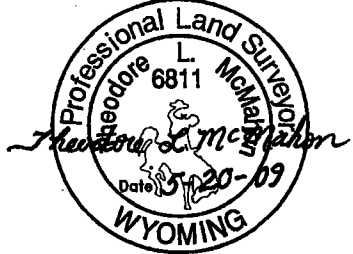

**CERTIFICATE OF SURVEYOR:**  
I, THEODORE L. MCMAHON, BEING A PROFESSIONAL LAND SURVEYOR, REGISTERED UNDER THE LAWS OF THE STATE OF WYOMING, DO HEREBY CERTIFY THAT THE MAP HEREON REPRESENTS AN ACTUAL SURVEY MADE BY MYSELF AND OR BY PERSONNEL OF KNIGHT TECHNOLOGIES INCORPORATED UNDER MY DIRECT SUPERVISION AND THAT SAID PLAT AND LEGAL DESCRIPTION SHOWN ARE ACCURATELY REPRESENTED.

PREPARED FOR:  
BLACK HILLS POWER, INC.  
625 9th STREET  
P.O. BOX 1400  
RAPID CITY, SD 57709

**RIGHT OF WAY EASEMENT  
C JAMES SPOMER AND  
CARLENE VAN BUGGENUM SPOMER  
SEC. 17, T. 43 N., R. 74 W.  
CAMPBELL COUNTY, WYOMING**



**NOTE:**  
ALL CENTERLINE BEARINGS AND DISTANCES HEREIN ARE CONSIDERED TO BE MORE OR LESS. THE CENTERLINE OF THE POWERLINE AS CONSTRUCTED IS THE CENTER LINE OF THE 125' WIDE EASEMENT BEING 62.5' ON EACH SIDE

PREPARED BY:  
KNIGHT TECHNOLOGIES, INC.  
201 W. Lakeway Rd.  
Suite 200  
Gillette, WY 82718  
Office: (307) 882-8547

DATE: 05-14-09	DESIGNED BY: KTI
SCALE: 1" = 1000'	DRAWN BY: KTI/PK
CNTR INTRVL: N/A	APPROVED BY: KTI/TLM
REVISION:	DATE: / /

**RIGHT OF WAY EASEMENT  
BLACK HILLS POWER, INC.  
SECTION 20, T. 43 N., R. 74 W., 6TH P.M.  
CAMPBELL COUNTY, WYOMING**

RECORD OWNER ATWOOD-LAUR FAMILY TRUST	FOOTAGE 5372.2'	RODS 325.59
--	--------------------	----------------

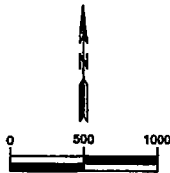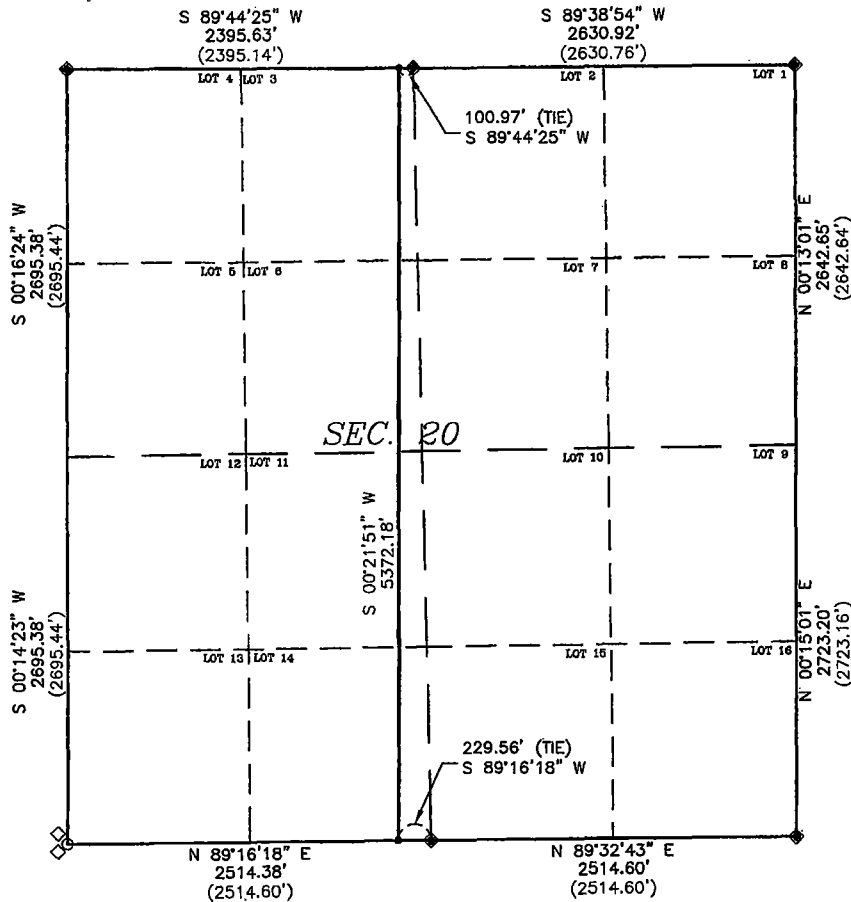

- LEGEND:**
- ◆ 1992 B.L.M. BRASS CAP
  - ◇ REFERENCE MARKER
  - CALCULATED CORNER POSITION (NOT SET)
  - ( ) RECORDED DISTANCE
  - CENTERLINE OF RIGHT OF WAY EASEMENT
  - BEGINNING AND END OF ALIGNMENT DESCRIPTION

**BASIS OF BEARING:**  
NAD 83 WYOMING STATE PLANE,  
EAST ZONE-GRID


**LEGAL DESCRIPTION:**

The following is a legal description for a 125 foot wide easement located in portions of Lot 3 (NE 1/4 NW 1/4), Lot 6 (SE 1/4 NW 1/4), Lot 11 (NE 1/4 SW 1/4), Lot 14 (SE 1/4 SW 1/4) of Section 20, Township 43 North, Range 74 West of the 6th P.M., Campbell County, Wyoming. Said easement being 62.5 feet on each side of the following described centerline:

Commencing at the North 1/4 corner of said Section 20, said corner being monumented with a 1992 B.L.M. Brass cap, thence S 89°44'25" W, a distance of 100.97 feet to the True Point of Beginning of said easement centerline;

Thence along said centerline S 00°21'51" W, a distance of 5372.18 feet to a point on the South line of said Section 20, said point being S 89°16'18" W, a distance of 229.56 feet from the South 1/4 corner of said Section 20, being a 1992 B.L.M. Brass cap.

Said easement centerline being 5372.18 feet in length, more or less with side lines shortened or extended to the recorded boundary.

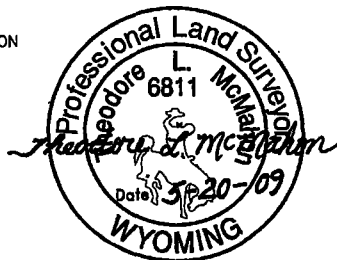

**CERTIFICATE OF SURVEYOR:**  
I, THEODORE L. MCMAHON, BEING A PROFESSIONAL LAND SURVEYOR, REGISTERED UNDER THE LAWS OF THE STATE OF WYOMING, DO HEREBY CERTIFY THAT THE MAP HEREON REPRESENTS AN ACTUAL SURVEY MADE BY MYSELF AND OR BY PERSONNEL OF KNIGHT TECHNOLOGIES INCORPORATED UNDER MY DIRECT SUPERVISION AND THAT SAID PLAT AND LEGAL DESCRIPTION SHOWN ARE ACCURATELY REPRESENTED.

PREPARED FOR:  
BLACK HILLS POWER, INC.  
826 9th STREET  
P.O. BOX 1400  
RAPID CITY, SD 57709



**RIGHT OF WAY EASEMENT  
ATWOOD-LAUR FAMILY TRUST**

SEC. 20, T. 43 N., R. 74 W.  
CAMPBELL COUNTY, WYOMING

**NOTE:**  
ALL CENTERLINE BEARINGS AND DISTANCES HEREIN ARE CONSIDERED TO BE MORE OR LESS. THE CENTERLINE OF THE POWERLINE AS CONSTRUCTED IS THE CENTER LINE OF THE 125' WIDE EASEMENT BEING 62.5' ON EACH SIDE



PREPARED BY:  
KNIGHT TECHNOLOGIES, INC.  
201 W. Lokeway Rd.  
Suite 200  
Gillette, WY 82718  
Office: (307) 682-8547



DATE: 05-14-09	DESIGNED BY: KTI
SCALE: 1" = 1000'	DRAWN BY: KTI/PK
CNTR INTRVL: N/A	APPROVED BY: KTI/TLM
REVISION:	DATE: / /

**RIGHT OF WAY EASEMENT  
BLACK HILLS POWER, INC.  
SECTION 29, T. 43 N., R. 74 W., 6TH P.M.  
CAMPBELL COUNTY, WYOMING**

RECORD OWNER	FOOTAGE	RODS
ATWOOD-LAUR FAMILY TRUST	5349.2'	324.19

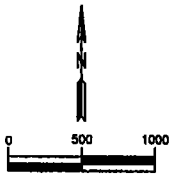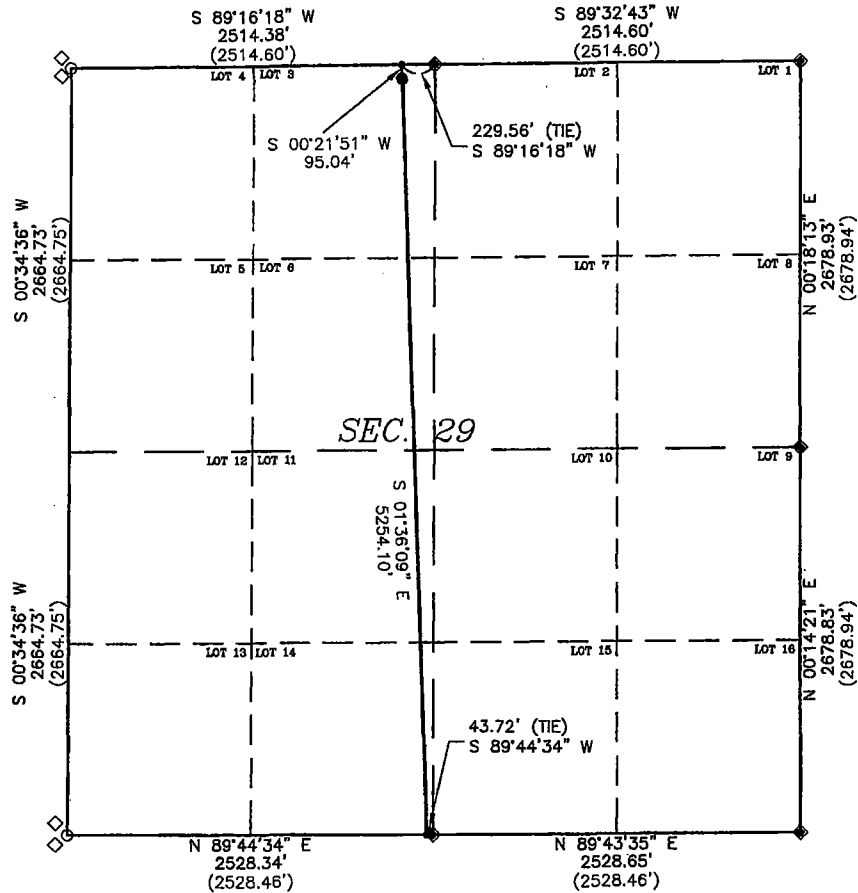

- LEGEND:**
- ◆ 1992 B.L.M. BRASS CAP
  - ◇ REFERENCE MARKER
  - CALCULATED CORNER POSITION (NOT SET)
  - ( ) RECORDED DISTANCE
  - CENTERLINE OF RIGHT OF WAY EASEMENT
  - BEGINNING AND END OF ALIGNMENT DESCRIPTION
  - POWER LINE PI LOCATION

**BASIS OF BEARING:**  
NAD 83 WYOMING STATE PLANE,  
EAST ZONE-GRID


**LEGAL DESCRIPTION:**

The following is a legal description for a 125 foot wide easement located in portions of Lot 3 (NE 1/4 NW 1/4), Lot 6 (SE 1/4 NW 1/4), Lot 11 (NE 1/4 SW 1/4), Lot 14 (SE 1/4 SW 1/4), Lot 15 (SW 1/4 SE 1/4) of Section 29, Township 43 North, Range 74 West of the 6th P.M., Campbell County, Wyoming. Said easement being 62.5 feet on each side of the following described centerline:

Commencing at the North 1/4 corner of said Section 29, said corner being monumented with a 1992 B.L.M. Brass cap, thence S 89°16'18" W, a distance of 229.56 feet to the True Point of Beginning of said easement centerline;

Thence along said centerline S 00°21'51" W, a distance of 95.04 feet; Thence along said centerline S 01°36'09" E, a distance of 5254.10 feet to a point on the South line of said Section 29, said point being S 89°44'34" W, a distance of 43.72 feet from the South 1/4 corner of said Section 29, being a 1992 B.L.M. Brass cap.

Said easement centerline being 5349.15 feet in length, more or less with side lines shortened or extended to the recorded boundary.

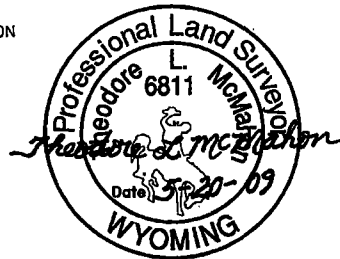

**CERTIFICATE OF SURVEYOR:**  
I, THEODORE L. MCMAHON, BEING A PROFESSIONAL LAND SURVEYOR; REGISTERED UNDER THE LAWS OF THE STATE OF WYOMING, DO HEREBY CERTIFY THAT THE MAP HEREON REPRESENTS AN ACTUAL SURVEY MADE BY MYSELF AND OR BY PERSONNEL OF KNIGHT TECHNOLOGIES INCORPORATED UNDER MY DIRECT SUPERVISION AND THAT SAID PLAT AND LEGAL DESCRIPTION SHOWN ARE ACCURATELY REPRESENTED.

PREPARED FOR:  
BLACK HILLS POWER, INC.  
625 6th STREET  
P.O. BOX 1400  
RAPID CITY, SD 57708



**RIGHT OF WAY EASEMENT  
ATWOOD-LAUR FAMILY TRUST**

SEC. 29, T. 43 N., R. 74 W.  
CAMPBELL COUNTY, WYOMING

PREPARED BY:  
KNIGHT TECHNOLOGIES, INC.  
201 W. Lakeway Rd.  
Suite 200  
Gillette, WY 82718  
Office: (307) 682-8547




DATE: 06-14-09	DESIGNED BY: KTI
SCALE: 1" = 1000'	DRAWN BY: KTI/PK
CNTR INTRVL: N/A	APPROVED BY: KTI/TLM
REVISION:	DATE: / /

**NOTE:**  
ALL CENTERLINE BEARINGS AND DISTANCES HEREIN ARE CONSIDERED TO BE MORE OR LESS. THE CENTERLINE OF THE POWERLINE AS CONSTRUCTED IS THE CENTER LINE OF THE 125' WIDE EASEMENT BEING 62.5' ON EACH SIDE

**RIGHT OF WAY EASEMENT  
BLACK HILLS POWER, INC.**

SECTION 32, T. 43 N., R. 74 W., 6TH P.M.  
CAMPBELL COUNTY, WYOMING

RECORD OWNER	FOOTAGE	RODS
ATWOOD-LAUR FAMILY TRUST	3083.4'	186.87

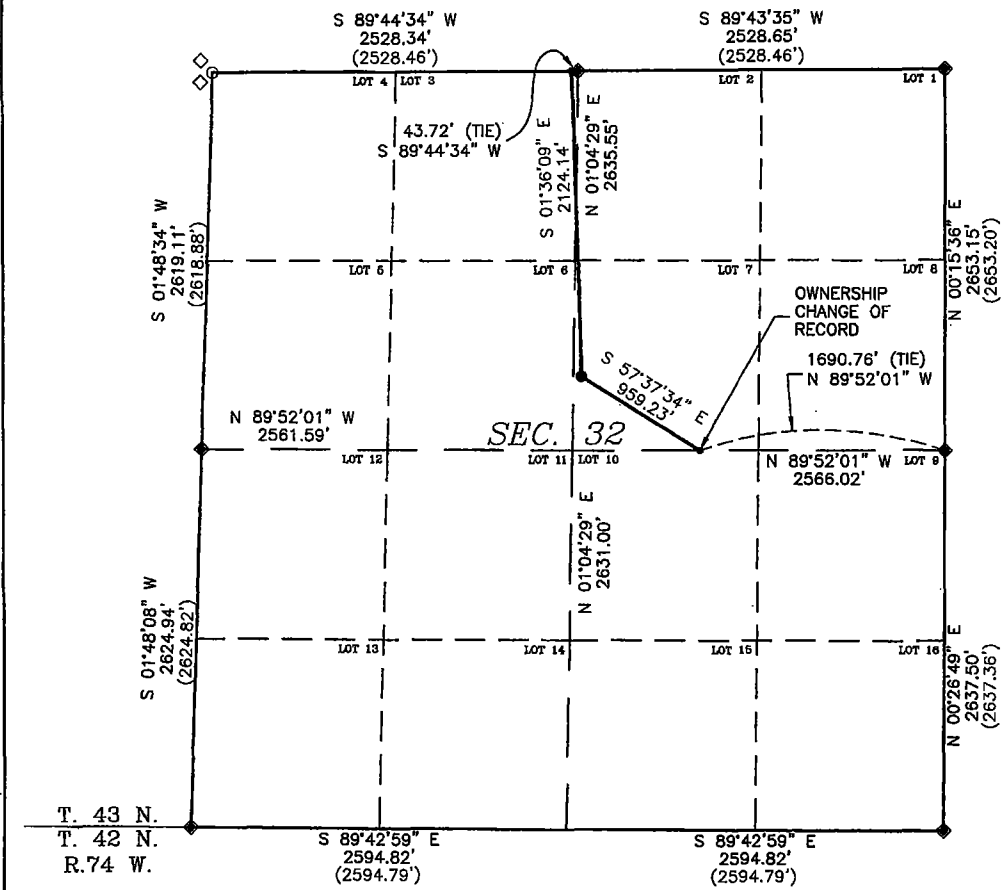

**LEGEND:**

- ◆ 1992 B.L.M. BRASS CAP
- ◇ REFERENCE MARKER
- CALCULATED CORNER POSITION (NOT SET)
- ( ) RECORDED DISTANCE
- CENTERLINE OF RIGHT OF WAY EASEMENT
- BEGINNING AND END OF ALIGNMENT DESCRIPTION
- POWER LINE PI LOCATION

**BASIS OF BEARING:**  
NAD 83 WYOMING STATE PLANE,  
EAST ZONE-GRID

**LEGAL DESCRIPTION:**


The following is a legal description for a 125 foot wide easement located in portions of Lot 2 (NW 1/4 NE 1/4), Lot 3 (NE 1/4 NW 1/4), Lot 6 (SE 1/4 NW 1/4), Lot 7 (SW 1/4 NE 1/4) of Section 32, Township 43 North, Range 74 West of the 6th P.M., Campbell County, Wyoming. Said easement being 62.5 feet on each side of the following described centerline:

Commencing at the North 1/4 corner of said Section 32, said corner being monumented with a 1992 B.L.M. Brass cap, thence S 89°44'34" W, a distance of 43.72 feet to the True Point of Beginning of said easement centerline;

Thence along said centerline S 01°36'09" E, a distance of 2124.14 feet; Thence along said centerline S 57°37'34" E, a distance of 959.23 feet to a point on the South line of said Lot 7 (SW 1/4 NE 1/4), said point being N 89°52'01" W, a distance of 1690.76 feet from the East 1/4 corner of said Section 32, being a 1992 B.L.M. Brass cap.

Said easement centerline being 3083.38 feet in length, more or less with side lines shortened or extended to the recorded boundary.

**CERTIFICATE OF SURVEYOR:**  
I, THEODORE L. MCMAHON, BEING A PROFESSIONAL LAND SURVEYOR, REGISTERED UNDER THE LAWS OF THE STATE OF WYOMING, DO HEREBY CERTIFY THAT THE MAP HEREON REPRESENTS AN ACTUAL SURVEY MADE BY MYSELF AND OR BY PERSONNEL OF KNIGHT TECHNOLOGIES INCORPORATED UNDER MY DIRECT SUPERVISION AND THAT SAID PLAT AND LEGAL DESCRIPTION SHOWN ARE ACCURATELY REPRESENTED.

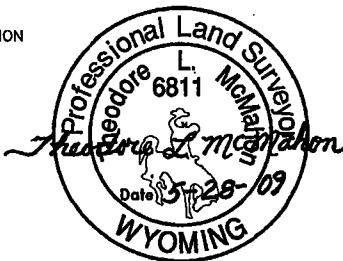

**NOTE:**  
ALL CENTERLINE BEARINGS AND DISTANCES HEREIN ARE CONSIDERED TO BE MORE OR LESS. THE CENTERLINE OF THE POWERLINE AS CONSTRUCTED IS THE CENTER LINE OF THE 125' WIDE EASEMENT BEING 62.5' ON EACH SIDE

PREPARED BY:  
KNIGHT TECHNOLOGIES, INC.  
201 W. Lokewoy Rd.  
Suite 200  
Gillette, WY 82718  
Office: (307) 682-8547



PREPARED FOR:  
BLACK HILLS POWER, INC.  
625 9th STREET  
P.O. BOX 1400  
RAPID CITY, SD 57709





**RIGHT OF WAY EASEMENT**  
ATWOOD-LAUR FAMILY TRUST  
SEC. 32, T. 43 N., R. 74 W.  
CAMPBELL COUNTY, WYOMING

DATE: 05-28-09	DESIGNED BY: KTI
SCALE: 1" = 1000'	DRAWN BY: KTI/MB
CNTR INTRVL: N/A	APPROVED BY: KTI/TLM
REVISION:	DATE: / /

**RIGHT OF WAY EASEMENT  
BLACK HILLS POWER, INC.  
SECTION 32, T. 43 N., R. 74 W., 6TH P.M.  
CAMPBELL COUNTY, WYOMING**

RECORD OWNER IBERLIN RANCH LIMITED PARTNERSHIP	FOOTAGE 1992.1'	RODS 120.73
---	--------------------	----------------

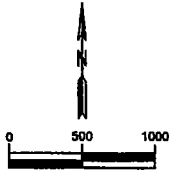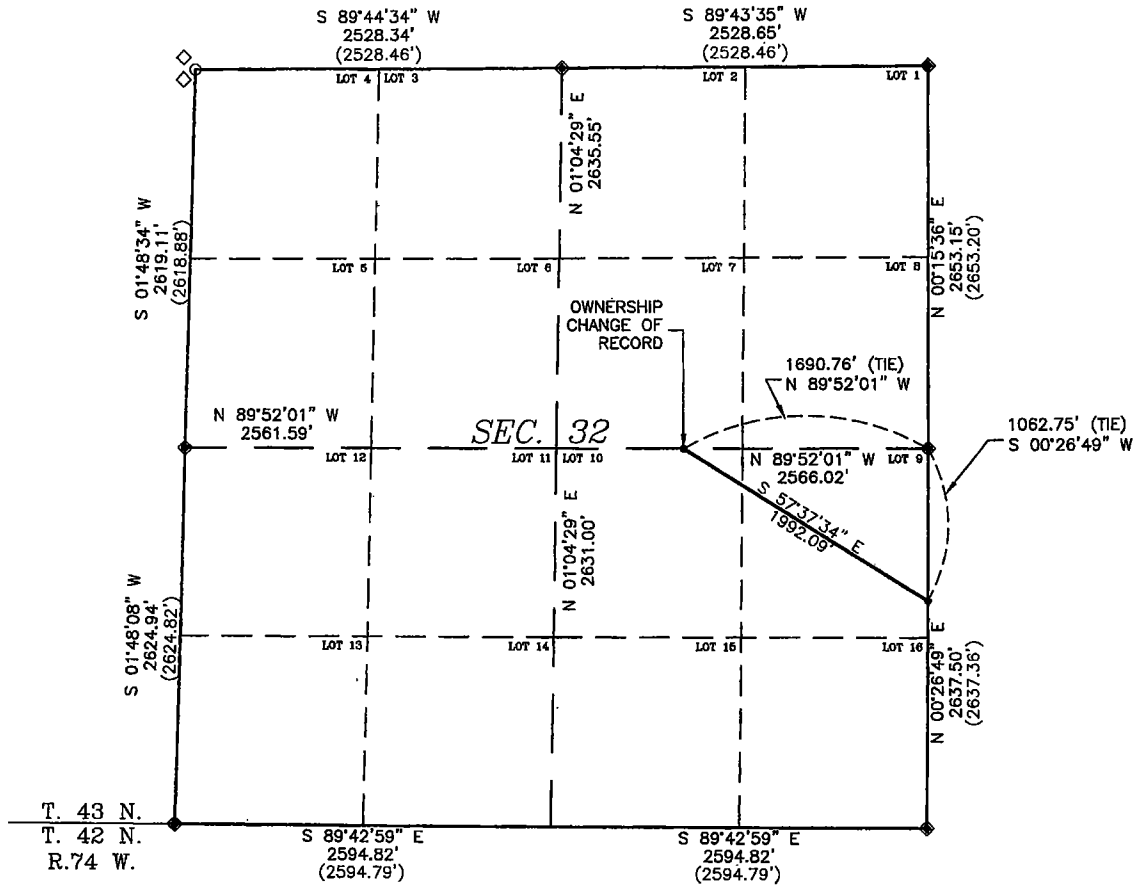

- LEGEND:**
- ◆ 1992 B.L.M. BRASS CAP
  - ◇ REFERENCE MARKER
  - CALCULATED CORNER POSITION (NOT SET)
  - ( ) RECORDED DISTANCE
  - CENTERLINE OF RIGHT OF WAY EASEMENT
  - BEGINNING AND END OF ALIGNMENT DESCRIPTION

**BASIS OF BEARING:**  
NAD 83 WYOMING STATE PLANE,  
EAST ZONE-GRID


**LEGAL DESCRIPTION:**

The following is a legal description for a 125 foot wide easement located in portions of Lot 9 (NE 1/4 SE 1/4), Lot 10 (NW 1/4 SE 1/4) of Section 32, Township 43 North, Range 74 West of the 6th P.M., Campbell County, Wyoming. Said easement being 62.5 feet on each side of the following described centerline:

Commencing at the East 1/4 corner of said Section 32, said corner being monumented with a 1992 B.L.M. Brass cap, thence N 89°52'01" W, a distance of 1690.76 feet to the True Point of Beginning of said easement centerline;

Thence along said centerline S 57°37'34" E, a distance of 1992.09 feet to a point on the East line of said Section 32, said point being S 00°26'49" W, a distance of 1062.75 feet from the East 1/4 corner of said Section 32, being a 1992 B.L.M. Brass cap.

Said easement centerline being 1992.09 feet in length, more or less with side lines shortened or extended to the recorded boundary.

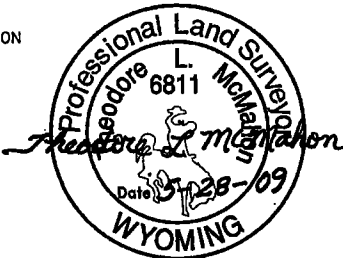

**CERTIFICATE OF SURVEYOR:**  
I, THEODORE L. MCMAHON, BEING A PROFESSIONAL LAND SURVEYOR, REGISTERED UNDER THE LAWS OF THE STATE OF WYOMING, DO HEREBY CERTIFY THAT THE MAP HEREON REPRESENTS AN ACTUAL SURVEY MADE BY MYSELF AND OR BY PERSONNEL OF KNIGHT TECHNOLOGIES INCORPORATED UNDER MY DIRECT SUPERVISION AND THAT SAID PLAT AND LEGAL DESCRIPTION SHOWN ARE ACCURATELY REPRESENTED.

PREPARED FOR:  
BLACK HILLS POWER, INC.  
865 6th STREET  
P.O. BOX 1400  
RAPID CITY, SD 57708



**RIGHT OF WAY EASEMENT  
IBERLIN RANCH LIMITED PARTNERSHIP**

SEC. 32, T. 43 N., R. 74 W.  
CAMPBELL COUNTY, WYOMING

**NOTE:**  
ALL CENTERLINE BEARINGS AND DISTANCES HEREIN ARE CONSIDERED TO BE MORE OR LESS, THE CENTERLINE OF THE POWERLINE AS CONSTRUCTED IS THE CENTER LINE OF THE 125' WIDE EASEMENT BEING 62.5' ON EACH SIDE

PREPARED BY:  
KNIGHT TECHNOLOGIES, INC.  
201 W. Lakeway Rd.  
Suite 200  
Gillette, WY 82718  
Office: (307) 682-8547





DATE: 06-28-08	DESIGNED BY: KTI
SCALE: 1" = 1000'	DRAWN BY: KTI/PK
CNTR INTRVL: N/A	APPROVED BY: KTI/TLM
REVISION:	DATE:

**RIGHT OF WAY EASEMENT  
BLACK HILLS POWER, INC.**

SECTION 33, T. 43 N., R. 74 W., 6TH P.M.  
CAMPBELL COUNTY, WYOMING

RECORD OWNER	FOOTAGE	RODS
IBERLIN RANCH LIMITED PARTNERSHIP	1568.9'	95.08

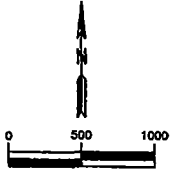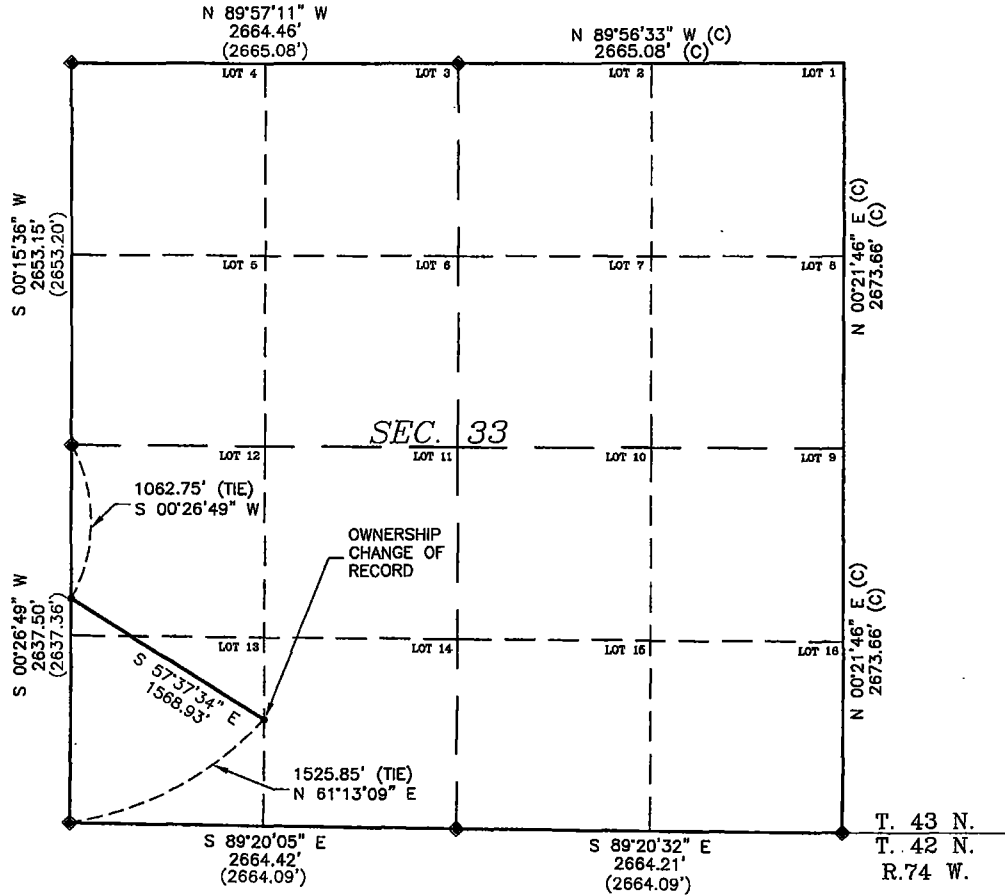

- LEGEND:**
- ◆ 1992 B.L.M. BRASS CAP
  - ( ) RECORDED DISTANCE
  - (C) CALCULATED FROM RECORD
  - CENTERLINE OF RIGHT OF WAY EASEMENT
  - BEGINNING AND END OF ALIGNMENT DESCRIPTION

BASIS OF BEARING:  
NAD 83 WYOMING STATE PLANE,  
EAST ZONE-GRID

**LEGAL DESCRIPTION:**

The following is a legal description for a 125 foot wide easement located in portions of Lot 12 (NW 1/4 SW 1/4) and Lot 13 (SW 1/4 SW 1/4) of Section 33, Township 43 North, Range 74 West of the 6th P.M., Campbell County, Wyoming. Said easement being 62.5 feet on each side of the following described centerline:

Commencing at the West 1/4 corner of said Section 33, said corner being monumented with a 1992 B.L.M. Brass cap, thence S 00°26'49" W, a distance of 1062.75 feet to the True Point of Beginning of said easement centerline;

Thence along said centerline S 57°37'34" E, a distance of 1568.93 feet to a point on the East line of Lot 13 (SW 1/4 SW 1/4) of said Section 33, said point being N 61°13'09" E, a distance of 1525.85 feet from the Southwest corner of said Section 33, being a 1992 B.L.M. Brass cap.

Said easement centerline being 1568.93 feet in length, more or less with side lines shortened or extended to the recorded boundary.



**CERTIFICATE OF SURVEYOR:**  
I, THEODORE L. MCMAHON, BEING A PROFESSIONAL LAND SURVEYOR, REGISTERED UNDER THE LAWS OF THE STATE OF WYOMING, DO HEREBY CERTIFY THAT THE MAP HEREON REPRESENTS AN ACTUAL SURVEY MADE BY MYSELF AND OR BY PERSONNEL OF KNIGHT TECHNOLOGIES INCORPORATED UNDER MY DIRECT SUPERVISION AND THAT SAID PLAT AND LEGAL DESCRIPTION SHOWN ARE ACCURATELY REPRESENTED.

**NOTE:**  
ALL CENTERLINE BEARINGS AND DISTANCES HEREIN ARE CONSIDERED TO BE MORE OR LESS. THE CENTERLINE OF THE POWERLINE AS CONSTRUCTED IS THE CENTER LINE OF THE 125' WIDE EASEMENT BEING 62.5' ON EACH SIDE



PREPARED BY:  
KNIGHT TECHNOLOGIES, INC.  
201 W. Lakeway Rd.  
Suite 200  
Gillette, WY 82718  
Office: (307) 682-8547



PREPARED FOR: BLACK HILLS POWER, INC. 625 9th STREET P.O. BOX 1400 RAPID CITY, SD 57709		
RIGHT OF WAY EASEMENT IBERLIN RANCH LIMITED PARTNERSHIP		
SEC. 33, T. 43 N., R. 74 W. CAMPBELL COUNTY, WYOMING		
DATE: 06-14-09	DESIGNED BY: KTI	
SCALE: 1" = 1000'	DRAWN BY: KTI/PK	
CNTR INTRVL: N/A	APPROVED BY: KTI/TLM	
REVISION:	DATE:	
FILE: F:\2008-080_BHP_TRANSMISSION_LINE-PHASE2\FINAL\PLATS\WDR_SEC_PLATS_GROUND_WY83-EP		

**RIGHT OF WAY EASEMENT  
BLACK HILLS POWER, INC.  
SECTION 33, T. 43 N., R. 74 W., 6TH P.M.  
CAMPBELL COUNTY, WYOMING**

RECORD OWNER	FOOTAGE	RODS
ROBERT R AND DONA M ROUSH	1427.2'	86.50

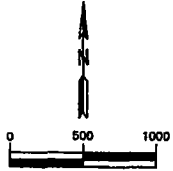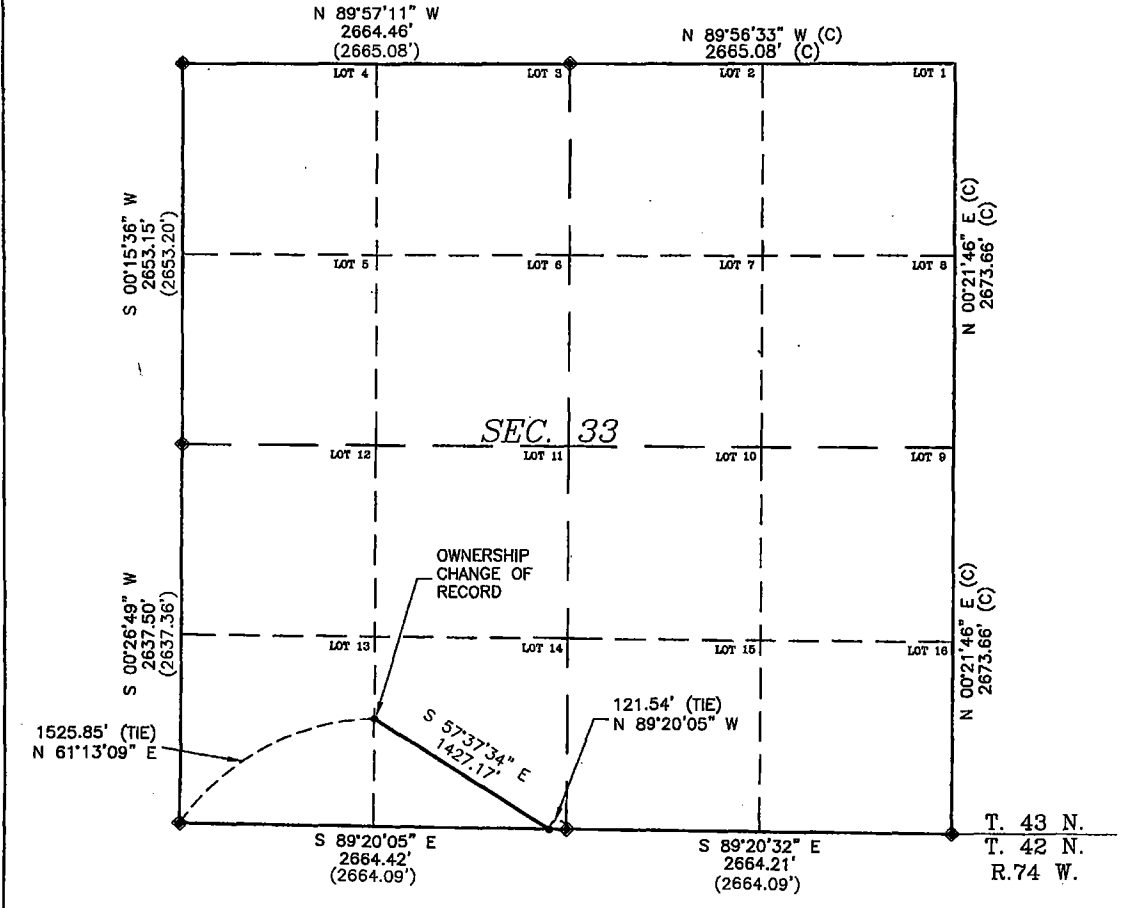

- LEGEND:**
- ◆ 1992 B.L.M. BRASS CAP
  - ( ) RECORDED DISTANCE
  - (C) CALCULATED FROM RECORD
  - CENTERLINE OF RIGHT OF WAY EASEMENT
  - BEGINNING AND END OF ALIGNMENT DESCRIPTION

**BASIS OF BEARING:**  
NAD 83 WYOMING STATE PLANE,  
EAST ZONE—GRID

**LEGAL DESCRIPTION:**

The following is a legal description for a 125 foot wide easement located in a portion of Lot 14 (SE 1/4 SW 1/4) of Section 33, Township 43 North, Range 74 West of the 6th P.M., Campbell County, Wyoming. Said easement being 62.5 feet on each side of the following described centerline:

Commencing at the Southwest corner of said Section 33, said corner being monumented with a 1992 B.L.M. Brass cap, thence N 61°13'09" E, a distance of 1525.85 feet to the True Point of Beginning of said easement centerline;

Thence along said centerline S 57°37'34" E, a distance of 1427.17 feet to a point on the South line of said Section 33, said point being N 89°20'05" W, a distance of 121.54 feet from the South 1/4 corner of said Section 33, being a 1992 B.L.M. Brass cap.

Said easement centerline being 1427.17 feet in length, more or less with side lines shortened or extended to the recorded boundary.



**CERTIFICATE OF SURVEYOR:**  
I, THEODORE L. MCMAHON, BEING A PROFESSIONAL LAND SURVEYOR, REGISTERED UNDER THE LAWS OF THE STATE OF WYOMING, DO HEREBY CERTIFY THAT THE MAP HEREON REPRESENTS AN ACTUAL SURVEY MADE BY MYSELF AND OR BY PERSONNEL OF KNIGHT TECHNOLOGIES INCORPORATED UNDER MY DIRECT SUPERVISION AND THAT SAID PLAT AND LEGAL DESCRIPTION SHOWN ARE ACCURATELY REPRESENTED.

PREPARED FOR:  
BLACK HILLS POWER, INC.  
625 9th STREET  
P.O. BOX 1400  
RAPID CITY, SD 57709



<b>RIGHT OF WAY EASEMENT</b>	
ROBERT R AND DONA M ROUSH	
SEC. 33, T. 43 N., R. 74 W. CAMPBELL COUNTY, WYOMING	
DATE: 06-14-09	DESIGNED BY: KTI
SCALE: 1" = 1000'	DRAWN BY: KTI/PK
CNTR INTRVL: N/A	APPROVED BY: KTI/TLM
REVISION:	DATE: / /



PREPARED BY:  
KNIGHT TECHNOLOGIES, INC.  
201 W. Lakeway Rd.  
Suite 200  
Gillette, WY 82718  
Office: (307) 682-8547



**NOTE:**  
ALL CENTERLINE BEARINGS AND DISTANCES HEREIN ARE CONSIDERED TO BE MORE OR LESS. THE CENTERLINE OF THE POWERLINE AS CONSTRUCTED IS THE CENTER LINE OF THE 125' WIDE EASEMENT BEING 62.5' ON EACH SIDE

**RIGHT OF WAY EASEMENT  
BLACK HILLS POWER, INC.  
SECTION 2, T. 42 N., R. 74 W., 6TH P.M.  
CAMPBELL COUNTY, WYOMING**

RECORD OWNER: IBERLIN RANCH LIMITED PARTNERSHIP      FOOTAGE: 294.7'      RODS: 17.86

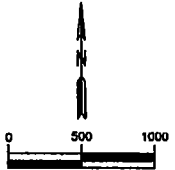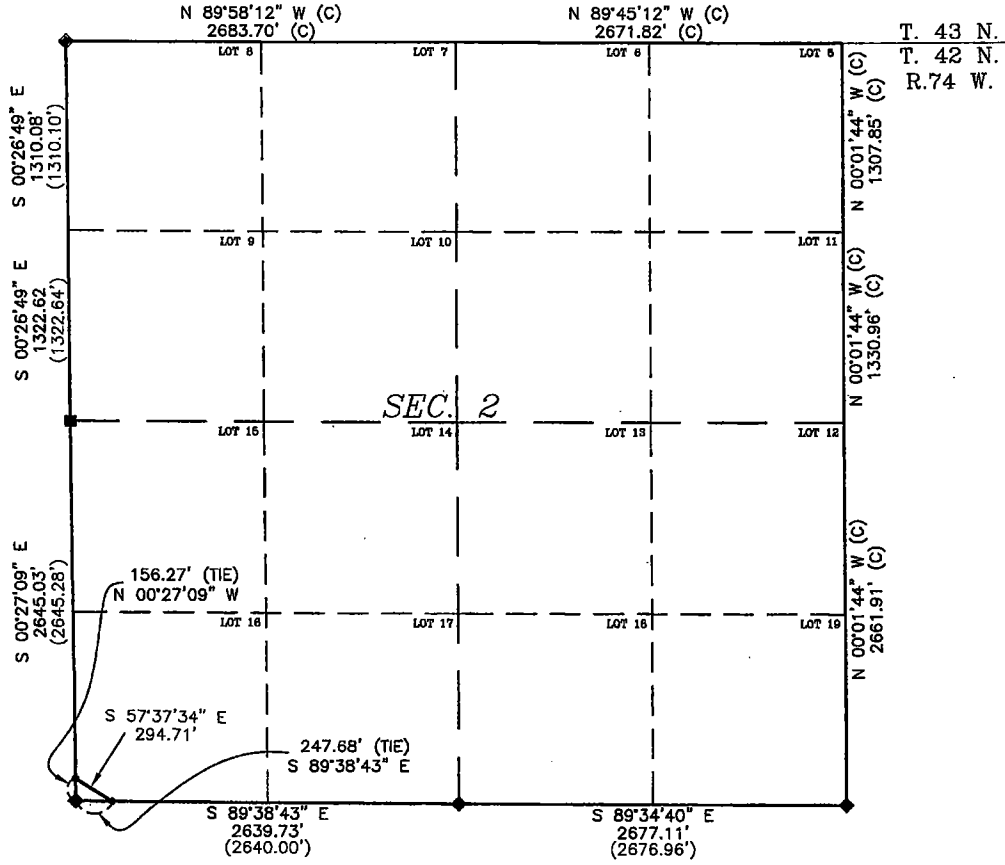

- LEGEND:**
- ◆ 1992 B.L.M. BRASS CAP
  - ◆ 1997 B.L.M. BRASS CAP
  - 1998 B.L.M. BRASS CAP
  - ( ) RECORDED DISTANCE
  - (C) CALCULATED FROM RECORD
  - CENTERLINE OF RIGHT OF WAY EASEMENT
  - BEGINNING AND END OF ALIGNMENT DESCRIPTION

**BASIS OF BEARING:**  
NAD 83 WYOMING STATE PLANE,  
EAST ZONE-GRID

**LEGAL DESCRIPTION:**

The following is a legal description for a 125 foot wide easement located in a portion of Lot 16 (SW 1/4 SW 1/4) of Section 2, Township 42 North, Range 74 West of the 6th P.M., Campbell County, Wyoming. Said easement being 62.5 feet on each side of the following described centerline:

Commencing at the Southwest corner of said Section 2, said corner being monumented with a 1997 B.L.M. Brass cap, thence N 00°27'09" W, a distance of 156.27 feet to the True Point of Beginning of said easement centerline;

Thence along said centerline S 57°37'34" E, a distance of 294.71 feet to a point on the South line of said Section 2, said point being S 89°38'43" E, a distance of 247.68 feet from the Southwest corner of said Section 2, being a 1997 B.L.M. Brass cap.

Said easement centerline being 294.71 feet in length, more or less with side lines shortened or extended to the recorded boundary.



**CERTIFICATE OF SURVEYOR:**  
I, THEODORE L. MCMAHON, BEING A PROFESSIONAL LAND SURVEYOR, REGISTERED UNDER THE LAWS OF THE STATE OF WYOMING, DO HEREBY CERTIFY THAT THE MAP HEREON REPRESENTS AN ACTUAL SURVEY MADE BY MYSELF AND OR BY PERSONNEL OF KNIGHT TECHNOLOGIES INCORPORATED UNDER MY DIRECT SUPERVISION AND THAT SAID PLAT AND LEGAL DESCRIPTION SHOWN ARE ACCURATELY REPRESENTED.

**NOTE:**  
ALL CENTERLINE BEARINGS AND DISTANCES HEREIN ARE CONSIDERED TO BE MORE OR LESS. THE CENTERLINE OF THE POWERLINE AS CONSTRUCTED IS THE CENTER LINE OF THE 125' WIDE EASEMENT BEING 62.5' ON EACH SIDE



PREPARED BY:  
**KNIGHT TECHNOLOGIES, INC.**  
201 W. Lakeway Rd.  
Suite 200  
Gillette, WY 82718  
Office: (307) 682-8547

PREPARED FOR: BLACK HILLS POWER, INC. 685 9th STREET P.O. BOX 1400 RAPID CITY, SD 57708		
<b>RIGHT OF WAY EASEMENT</b> IBERLIN RANCH LIMITED PARTNERSHIP  SEC. 2, T. 42 N., R. 74 W. CAMPBELL COUNTY, WYOMING		
DATE: 06-14-09	DESIGNED BY: KTI	
SCALE: 1" = 1000'	DRAWN BY: KTI/PK	
CNTR INTRVL: N/A	APPROVED BY: KTI/TLM	
REVISION:	DATE: / /	



**RIGHT OF WAY EASEMENT  
BLACK HILLS POWER, INC.  
SECTION 3, T. 42 N., R. 74 W., 6TH P.M.  
CAMPBELL COUNTY, WYOMING**

RECORD OWNER: IBERLIN RANCH LIMITED PARTNERSHIP      FOOTAGE: 6338.0'      RODS: 384.12

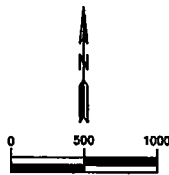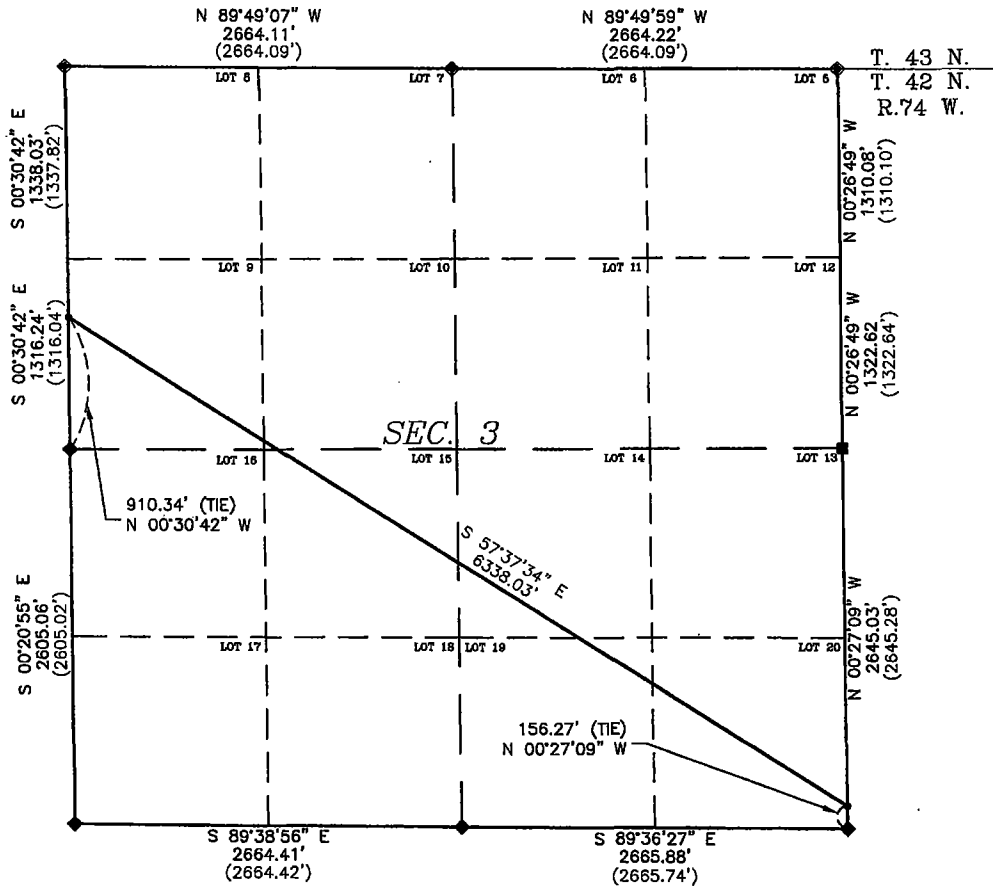

- LEGEND:**
- ◆ 1992 B.L.M. BRASS CAP
  - ◆ 1997 B.L.M. BRASS CAP
  - 1998 B.L.M. BRASS CAP
  - ( ) RECORDED DISTANCE
  - CENTERLINE OF RIGHT OF WAY EASEMENT
  - BEGINNING AND END OF ALIGNMENT DESCRIPTION

**BASIS OF BEARING:**  
NAD 83 WYOMING STATE PLANE,  
EAST ZONE-GRID


**LEGAL DESCRIPTION:**

The following is a legal description for a 125 foot wide easement located in portions of Lot 9 (SW 1/4 NW 1/4), Lot 10 (SE 1/4 NW 1/4), Lot 14 (NW 1/4 SE 1/4), Lot 15 (NE 1/4 SW 1/4), Lot 19 (SW 1/4 SE 1/4), Lot 20 (SE 1/4 SE 1/4) of Section 3, Township 42 North, Range 74 West of the 6th P.M., Campbell County, Wyoming. Said easement being 62.5 feet on each side of the following described centerline:

Commencing at the West 1/4 corner of said Section 3, said corner being monumented with a 1997 B.L.M. Brass cap, thence N 00°30'42" W, a distance of 910.34 feet to the True Point of Beginning of said easement centerline;

Thence along said centerline S 57°37'34" E, a distance of 6338.03 feet to a point on the East line of said Section 3, said point being N 00°27'09" W, a distance of 156.27 feet from the Southeast corner of said Section 3, being a 1997 B.L.M. Brass cap.

Said easement centerline being 6338.03 feet in length, more or less with side lines shortened or extended to the recorded boundary.

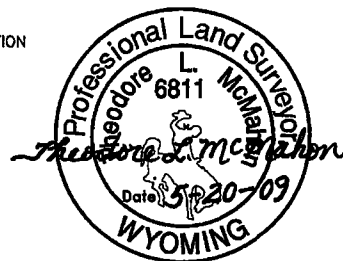

**CERTIFICATE OF SURVEYOR:**  
I, THEODORE L. MCMAHON, BEING A PROFESSIONAL LAND SURVEYOR, REGISTERED UNDER THE LAWS OF THE STATE OF WYOMING, DO HEREBY CERTIFY THAT THE MAP HEREON REPRESENTS AN ACTUAL SURVEY MADE BY MYSELF AND OR BY PERSONNEL OF KNIGHT TECHNOLOGIES INCORPORATED UNDER MY DIRECT SUPERVISION AND THAT SAID PLAT AND LEGAL DESCRIPTION SHOWN ARE ACCURATELY REPRESENTED.

PREPARED FOR:  
BLACK HILLS POWER, INC.  
629 8th STREET  
P.O. BOX 1400  
RAPID CITY, SD. 57709



**RIGHT OF WAY EASEMENT  
IBERLIN RANCH LIMITED PARTNERSHIP**

SEC. 3, T. 42 N., R. 74 W.  
CAMPBELL COUNTY, WYOMING

DATE: 05-14-09	DESIGNED BY: KTI
SCALE: 1" = 1000'	DRAWN BY: KTI/PK
CNTR INTRVL: N/A	APPROVED BY: KTI/TLM
REVISION:	DATE: / /



**NOTE:**  
ALL CENTERLINE BEARINGS AND DISTANCES HEREIN ARE CONSIDERED TO BE MORE OR LESS. THE CENTERLINE OF THE POWERLINE AS CONSTRUCTED IS THE CENTER LINE OF THE 125' WIDE EASEMENT BEING 62.5' ON EACH SIDE

PREPARED BY:  
KNIGHT TECHNOLOGIES, INC.  
201 W. Lakeway Rd.  
Suite 200  
Gillette, WY 82718  
Office: (307) 682-8547



**RIGHT OF WAY EASEMENT  
BLACK HILLS POWER, INC.  
SECTION 4, T. 42 N., R. 74 W., 6TH P.M.  
CAMPBELL COUNTY, WYOMING**

RECORD OWNER: THE LBZ REVOCABLE TRUST      FOOTAGE: 3316.6'      RODS: 201.01

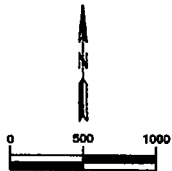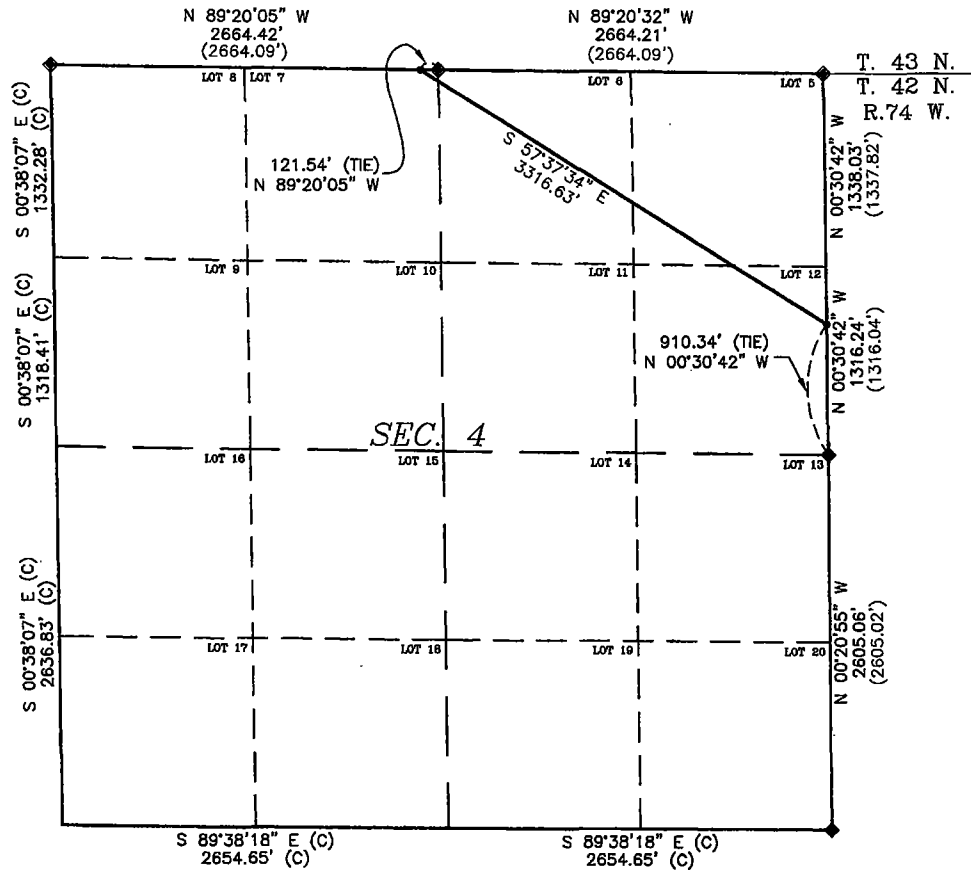

- LEGEND:**
- ◆ 1992 B.L.M. BRASS CAP
  - ◆ 1997 B.L.M. BRASS CAP
  - ( ) RECORDED DISTANCE
  - (C) CALCULATED FROM RECORD
  - CENTERLINE OF RIGHT OF WAY EASEMENT
  - BEGINNING AND END OF ALIGNMENT DESCRIPTION

**BASIS OF BEARING:**  
NAD 83 WYOMING STATE PLANE,  
EAST ZONE-GRID


**LEGAL DESCRIPTION:**

The following is a legal description for a 125 foot wide easement located in portions of Lot 5 (NE 1/4 NE 1/4), Lot 6 (NW 1/4 NE 1/4), Lot 7 (NE 1/4 NW 1/4), Lot 12 (SE 1/4 NE 1/4) of Section 4, Township 42 North, Range 74 West of the 6th P.M., Campbell County, Wyoming. Said easement being 62.5 feet on each side of the following described centerline:

Commencing at the North 1/4 corner of said Section 4, said corner being monumented with a 1992 B.L.M. Brass cap, thence N 89°20'05" W, a distance of 121.54 feet to the True Point of Beginning of said easement centerline;

Thence along said centerline S 57°37'34" E, a distance of 3316.63 feet to a point on the East line of said Section 4, said point being N 00°30'42" W, a distance of 910.34 feet from the East 1/4 corner of said Section 4, being a 1997 B.L.M. Brass cap.

Said easement centerline being 3316.63 feet in length, more or less with side lines shortened or extended to the recorded boundary.

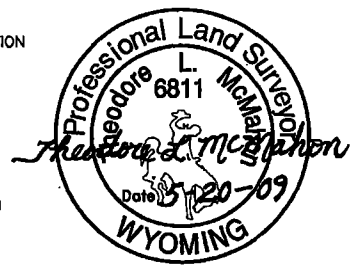

**CERTIFICATE OF SURVEYOR:**  
I, THEODORE L. MCMAHON, BEING A PROFESSIONAL LAND SURVEYOR, REGISTERED UNDER THE LAWS OF THE STATE OF WYOMING, DO HEREBY CERTIFY THAT THE MAP HEREON REPRESENTS AN ACTUAL SURVEY MADE BY MYSELF AND OR BY PERSONNEL OF KNIGHT TECHNOLOGIES INCORPORATED UNDER MY DIRECT SUPERVISION AND THAT SAID PLAT AND LEGAL DESCRIPTION SHOWN ARE ACCURATELY REPRESENTED.

PREPARED FOR:  
BLACK HILLS POWER, INC.  
626 9th STREET  
P.O. BOX 1400  
RAPID CITY, SD 57709



**RIGHT OF WAY EASEMENT  
THE LBZ REVOCABLE TRUST  
SEC. 4, T. 42 N., R. 74 W.  
CAMPBELL COUNTY, WYOMING**

**NOTE:**  
ALL CENTERLINE BEARINGS AND DISTANCES HEREIN ARE CONSIDERED TO BE MORE OR LESS. THE CENTERLINE OF THE POWERLINE AS CONSTRUCTED IS THE CENTER LINE OF THE 125' WIDE EASEMENT BEING 62.5' ON EACH SIDE



PREPARED BY:  
KNIGHT TECHNOLOGIES, INC.  
201 W. Lakeway Rd.  
Suite 200  
Gillette, WY 82718  
Office: (307) 682-8547



DATE: 05-14-09	DESIGNED BY: KTI
SCALE: 1" = 1000'	DRAWN BY: KTI/PK
CNTR INTRVL: N/A	APPROVED BY: KTI/TLM
REVISION:	DATE: / /

**RIGHT OF WAY EASEMENT  
BLACK HILLS POWER, INC.  
SECTION 11, T. 42 N., R. 74 W., 6TH P.M.  
CAMPBELL COUNTY, WYOMING**

<b>RECORD OWNER</b>	<b>FOOTAGE</b>	<b>RODS</b>
ROBERT R AND DONA M ROUSH ROUSH FAMILY TRUST	6384.6'	386.95

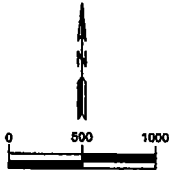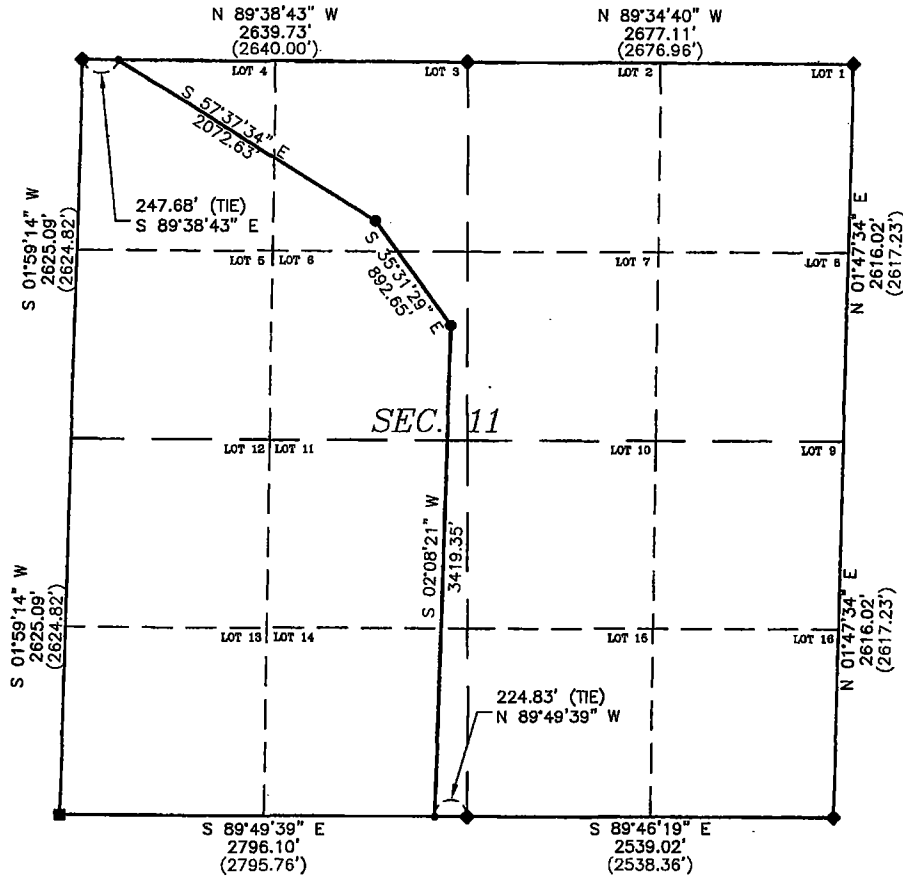

- LEGEND:**
- ◆ 1997 B.L.M. BRASS CAP
  - 1998 B.L.M. BRASS CAP
  - ( ) RECORDED DISTANCE
  - CENTERLINE OF RIGHT OF WAY EASEMENT
  - BEGINNING AND END OF ALIGNMENT DESCRIPTION
  - POWER LINE PI LOCATION

**BASIS OF BEARING:**  
NAD 83 WYOMING STATE PLANE,  
EAST ZONE—GRID


**LEGAL DESCRIPTION:**

The following is a legal description for a 125 foot wide easement located in portions of Lot 3 (NE 1/4 NW 1/4), Lot 4 (NW 1/4 NW 1/4), Lot 6 (SE 1/4 NW 1/4), Lot 11 (NE 1/4 SW 1/4), Lot 14 (SE 1/4 SW 1/4) of Section 11, Township 42 North, Range 74 West of the 6th P.M., Campbell County, Wyoming. Said easement being 62.5 feet on each side of the following described centerline:

Commencing at the Northwest corner of said Section 11, said corner being monumented with a 1997 B.L.M. Brass cap, thence S 89°38'43" E, a distance of 247.68 feet to the True Point of Beginning of said easement centerline;

Thence along said centerline S 57°37'34" E, a distance of 2072.63 feet to a point;  
Thence along said centerline S 35°31'29" E, a distance of 892.65 feet to a point;  
Thence along said centerline S 02°08'21" W, a distance of 3419.35 to a point on the South line of said Section 11, said point being N 89°49'39" W, a distance of 224.83 feet from the South 1/4 corner of said Section 11, being a 1997 B.L.M. Brass cap.

Said easement centerline being 6384.63 feet in length, more or less with side lines shortened or extended to the recorded boundary.

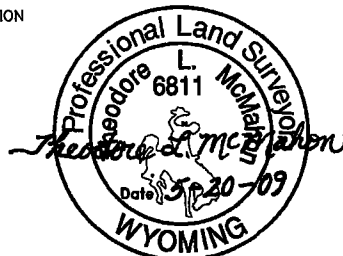

**CERTIFICATE OF SURVEYOR:**  
I, THEODORE L. MCMAHON, BEING A PROFESSIONAL LAND SURVEYOR, REGISTERED UNDER THE LAWS OF THE STATE OF WYOMING, DO HEREBY CERTIFY THAT THE MAP HEREON REPRESENTS AN ACTUAL SURVEY MADE BY MYSELF AND OR BY PERSONNEL OF KNIGHT TECHNOLOGIES INCORPORATED UNDER MY DIRECT SUPERVISION AND THAT SAID PLAT AND LEGAL DESCRIPTION SHOWN ARE ACCURATELY REPRESENTED.

PREPARED FOR:  
BLACK HILLS POWER, INC.  
625 9th STREET  
P.O. BOX 1400  
RAPID CITY, SD 57708



**RIGHT OF WAY EASEMENT**  
ROBERT R AND DONA M ROUSH  
ROUSH FAMILY TRUST  
SEC. 11, T. 42 N., R. 74 W.  
CAMPBELL COUNTY, WYOMING

**NOTE:**  
ALL CENTERLINE BEARINGS AND DISTANCES HEREIN ARE CONSIDERED TO BE MORE OR LESS. THE CENTERLINE OF THE POWERLINE AS CONSTRUCTED IS THE CENTER LINE OF THE 125' WIDE EASEMENT BEING 62.5' ON EACH SIDE

PREPARED BY:  
KNIGHT TECHNOLOGIES, INC.  
201 W. Lakeway Rd.  
Suite 200  
Gillette, WY 82718  
Office: (307) 682-8547





DATE: 06-14-09	DESIGNED BY: KTI
SCALE: 1" = 1000'	DRAWN BY: KTI/PK
CNTR INTVL: N/A	APPROVED BY: KTI/TLM
REVISION:	DATE: / /

**RIGHT OF WAY EASEMENT  
BLACK HILLS POWER, INC.**

**SECTION 13, T. 42 N., R. 74 W., 6TH P.M.  
CAMPBELL COUNTY, WYOMING**

RECORD OWNER	FOOTAGE	RODS
LELAND J TURNER, KAREN TURNER, JENNIFER LOUISE TURNER, WENDY CHRISTINE TURNER, MICHAEL WILLIAM TURNER	2159.3'	130.87

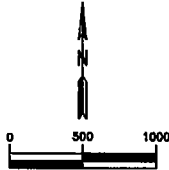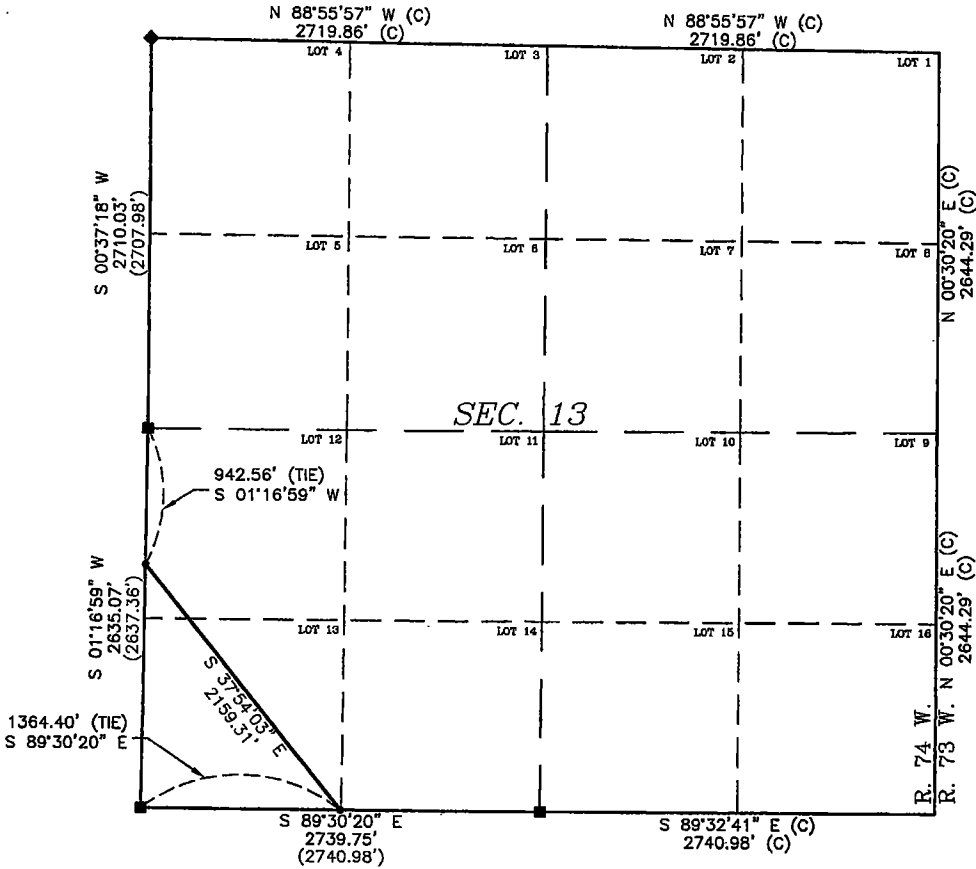

- LEGEND:**
- ◆ 1997 B.L.M. BRASS CAP
  - 1998 B.L.M. BRASS CAP
  - ( ) RECORDED DISTANCE
  - (C) CALCULATED FROM RECORD
  - CENTERLINE OF RIGHT OF WAY EASEMENT
  - BEGINNING AND END OF ALIGNMENT DESCRIPTION

**BASIS OF BEARING:**  
NAD 83 WYOMING STATE PLANE,  
EAST ZONE-GRID

**LEGAL DESCRIPTION:**

The following is a legal description for a 125 foot wide easement located in portions of Lot 12 (NW 1/4 SW 1/4), Lot 13 (SW 1/4 SW 1/4) and Lot 14 (SE 1/4 SW 1/4) of Section 13, Township 42 North, Range 74 West of the 6th P.M., Campbell County, Wyoming. Said easement being 62.5 feet on each side of the following described centerline:

Commencing at the West 1/4 corner of said Section 13, said corner being monumented with a 1998 B.L.M. Brass cap, thence S 01°16'59" W, a distance of 942.56 feet to the True Point of Beginning of said easement centerline;

Thence along said centerline S 37°54'03" E, a distance of 2159.31 feet to a point on the South line of said Section 13, said point being S 89°30'20" E, a distance of 1364.40 feet from the Southwest corner of said Section 13, being a 1998 B.L.M. Brass cap.

Said easement centerline being 2159.31 feet in length, more or less with side lines shortened or extended to the recorded boundary.



**CERTIFICATE OF SURVEYOR:**  
I, THEODORE L. MCMAHON, BEING A PROFESSIONAL LAND SURVEYOR, REGISTERED UNDER THE LAWS OF THE STATE OF WYOMING, DO HEREBY CERTIFY THAT THE MAP HEREON REPRESENTS AN ACTUAL SURVEY MADE BY MYSELF AND OR BY PERSONNEL OF KNIGHT TECHNOLOGIES INCORPORATED UNDER MY DIRECT SUPERVISION AND THAT SAID PLAT AND LEGAL DESCRIPTION SHOWN ARE ACCURATELY REPRESENTED.

PREPARED FOR:  
BLACK HILLS POWER, INC.  
625 9th STREET  
P.O. BOX 1400  
RAPID CITY, SD 57709



**RIGHT OF WAY EASEMENT**  
L J TURNER, K TURNER, J L TURNER,  
W C TURNER, M W TURNER  
SEC. 13, T. 42 N., R. 74 W.  
CAMPBELL COUNTY, WYOMING

**NOTE:**  
ALL CENTERLINE BEARINGS AND DISTANCES HEREIN ARE CONSIDERED TO BE MORE OR LESS. THE CENTERLINE OF THE POWERLINE AS CONSTRUCTED IS THE CENTER LINE OF THE 125' WIDE EASEMENT BEING 62.5' ON EACH SIDE

PREPARED BY:  
KNIGHT TECHNOLOGIES, INC.



201 W. Lakeway Rd.  
Suite 200  
Gillette, WY 82718  
Office: (307) 682-8547



DATE: 08-31-09	DESIGNED BY: KTI
SCALE: 1" = 1000'	DRAWN BY: KTI/PK
CNTR INTVL: N/A	APPROVED BY: KTI/TLM
REVISION:	DATE: / /

**RIGHT OF WAY EASEMENT  
BLACK HILLS POWER, INC.  
SECTION 14, T. 42 N., R. 74 W., 6TH P.M.  
CAMPBELL COUNTY, WYOMING**

RECORD OWNER NINE MILE LAND COMPANY	FOOTAGE 2553.4'	RODS 154.75
--	--------------------	----------------

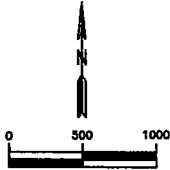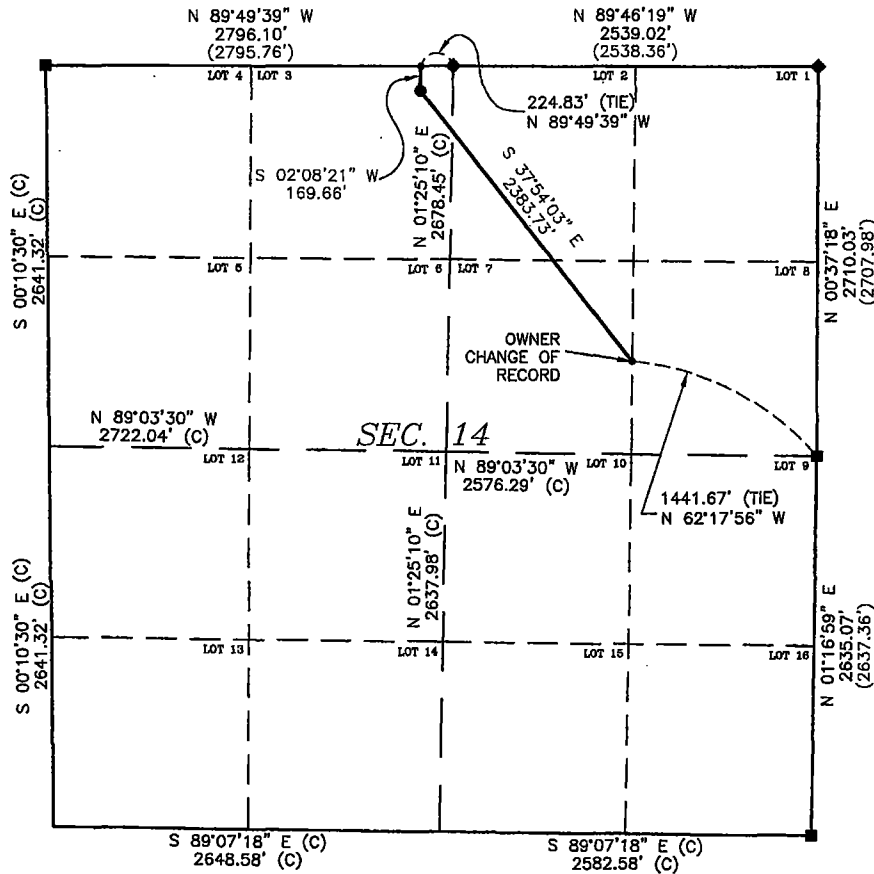

- LEGEND:**
- ◆ 1997 B.L.M. BRASS CAP
  - 1998 B.L.M. BRASS CAP
  - ( ) RECORDED DISTANCE
  - (C) CALCULATED FROM RECORD
  - CENTERLINE OF RIGHT OF WAY EASEMENT
  - BEGINNING AND END OF ALIGNMENT DESCRIPTION
  - POWER LINE PI LOCATION

**BASIS OF BEARING:**  
NAD 83 WYOMING STATE PLANE,  
EAST ZONE—GRID


**LEGAL DESCRIPTION:**

The following is a legal description for a 125 foot wide easement located in portions of Lot 2 (NW 1/4 NE 1/4), Lot 3 (NE 1/4 NW 1/4) and Lot 7 (SW 1/4 NE 1/4) of Section 14, Township 42 North, Range 74 West of the 6th P.M., Campbell County, Wyoming. Said easement being 62.5 feet on each side of the following described centerline:

Commencing at the North 1/4 corner of said Section 14, said corner being monumented with a 1997 B.L.M. Brass cap, thence N 89°49'39" W, a distance of 224.83 feet to the True Point of Beginning of said easement centerline;

Thence along said centerline S 02°08'21" W, a distance of 169.66 feet to a point; Thence along said centerline S 37°54'03" E, a distance of 2383.73 feet to a point on the East line of said Lot 7 (SW 1/4 NE 1/4) of Section 14, said point being N 62°17'56" W, a distance of 1441.67 feet from the East 1/4 corner of said Section 14, being a 1998 B.L.M. Brass cap.

Said easement centerline being 2553.39 feet in length, more or less with side lines shortened or extended to the recorded boundary.

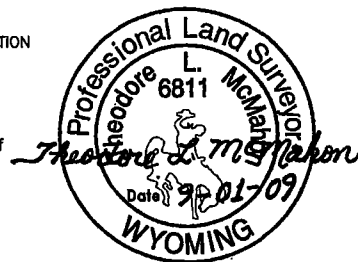

**CERTIFICATE OF SURVEYOR:**  
I, THEODORE L. MCMAHON, BEING A PROFESSIONAL LAND SURVEYOR, REGISTERED UNDER THE LAWS OF THE STATE OF WYOMING, DO HEREBY CERTIFY THAT THE MAP HEREON REPRESENTS AN ACTUAL SURVEY MADE BY MYSELF AND OR BY PERSONNEL OF KNIGHT TECHNOLOGIES INCORPORATED UNDER MY DIRECT SUPERVISION AND THAT SAID PLAT AND LEGAL DESCRIPTION SHOWN ARE ACCURATELY REPRESENTED.

PREPARED FOR:  
BLACK HILLS POWER, INC.  
625 8th STREET  
P.O. BOX 1400  
RAPID CITY, SD 57709



**RIGHT OF WAY EASEMENT  
NINE MILE LAND COMPANY**

SEC. 14, T. 42 N., R. 74 W.  
CAMPBELL COUNTY, WYOMING

DATE: 08-31-08	DESIGNED BY: KTI
SCALE: 1" = 1000'	DRAWN BY: KTI/JMB
CNTR INTVL: N/A	APPROVED BY: KTI/TLM
REVISION:	DATE: / /



**NOTE:**  
ALL CENTERLINE BEARINGS AND DISTANCES HEREIN ARE CONSIDERED TO BE MORE OR LESS. THE CENTERLINE OF THE POWERLINE AS CONSTRUCTED IS THE CENTER LINE OF THE 125' WIDE EASEMENT BEING 62.5' ON EACH SIDE

PREPARED BY:  
KNIGHT TECHNOLOGIES, INC.  
201 W. Lakeway Rd.  
Suite 200  
Gillette, WY 82718  
Office: (307) 682-8547



**RIGHT OF WAY EASEMENT  
BLACK HILLS POWER, INC.  
SECTION 14, T. 42 N., R. 74 W., 6TH P.M.  
CAMPBELL COUNTY, WYOMING**

<b>RECORD OWNER</b>	<b>FOOTAGE</b>	<b>RODS</b>
LELAND J TURNER, KAREN TURNER, JENNIFER LOUISE TURNER, WENDY CHRISTINE TURNER, MICHAEL WILLIAM TURNER	2043.5'	123.85

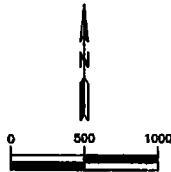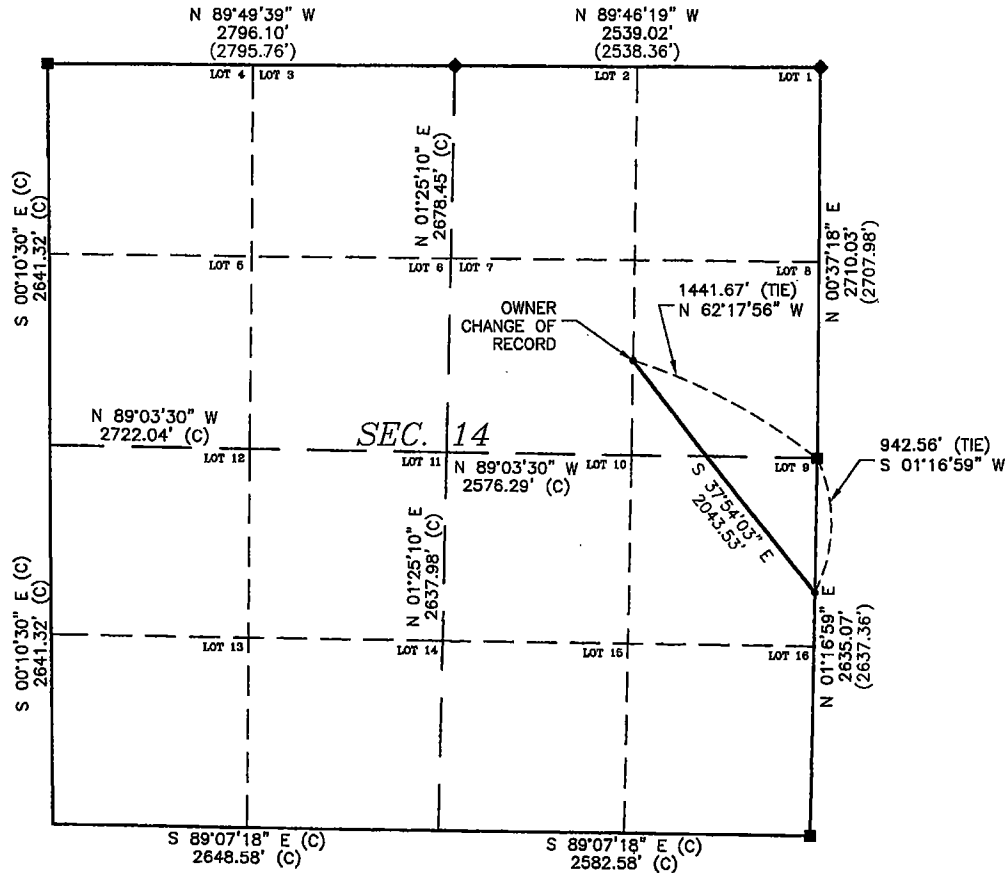

- LEGEND:**
- ◆ 1997 B.L.M. BRASS CAP
  - 1998 B.L.M. BRASS CAP
  - ( ) RECORDED DISTANCE
  - (C) CALCULATED FROM RECORD
  - CENTERLINE OF RIGHT OF WAY EASEMENT
  - BEGINNING AND END OF ALIGNMENT DESCRIPTION

**BASIS OF BEARING:**  
NAD 83 WYOMING STATE PLANE,  
EAST ZONE-GRID


**LEGAL DESCRIPTION:**

The following is a legal description for a 125 foot wide easement located in portions of Lot 8 (SE 1/4 NE 1/4) and Lot 9 (NE 1/4 SE 1/4) of Section 14, Township 42 North, Range 74 West of the 6th P.M., Campbell County, Wyoming. Said easement being 62.5 feet on each side of the following described centerline:

Commencing at the East 1/4 corner of said Section 14, said corner being monumented with a 1998 B.L.M. Brass cap, thence N 62°17'56" W, a distance of 1441.67 feet to the True Point of Beginning of said easement centerline;

Thence along said centerline S 37°54'03" E, a distance of 2043.53 feet to a point on the East line of said Section 14, said point being S 01°16'59" W, a distance of 942.56 feet from the East 1/4 corner of said Section 14, being a 1998 B.L.M. Brass cap.

Said easement centerline being 2043.53 feet in length, more or less with side lines shortened or extended to the recorded boundary.

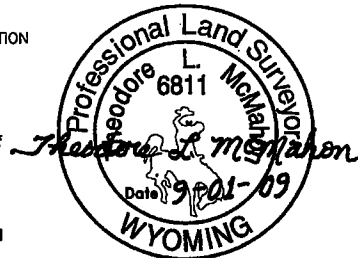

**CERTIFICATE OF SURVEYOR:**  
I, THEODORE L. MCMAHON, BEING A PROFESSIONAL LAND SURVEYOR, REGISTERED UNDER THE LAWS OF THE STATE OF WYOMING, DO HEREBY CERTIFY THAT THE MAP HEREON REPRESENTS AN ACTUAL SURVEY MADE BY MYSELF AND OR BY PERSONNEL OF KNIGHT TECHNOLOGIES INCORPORATED UNDER MY DIRECT SUPERVISION AND THAT SAID PLAT AND LEGAL DESCRIPTION SHOWN ARE ACCURATELY REPRESENTED.

PREPARED FOR:  
BLACK HILLS POWER, INC.  
825 9th STREET  
P.O. BOX 1400  
RAPID CITY, SD 57709

**RIGHT OF WAY EASEMENT**  
L J TURNER, K TURNER, J L TURNER,  
W C TURNER, M W TURNER  
SEC. 14, T. 42 N., R. 74 W.  
CAMPBELL COUNTY, WYOMING

**NOTE:**  
ALL CENTERLINE BEARINGS AND DISTANCES HEREIN ARE CONSIDERED TO BE MORE OR LESS. THE CENTERLINE OF THE POWERLINE AS CONSTRUCTED IS THE CENTER LINE OF THE 125' WIDE EASEMENT BEING 62.5' ON EACH SIDE



PREPARED BY:  
KNIGHT TECHNOLOGIES, INC.  
201 W. Lakeway Rd.  
Suite 200  
Gillette, WY 82718  
Office: (307) 682-8547



DATE: 08-31-09	DESIGNED BY: KTI
SCALE: 1" = 1000'	DRAWN BY: KTI/PK
CNTR INTVL: N/A	APPROVED BY: KTI/TLM
REVISION:	DATE: / /

**RIGHT OF WAY EASEMENT  
BLACK HILLS POWER, INC.  
SECTION 24, T. 42 N., R. 74 W., 6TH P.M.  
CAMPBELL COUNTY, WYOMING**

<b>RECORD OWNER</b>	<b>FOOTAGE</b>	<b>RODS</b>
LELAND J TURNER, KAREN TURNER, JENNIFER LOUISE TURNER, WENDY CHRISTINE TURNER, MICHAEL WILLIAM TURNER	6583.1'	398.98

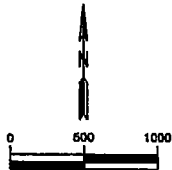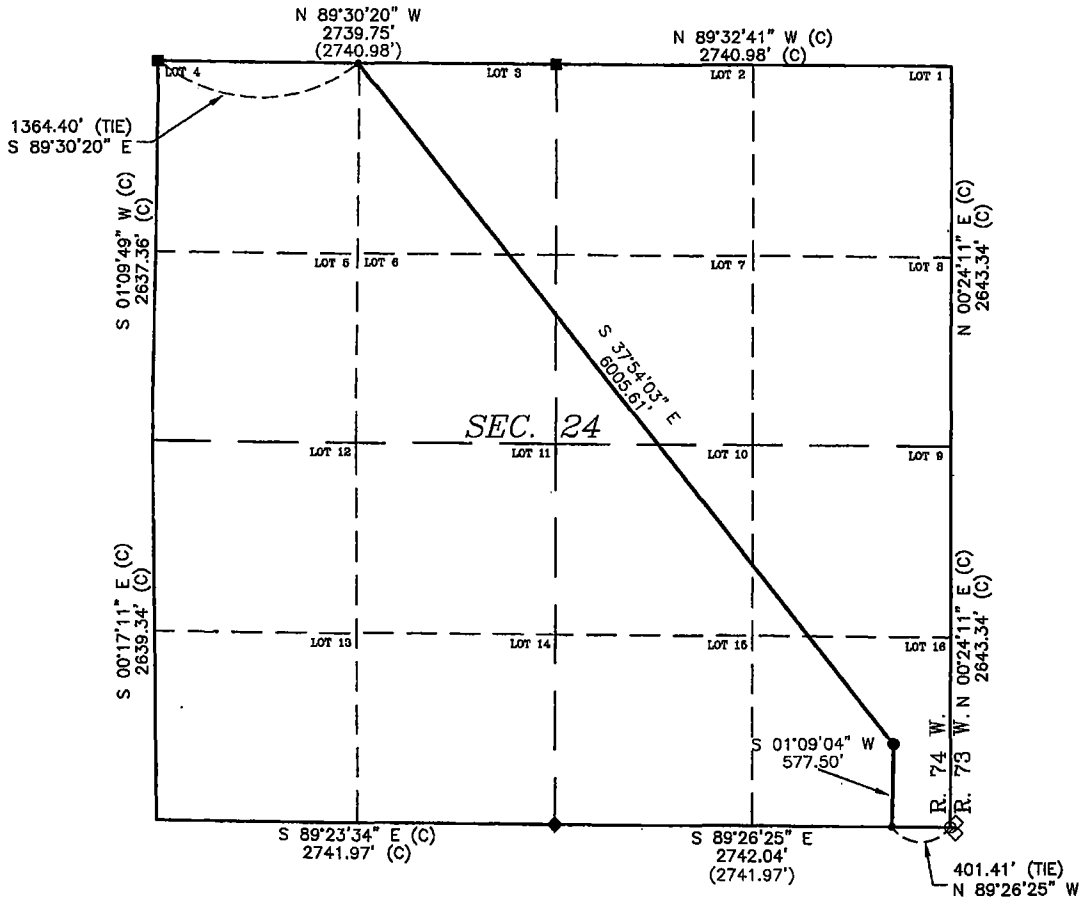

- LEGEND:**
- ◆ 1997 B.L.M. BRASS CAP
  - 1998 B.L.M. BRASS CAP
  - ◇ REFERENCE MARKER
  - CALCULATED CORNER POSITION (NOT SET)
  - ( ) RECORDED DISTANCE
  - (C) CALCULATED FROM RECORD
  - CENTERLINE OF RIGHT OF WAY EASEMENT
  - BEGINNING AND END OF ALIGNMENT DESCRIPTION
  - POWER LINE PI LOCATION

**BASIS OF BEARING:**  
NAD 83 WYOMING STATE PLANE,  
EAST ZONE-GRID



**LEGAL DESCRIPTION:**

The following is a legal description for a 125 foot wide easement located in portions of Lot 3 (NE 1/4 NW 1/4), Lot 4 (NW 1/4 NW 1/4), Lot 6 (SE 1/4 NW 1/4), Lot 7 (SW 1/4 NE 1/4), Lot 9 (NE 1/4 SE 1/4), Lot 10 (NW 1/4 SE 1/4) and Lot 16 (SE 1/4 SE 1/4) of Section 24, Township 42 North, Range 74 West of the 6th P.M., Campbell County, Wyoming. Said easement being 62.5 feet on each side of the following described centerline:

Commencing at the Northwest corner of said Section 24, said corner being monumented with a 1998 B.L.M. Brass cap, thence S 89°30'20" E, a distance of 1364.40 feet to the True Point of Beginning of said easement centerline;

Thence along said centerline S 37°54'03" E, a distance of 6005.61 feet to a point;  
Thence along said centerline S 01°09'04" W, a distance of 577.50 feet to a point on the South line of said Section 24, said point being N 89°26'25" W, a distance of 401.41 feet from the Southeast corner of said Section 24, said corner being referenced with two B.L.M. reference markers.

Said easement centerline being 6583.11 feet in length, more or less with side lines shortened or extended to the recorded boundary.

**CERTIFICATE OF SURVEYOR:**  
I, THEODORE L. MCMAHON, BEING A PROFESSIONAL LAND SURVEYOR, REGISTERED UNDER THE LAWS OF THE STATE OF WYOMING, DO HEREBY CERTIFY THAT THE MAP HEREON REPRESENTS AN ACTUAL SURVEY MADE BY MYSELF AND OR BY PERSONNEL OF KNIGHT TECHNOLOGIES INCORPORATED UNDER MY DIRECT SUPERVISION AND THAT SAID PLAT AND LEGAL DESCRIPTION SHOWN ARE ACCURATELY REPRESENTED.

PREPARED FOR: BLACK HILLS POWER, INC. 625 9th STREET P.O. BOX 1400 RAPID CITY, SD 57709		
<b>RIGHT OF WAY EASEMENT</b> L J TURNER, K TURNER, J L TURNER, W C TURNER, M W TURNER SEC. 24, T. 42 N., R. 74 W. CAMPBELL COUNTY, WYOMING		
DATE: 08-31-09	DESIGNED BY: KTI	
SCALE: 1" = 1000'	DRAWN BY: KTI/PK	
CNTR INTVL: N/A	APPROVED BY: KTI/TLM	
REVISION:	DATE: / /	



**NOTE:**  
ALL CENTERLINE BEARINGS AND DISTANCES HEREIN ARE CONSIDERED TO BE MORE OR LESS. THE CENTERLINE OF THE POWERLINE AS CONSTRUCTED IS THE CENTER LINE OF THE 125' WIDE EASEMENT BEING 62.5' ON EACH SIDE

PREPARED BY:  
KNIGHT TECHNOLOGIES, INC.  
201 W. Lakeway Rd.  
Suite 200  
Gillette, WY 82718  
Office: (307) 682-8547



**RIGHT OF WAY EASEMENT  
BLACK HILLS POWER, INC.  
SECTION 25, T. 42 N., R. 74 W., 6TH P.M.  
CAMPBELL COUNTY, WYOMING**

RECORD OWNER	FOOTAGE	RODS
LELAND J TURNER, KAREN TURNER, JENNIFER LOUISE TURNER, WENDY CHRISTINE TURNER, MICHAEL WILLIAM TURNER	5284.7	320.28

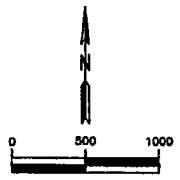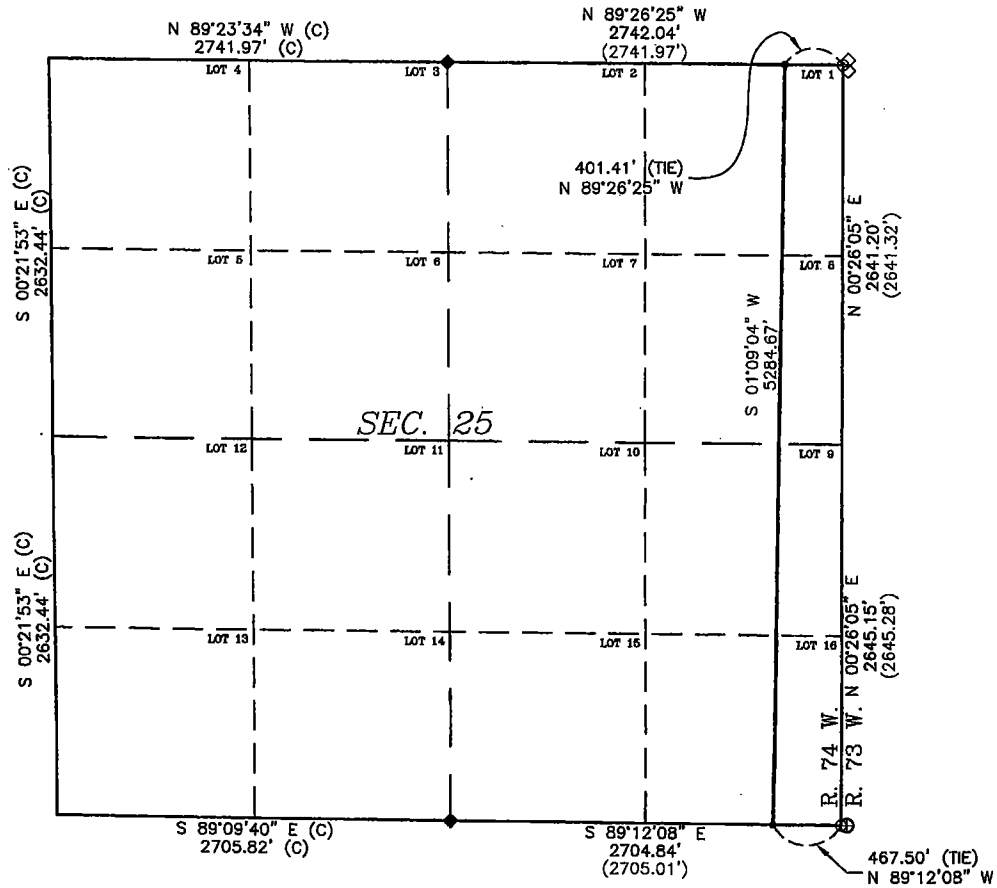

- LEGEND:**
- ◆ 1997 B.L.M. BRASS CAP
  - ⊕ 1980 LS 2327 ALUMINUM CAP WITNESS CORNER
  - ◇ REFERENCE MARKER
  - CALCULATED CORNER POSITION (NOT SET)
  - ( ) RECORDED DISTANCE
  - (C) CALCULATED FROM RECORD
  - CENTERLINE OF RIGHT OF WAY EASEMENT
  - BEGINNING AND END OF ALIGNMENT DESCRIPTION

**BASIS OF BEARING:**  
NAD 83 WYOMING STATE PLANE,  
EAST ZONE-GRID



**LEGAL DESCRIPTION:**

The following is a legal description for a 125 foot wide easement located in portions of Lot 1 (NE 1/4 NE 1/4), Lot 8 (SE 1/4 NE 1/4), Lot 9 (NE 1/4 SE 1/4) and Lot 16 (SE 1/4 SE 1/4) of Section 25, Township 42 North, Range 74 West of the 6th P.M., Campbell County, Wyoming. Said easement being 62.5 feet on each side of the following described centerline:

Commencing at the Northeast corner of said Section 25, said corner being referenced with two B.L.M. reference markers, thence N 89°26'25" W, a distance of 401.41 feet to the True Point of Beginning of said easement centerline;

Thence along said centerline S 01°09'04" W, a distance of 5284.67 feet to a point on the South line of said Section 25, said point being N 89°12'08" W, a distance of 467.50 feet from the Southeast corner of said Section 25, being referenced with a 1980 LS 2327 Aluminum cap.

Said easement centerline being 5284.67 feet in length, more or less with side lines shortened or extended to the recorded boundary.

**CERTIFICATE OF SURVEYOR:**  
I, THEODORE L. MCMAHON, BEING A PROFESSIONAL LAND SURVEYOR, REGISTERED UNDER THE LAWS OF THE STATE OF WYOMING, DO HEREBY CERTIFY THAT THE MAP HEREON REPRESENTS AN ACTUAL SURVEY MADE BY MYSELF AND OR BY PERSONNEL OF KNIGHT TECHNOLOGIES INCORPORATED UNDER MY DIRECT SUPERVISION AND THAT SAID PLAT AND LEGAL DESCRIPTION SHOWN ARE ACCURATELY REPRESENTED.

PREPARED FOR:  
BLACK HILLS POWER, INC.  
626 8th STREET  
P.O. BOX 1400  
RAPID CITY, SD 57709



**RIGHT OF WAY EASEMENT**  
L J TURNER, K TURNER, J L TURNER,  
W C TURNER, M W TURNER  
SEC. 25, T. 42 N., R. 74 W.  
CAMPBELL COUNTY, WYOMING

**NOTE:**  
ALL CENTERLINE BEARINGS AND DISTANCES HEREIN ARE CONSIDERED TO BE MORE OR LESS. THE CENTERLINE OF THE POWERLINE AS CONSTRUCTED IS THE CENTER LINE OF THE 125' WIDE EASEMENT BEING 62.5' ON EACH SIDE

PREPARED BY:  
KNIGHT TECHNOLOGIES, INC.  
201 W. Lakeway Rd.  
Suite 200  
Gillette, WY 82718  
Office: (307) 682-8547





DATE: 05-29-09	DESIGNED BY: KTI
SCALE: 1" = 1000'	DRAWN BY: KTI/PK
CNTR INTVL: N/A	APPROVED BY: KTI/TLM
REVISION:	DATE: / /



**RIGHT OF WAY EASEMENT  
BLACK HILLS POWER, INC.  
SECTION 36, T. 42 N., R. 74 W., 6TH P.M.  
CAMPBELL COUNTY, WYOMING**

RECORD OWNER: NINE MILE LAND COMPANY      FOOTAGE: 2643.0'      RODS: 160.18

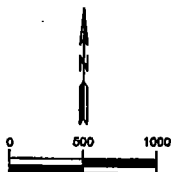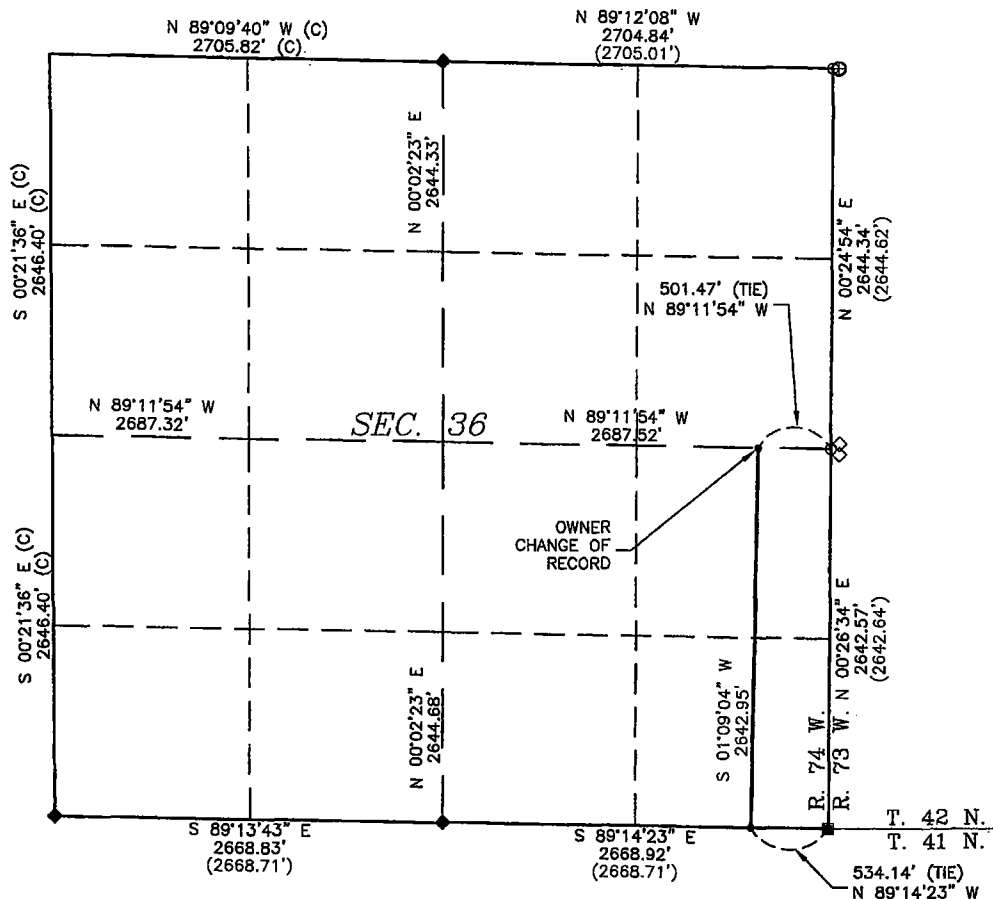

- LEGEND:**
- 1955 B.L.M. BRASS CAP
  - ◆ 1997 B.L.M. BRASS CAP
  - ⊕ 1980 LS 2327 ALUMINUM CAP WITNESS CORNER
  - ◇ REFERENCE MARKER
  - CALCULATED CORNER POSITION (NOT SET)
  - ( ) RECORDED DISTANCE
  - (C) CALCULATED FROM RECORD
  - CENTERLINE OF RIGHT OF WAY EASEMENT
  - BEGINNING AND END OF ALIGNMENT DESCRIPTION

**BASIS OF BEARING:**  
NAD 83 WYOMING STATE PLANE,  
EAST ZONE-GRID


**LEGAL DESCRIPTION:**

The following is a legal description for a 125 foot wide easement located in portions of NE 1/4 SE 1/4 and SE 1/4 SE 1/4 of Section 36, Township 42 North, Range 74 West of the 6th P.M., Campbell County, Wyoming. Said easement being 62.5 feet on each side of the following described centerline:

Commencing at the East 1/4 corner of said Section 36, said corner being referenced with two B.L.M. Brass caps, thence N 89°11'54" W, a distance of 501.47 feet to the True Point of Beginning of said easement centerline;

Thence along said centerline S 01°09'04" W, a distance of 2642.95 feet to a point on the South line of said Section 36, said point being N 89°14'23" W, a distance of 534.14 feet from the Southeast corner of said Section 36, being a 1955 B.L.M. Brass cap.

Said easement centerline being 2642.95 feet in length, more or less with side lines shortened or extended to the recorded boundary.

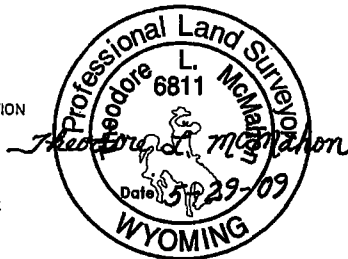

**CERTIFICATE OF SURVEYOR:**  
I, THEODORE L. MCMAHON, BEING A PROFESSIONAL LAND SURVEYOR, REGISTERED UNDER THE LAWS OF THE STATE OF WYOMING, DO HEREBY CERTIFY THAT THE MAP HEREON REPRESENTS AN ACTUAL SURVEY MADE BY MYSELF AND OR BY PERSONNEL OF KNIGHT TECHNOLOGIES INCORPORATED UNDER MY DIRECT SUPERVISION AND THAT SAID PLAT AND LEGAL DESCRIPTION SHOWN ARE ACCURATELY REPRESENTED.

**NOTE:**  
ALL CENTERLINE BEARINGS AND DISTANCES HEREIN ARE CONSIDERED TO BE MORE OR LESS. THE CENTERLINE OF THE POWERLINE AS CONSTRUCTED IS THE CENTER LINE OF THE 125' WIDE EASEMENT BEING 62.5' ON EACH SIDE



PREPARED BY:  
**KNIGHT TECHNOLOGIES, INC.**  
201 W. Lakeway Rd.  
Suite 200  
Gillette, WY 82718  
Office: (307) 682-8547



PREPARED FOR: BLACK HILLS POWER, INC. 825 9th STREET P.O. BOX 1400 RAPID CITY, SD 57709		<b>BHP</b> BLACK HILLS POWER
<b>RIGHT OF WAY EASEMENT NINE MILE LAND COMPANY</b>		
SEC. 36, T. 42 N., R. 74 W. CAMPBELL COUNTY, WYOMING		
DATE: 06-29-09	DESIGNED BY: KTI	
SCALE: 1" = 1000'	DRAWN BY: KTI/PK	
CNTR INTRVL: N/A	APPROVED BY: KTI/TLM	
REVISION:	DATE:	
FILE: F:\2008-020_BRP_TRANSMISSION_LINE-PHASE2\FINAL\PLATS\HDR_SEC_PLATS_GROUND_WY85-EP		

**RIGHT OF WAY EASEMENT  
BLACK HILLS POWER, INC.  
SECTION 1, T. 41 N., R. 74 W., 6TH P.M.  
CAMPBELL COUNTY, WYOMING**

RECORD OWNER: NINE MILE LAND COMPANY      FOOTAGE: 5284.9'      RODS: 320.30

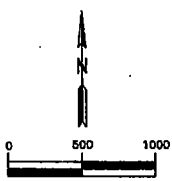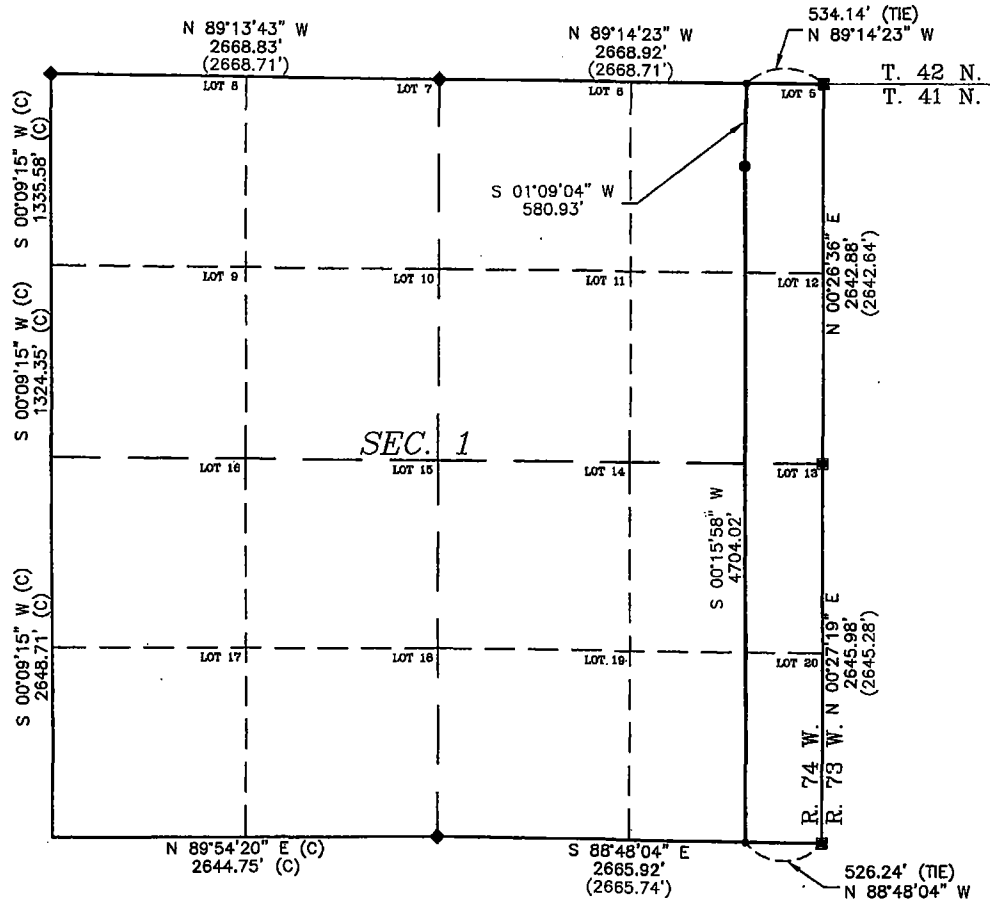

- LEGEND:**
- 1955 B.L.M. BRASS CAP
  - ◆ 1997 B.L.M. BRASS CAP
  - ( ) RECORDED DISTANCE
  - (C) CALCULATED FROM RECORD
  - CENTERLINE OF RIGHT OF WAY EASEMENT
  - BEGINNING AND END OF ALIGNMENT DESCRIPTION
  - POWER LINE PI LOCATION

**BASIS OF BEARING:**  
NAD 83 WYOMING STATE PLANE,  
EAST ZONE-GRID


**LEGAL DESCRIPTION:**

The following is a legal description for a 125 foot wide easement located in portions of Lot 5 (NE 1/4 NE 1/4), Lot 12 (SE 1/4 NE 1/4), Lot 13 (NE 1/4 SE 1/4) and Lot 20 (SE 1/4 SE 1/4) of Section 1, Township 41 North, Range 74 West of the 6th P.M., Campbell County, Wyoming. Said easement being 62.5 feet on each side of the following described centerline:

Commencing at the Northeast corner of said Section 1, said corner being monumented with a 1955 B.L.M. Brass cap, thence N 89°14'23" W, a distance of 534.14 feet to the True Point of Beginning of said easement centerline;

Thence along said centerline S 01°09'04" W, a distance of 580.93 feet; Thence along said centerline S 00°15'58" W, a distance of 4704.02 feet to a point on the South line of said Section 1, said point being N 88°48'04" W, a distance of 526.24 feet from the Southeast corner of said Section 1, being a 1955 B.L.M. Brass cap.

Said easement centerline being 5284.95 feet in length, more or less with side lines shortened or extended to the recorded boundary.

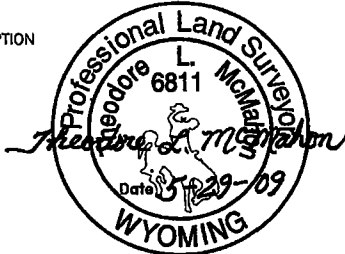

**CERTIFICATE OF SURVEYOR:**  
I, THEODORE L. MCMAHON, BEING A PROFESSIONAL LAND SURVEYOR, REGISTERED UNDER THE LAWS OF THE STATE OF WYOMING, DO HEREBY CERTIFY THAT THE MAP HEREON REPRESENTS AN ACTUAL SURVEY MADE BY MYSELF AND OR BY PERSONNEL OF KNIGHT TECHNOLOGIES INCORPORATED UNDER MY DIRECT SUPERVISION AND THAT SAID PLAT AND LEGAL DESCRIPTION SHOWN ARE ACCURATELY REPRESENTED.

**NOTE:**  
ALL CENTERLINE BEARINGS AND DISTANCES HEREIN ARE CONSIDERED TO BE MORE OR LESS. THE CENTERLINE OF THE POWERLINE AS CONSTRUCTED IS THE CENTER LINE OF THE 125' WIDE EASEMENT BEING 62.5' ON EACH SIDE



PREPARED BY:  
KNIGHT TECHNOLOGIES, INC.  
201 W. Lakeway Rd.  
Suite 200  
Gillette, WY 82718  
Office: (307) 682-8547

PREPARED FOR: BLACK HILLS POWER, INC. 625 9th STREET P.O. BOX 1400 RAPID CITY, SD 57708	
<b>RIGHT OF WAY EASEMENT NINE MILE LAND COMPANY</b>	
SEC. 1, T. 41 N., R. 74 W. CAMPBELL COUNTY, WYOMING	
DATE: 05-29-09	DESIGNED BY: KTI
SCALE: 1" = 1000'	DRAWN BY: KTI/JMB
CNTR INTRVL: N/A	APPROVED BY: KTI/TLM
REVISION:	DATE: / /

**RIGHT OF WAY EASEMENT  
BLACK HILLS POWER, INC.**

SECTION 12, T. 41 N., R. 74 W., 6TH P.M.  
CAMPBELL COUNTY, WYOMING

RECORD OWNER	FOOTAGE	RODS
NINE MILE LAND COMPANY	5291.4'	320.69

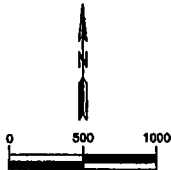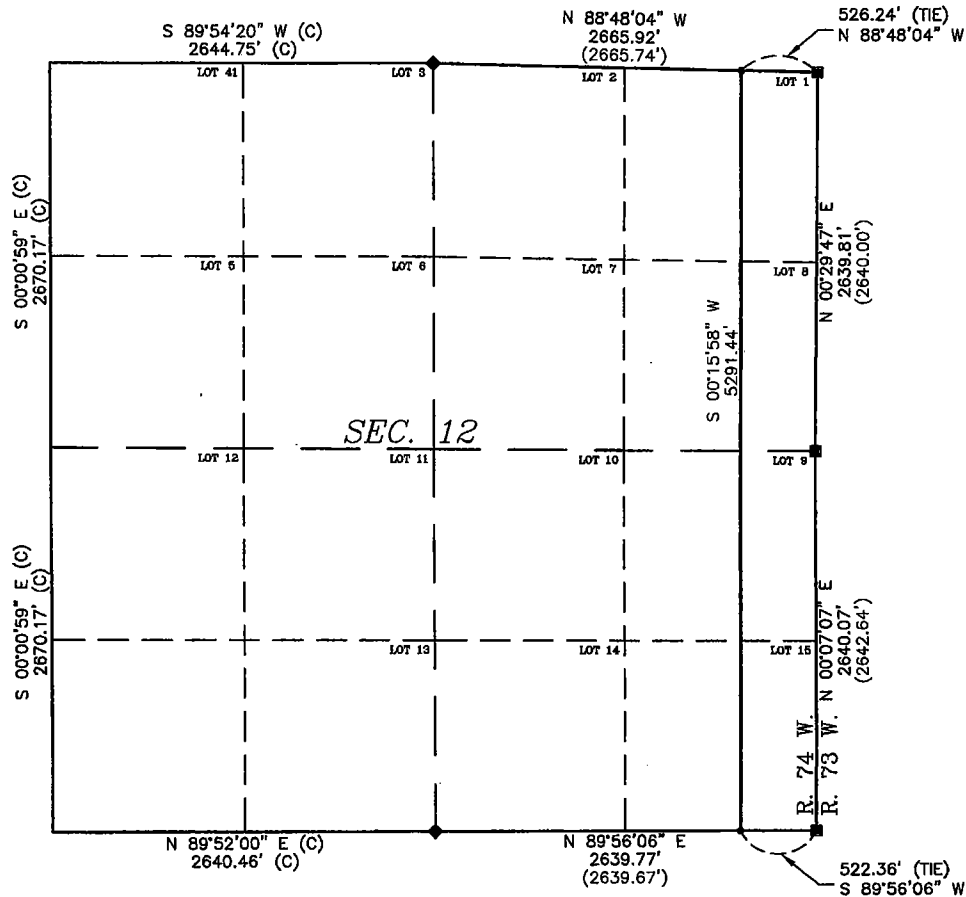

**LEGEND:**

- 1955 B.L.M. BRASS CAP
- ◆ 1997 B.L.M. BRASS CAP
- ( ) RECORDED DISTANCE
- (C) CALCULATED FROM RECORD
- CENTERLINE OF RIGHT OF WAY EASEMENT
- BEGINNING AND END OF ALIGNMENT DESCRIPTION

**BASIS OF BEARING:**  
NAD 83 WYOMING STATE PLANE,  
EAST ZONE-GRID


**LEGAL DESCRIPTION:**

The following is a legal description for a 125 foot wide easement located in portions of Lot 1 (NE 1/4 NE 1/4), Lot 8 (SE 1/4 NE 1/4), Lot 9 (NE 1/4 SE 1/4) and Lot 15 (SE 1/4 SE 1/4) of Section 12, Township 41 North, Range 74 West of the 6th P.M., Campbell County, Wyoming. Said easement being 62.5 feet on each side of the following described centerline:

Commencing at the Northeast corner of said Section 12, said corner being monumented with a 1955 B.L.M. Brass cap, thence N 88°48'04" W, a distance of 526.24 feet to the True Point of Beginning of said easement centerline;

Thence along said centerline S 00°15'58" W, a distance of 5291.44 feet to a point on the South line of said Section 12, said point being S 89°56'06" W, a distance of 522.36 feet from the Southeast corner of said Section 12, being a 1955 B.L.M. Brass cap.

Said easement centerline being 5291.44 feet in length, more or less with side lines shortened or extended to the recorded boundary.

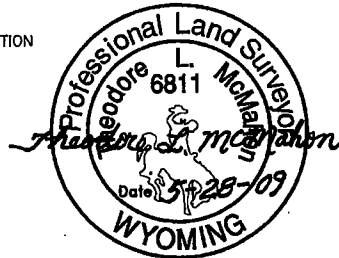

**CERTIFICATE OF SURVEYOR:**  
I, THEODORE L. MCMAHON, BEING A PROFESSIONAL LAND SURVEYOR, REGISTERED UNDER THE LAWS OF THE STATE OF WYOMING, DO HEREBY CERTIFY THAT THE MAP HEREON REPRESENTS AN ACTUAL SURVEY MADE BY MYSELF AND OR BY PERSONNEL OF KNIGHT TECHNOLOGIES INCORPORATED UNDER MY DIRECT SUPERVISION AND THAT SAID PLAT AND LEGAL DESCRIPTION SHOWN ARE ACCURATELY REPRESENTED.

PREPARED FOR:  
BLACK HILLS POWER, INC.  
825 9th STREET  
P.O. BOX 1400  
RAPID CITY, SD 57708



**RIGHT OF WAY EASEMENT  
NINE MILE LAND COMPANY**

SEC. 12, T. 41 N., R. 74 W.  
CAMPBELL COUNTY, WYOMING

PREPARED BY:  
KNIGHT TECHNOLOGIES, INC.  
201 W. Lakeway Rd.  
Suite 200  
Gillette, WY 82718  
Office: (307) 682-8547





DATE: 05-28-09	DESIGNED BY: KTI
SCALE: 1" = 1000'	DRAWN BY: KTI/PK
CNTR INTRVL: N/A	APPROVED BY: KTI/TLM
REVISION:	DATE: / /

**NOTE:**  
ALL CENTERLINE BEARINGS AND DISTANCES HEREIN ARE CONSIDERED TO BE MORE OR LESS. THE CENTERLINE OF THE POWERLINE AS CONSTRUCTED IS THE CENTER LINE OF THE 125' WIDE EASEMENT BEING 62.5' ON EACH SIDE

**RIGHT OF WAY EASEMENT  
BLACK HILLS POWER, INC.  
SECTION 13, T. 41 N., R. 74 W., 6TH P.M.  
CAMPBELL COUNTY, WYOMING**

RECORD OWNER: NINE MILE LAND COMPANY      FOOTAGE: 5321.8'      RODS: 322.53

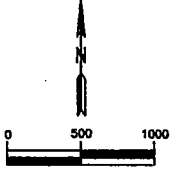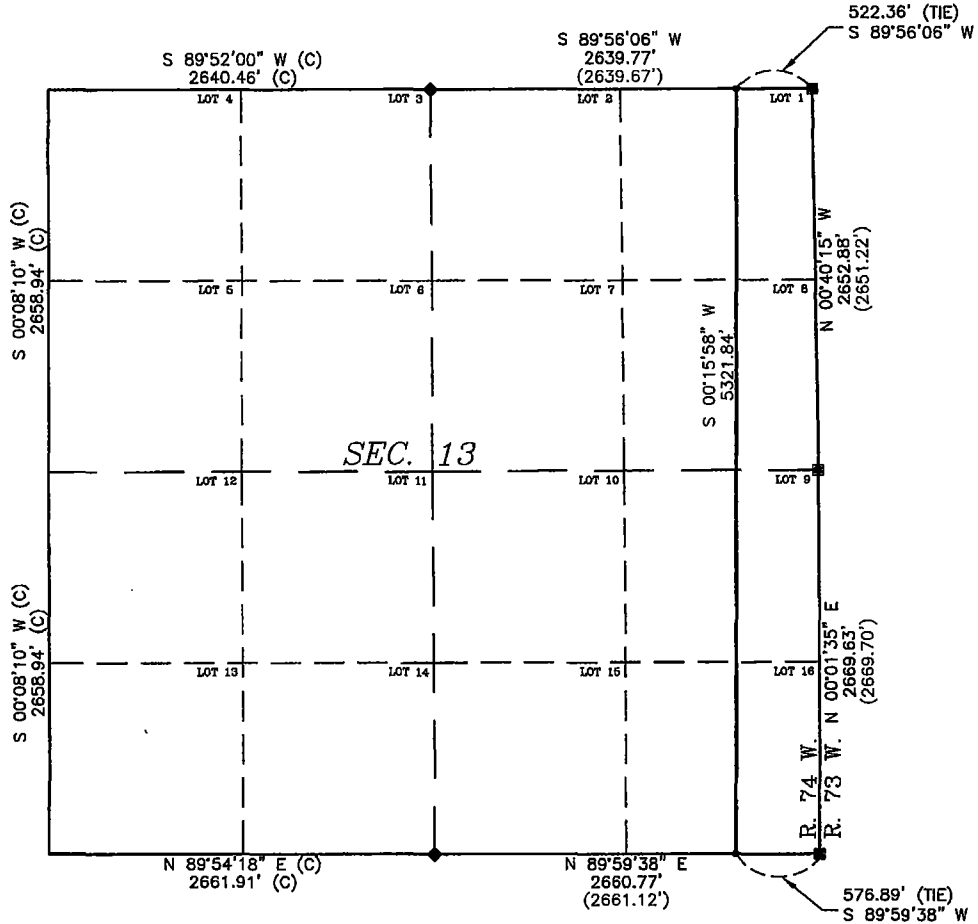

- LEGEND:**
- 1955 B.L.M. BRASS CAP
  - ◆ 1997 B.L.M. BRASS CAP
  - ( ) RECORDED DISTANCE
  - (C) CALCULATED FROM RECORD
  - CENTERLINE OF RIGHT OF WAY EASEMENT
  - BEGINNING AND END OF ALIGNMENT DESCRIPTION

**BASIS OF BEARING:**  
NAD 83 WYOMING STATE PLANE,  
EAST ZONE-GRID

**LEGAL DESCRIPTION:**

The following is a legal description for a 125 foot wide easement located in portions of Lot 1 (NE 1/4 NE 1/4), Lot 8 (SE 1/4 NE 1/4), Lot 9 (NE 1/4 SE 1/4) and Lot 16 (SE 1/4 SE 1/4) of Section 13, Township 41 North, Range 74 West of the 6th P.M., Campbell County, Wyoming. Said easement being 62.5 feet on each side of the following described centerline:

Commencing at the Northeast corner of said Section 13, said corner being monumented with a 1955 B.L.M. Brass cap, thence S 89°56'06" W, a distance of 522.36 feet to the True Point of Beginning of said easement centerline;

Thence along said centerline S 00°15'58" W, a distance of 5321.84 feet to a point on the South line of said Section 13, said point being S 89°59'38" W, a distance of 576.89 feet from the Southeast corner of said Section 13, being a 1955 B.L.M. Brass cap.

Said easement centerline being 5321.84 feet in length, more or less with side lines shortened or extended to the recorded boundary.



**CERTIFICATE OF SURVEYOR:**  
I, THEODORE L. MCMAHON, BEING A PROFESSIONAL LAND SURVEYOR, REGISTERED UNDER THE LAWS OF THE STATE OF WYOMING, DO HEREBY CERTIFY THAT THE MAP HEREON REPRESENTS AN ACTUAL SURVEY MADE BY MYSELF AND OR BY PERSONNEL OF KNIGHT TECHNOLOGIES INCORPORATED UNDER MY DIRECT SUPERVISION AND THAT SAID PLAT AND LEGAL DESCRIPTION SHOWN ARE ACCURATELY REPRESENTED.

**NOTE:**  
ALL CENTERLINE BEARINGS AND DISTANCES HEREIN ARE CONSIDERED TO BE MORE OR LESS. THE CENTERLINE OF THE POWERLINE AS CONSTRUCTED IS THE CENTER LINE OF THE 125' WIDE EASEMENT BEING 62.5' ON EACH SIDE

PREPARED BY:  
**KNIGHT TECHNOLOGIES, INC.**  
201 W. Lakeway Rd.  
Suite 200  
Gillette, WY 82718  
Office: (307) 682-8547





PREPARED FOR: BLACK HILLS POWER, INC. 625 9th STREET P.O. BOX 1400 RAPID CITY, SD 57709		
<b>RIGHT OF WAY EASEMENT</b> NINE MILE LAND COMPANY		
SEC. 13, T. 41 N., R. 74 W. CAMPBELL COUNTY, WYOMING		
DATE: 05-28-09	DESIGNED BY: KTI	
SCALE: 1" = 1000'	DRAWN BY: KTI/PK	
CNTR INTVL: N/A	APPROVED BY: KTI/TLM	
REVISION:	DATE: / /	

**RIGHT OF WAY EASEMENT  
BLACK HILLS POWER, INC.**

**SECTION 24, T. 41 N., R. 74 W., 6TH P.M.  
CAMPBELL COUNTY, WYOMING**

RECORD OWNER: NINE MILE LAND COMPANY      FOOTAGE: 2663.3'      RODS: 161.41

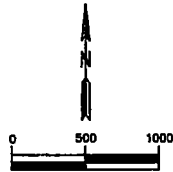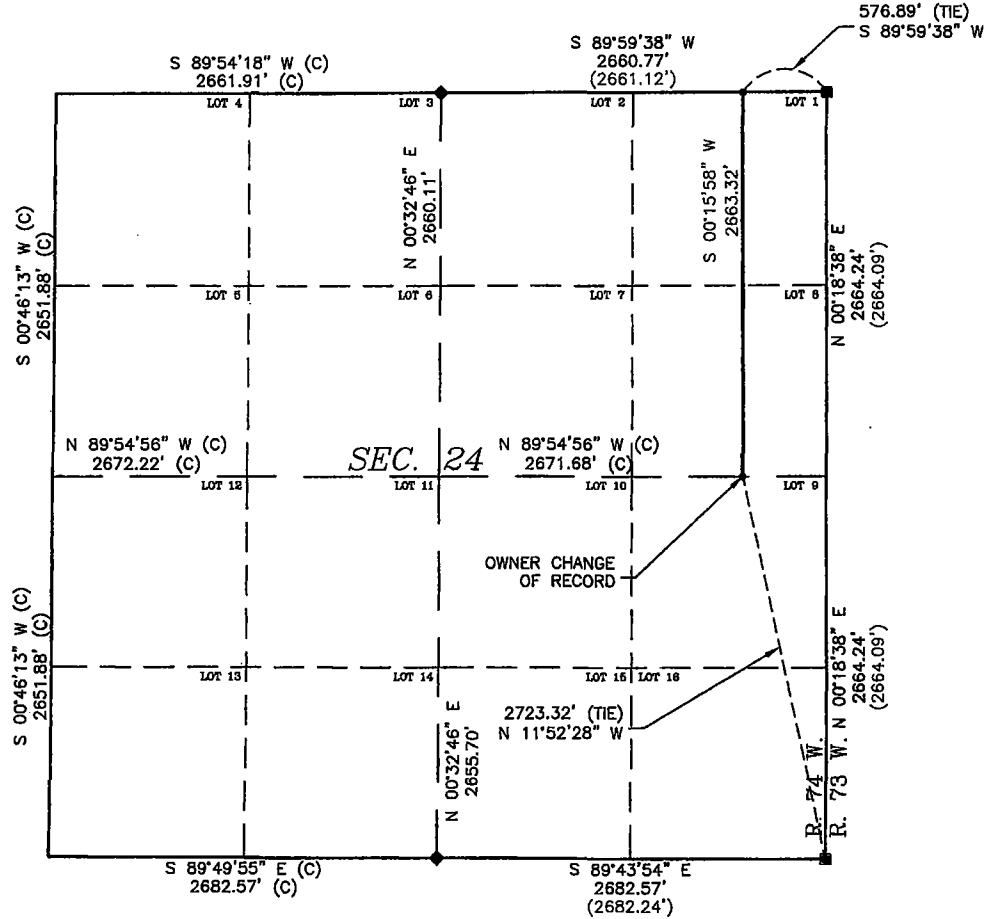

**LEGEND:**

- 1955 B.L.M. BRASS CAP
- ◆ 1997 B.L.M. BRASS CAP
- ( ) RECORDED DISTANCE
- (C) CALCULATED FROM RECORD
- CENTERLINE OF RIGHT OF WAY EASEMENT
- BEGINNING AND END OF ALIGNMENT DESCRIPTION

**BASIS OF BEARING:**  
NAD 83 WYOMING STATE PLANE,  
EAST ZONE-GRID


**LEGAL DESCRIPTION:**

The following is a legal description for a 125 foot wide easement located in portions of Lot 1 (NE 1/4 NE 1/4) and Lot 8 (SE 1/4 NE 1/4) of Section 24, Township 41 North, Range 74 West of the 6th P.M., Campbell County, Wyoming. Said easement being 62.5 feet on each side of the following described centerline:

Commencing at the Northeast corner of said Section 24, said corner being monumented with a 1955 B.L.M. Brass cap, thence S 89°59'38" W, a distance of 576.89' feet to the True Point of Beginning of said easement centerline;

Thence along said centerline S 00°15'58" W, a distance of 2663.32 feet to a point on the South line of said Lot 8 (SE 1/4 NE 1/4), said point being N 11°52'28" W, a distance of 2723.32 feet from the Southeast corner of said Section 24, being a 1955 B.L.M. Brass cap.

Said easement centerline being 2663.32 feet in length, more or less with side lines shortened or extended to the recorded boundary.

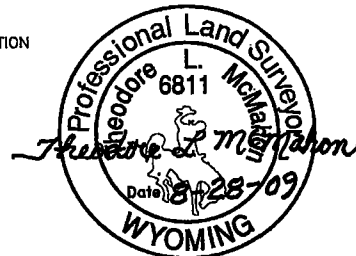

**CERTIFICATE OF SURVEYOR:**  
I, THEODORE L. MCMAHON, BEING A PROFESSIONAL LAND SURVEYOR, REGISTERED UNDER THE LAWS OF THE STATE OF WYOMING, DO HEREBY CERTIFY THAT THE MAP HEREON REPRESENTS AN ACTUAL SURVEY MADE BY MYSELF AND OR BY PERSONNEL OF KNIGHT TECHNOLOGIES INCORPORATED UNDER MY DIRECT SUPERVISION AND THAT SAID PLAT AND LEGAL DESCRIPTION SHOWN ARE ACCURATELY REPRESENTED.

PREPARED FOR:  
BLACK HILLS POWER, INC.  
625 9th STREET  
P.O. BOX 1400  
RAPID CITY, SD 57708



**RIGHT OF WAY EASEMENT  
NINE MILE LAND COMPANY**

SEC. 24, T. 41 N., R. 74 W.  
CAMPBELL COUNTY, WYOMING

**NOTE:**  
ALL CENTERLINE BEARINGS AND DISTANCES HEREIN ARE CONSIDERED TO BE MORE OR LESS. THE CENTERLINE OF THE POWERLINE AS CONSTRUCTED IS THE CENTER LINE OF THE 125' WIDE EASEMENT BEING 62.5' ON EACH SIDE



PREPARED BY:  
KNIGHT TECHNOLOGIES, INC.  
201 W. Lakeway Rd.  
Suite 200  
Gillette, WY 82718  
Office: (307) 682-8547



DATE: 08-28-09	DESIGNED BY: KTI
SCALE: 1" = 1000'	DRAWN BY: KTI/PK
CNTR INTRVL: N/A	APPROVED BY: KTI/TLM
REVISION:	DATE: / /

**RIGHT OF WAY EASEMENT**  
**BLACK HILLS POWER, INC.**  
 SECTION 24, T. 41 N., R. 74 W., 6TH P.M.  
 CAMPBELL COUNTY, WYOMING

RECORD OWNER: W I MOORE RANCH CO, INC      FOOTAGE: 2662.4'      RODS: 161.36

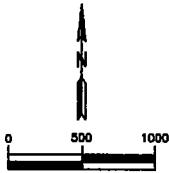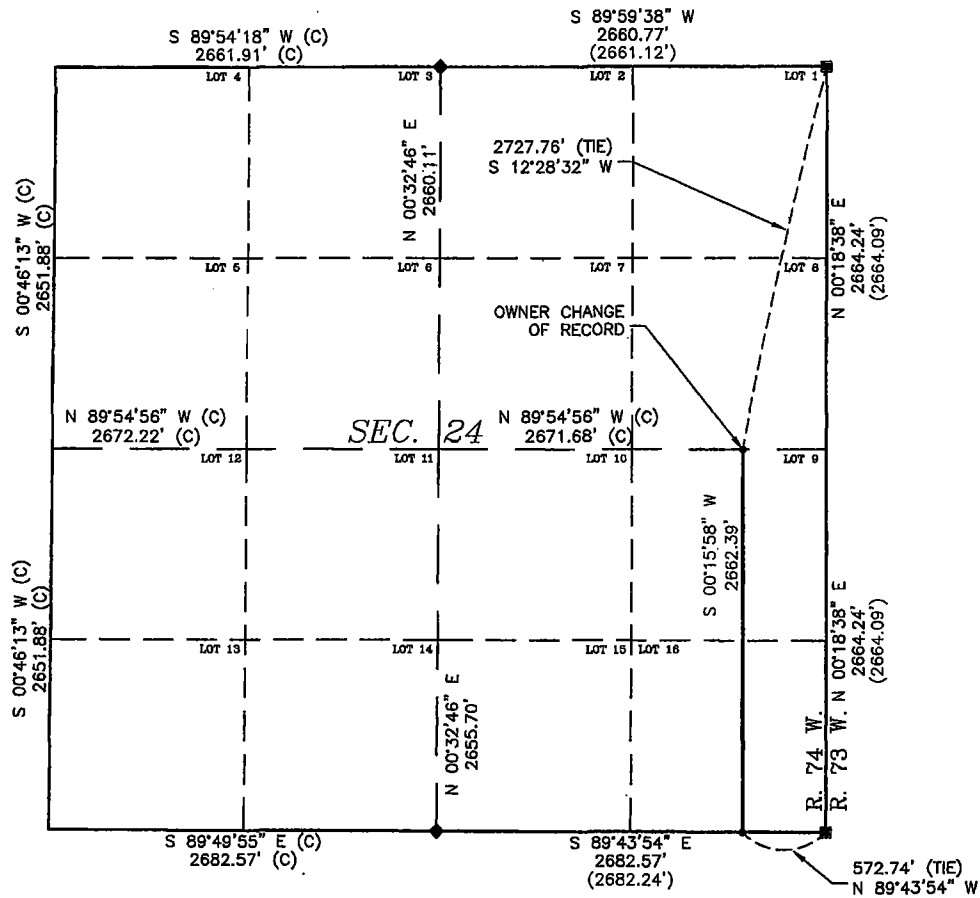

- LEGEND:**
- 1955 B.L.M. BRASS CAP
  - ◆ 1997 B.L.M. BRASS CAP
  - ( ) RECORDED DISTANCE
  - (C) CALCULATED FROM RECORD
  - CENTERLINE OF RIGHT OF WAY EASEMENT
  - BEGINNING AND END OF ALIGNMENT DESCRIPTION

**BASIS OF BEARING:**  
 NAD 83 WYOMING STATE PLANE,  
 EAST ZONE-GRID


**LEGAL DESCRIPTION:**

The following is a legal description for a 125 foot wide easement located in portions of Lot 9 (NE 1/4 SE 1/4) and Lot 16 (SE 1/4 SE 1/4) of Section 24, Township 41 North, Range 74 West of the 6th P.M., Campbell County, Wyoming. Said easement being 62.5 feet on each side of the following described centerline:

Commencing at the Northeast corner of said Section 24, said corner being monumented with a 1955 B.L.M. Brass cap, thence S 12°28'32" W, a distance of 2727.76 feet to the True Point of Beginning of said easement centerline;

Thence along said centerline S 00°15'58" W, a distance of 2662.39 feet to a point on the South line of said Section 24, said point being N 89°43'54" W, a distance of 572.74 feet from the Southeast corner of said Section 24, being a 1955 B.L.M. Brass cap.

Said easement centerline being 2662.39 feet in length, more or less with side lines shortened or extended to the recorded boundary.

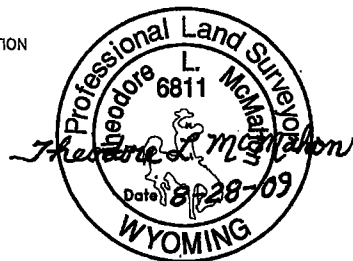

**CERTIFICATE OF SURVEYOR:**  
 I, THEODORE L. MCMAHON, BEING A PROFESSIONAL LAND SURVEYOR, REGISTERED UNDER THE LAWS OF THE STATE OF WYOMING, DO HEREBY CERTIFY THAT THE MAP HEREON REPRESENTS AN ACTUAL SURVEY MADE BY MYSELF AND OR BY PERSONNEL OF KNIGHT TECHNOLOGIES INCORPORATED UNDER MY DIRECT SUPERVISION AND THAT SAID PLAT AND LEGAL DESCRIPTION SHOWN ARE ACCURATELY REPRESENTED.

PREPARED FOR:  
 BLACK HILLS POWER, INC.  
 825 9th STREET  
 P.O. BOX 1400  
 RAPID CITY, SD 57709



**RIGHT OF WAY EASEMENT**  
**W I MOORE RANCH CO, INC**  
 SEC. 24, T. 41 N., R. 74 W.  
 CAMPBELL COUNTY, WYOMING



DATE: 08-28-09	DESIGNED BY: KTI
SCALE: 1" = 1000'	DRAWN BY: KTI/PK
CNTR INTRVL: N/A	APPROVED BY: KTI/TLM
REVISION:	DATE: / /

**NOTE:**  
 ALL CENTERLINE BEARINGS AND DISTANCES HEREIN ARE CONSIDERED TO BE MORE OR LESS. THE CENTERLINE OF THE POWERLINE AS CONSTRUCTED IS THE CENTER LINE OF THE 125' WIDE EASEMENT BEING 62.5' ON EACH SIDE

PREPARED BY:  
 KNIGHT TECHNOLOGIES, INC.  
 201 W. Lakeway Rd.  
 Suite 200  
 Gillette, WY 82718  
 Office: (307) 682-8547



**RIGHT OF WAY EASEMENT  
BLACK HILLS POWER, INC.  
SECTION 25, T. 41 N., R. 74 W., 6TH P.M.  
CAMPBELL COUNTY, WYOMING  
CONVERSE COUNTY, WYOMING**

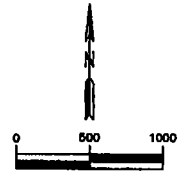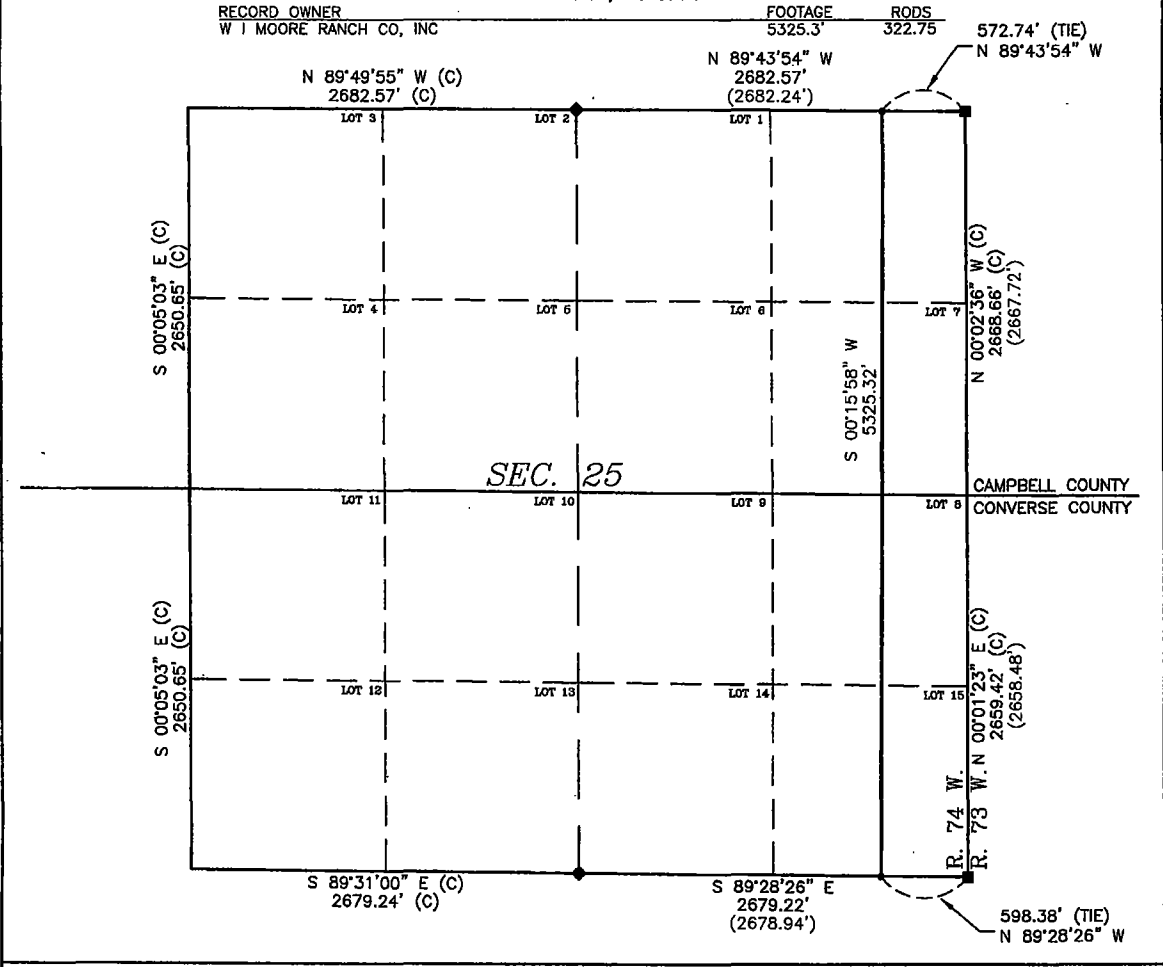

- LEGEND:**
- 1955 B.L.M. BRASS CAP
  - ◆ 1997 B.L.M. BRASS CAP
  - ( ) RECORDED DISTANCE
  - (C) CALCULATED FROM RECORD
  - CENTERLINE OF RIGHT OF WAY EASEMENT
  - BEGINNING AND END OF ALIGNMENT DESCRIPTION

**BASIS OF BEARING:**  
NAD 83 WYOMING STATE PLANE,  
EAST ZONE-GRID


**LEGAL DESCRIPTION:**

The following is a legal description for a 125 foot wide easement located in portions of NE 1/4 NE 1/4, Lot 7 (SE 1/4 NE 1/4), Lot 8 (NE 1/4 SE 1/4) and Lot 15 (SE 1/4 SE 1/4) of Section 25, Township 41 North, Range 74 West of the 6th P.M., Campbell County and Converse County, Wyoming. Said easement being 62.5 feet on each side of the following described centerline:

Commencing at the Northeast corner of said Section 25, said corner being monumented with a 1955 B.L.M. Brass cap, thence N 89°43'54" W, a distance of 572.74 feet to the True Point of Beginning of said easement centerline;

Thence along said centerline S 00°15'58" W, a distance of 5325.32 feet to a point on the South line of said Section 25, said point being N 89°28'26" W, a distance of 598.38 feet from the Southeast corner of said Section 25, being a 1955 B.L.M. Brass cap.

Said easement centerline being 5325.32 feet in length, more or less with side lines shortened or extended to the recorded boundary.

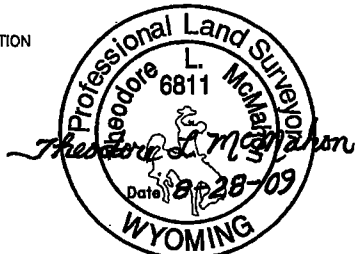

**CERTIFICATE OF SURVEYOR:**  
I, THEODORE L. MCMAHON, BEING A PROFESSIONAL LAND SURVEYOR, REGISTERED UNDER THE LAWS OF THE STATE OF WYOMING, DO HEREBY CERTIFY THAT THE MAP HEREON REPRESENTS AN ACTUAL SURVEY MADE BY MYSELF AND OR BY PERSONNEL OF KNIGHT TECHNOLOGIES INCORPORATED UNDER MY DIRECT SUPERVISION AND THAT SAID PLAT AND LEGAL DESCRIPTION SHOWN ARE ACCURATELY REPRESENTED.

**NOTE:**  
ALL CENTERLINE BEARINGS AND DISTANCES HEREIN ARE CONSIDERED TO BE MORE OR LESS. THE CENTERLINE OF THE POWERLINE AS CONSTRUCTED IS THE CENTER LINE OF THE 125' WIDE EASEMENT BEING 62.5' ON EACH SIDE

PREPARED BY:  
**KNIGHT TECHNOLOGIES, INC.**  
201 W. Lakeway Rd.  
Suite 200  
Gillette, WY 82718  
Office: (307) 682-8547



PREPARED FOR:  
BLACK HILLS POWER, INC.  
828 9th STREET  
P.O. BOX 1400  
RAPID CITY, SD 57709



<b>RIGHT OF WAY EASEMENT W I MOORE RANCH CO, INC</b>	
SEC. 25, T. 41 N., R. 74 W. CAMPBELL & CONVERSE COUNTY, WYOMING	
DATE: 05-28-09	DESIGNED BY: KTI
SCALE: 1" = 1000'	DRAWN BY: KTI/PK
CNTR INTRVL: N/A	APPROVED BY: KTI/TLM
REVISION:	DATE: / /



RIGHT OF WAY EASEMENTS OVER  
LANDS IN CONVERSE COUNTY, WYOMING

[See attachment.]



**RIGHT OF WAY EASEMENT  
BLACK HILLS POWER, INC.  
SECTION 25, T. 41 N., R. 74 W., 8TH P.M.  
CAMPBELL COUNTY, WYOMING  
CONVERSE COUNTY, WYOMING**

RECORD OWNER: W I MOORE RANCH CO, INC      FOOTAGE: 5325.3'      RODS: 322.75'      572.74' (TIE) N 89°43'54" W

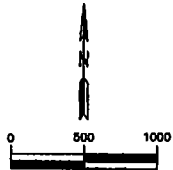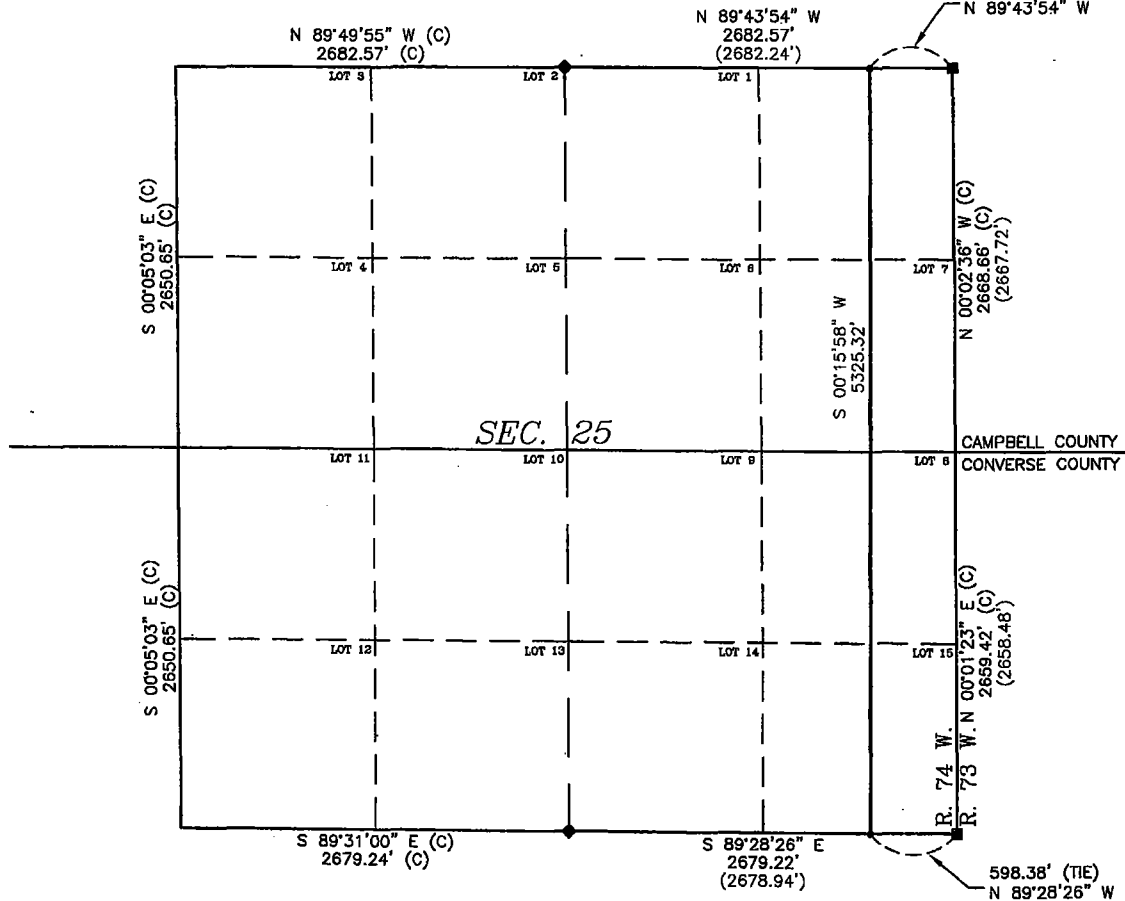

- LEGEND:**
- 1955 B.L.M. BRASS CAP
  - ◆ 1997 B.L.M. BRASS CAP
  - ( ) RECORDED DISTANCE
  - (C) CALCULATED FROM RECORD
  - CENTERLINE OF RIGHT OF WAY EASEMENT
  - BEGINNING AND END OF ALIGNMENT DESCRIPTION

**BASIS OF BEARING:**  
NAD 83 WYOMING STATE PLANE,  
EAST ZONE-GRID


**LEGAL DESCRIPTION:**

The following is a legal description for a 125 foot wide easement located in portions of NE 1/4 NE 1/4, Lot 7 (SE 1/4 NE 1/4), Lot 8 (NE 1/4 SE 1/4) and Lot 15 (SE 1/4 SE 1/4) of Section 25, Township 41 North, Range 74 West of the 6th P.M., Campbell County and Converse County, Wyoming. Said easement being 62.5 feet on each side of the following described centerline:

Commencing at the Northeast corner of said Section 25, said corner being monumented with a 1955 B.L.M. Brass cap, thence N 89°43'54" W, a distance of 572.74 feet to the True Point of Beginning of said easement centerline;

Thence along said centerline S 00°15'58" W, a distance of 5325.32 feet to a point on the South line of said Section 25, said point being N 89°28'26" W, a distance of 598.38 feet from the Southeast corner of said Section 25, being a 1955 B.L.M. Brass cap.

Said easement centerline being 5325.32 feet in length, more or less with side lines shortened or extended to the recorded boundary.

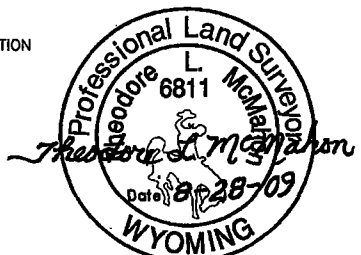

**CERTIFICATE OF SURVEYOR:**  
I, THEODORE L. MCMAHON, BEING A PROFESSIONAL LAND SURVEYOR, REGISTERED UNDER THE LAWS OF THE STATE OF WYOMING, DO HEREBY CERTIFY THAT THE MAP HEREON REPRESENTS AN ACTUAL SURVEY MADE BY MYSELF AND OR BY PERSONNEL OF KNIGHT TECHNOLOGIES INCORPORATED UNDER MY DIRECT SUPERVISION AND THAT SAID PLAT AND LEGAL DESCRIPTION SHOWN ARE ACCURATELY REPRESENTED.

PREPARED FOR:  
BLACK HILLS POWER, INC.  
828 9th STREET  
P.O. BOX 1400  
RAPID CITY, SD 57709

**RIGHT OF WAY EASEMENT  
W I MOORE RANCH CO, INC**

SEC. 25, T. 41 N., R. 74 W.  
CAMPBELL & CONVERSE COUNTY, WYOMING

DATE: 08-28-09	DESIGNED BY: KTI
SCALE: 1" = 1000'	DRAWN BY: KTI/PK
CNTR INTRVL: N/A	APPROVED BY: KTI/TLM
REVISION:	DATE: / /



**NOTE:**  
ALL CENTERLINE BEARINGS AND DISTANCES HEREIN ARE CONSIDERED TO BE MORE OR LESS. THE CENTERLINE OF THE POWERLINE AS CONSTRUCTED IS THE CENTER LINE OF THE 125' WIDE EASEMENT BEING 62.5' ON EACH SIDE

PREPARED BY:  
KNIGHT TECHNOLOGIES, INC.  
201 W. Lakeway Rd.  
Suite 200  
Gillette, WY 82718  
Office: (307) 682-8547




**RIGHT OF WAY EASEMENT  
BLACK HILLS POWER, INC.  
SECTION 3, T. 39 N., R. 74 W., 6TH P.M.  
CONVERSE COUNTY, WYOMING**

RECORD OWNER: DILTS RANCH COMPANY & STEVEN K DILTS INTER VIVOS TRUST  
FOOTAGE: 5679.0'  
RODS: 344.18

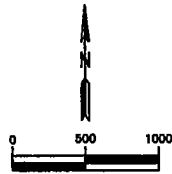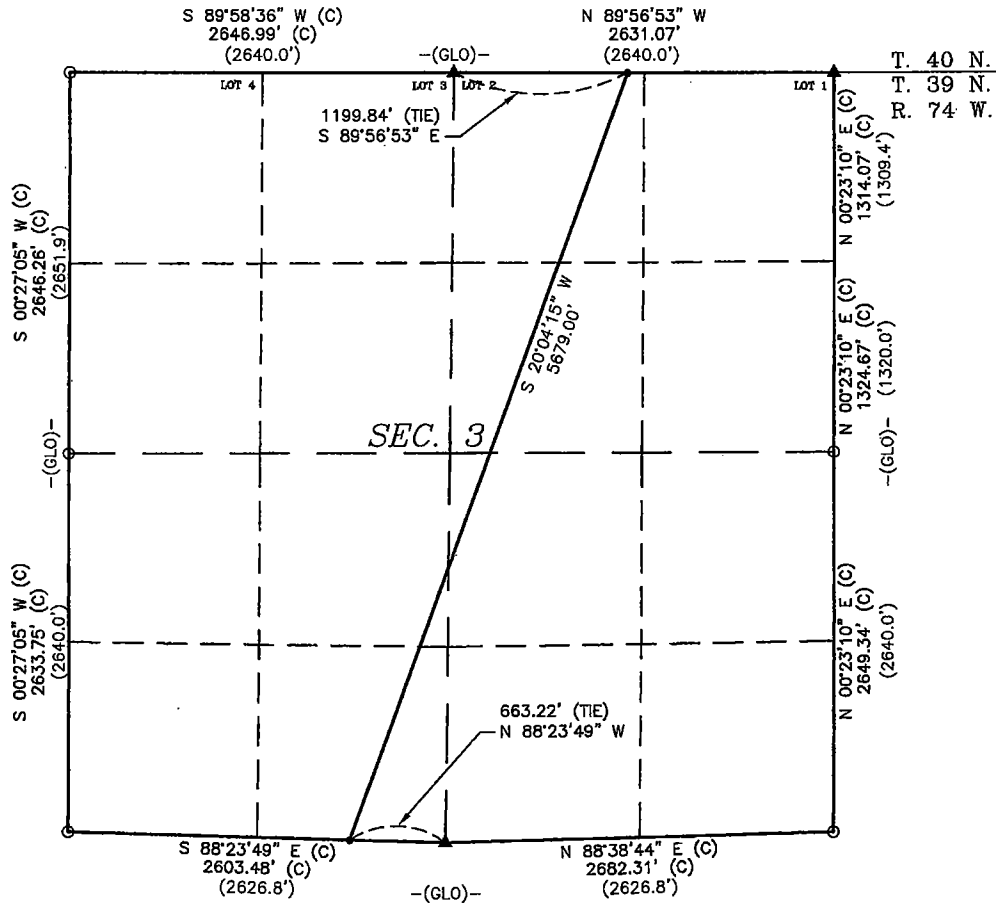

- LEGEND:**
- ▲ ORIGINAL STONE MARKER
  - CALCULATED CORNER POSITION (NOT SET)
  - ( ) RECORDED DISTANCE
  - (C) CALCULATED FROM RECORD
  - CENTERLINE OF RIGHT OF WAY EASEMENT
  - BEGINNING AND END OF ALIGNMENT DESCRIPTION
  - (GLO) REFERS TO RECORDS OF ORIGINAL GENERAL LAND OFFICE

**BASIS OF BEARING:**  
MAD 83 WYOMING STATE PLANE,  
EAST ZONE-GRID

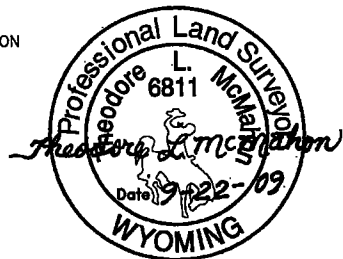

**LEGAL DESCRIPTION:**

The following is a legal description for a 125 foot wide easement located in portions of Lot 2 (NW 1/4 NE 1/4), SW 1/4 NE 1/4, NW 1/4 SE 1/4, NE 1/4 SW 1/4, SE 1/4 SW 1/4 of Section 3, Township 39 North, Range 74 West of the 6th P.M., Converse County, Wyoming. Said easement being 62.5 feet on each side of the following described centerline:

Commencing at the North 1/4 corner of said Section 3, said corner being monumented with an original stone marker, thence S 89°56'53" E, a distance of 1199.84 feet to the True Point of Beginning of said easement centerline;

Thence along said centerline S 20°04'15" W, a distance of 5679.00 feet to a point on the South line of said Section 3, said point being N 88°23'49" W, a distance of 663.22 feet from the South 1/4 corner of said Section 3, being an original stone marker.

Said easement centerline being 5679.00 feet in length, more or less with side lines shortened or extended to the recorded boundary.

**CERTIFICATE OF SURVEYOR:**  
I, THEODORE L. MCMAHON, BEING A PROFESSIONAL LAND SURVEYOR, REGISTERED UNDER THE LAWS OF THE STATE OF WYOMING, DO HEREBY CERTIFY THAT THE MAP HEREON REPRESENTS AN ACTUAL SURVEY MADE BY MYSELF AND OR BY PERSONNEL OF KNIGHT TECHNOLOGIES INCORPORATED UNDER MY DIRECT SUPERVISION AND THAT SAID PLAN AND LEGAL DESCRIPTION SHOWN ARE ACCURATELY REPRESENTED.

PREPARED FOR:  
BLACK HILLS POWER, INC.  
625 9th STREET  
P.O. BOX 1400  
RAPID CITY, SD 57709

**RIGHT OF WAY EASEMENT  
DILTS RANCH COMPANY &  
STEVEN K DILTS INTER VIVOS TRUST  
SEC. 3, T. 39 N., R. 74 W.  
CONVERSE COUNTY, WYOMING**

**NOTE:**  
ALL CENTERLINE BEARINGS AND DISTANCES HEREIN ARE CONSIDERED TO BE MORE OR LESS. THE CENTERLINE OF THE POWERLINE AS CONSTRUCTED IS THE CENTER LINE OF THE 125' WIDE EASEMENT BEING 62.5' ON EACH SIDE



PREPARED BY:  
KNIGHT TECHNOLOGIES, INC.  
201 W. Lakeway Rd.  
Suite 200  
Gillette, WY 82718  
Office: (307) 682-8547



DATE: 09-22-09	DESIGNED BY: KTI
SCALE: 1" = 1000'	DRAWN BY: KTI/EK
CNTR DTRVL: N/A	APPROVED BY: KTI/TLM
REVISION:	DATE: / /


**RIGHT OF WAY EASEMENT  
BLACK HILLS POWER, INC.  
SECTION 10, T. 39 N., R. 74 W., 6TH P.M.  
CONVERSE COUNTY, WYOMING**

RECORD OWNER DILTS RANCH COMPANY & STEVEN K DILTS INTER VIVOS TRUST	FOOTAGE 5469.8'	RODS 331.50
---	--------------------	----------------

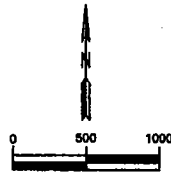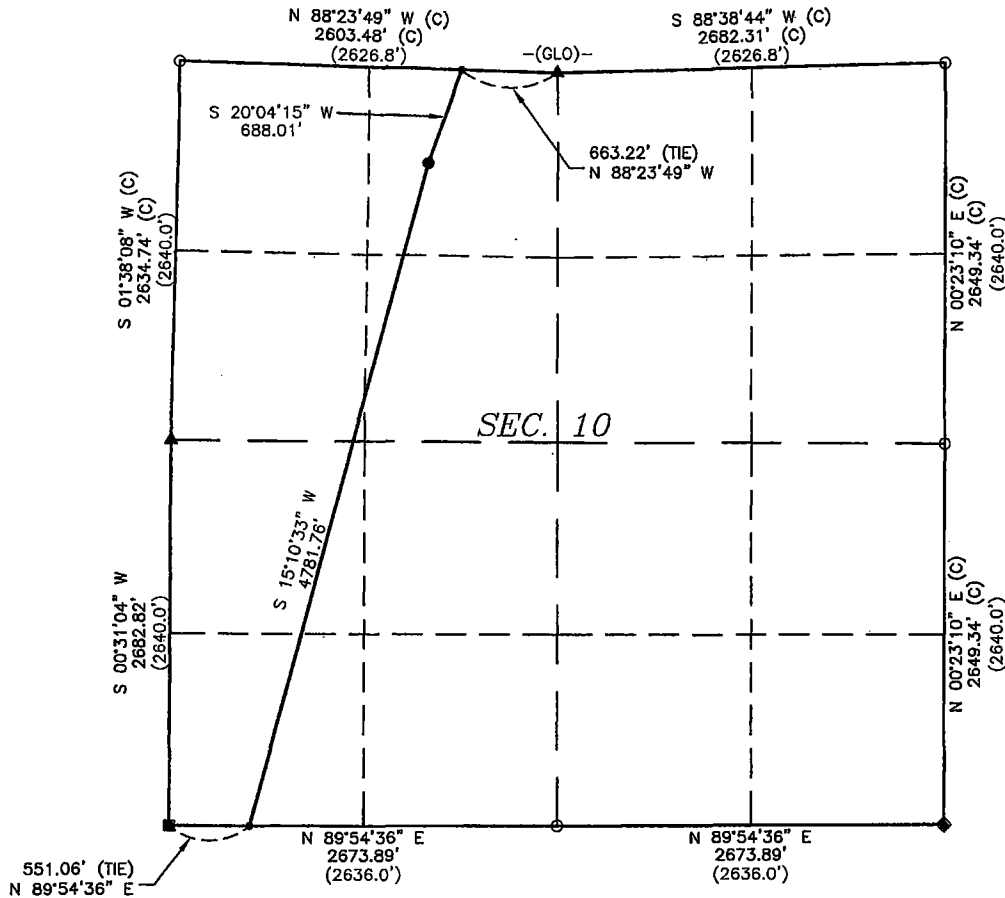

- LEGEND:**
- ▲ ORIGINAL STONE MARKER
  - CALCULATED CORNER POSITION (NOT SET)
  - 1982 LS 2097 ALUMINUM CAP
  - ◆ 2008 LS 489 ALUMINUM CAP
  - ( ) RECORDED DISTANCE
  - (C) CALCULATED FROM RECORD
  - CENTERLINE OF RIGHT OF WAY EASEMENT
  - BEGINNING AND END OF ALIGNMENT DESCRIPTION
  - POWER LINE PI LOCATION
  - (GLO) REFERS TO RECORDS OF ORIGINAL GENERAL LAND OFFICE

**BASIS OF BEARING:**  
NAD 83 WYOMING STATE PLANE,  
EAST ZONE--GRID

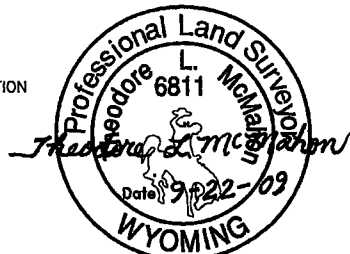

**LEGAL DESCRIPTION:**

The following is a legal description for a 125 foot wide easement located in portions of the NE 1/4 NW 1/4, SE 1/4 NW 1/4, SW 1/4 NW 1/4, NW 1/4 SW 1/4 and SW 1/4 SW 1/4 of Section 10, Township 39 North, Range 74 West of the 6th P.M., Converse County, Wyoming. Said easement being 62.5 feet on each side of the following described centerline:

Commencing at the North 1/4 corner of said Section 10, said corner being monumented with an original stone marker, thence N 88°23'49" W, a distance of 663.22 feet to the True Point of Beginning of said easement centerline;

Thence along said centerline S 20°04'15" W, a distance of 688.01 feet to a point; Thence along said centerline S 15°10'33" W, a distance of 4781.76 feet to a point on the South line of said Section 10, said point being N 89°54'36" E, a distance of 551.06 feet from the Southwest corner of said Section 10, being a 1982 L.S. 2097 Aluminum cap.

Said easement centerline being 5469.77 feet in length, more or less with side lines shortened or extended to the recorded boundary.

**CERTIFICATE OF SURVEYOR:**  
I, THEODORE L. MCMAHON, BEING A PROFESSIONAL LAND SURVEYOR, REGISTERED UNDER THE LAWS OF THE STATE OF WYOMING, DO HEREBY CERTIFY THAT THE MAP HEREON REPRESENTS AN ACTUAL SURVEY MADE BY MYSELF AND OR BY PERSONNEL OF KNIGHT TECHNOLOGIES INCORPORATED UNDER MY DIRECT SUPERVISION AND THAT SAID PLAT AND LEGAL DESCRIPTION SHOWN ARE ACCURATELY REPRESENTED.

PREPARED FOR:  
BLACK HILLS POWER, INC.  
825 9th STREET  
P.O. BOX 1400  
RAPID CITY, SD 57709

**RIGHT OF WAY EASEMENT  
DILTS RANCH COMPANY &  
STEVEN K DILTS INTER VIVOS TRUST  
SEC. 10, T. 39 N., R. 74 W.  
CONVERSE COUNTY, WYOMING**

**NOTE:**  
ALL CENTERLINE BEARINGS AND DISTANCES HEREIN ARE CONSIDERED TO BE MORE OR LESS. THE CENTERLINE OF THE POWERLINE AS CONSTRUCTED IS THE CENTER LINE OF THE 125' WIDE EASEMENT BEING 62.5' ON EACH SIDE



PREPARED BY:  
KNIGHT TECHNOLOGIES, INC.  
201 W. Lakeway Rd.  
Suite 200  
Gillette, WY 82718  
Office: (307) 682-8547



DATE: 09-22-09	DESIGNED BY: KTI
SCALE: 1" = 1000'	DRAWN BY: KTI/PK
CNTR INTRVL: N/A	APPROVED BY: KTI/TLM
REVISION:	DATE: / /

**RIGHT OF WAY EASEMENT**  
**BLACK HILLS POWER, INC.**  
 SECTION 15, T. 39 N., R. 74 W., 6TH P.M.  
 CONVERSE COUNTY, WYOMING

RECORD OWNER	FOOTAGE	RODS
DILTS RANCH COMPANY & STEVEN K DILTS INTER VIVOS TRUST	3953.2'	239.59

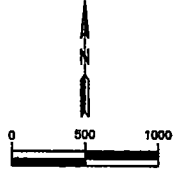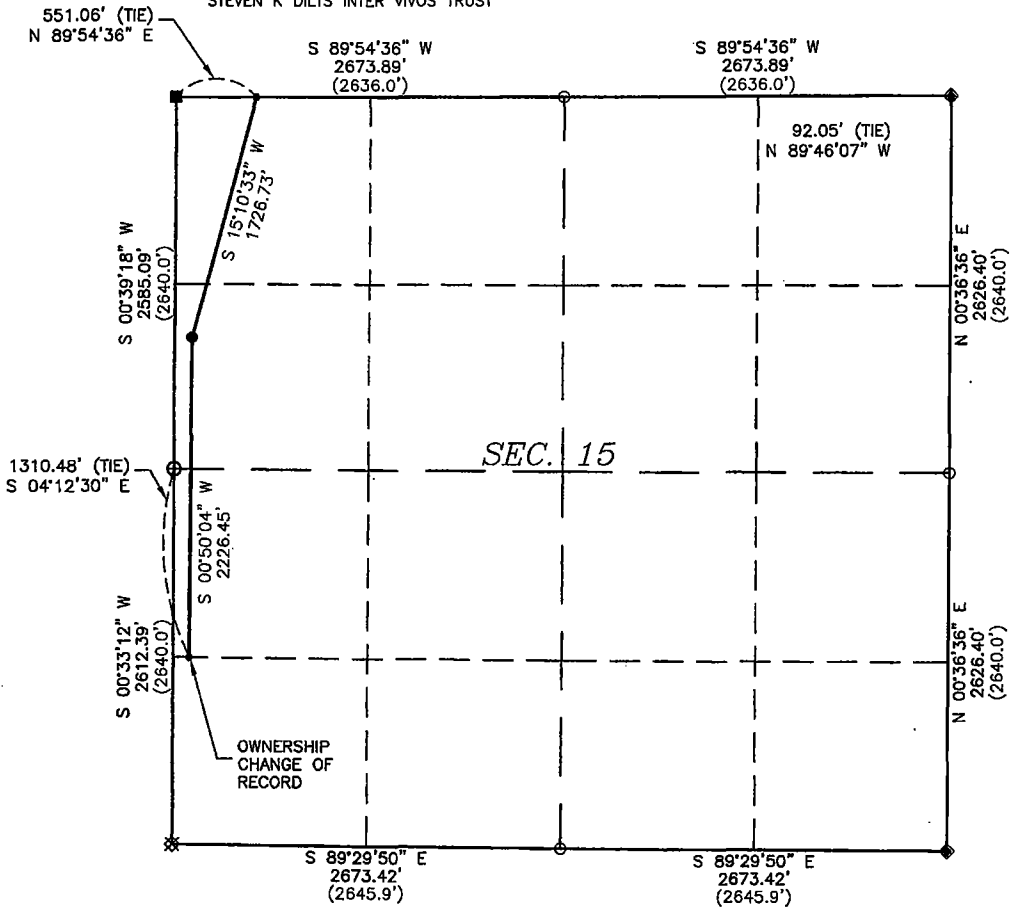

- LEGEND:**
- ⊗ ALUMINUM CAP (UNKNOWN ORIGIN)
  - 1982 LS 2097 ALUMINUM CAP
  - ⊕ 2004 LS 519 ALUMINUM CAP
  - ◆ 2008 LS 489 ALUMINUM CAP
  - CALCULATED CORNER POSITION (NOT SET)
  - ( ) RECORDED DISTANCE
  - (C) CALCULATED FROM RECORD
  - CENTERLINE OF RIGHT OF WAY EASEMENT
  - BEGINNING AND END OF ALIGNMENT DESCRIPTION
  - POWER LINE PI LOCATION

**BASIS OF BEARING:**  
 NAD 83 WYOMING STATE PLANE,  
 EAST ZONE—GRID



**LEGAL DESCRIPTION:**

The following is a legal description for a 125 foot wide easement located in portions of the NW 1/4 NW 1/4, SW 1/4 NW 1/4 and NW 1/4 SW 1/4 of Section 15, Township 39 North, Range 74 West of the 6th P.M., Converse County, Wyoming. Said easement being 62.5 feet on each side of the following described centerline:

Commencing at the Northwest corner of said Section 15, said corner being monumented with a 1982 L.S. 2097 Aluminum cap, thence N 89°54'36" E, a distance of 551.06 feet to the True Point of Beginning of said easement centerline;

Thence along said centerline S 15°10'33" W, a distance of 1726.73 feet to a point;  
 Thence along said centerline S 00°50'04" W, a distance of 2226.45 feet to a point on the South line of said NW 1/4 SW 1/4 of said Section 15, said point being S 04°12'30" E, a distance of 1310.48 feet from the West 1/4 corner of said Section 15, being a 2004 L.S. 519 Aluminum cap.

Said easement centerline being 3953.18 feet in length, more or less with side lines shortened or extended to the recorded boundary.

**CERTIFICATE OF SURVEYOR:**  
 I, THEODORE L. MCMAHON, BEING A PROFESSIONAL LAND SURVEYOR, REGISTERED UNDER THE LAWS OF THE STATE OF WYOMING, DO HEREBY CERTIFY THAT THE MAP HEREON REPRESENTS AN ACTUAL SURVEY MADE BY MYSELF AND OR BY PERSONNEL OF KNIGHT TECHNOLOGIES INCORPORATED UNDER MY DIRECT SUPERVISION AND THAT SAID PLAT AND LEGAL DESCRIPTION SHOWN ARE ACCURATELY REPRESENTED.

PREPARED FOR:  
 BLACK HILLS POWER, INC.  
 626 9th STREET  
 P.O. BOX 1400  
 RAPID CITY, SD 57708

**RIGHT OF WAY EASEMENT**  
 DILTS RANCH COMPANY &  
 STEVEN K DILTS INTER VIVOS TRUST  
 SEC. 15, T. 39 N., R. 74 W.  
 CONVERSE COUNTY, WYOMING

**NOTE:**  
 ALL CENTERLINE BEARINGS AND DISTANCES HEREIN ARE CONSIDERED TO BE MORE OR LESS. THE CENTERLINE OF THE POWERLINE AS CONSTRUCTED IS THE CENTER LINE OF THE 125' WIDE EASEMENT BEING 62.5' ON EACH SIDE



PREPARED BY:  
 KNIGHT TECHNOLOGIES, INC.  
 201 W. Lokeway Rd.  
 Suite 200  
 Gillette, WY 82718  
 Office: (307) 682-8547



DATE: 09-22-09	DESIGNED BY: KTI
SCALE: 1" = 1000'	DRAWN BY: KTI/PK
CNTR INTRVL: N/A	APPROVED BY: KTI/TLM
REVISION:	DATE: / /

**RIGHT OF WAY EASEMENT  
BLACK HILLS POWER, INC.  
SECTION 15, T. 39 N., R. 74 W., 6TH P.M.  
CONVERSE COUNTY, WYOMING**

RECORD OWNER	FOOTAGE	RODS
HARDY ENTERPRISES	1306.4'	79.17

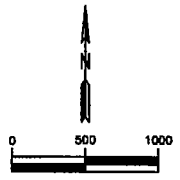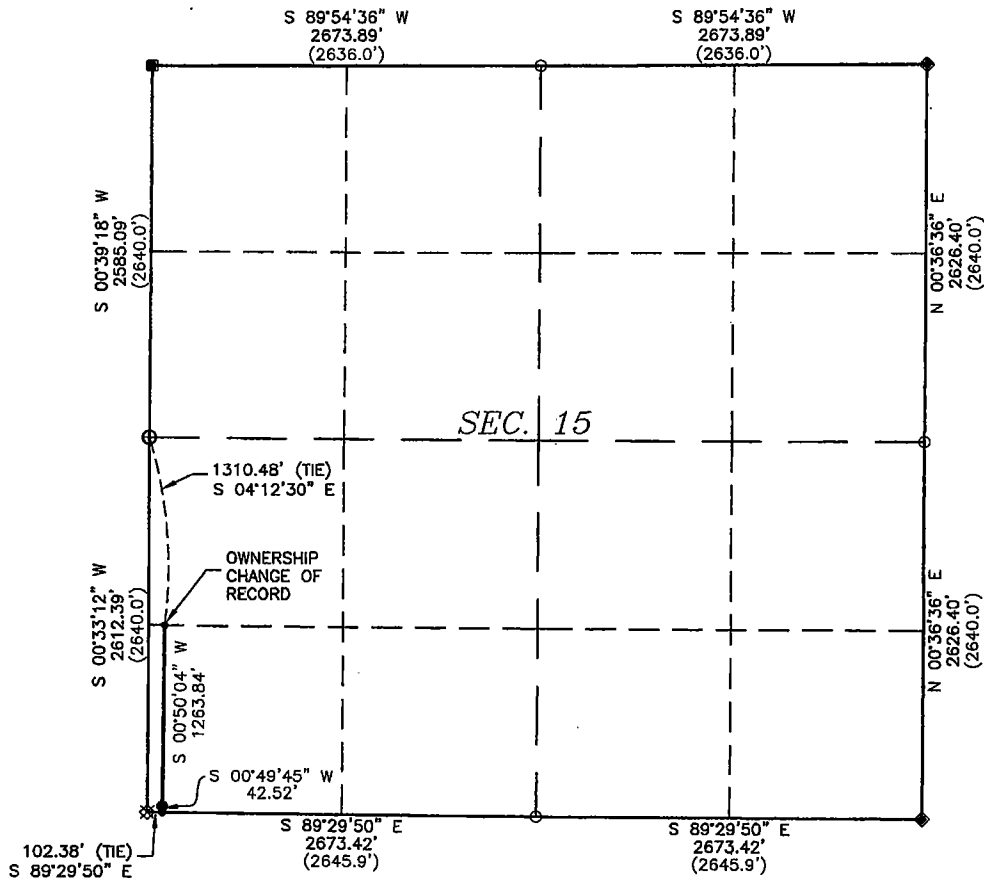

- LEGEND:**
- ⊗ ALUMINUM CAP (UNKNOWN ORIGIN)
  - 1982 LS 2097 ALUMINUM CAP
  - ⊕ 2004 LS 519 ALUMINUM CAP
  - ◆ 2008 LS 489 ALUMINUM CAP
  - CALCULATED CORNER POSITION (NOT SET)
  - ( ) RECORDED DISTANCE
  - (C) CALCULATED FROM RECORD
  - CENTERLINE OF RIGHT OF WAY EASEMENT
  - BEGINNING AND END OF ALIGNMENT DESCRIPTION
  - POWER LINE PI LOCATION

**BASIS OF BEARING:**  
NAD 83 WYOMING STATE PLANE,  
EAST ZONE-GRID



**LEGAL DESCRIPTION:**

The following is a legal description for a 125 foot wide easement located in a portion of the SW 1/4 SW 1/4 of Section 15, Township 39 North, Range 74 West of the 6th P.M., Converse County, Wyoming. Said easement being 62.5 feet on each side of the following described centerline:

Commencing at the West 1/4 corner of said Section 15, said corner being monumented with a 2004 L.S. 519 Aluminum cap, thence S 04°12'30" E, a distance of 1310.48 feet to the True Point of Beginning of said easement centerline;

Thence along said centerline S 00°50'04" W, a distance of 1263.84 feet to a point; Thence along said centerline S 00°49'45" W, a distance of 42.52 feet to a point on the South line of said Section 15, said point being S 89°29'50" E, a distance of 102.38 feet from the Southwest corner of said Section 15, being an aluminum cap.

Said easement centerline being 1306.36 feet in length, more or less with side lines shortened or extended to the recorded boundary.

**CERTIFICATE OF SURVEYOR:**  
I, THEODORE L. MCMAHON, BEING A PROFESSIONAL LAND SURVEYOR, REGISTERED UNDER THE LAWS OF THE STATE OF WYOMING, DO HEREBY CERTIFY THAT THE MAP HEREON REPRESENTS AN ACTUAL SURVEY MADE BY MYSELF AND OR BY PERSONNEL OF KNIGHT TECHNOLOGIES INCORPORATED UNDER MY DIRECT SUPERVISION AND THAT SAID PLAT AND LEGAL DESCRIPTION SHOWN ARE ACCURATELY REPRESENTED.

PREPARED FOR:  
BLACK HILLS POWER, INC.  
626 9th STREET  
P.O. BOX 1400  
RAPID CITY, SD 57709

**RIGHT OF WAY EASEMENT  
HARDY ENTERPRISES  
SEC. 15, T. 39 N., R. 74 W.  
CONVERSE COUNTY, WYOMING**

**NOTE:**  
ALL CENTERLINE BEARINGS AND DISTANCES HEREIN ARE CONSIDERED TO BE MORE OR LESS. THE CENTERLINE OF THE POWERLINE AS CONSTRUCTED IS THE CENTER LINE OF THE 125' WIDE EASEMENT BEING 62.5' ON EACH SIDE

PREPARED BY:  
KNIGHT TECHNOLOGIES, INC.  
201 W. Lakeway Rd.  
Suite 200  
Gillette, WY 82718  
Office: (307) 682-8547





DATE: 09-22-09	DESIGNED BY: KTI
SCALE: 1" = 1000'	DRAWN BY: KTI/PK
CNTR INTERVAL: N/A	APPROVED BY: KTI/TLM
REVISION:	DATE: / /




**RIGHT OF WAY EASEMENT**  
**BLACK HILLS POWER, INC.**  
 SECTION 27, T. 39 N., R. 74 W., 6TH P.M.  
 CONVERSE COUNTY, WYOMING

RECORD OWNER: HARDY ENTERPRISES      FOOTAGE: 4655.5'      RODS: 282.15

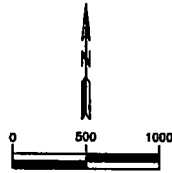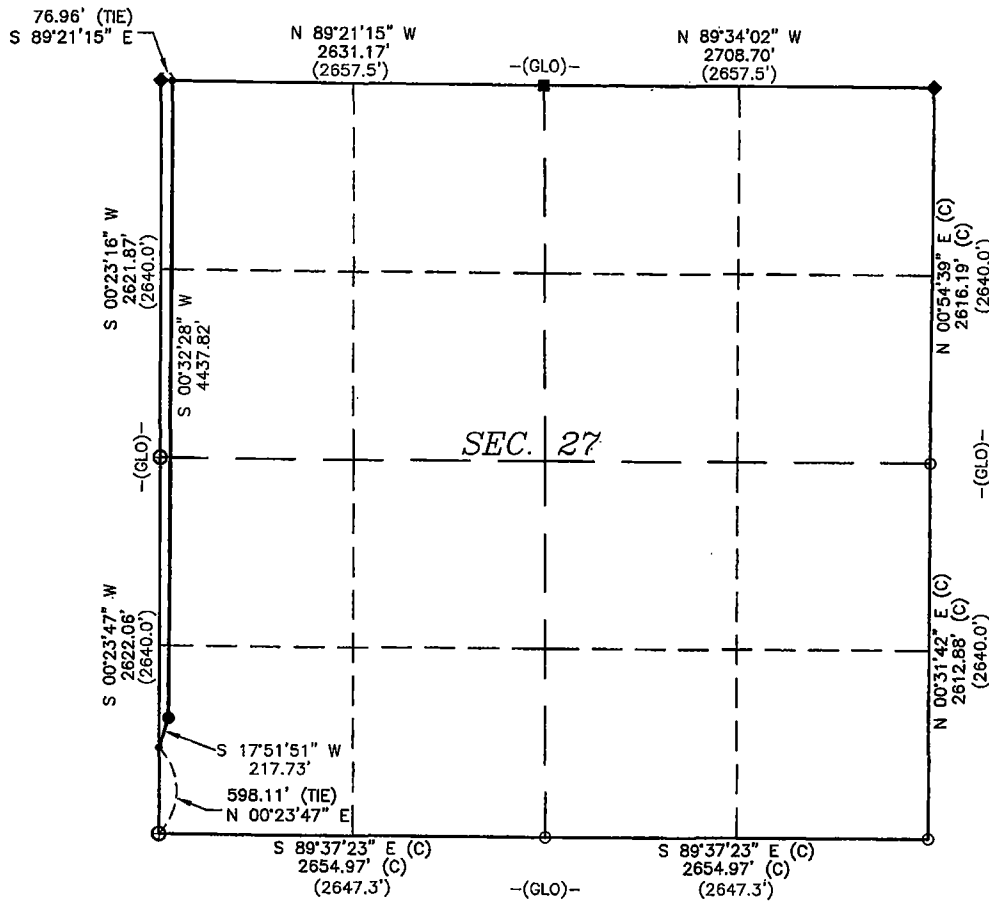

- LEGEND:**
- 1979 LS 522 ALUMINUM CAP
  - ◆ 1995 LS 538 ALUMINUM CAP
  - ⊕ 2004 LS 519 ALUMINUM CAP
  - CALCULATED CORNER POSITION (NOT SET)
  - ( ) RECORDED DISTANCE
  - (C) CALCULATED FROM RECORD
  - CENTERLINE OF RIGHT OF WAY EASEMENT
  - BEGINNING AND END OF ALIGNMENT DESCRIPTION
  - POWER LINE PI LOCATION
  - (GLO) REFERS TO RECORDS OF ORIGINAL GENERAL LAND OFFICE

**BASIS OF BEARING:**  
 NAD 83 WYOMING STATE PLANE,  
 EAST ZONE-GRID

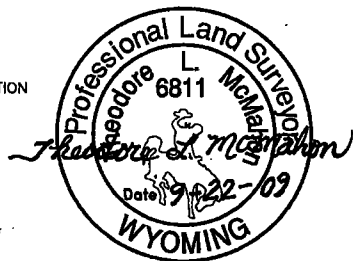

**LEGAL DESCRIPTION:**

The following is a legal description for a 125 foot wide easement located in portions of the NW 1/4 NW 1/4, SW 1/4 NW 1/4, NW 1/4 SW 1/4 and SW 1/4 SW 1/4 of Section 27, Township 39 North, Range 74 West of the 6th P.M., Converse County, Wyoming.

Said easement being 62.5 feet on each side of the following described centerline:

Commencing at the Northwest corner of said Section 27, said corner being monumented with a 1995 L.S. 538 Aluminum cap, thence S 89°21'15" E, a distance of 76.96 feet to the True Point of Beginning of said easement centerline;

Thence along said centerline S 00°32'28" W, a distance of 4437.82 feet to a point; Thence along said centerline S 17°51'51" W, a distance of 217.73 feet to a point on the West line of said Section 27, said point being N 00°23'47" E, a distance of 598.11 feet from the Southwest corner of said Section 27, being a 2004 L.S. 519 Aluminum cap.

Said easement centerline being 4655.55 feet in length, more or less with side lines shortened or extended to the recorded boundary.

**CERTIFICATE OF SURVEYOR:**  
 I, THEODORE L. MCMAHON, BEING A PROFESSIONAL LAND SURVEYOR, REGISTERED UNDER THE LAWS OF THE STATE OF WYOMING, DO HEREBY CERTIFY THAT THE MAP HEREON REPRESENTS AN ACTUAL SURVEY MADE BY MYSELF AND OR BY PERSONNEL OF KNIGHT TECHNOLOGIES INCORPORATED UNDER MY DIRECT SUPERVISION AND THAT SAID PLAT AND LEGAL DESCRIPTION SHOWN ARE ACCURATELY REPRESENTED.

PREPARED FOR:  
 BLACK HILLS POWER, INC.  
 825 9th STREET  
 P.O. BOX 1400  
 RAPID CITY, SD 57709



**RIGHT OF WAY EASEMENT**  
**HARDY ENTERPRISES**

SEC. 27, T. 39 N., R. 74 W.  
 CONVERSE COUNTY, WYOMING

DATE: 09-22-09	DESIGNED BY: KTI
SCALE: 1" = 1000'	DRAWN BY: KTI/PK
CNTR INTRVL: N/A	APPROVED BY: KTI/TLM
REVISION:	DATE: / /

**NOTE:**  
 ALL CENTERLINE BEARINGS AND DISTANCES HEREIN ARE CONSIDERED TO BE MORE OR LESS. THE CENTERLINE OF THE POWERLINE AS CONSTRUCTED IS THE CENTER LINE OF THE 125' WIDE EASEMENT BEING 62.5' ON EACH SIDE



PREPARED BY:  
 KNIGHT TECHNOLOGIES, INC.  
 201 W. Lakeway Rd.  
 Suite 200  
 Gillette, WY 82718  
 Office: (307) 682-8547



**RIGHT OF WAY EASEMENT  
BLACK HILLS POWER, INC.  
SECTION 28, T. 39 N., R. 74 W., 6TH P.M.  
CONVERSE COUNTY, WYOMING**


RECORD OWNER  
HARDY ENTERPRISES

FOOTAGE 608.6'  
RODS 36.88

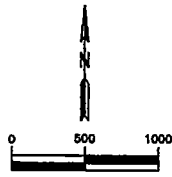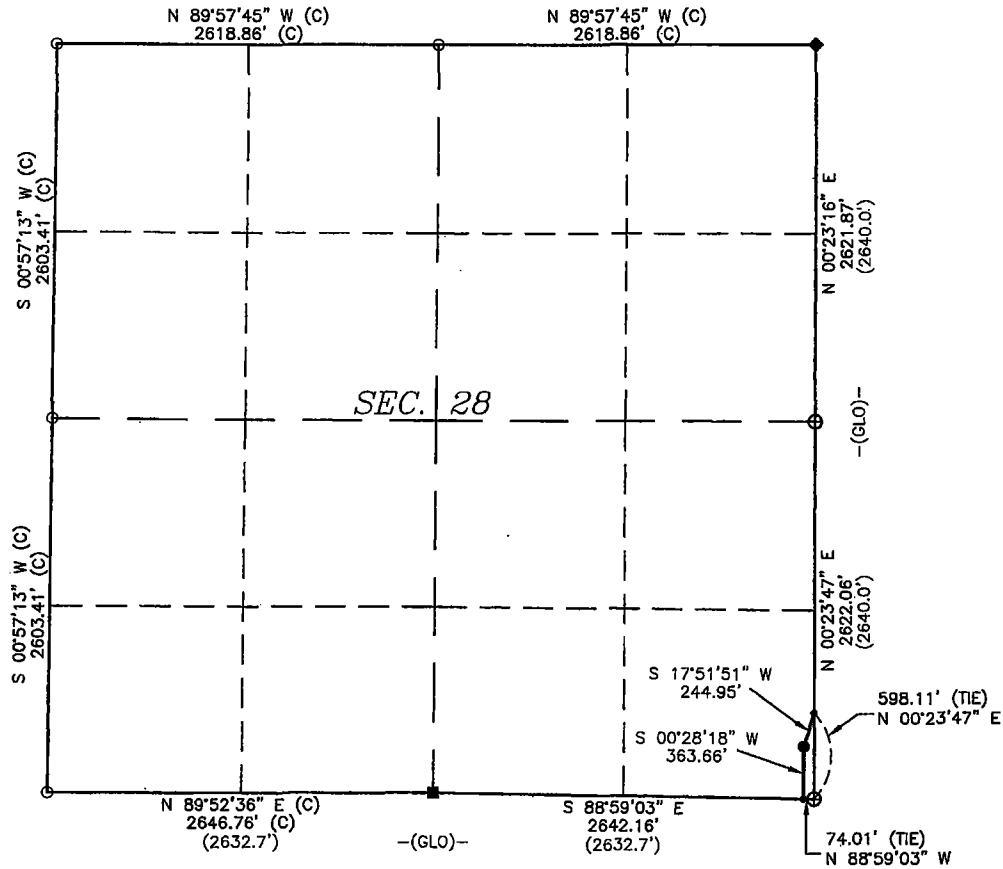

- LEGEND:**
- ANCIENT FENCE CORNER
  - ◆ 1995 LS 538 ALUMINUM CAP
  - ⊕ 2004 LS 519 ALUMINUM CAP
  - CALCULATED CORNER POSITION (NOT SET)
  - ( ) RECORDED DISTANCE
  - (C) CALCULATED FROM RECORD
  - CENTERLINE OF RIGHT OF WAY EASEMENT
  - BEGINNING AND END OF ALIGNMENT DESCRIPTION
  - POWER LINE PI LOCATION
  - (GLO) REFERS TO RECORDS OF ORIGINAL GENERAL LAND OFFICE

**BASIS OF BEARING:**  
NAD 83 WYOMING STATE PLANE,  
EAST ZONE-GRID

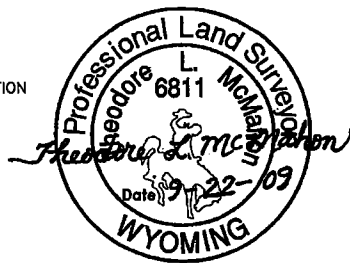

**LEGAL DESCRIPTION:**

The following is a legal description for a 125 foot wide easement located in a portion of the SE 1/4 SE 1/4 of Section 28, Township 39 North, Range 74 West of the 6th P.M., Converse County, Wyoming. Said easement being 62.5 feet on each side of the following described centerline:

Commencing at the Southeast corner of said Section 28, said corner being monumented with a 2004 L.S. 519 Aluminum cap, thence N 00°23'47" E, a distance of 598.11 feet to the True Point of Beginning of said easement centerline;

Thence along said centerline S 17°51'51" W, a distance of 244.95 to a point; Thence along said centerline S 00°28'18" W, a distance of 363.66 to a point on the South line of said Section 28, said point being N 88°59'03" W, a distance of 74.01 feet from the Southeast corner of said Section 28, being a 2004 L.S. 519 Aluminum cap.

Said easement centerline being 608.61 feet in length, more or less with side lines shortened or extended to the recorded boundary.

**CERTIFICATE OF SURVEYOR:**  
I, THEODORE L. MCMAHON, BEING A PROFESSIONAL LAND SURVEYOR, REGISTERED UNDER THE LAWS OF THE STATE OF WYOMING, DO HEREBY CERTIFY THAT THE MAP HEREON REPRESENTS AN ACTUAL SURVEY MADE BY MYSELF AND OR BY PERSONNEL OF KNIGHT TECHNOLOGIES INCORPORATED UNDER MY DIRECT SUPERVISION AND THAT SAID PLAT AND LEGAL DESCRIPTION SHOWN ARE ACCURATELY REPRESENTED.

PREPARED FOR:  
BLACK HILLS POWER, INC.  
626 9th STREET  
P.O. BOX 1400  
RAPID CITY, SD 57709



**RIGHT OF WAY EASEMENT  
HARDY ENTERPRISES**

SEC. 28, T. 39 N., R. 74 W.  
CONVERSE COUNTY, WYOMING

DATE: 09-22-09	DESIGNED BY: KTI
SCALE: 1" = 1000'	DRAWN BY: KTI/PK
CNTR INTVL: N/A	APPROVED BY: KTI/TLM
REVISION:	DATE: / /

**NOTE:**  
ALL CENTERLINE BEARINGS AND DISTANCES HEREIN ARE CONSIDERED TO BE MORE OR LESS. THE CENTERLINE OF THE POWERLINE AS CONSTRUCTED IS THE CENTER LINE OF THE 125' WIDE EASEMENT BEING 62.5' ON EACH SIDE



PREPARED BY:  
KNIGHT TECHNOLOGIES, INC.  
201 W. Lakeway Rd.  
Suite 200  
Gillette, WY 82718  
Office: (307) 682-8547





**RIGHT OF WAY EASEMENT  
BLACK HILLS POWER, INC.  
SECTION 33, T. 39 N., R. 74 W., 6TH P.M.  
CONVERSE COUNTY, WYOMING**

RECORD OWNER ALLEMAND FAMILY TRUST FOOTAGE 5241.2' RODS 317.65

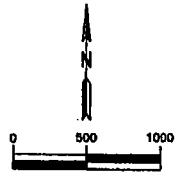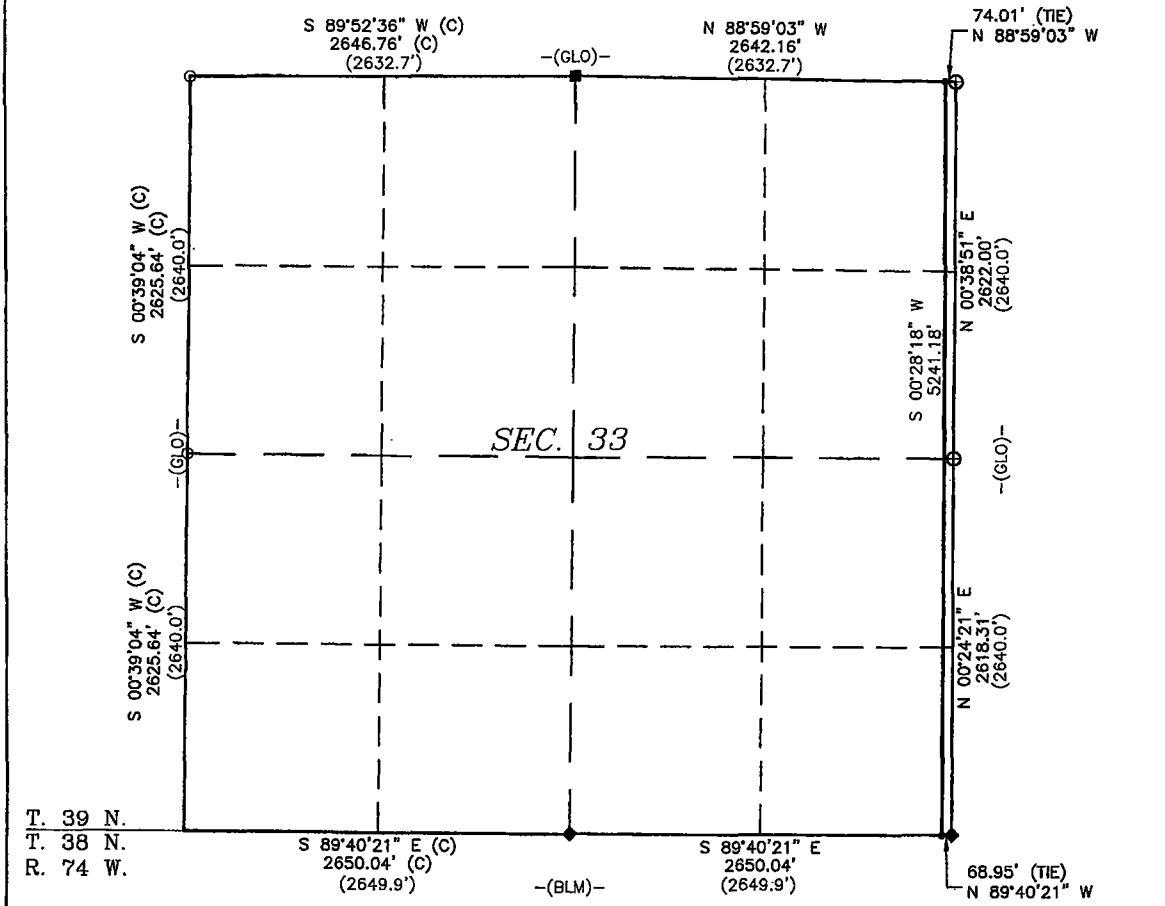

- LEGEND:**
- ANCIENT FENCE CORNER
  - ◆ 1989 B.L.M. BRASS CAP
  - ⊕ 2004 LS 519 ALUMINUM CAP
  - CALCULATED CORNER POSITION (NOT SET)
  - ( ) RECORDED DISTANCE
  - (C) CALCULATED FROM RECORD
  - CENTERLINE OF RIGHT OF WAY EASEMENT
  - BEGINNING AND END OF ALIGNMENT DESCRIPTION
  - (GLO) REFERS TO RECORDS OF ORIGINAL GENERAL LAND OFFICE
  - (BLM) REFERS TO RECORDS OF B.L.M. RESURVEY

**BASIS OF BEARING:**  
NAD 83 WYOMING STATE PLANE,  
EAST ZONE-GRID



**LEGAL DESCRIPTION:**

The following is a legal description for a 125 foot wide easement located in portions of the NE 1/4 NE 1/4, SE 1/4 NE 1/4, NE 1/4 SE 1/4 and SE 1/4 SE 1/4 of Section 33, Township 39 North, Range 74 West of the 6th P.M., Converse County, Wyoming. Said easement being 62.5 feet on each side of the following described centerline:

Commencing at the Northeast corner of said Section 33, said corner being monumented with a 2004 L.S. 519 Aluminum cap, thence N 88°59'03" W, a distance of 74.01 feet to the True Point of Beginning of said easement centerline;

Thence along said centerline S 00°28'18" W, a distance of 5241.18 to a point on the South line of said Section 33, said point being N 89°40'21" W, a distance of 68.95 feet from the Southeast corner of said Section 33, being a 1989 B.L.M. Brass cap.

Said easement centerline being 5241.18 feet in length, more or less with side lines shortened or extended to the recorded boundary.

**CERTIFICATE OF SURVEYOR:**  
I, THEODORE L. MCMAHON, BEING A PROFESSIONAL LAND SURVEYOR, REGISTERED UNDER THE LAWS OF THE STATE OF WYOMING, DO HEREBY CERTIFY THAT THE MAP HEREON REPRESENTS AN ACTUAL SURVEY MADE BY MYSELF AND OR BY PERSONNEL OF KNIGHT TECHNOLOGIES INCORPORATED UNDER MY DIRECT SUPERVISION AND THAT SAID PLAT AND LEGAL DESCRIPTION SHOWN ARE ACCURATELY REPRESENTED.

PREPARED FOR: BLACK HILLS POWER, INC. 625 6th STREET P.O. BOX 1400 RAPID CITY, SD 57709		
<b>RIGHT OF WAY EASEMENT</b> ALLEMAND FAMILY TRUST  SEC. 33, T. 39 N., R. 74 W. CONVERSE COUNTY, WYOMING		
DATE: 09-22-09	DESIGNED BY: KTI	
SCALE: 1" = 1000'	DRAWN BY: KTI/PK	
CNTR INTRVL: N/A	APPROVED BY: KTI/TLM	
REVISION:	DATE: / /	

**NOTE:**  
ALL CENTERLINE BEARINGS AND DISTANCES HEREIN ARE CONSIDERED TO BE MORE OR LESS. THE CENTERLINE OF THE POWERLINE AS CONSTRUCTED IS THE CENTER LINE OF THE 125' WIDE EASEMENT BEING 62.5' ON EACH SIDE



PREPARED BY:  
KNIGHT TECHNOLOGIES, INC.  
201 W. Lakeway Rd.  
Suite 200  
Gillette, WY 82718  
Office: (307) 682-8547



**RIGHT OF WAY EASEMENT  
BLACK HILLS POWER, INC.**

SECTION 4, T. 38 N., R. 74 W., 6TH P.M.  
CONVERSE COUNTY, WYOMING

RECORD OWNER	FOOTAGE	RODS
ALLEMAND FAMILY TRUST	5290.4'	320.63

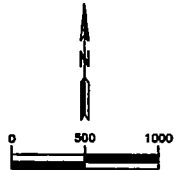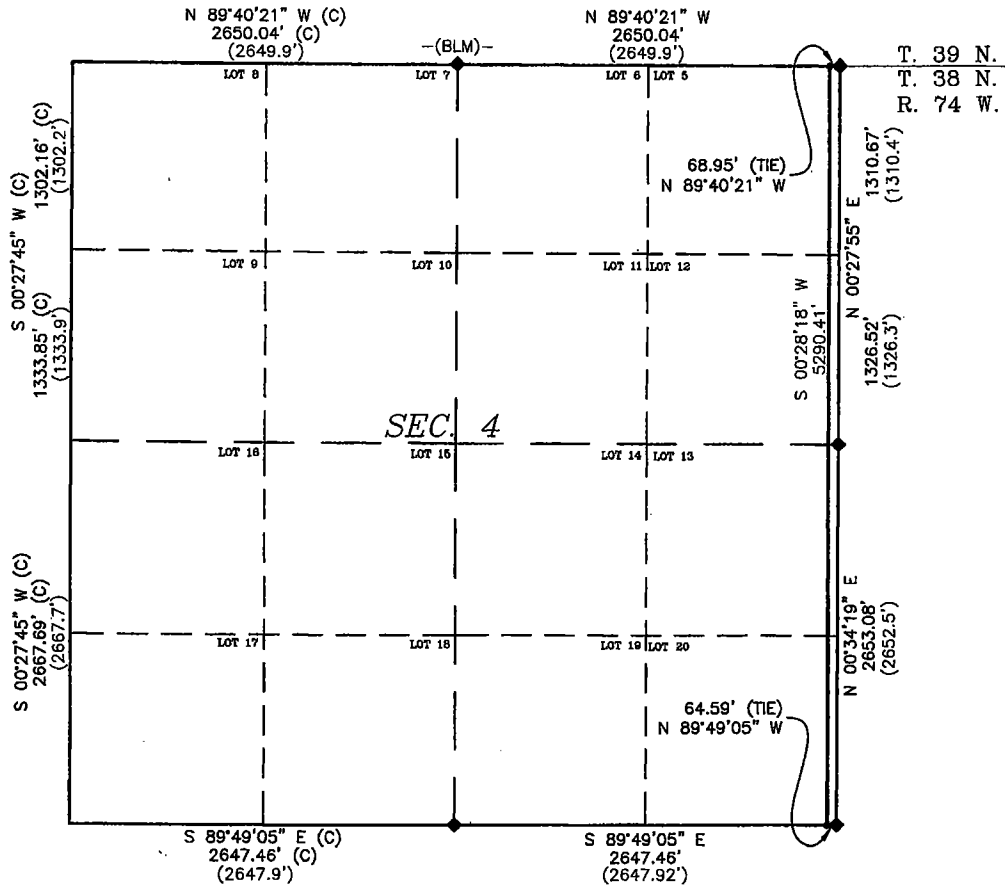

- LEGEND:**
- ◆ 1989 B.L.M. BRASS CAP
  - ( ) RECORDED DISTANCE
  - (C) CALCULATED FROM RECORD
  - CENTERLINE OF RIGHT OF WAY EASEMENT
  - BEGINNING AND END OF ALIGNMENT DESCRIPTION

**BASIS OF BEARING:**  
NAD 83 WYOMING STATE PLANE,  
EAST ZONE-GRID


**LEGAL DESCRIPTION:**

The following is a legal description for a 125 foot wide easement located in portions of Lot 5 (NE 1/4 NE 1/4), Lot 12 (SE 1/4 NE 1/4), Lot 13 (NE 1/4 SE 1/4) and Lot 20 (SE 1/4 SE 1/4) of Section 4, Township 38 North, Range 74 West of the 6th P.M., Converse County, Wyoming. Said easement being 62.5 feet on each side of the following described centerline:

Commencing at the Northeast corner of said Section 4, said corner being monumented with a 1989 B.L.M. Brass cap, thence N 89°40'21" W, a distance of 68.95 feet to the True Point of Beginning of said easement centerline;

Thence along said centerline S 00°28'18" W, a distance of 5290.41 feet to a point on the South line of said Section 4, said point being N 89°49'05" W, a distance of 64.59 feet from the Southeast corner of said Section 4, being a 1989 B.L.M. Brass cap.

Said easement centerline being 5290.41 feet in length, more or less with side lines shortened or extended to the recorded boundary.

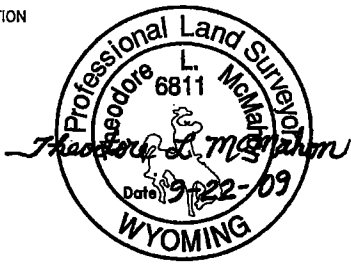

**CERTIFICATE OF SURVEYOR:**  
I, THEODORE L. MCMAHON, BEING A PROFESSIONAL LAND SURVEYOR, REGISTERED UNDER THE LAWS OF THE STATE OF WYOMING, DO HEREBY CERTIFY THAT THE MAP HEREON REPRESENTS AN ACTUAL SURVEY MADE BY MYSELF AND OR BY PERSONNEL OF KNIGHT TECHNOLOGIES INCORPORATED UNDER MY DIRECT SUPERVISION AND THAT SAID PLAT AND LEGAL DESCRIPTION SHOWN ARE ACCURATELY REPRESENTED.

PREPARED FOR:  
BLACK HILLS POWER, INC.  
626 9th STREET  
P.O. BOX 1400  
RAPID CITY, SD 57708



<b>RIGHT OF WAY EASEMENT ALLEMAND FAMILY TRUST</b>	
SEC. 4, T. 38 N., R. 74 W. CONVERSE COUNTY, WYOMING	
DATE: 08-21-08	DESIGNED BY: KTI
SCALE: 1" = 1000'	DRAWN BY: KTI/PK
CNTR INTERVAL: N/A	APPROVED BY: KTI/TLM
REVISION:	DATE: / /

PREPARED BY:  
KNIGHT TECHNOLOGIES, INC.  
201 W. Lakeway Rd.  
Suite 200  
Gillette, WY 82718  
Office: (307) 682-8547

**NOTE:**  
ALL CENTERLINE BEARINGS AND DISTANCES HEREIN ARE CONSIDERED TO BE MORE OR LESS. THE CENTERLINE OF THE POWERLINE AS CONSTRUCTED IS THE CENTER LINE OF THE 125' WIDE EASEMENT BEING 62.5' ON EACH SIDE

**RIGHT OF WAY EASEMENT  
BLACK HILLS POWER, INC.  
SECTION 9, T. 38 N., R. 74 W., 6TH P.M.  
CONVERSE COUNTY, WYOMING**

<b>RECORD OWNER</b>	<b>FOOTAGE</b>	<b>RODS</b>
JOE PATTERSON RANCH CORPORATION	5295.5'	320.94

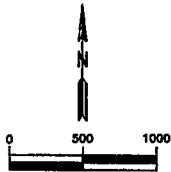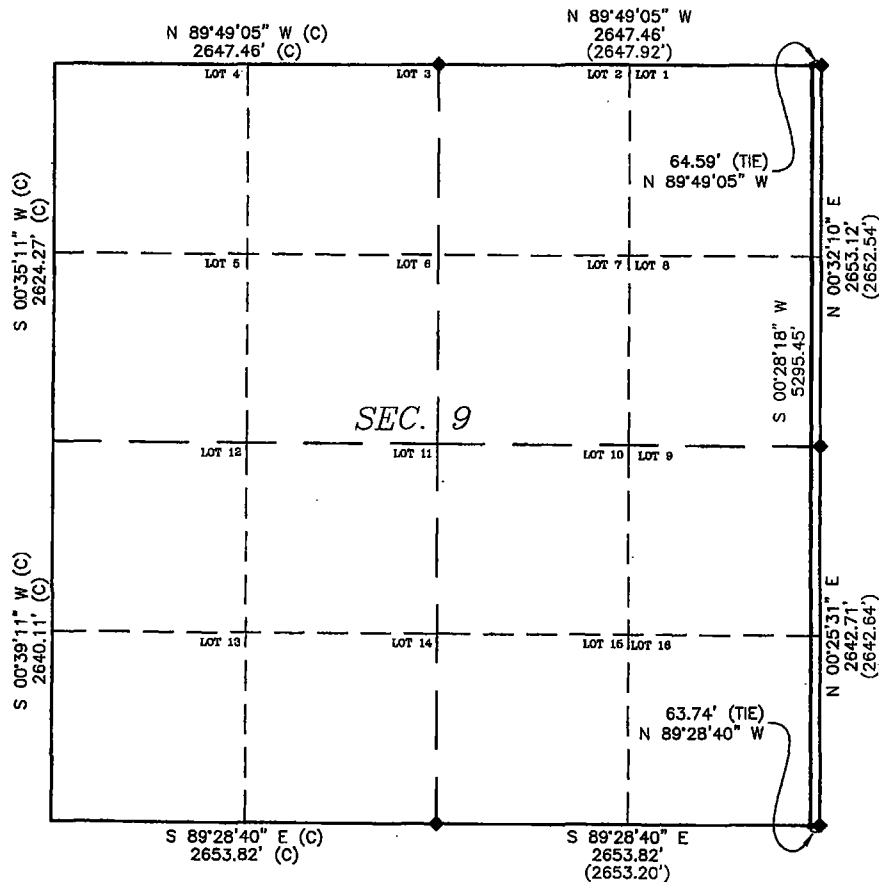

- LEGEND:**
- ◆ 1989 B.L.M. BRASS CAP
  - ( ) RECORDED DISTANCE
  - (C) CALCULATED FROM RECORD
  - CENTERLINE OF RIGHT OF WAY EASEMENT
  - BEGINNING AND END OF ALIGNMENT DESCRIPTION

**BASIS OF BEARING:**  
NAD 83 WYOMING STATE PLANE,  
EAST ZONE—GRID


**LEGAL DESCRIPTION:**

The following is a legal description for a 125 foot wide easement located in portions of Lot 1 (NE 1/4 NE 1/4), Lot 8 (SE 1/4 NE 1/4), Lot 9 (NE 1/4 SE 1/4) and Lot 16 (SE 1/4 SE 1/4) of Section 9, Township 38 North, Range 74 West of the 6th P.M., Converse County, Wyoming. Said easement being 62.5 feet on each side of the following described centerline:

Commencing at the Northeast corner of said Section 9, said corner being monumented with a 1989 B.L.M. Brass cap, thence N 89°49'05" W, a distance of 64.59 feet to the True Point of Beginning of said easement centerline;

Thence along said centerline S 00°28'18" W, a distance of 5295.45 feet to a point on the South line of said Section 9, said point being N 89°28'40" W, a distance of 63.74 feet from the Southeast corner of said Section 9, being a 1989 B.L.M. Brass cap.

Said easement centerline being 5295.45 feet in length, more or less with side lines shortened or extended to the recorded boundary.

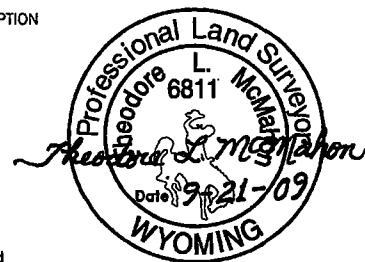

**CERTIFICATE OF SURVEYOR:**  
I, THEODORE L. MCMAHON, BEING A PROFESSIONAL LAND SURVEYOR, REGISTERED UNDER THE LAWS OF THE STATE OF WYOMING, DO HEREBY CERTIFY THAT THE MAP HEREON REPRESENTS AN ACTUAL SURVEY MADE BY MYSELF AND OR BY PERSONNEL OF KNIGHT TECHNOLOGIES INCORPORATED UNDER MY DIRECT SUPERVISION AND THAT SAID PLAT AND LEGAL DESCRIPTION SHOWN ARE ACCURATELY REPRESENTED.

PREPARED FOR:  
BLACK HILLS POWER, INC.  
826 DIN STREET  
P.O. BOX 1400  
RAPID CITY, SD 57709



**RIGHT OF WAY EASEMENT  
JOB PATTERSON RANCH CORPORATION**

SEC. 9, T. 38 N., R. 74 W.  
CONVERSE COUNTY, WYOMING

**NOTE:**  
ALL CENTERLINE BEARINGS AND DISTANCES HEREIN ARE CONSIDERED TO BE MORE OR LESS. THE CENTERLINE OF THE POWERLINE AS CONSTRUCTED IS THE CENTER LINE OF THE 125' WIDE EASEMENT BEING 62.5' ON EACH SIDE



PREPARED BY:  
KNIGHT TECHNOLOGIES, INC.  
201 W. Lakeway Rd.  
Suite 200  
Gillette, WY 82718  
Office: (307) 682-8547



DATE: 09-21-09	DESIGNED BY: KTI
SCALE: 1" = 1000'	DRAWN BY: KTI/PK
CNTR INTRVL: N/A	APPROVED BY: KTI/TLM
REVISION:	DATE: / /

**RIGHT OF WAY EASEMENT  
BLACK HILLS POWER, INC.  
SECTION 21, T. 38 N., R. 74 W., 6TH P.M.  
CONVERSE COUNTY, WYOMING**

RECORD OWNER	FOOTAGE	RODS
MANNING FAMILY BYPASS TRUST MAE ANN MANNING REVOCABLE TRUST	889.1'	53.88

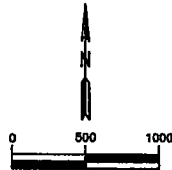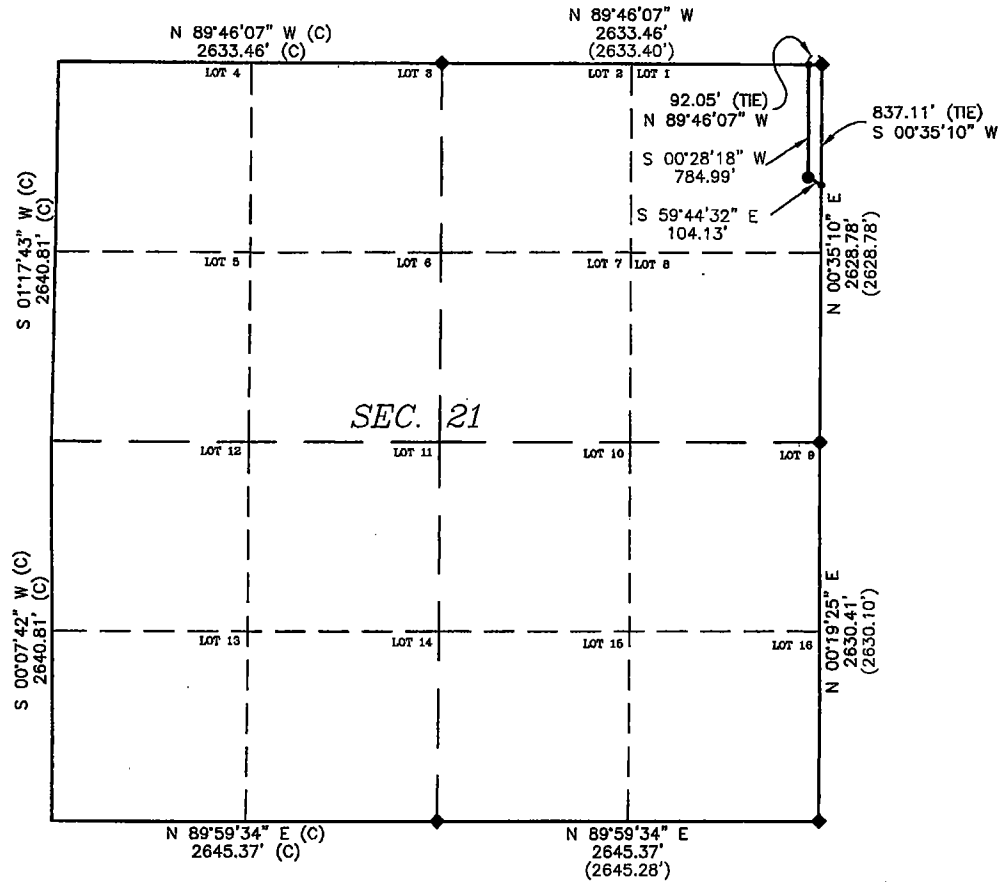

- LEGEND:**
- ◆ 1989 B.L.M. BRASS CAP
  - ( ) RECORDED DISTANCE
  - (C) CALCULATED FROM RECORD
  - CENTERLINE OF RIGHT OF WAY EASEMENT
  - BEGINNING AND END OF ALIGNMENT DESCRIPTION
  - POWER LINE PI LOCATION

**BASIS OF BEARING:**  
NAD 83 WYOMING STATE PLANE,  
EAST ZONE-GRID


**LEGAL DESCRIPTION:**

The following is a legal description for a 125 foot wide easement located in a portion of Lot 1 (NE 1/4 NE 1/4) of Section 21, Township 38 North, Range 74 West of the 6th P.M., Converse County, Wyoming. Said easement being 62.5 feet on each side of the following described centerline:

Commencing at the Northeast corner of said Section 21, said corner being monumented with a 1989 B.L.M. Brass cap, thence N 89°46'07" W, a distance of 92.05 feet to the True Point of Beginning of said easement centerline;

Thence along said centerline S 00°28'18" W, a distance of 784.99 feet to a point;  
Thence along said centerline S 59°44'32" E, a distance of 104.13 feet to a point on the East line of said Section 21, said point being S 00°35'10" W, a distance of 837.11 feet from the Northeast corner of said Section 21, being a 1989 B.L.M. Brass cap.

Said easement centerline being 889.12 feet in length, more or less with side lines shortened or extended to the recorded boundary.

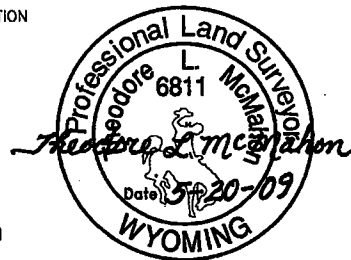

**CERTIFICATE OF SURVEYOR:**  
I, THEODORE L. MCMAHON, BEING A PROFESSIONAL LAND SURVEYOR, REGISTERED UNDER THE LAWS OF THE STATE OF WYOMING, DO HEREBY CERTIFY THAT THE MAP HEREON REPRESENTS AN ACTUAL SURVEY MADE BY MYSELF AND OR BY PERSONNEL OF KNIGHT TECHNOLOGIES INCORPORATED UNDER MY DIRECT SUPERVISION AND THAT SAID PLAT AND LEGAL DESCRIPTION SHOWN ARE ACCURATELY REPRESENTED.

PREPARED FOR: BLACK HILLS POWER, INC. 625 9th STREET P.O. BOX 1400 RAPID CITY, SD 57709		
<b>RIGHT OF WAY EASEMENT</b> MANNING FAMILY BYPASS TRUST MAE ANN MANNING REVOCABLE TRUST SEC. 21, T. 38 N., R. 74 W. CONVERSE COUNTY, WYOMING		
DATE: 05-14-09	DESIGNED BY: KTI	
SCALE: 1" = 1000'	DRAWN BY: KTI/PK	
CYR INTRVL: N/A	APPROVED BY: KTI/TLM	
REVISION:	DATE: / /	

**NOTE:**  
ALL CENTERLINE BEARINGS AND DISTANCES HEREIN ARE CONSIDERED TO BE MORE OR LESS. THE CENTERLINE OF THE POWERLINE AS CONSTRUCTED IS THE CENTER LINE OF THE 125' WIDE EASEMENT BEING 62.5' ON EACH SIDE



PREPARED BY:  
KNIGHT TECHNOLOGIES, INC.  
201 W. Lakeway Rd.  
Suite 200  
Gillette, WY 82718  
Office: (307) 682-8547



**RIGHT OF WAY EASEMENT  
BLACK HILLS POWER, INC.**

SECTION 22, T. 38 N., R. 74 W., 6TH P.M.  
CONVERSE COUNTY, WYOMING

RECORD OWNER	FOOTAGE	RODS
MANNING FAMILY BYPASS TRUST	942.6'	57.13
MAE ANN MANNING REVOCABLE TRUST		

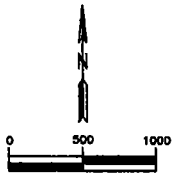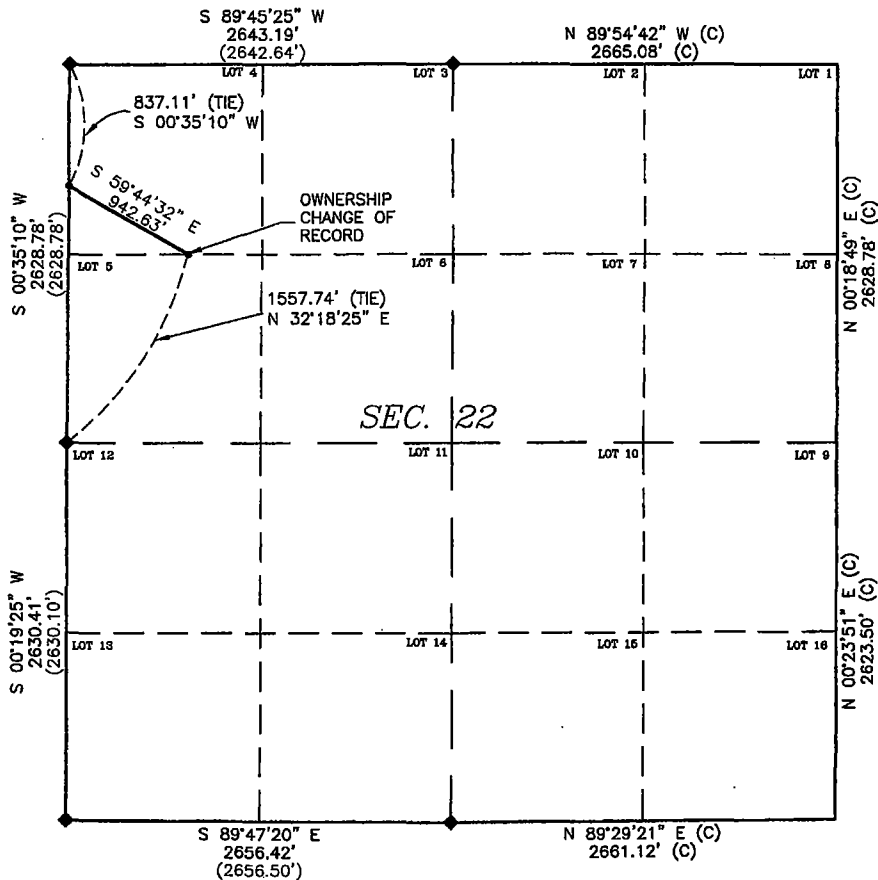

**LEGEND:**

- ◆ 1989 B.L.M. BRASS CAP
- ( ) RECORDED DISTANCE
- (C) CALCULATED FROM RECORD
- CENTERLINE OF RIGHT OF WAY EASEMENT
- BEGINNING AND END OF ALIGNMENT DESCRIPTION

**BASIS OF BEARING:**  
NAD 83 WYOMING STATE PLANE,  
EAST ZONE-GRID

**LEGAL DESCRIPTION:**

The following is a legal description for a 125 foot wide easement located in a portion of Lot 4 (NW 1/4 NW 1/4) of Section 22, Township 38 North, Range 74 West of the 6th P.M., Converse County, Wyoming. Said easement being 62.5 feet on each side of the following described centerline:

Commencing at the Northwest corner of said Section 22, said corner being monumented with a 1989 B.L.M. Brass cap, thence S 00°35'10" W, a distance of 837.11 feet to the True Point of Beginning of said easement centerline;

Thence along said centerline S 59°44'32" E, a distance of 942.63 feet to a point on the South line of Lot 4 (NW 1/4 NW 1/4) of said Section 22, said point being N 32°18'25" E, a distance of 1557.74 feet from the West 1/4 corner of said Section 22, being a 1989 B.L.M. Brass cap.

Said easement centerline being 942.63 feet in length, more or less with side lines shortened or extended to the recorded boundary.



**CERTIFICATE OF SURVEYOR:**

I, THEODORE L. MCMAHON, BEING A PROFESSIONAL LAND SURVEYOR, REGISTERED UNDER THE LAWS OF THE STATE OF WYOMING, DO HEREBY CERTIFY THAT THE MAP HEREON REPRESENTS AN ACTUAL SURVEY MADE BY MYSELF AND OR BY PERSONNEL OF KNIGHT TECHNOLOGIES INCORPORATED UNDER MY DIRECT SUPERVISION AND THAT SAID PLAT AND LEGAL DESCRIPTION SHOWN ARE ACCURATELY REPRESENTED.

PREPARED FOR:  
BLACK HILLS POWER, INC.  
625 9th STREET  
P.O. BOX 1400  
RAPID CITY, SD 57709

**RIGHT OF WAY EASEMENT  
MANNING FAMILY BYPASS TRUST  
MAE ANN MANNING REVOCABLE TRUST  
SEC. 22, T. 38 N., R. 74 W.  
CONVERSE COUNTY, WYOMING**

**NOTE:**  
ALL CENTERLINE BEARINGS AND DISTANCES HEREIN ARE CONSIDERED TO BE MORE OR LESS. THE CENTERLINE OF THE POWERLINE AS CONSTRUCTED IS THE CENTER LINE OF THE 125' WIDE EASEMENT BEING 62.5' ON EACH SIDE



PREPARED BY:  
KNIGHT TECHNOLOGIES, INC.  
201 W. Lakeway Rd.  
Suite 200  
Gillette, WY 82718  
Office: (307) 682-8547



DATE: 05-28-09	DESIGNED BY: KTI
SCALE: 1" = 1000'	DRAWN BY: KTI/PK
CNTR INTRVL: N/A	APPROVED BY: KTI/TLM
REVISION:	DATE: / /

**RIGHT OF WAY EASEMENT  
BLACK HILLS POWER, INC.  
SECTION 22, T. 38 N., R. 74 W., 6TH P.M.  
CONVERSE COUNTY, WYOMING**

RECORD OWNER	FOOTAGE	RODS
JOE PATTERSON RANCH CORPORATION	4191.5'	254.03

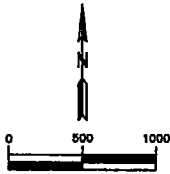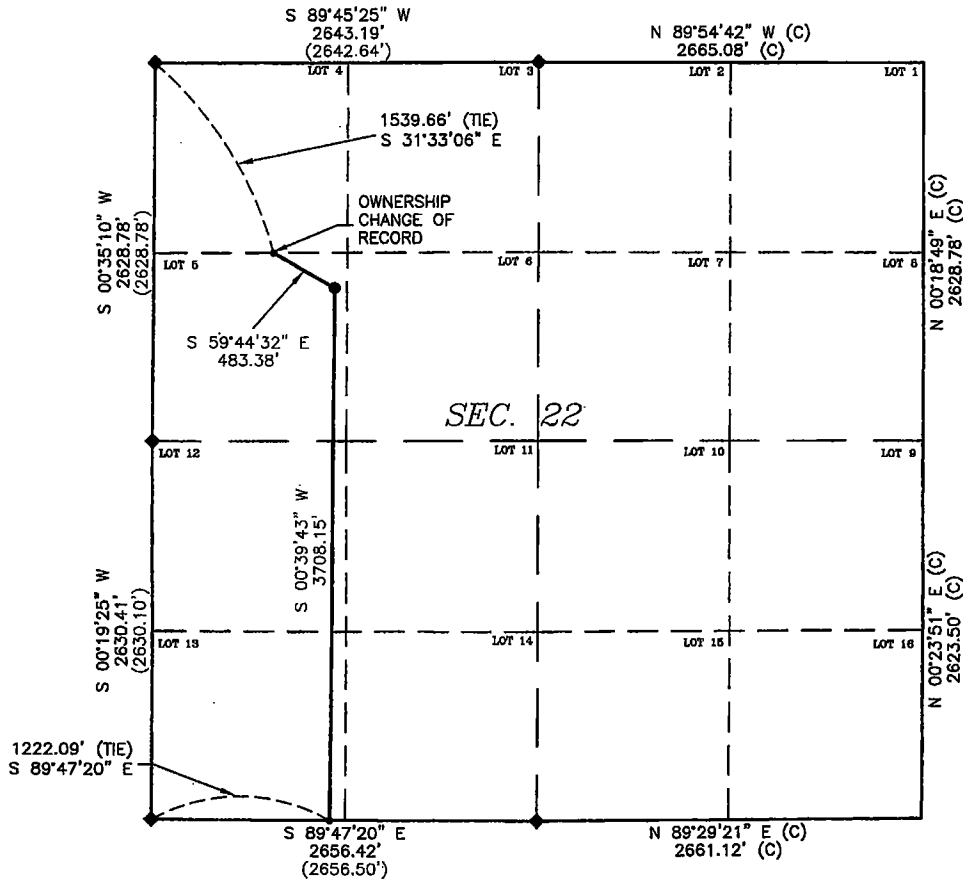

- LEGEND:**
- ◆ 1989 B.L.M. BRASS CAP
  - ( ) RECORDED DISTANCE
  - (C) CALCULATED FROM RECORD
  - CENTERLINE OF RIGHT OF WAY EASEMENT
  - BEGINNING AND END OF ALIGNMENT DESCRIPTION
  - POWER LINE PI LOCATION

**BASIS OF BEARING:**  
NAD 83 WYOMING STATE PLANE,  
EAST ZONE—GRID


**LEGAL DESCRIPTION:**

The following is a legal description for a 125 foot wide easement located in portions of Lot 5 (SW 1/4 NW 1/4), Lot 12 (NW 1/4 SW 1/4) and Lot 13 (SW 1/4 SW 1/4) of Section 22, Township 38 North, Range 74 West of the 6th P.M., Converse County, Wyoming. Said easement being 62.5 feet on each side of the following described centerline:

Commencing at the Northwest corner of said Section 22, said corner being monumented with a 1989 B.L.M. Brass cap, thence S 31°33'06" E, a distance of 1539.66 feet to the True Point of Beginning of said easement centerline;

Thence along said centerline S 59°44'32" E, a distance of 483.38 feet to a point;  
Thence along said centerline S 00°39'43" W, a distance of 3708.15 feet to a point on the South line of said Section 22, said point being S 89°47'20" E, a distance of 1222.09 feet from the Southwest corner of said Section 22, being a 1989 B.L.M. Brass cap.

Said easement centerline being 4191.53 feet in length, more or less with side lines shortened or extended to the recorded boundary.

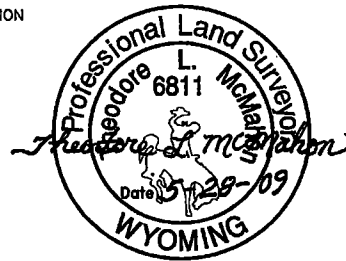

**CERTIFICATE OF SURVEYOR:**  
I, THEODORE L. MCMAHON, BEING A PROFESSIONAL LAND SURVEYOR, REGISTERED UNDER THE LAWS OF THE STATE OF WYOMING, DO HEREBY CERTIFY THAT THE MAP HEREON REPRESENTS AN ACTUAL SURVEY MADE BY MYSELF AND OR BY PERSONNEL OF KNIGHT TECHNOLOGIES INCORPORATED UNDER MY DIRECT SUPERVISION AND THAT SAID PLAT AND LEGAL DESCRIPTION SHOWN ARE ACCURATELY REPRESENTED.

PREPARED FOR:  
BLACK HILLS POWER, INC.  
826 9th STREET  
P.O. BOX 1400  
RAPID CITY, SD 57709



**RIGHT OF WAY EASEMENT  
JOE PATTERSON RANCH CORPORATION**

SEC. 22, T. 38 N., R. 74 W.  
CONVERSE COUNTY, WYOMING

DATE: 05-28-09	DESIGNED BY: KTI
SCALE: 1" = 1000'	DRAWN BY: KTI/HMB
CNTR INTRVL: N/A	APPROVED BY: KTI/TLM
REVISION:	DATE: / /



**NOTE:**  
ALL CENTERLINE BEARINGS AND DISTANCES HEREIN ARE CONSIDERED TO BE MORE OR LESS. THE CENTERLINE OF THE POWERLINE AS CONSTRUCTED IS THE CENTER LINE OF THE 125' WIDE EASEMENT BEING 62.5' ON EACH SIDE

PREPARED BY:  
KNIGHT TECHNOLOGIES, INC.  
201 W. Lokeway Rd.  
Suite 200  
Gillette, WY 82718  
Office: (307) 682-8547



**RIGHT OF WAY EASEMENT  
BLACK HILLS POWER, INC.  
SECTION 27, T. 38 N., R. 74 W., 6TH P.M.  
CONVERSE COUNTY, WYOMING**

RECORD OWNER	FOOTAGE	RODS
JOE PATTERSON RANCH CORPORATION	1509.5'	91.48

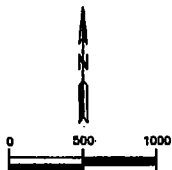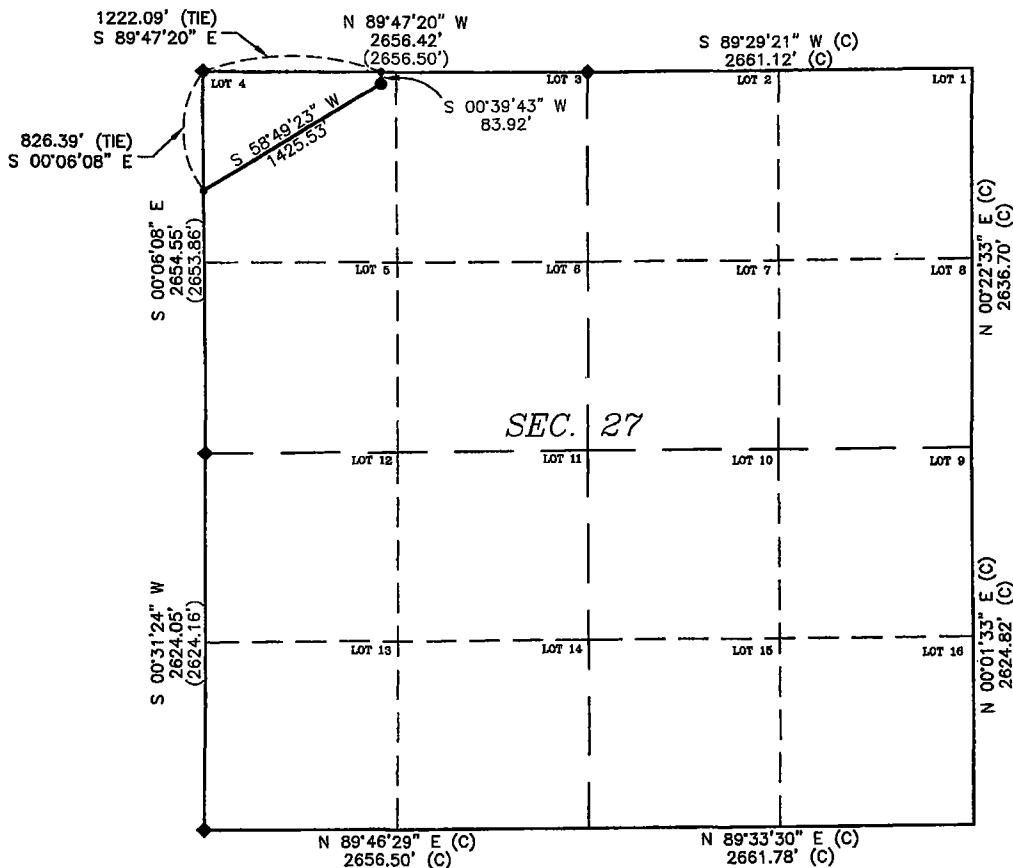

- LEGEND:**
- ◆ 1989 B.L.M. BRASS CAP
  - ( ) RECORDED DISTANCE
  - (C) CALCULATED FROM RECORD
  - CENTERLINE OF RIGHT OF WAY EASEMENT
  - BEGINNING AND END OF ALIGNMENT DESCRIPTION
  - POWER LINE PI LOCATION

**BASIS OF BEARING:**  
NAD 83 WYOMING STATE PLANE,  
EAST ZONE-GRID

**LEGAL DESCRIPTION:**

The following is a legal description for a 125 foot wide easement located in a portion of Lot 4 (NW 1/4 NW 1/4) of Section 27, Township 38 North, Range 74 West of the 6th P.M., Converse County, Wyoming. Said easement being 62.5 feet on each side of the following described centerline:

Commencing at the Northwest corner of said Section 27, said corner being monumented with a 1989 B.L.M. Brass cap, thence S 89°47'20" E, a distance of 1222.09 feet to the True Point of Beginning of said easement centerline;

Thence along said centerline S 00°39'43" W, a distance of 83.92 feet to a point;  
Thence along said centerline S 58°49'23" W, a distance of 1425.53 feet to a point on the West line of said Section 27, said point being S 00°06'08" E, a distance of 826.39 feet from the Northwest corner of said Section 27, being a 1989 B.L.M. Brass cap.

Said easement centerline being 1509.45 feet in length, more or less with side lines shortened or extended to the recorded boundary.



**CERTIFICATE OF SURVEYOR:**  
I, THEODORE L. MCMAHON, BEING A PROFESSIONAL LAND SURVEYOR, REGISTERED UNDER THE LAWS OF THE STATE OF WYOMING, DO HEREBY CERTIFY THAT THE MAP HEREON REPRESENTS AN ACTUAL SURVEY MADE BY MYSELF AND OR BY PERSONNEL OF KNIGHT TECHNOLOGIES INCORPORATED UNDER MY DIRECT SUPERVISION AND THAT SAID PLAT AND LEGAL DESCRIPTION SHOWN ARE ACCURATELY REPRESENTED.

PREPARED FOR: BLACK HILLS POWER, INC. 825 9th STREET P.O. BOX 1400 RAPID CITY, SD 57709		
<b>RIGHT OF WAY EASEMENT</b> JOE PATTERSON RANCH CORPORATION		
SEC. 27, T. 38 N., R. 74 W. CONVERSE COUNTY, WYOMING		
DATE: 05-26-09	DESIGNED BY: KTI	
SCALE: 1" = 1000'	DRAWN BY: KTI/PK	
CNTR INTVL: N/A	APPROVED BY: KTI/TLM	
REVISION:	DATE: / /	



**NOTE:**  
ALL CENTERLINE BEARINGS AND DISTANCES HEREIN ARE CONSIDERED TO BE MORE OR LESS. THE CENTERLINE OF THE POWERLINE AS CONSTRUCTED IS THE CENTER LINE OF THE 125' WIDE EASEMENT BEING 62.5' ON EACH SIDE

PREPARED BY:  
KNIGHT TECHNOLOGIES, INC.  
201 W. Lakeway Rd.  
Suite 200  
Gillette, WY 82718  
Office: (307) 682-8547



**RIGHT OF WAY EASEMENT  
BLACK HILLS POWER, INC.  
SECTION 28, T. 38 N., R. 74 W., 6TH P.M.  
CONVERSE COUNTY, WYOMING**

RECORD OWNER	FOOTAGE	RODS
JOE PATTERSON RANCH CORPORATION	3199.3'	193.90

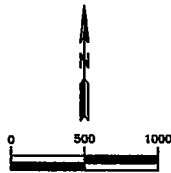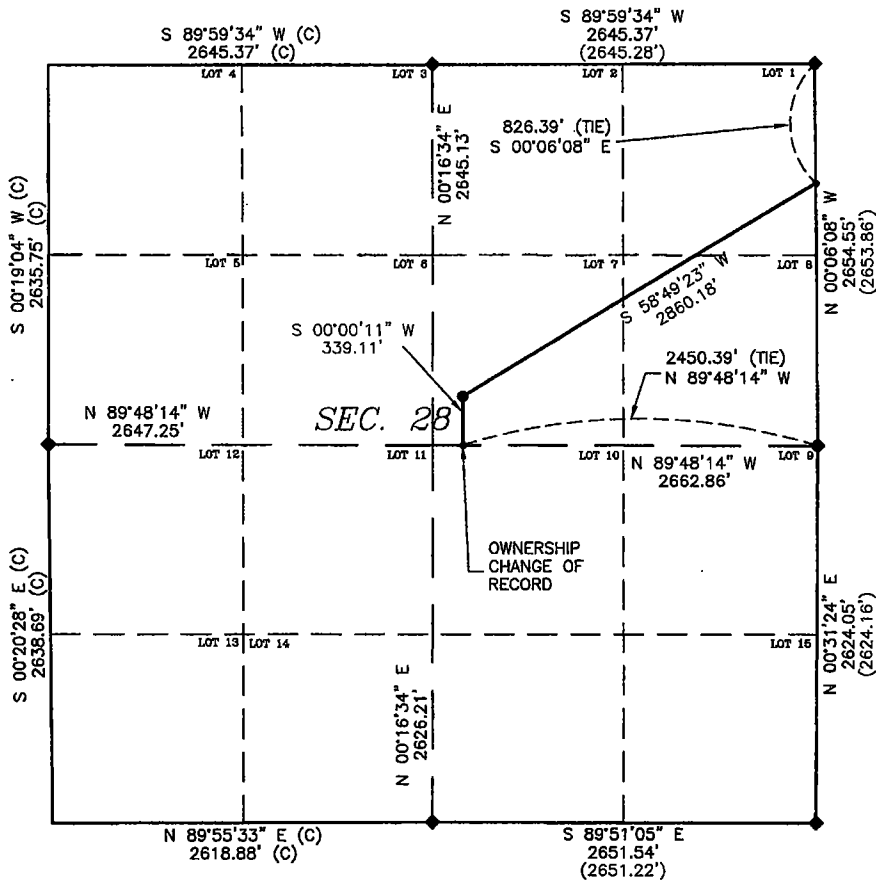

- LEGEND:**
- ◆ 1989 B.L.M. BRASS CAP
  - ( ) RECORDED DISTANCE
  - (C) CALCULATED FROM RECORD
  - CENTERLINE OF RIGHT OF WAY EASEMENT
  - BEGINNING AND END OF ALIGNMENT DESCRIPTION
  - POWER LINE PI LOCATION

**BASIS OF BEARING:**  
NAD 83 WYOMING STATE PLANE,  
EAST ZONE—GRID


**LEGAL DESCRIPTION:**

The following is a legal description for a 125 foot wide easement located in portions of Lot 1 (NE 1/4 NE 1/4), Lot 7 (SW 1/4 NE 1/4) and Lot 8 (SE 1/4 NE 1/4) of Section 28, Township 38 North, Range 74 West of the 6th P.M., Converse County, Wyoming. Said easement being 62.5 feet on each side of the following described centerline:

Commencing at the Northeast corner of said Section 28, said corner being monumented with a 1989 B.L.M. Brass cap, thence S 00°06'08" E, a distance of 826.39 feet to the True Point of Beginning of said easement centerline;

Thence along said centerline S 58°49'23" W, a distance of 2860.18 feet to a point; Thence along said centerline S 00°00'11" W, a distance of 339.11 feet to a point on the South line of Lot 7 (SW 1/4 NE 1/4) of said Section 28, said point being N 89°48'14" W, a distance of 2450.39 feet from the East 1/4 corner of said Section 28, being a 1989 B.L.M. Brass cap.

Said easement centerline being 3199.29 feet in length, more or less with side lines shortened or extended to the recorded boundary.

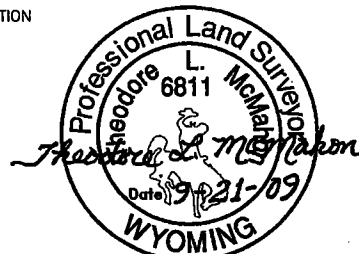

**CERTIFICATE OF SURVEYOR:**  
I, THEODORE L. MCMAHON, BEING A PROFESSIONAL LAND SURVEYOR, REGISTERED UNDER THE LAWS OF THE STATE OF WYOMING, DO HEREBY CERTIFY THAT THE MAP HEREON REPRESENTS AN ACTUAL SURVEY MADE BY MYSELF AND OR BY PERSONNEL OF KNIGHT TECHNOLOGIES INCORPORATED UNDER MY DIRECT SUPERVISION AND THAT SAID PLAT AND LEGAL DESCRIPTION SHOWN ARE ACCURATELY REPRESENTED.

PREPARED FOR:  
BLACK HILLS POWER, INC.  
825 9th STREET  
P.O. BOX 1400  
RAPID CITY, SD 57709



**RIGHT OF WAY EASEMENT**  
JOE PATTERSON RANCH CORPORATION

SEC. 28, T. 38 N., R. 74 W.  
CONVERSE COUNTY, WYOMING

**NOTE:**  
ALL CENTERLINE BEARINGS AND DISTANCES HEREIN ARE CONSIDERED TO BE MORE OR LESS. THE CENTERLINE OF THE POWERLINE AS CONSTRUCTED IS THE CENTER LINE OF THE 125' WIDE EASEMENT BEING 62.5' ON EACH SIDE

PREPARED BY:  
KNIGHT TECHNOLOGIES, INC.  
201 W. Lakeway Rd.  
Suite 200  
Gillette, WY 82718  
Office: (307) 682-8547





DATE: 09-21-09	DESIGNED BY: KTI
SCALE: 1" = 1000'	DRAWN BY: KTI/JMB
CNTR INTRVL: N/A	APPROVED BY: KTI/TLM
REVISION:	DATE: / /



**RIGHT OF WAY EASEMENT  
BLACK HILLS POWER, INC.**

SECTION 28, T. 38 N., R. 74 W., 6TH P.M.  
CONVERSE COUNTY, WYOMING

RECORD OWNER	FOOTAGE	RODS
MANNING FAMILY BYPASS TRUST	2626.0'	159.15
MAE ANN MANNING REVOCABLE TRUST		

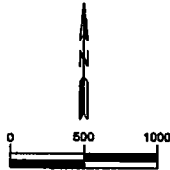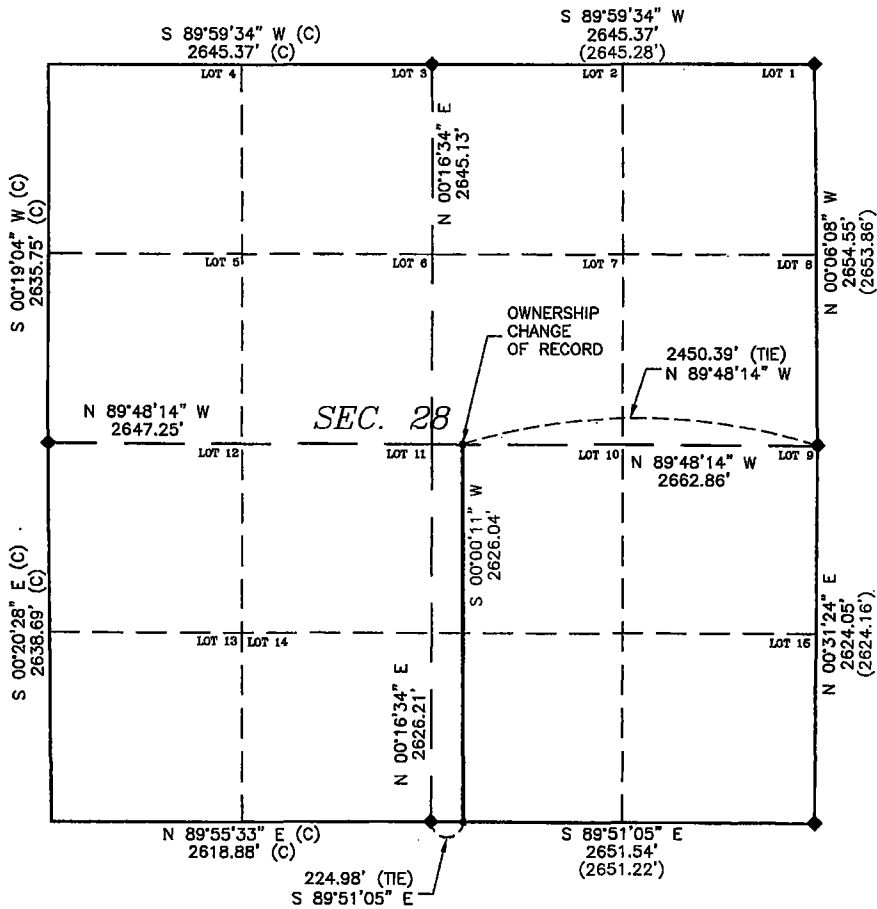

- LEGEND:**
- ◆ 1989 B.L.M. BRASS CAP
  - ( ) RECORDED DISTANCE
  - (C) CALCULATED FROM RECORD
  - CENTERLINE OF RIGHT OF WAY EASEMENT
  - BEGINNING AND END OF ALIGNMENT DESCRIPTION

**BASIS OF BEARING:**  
NAD 83 WYOMING STATE PLANE,  
EAST ZONE--GRID


**LEGAL DESCRIPTION:**

The following is a legal description for a 125 foot wide easement located in portions of Lot 10. (NW 1/4 SE 1/4) and SW 1/4 SE 1/4 of Section 28, Township 38 North, Range 74 West of the 6th P.M., Converse County, Wyoming. Said easement being 62.5 feet on each side of the following described centerline:

Commencing at the East 1/4 corner of said Section 28, said corner being monumented with a 1989 B.L.M. Brass cap, thence N 89°48'14" W, a distance of 2450.39 feet to the True Point of Beginning of said easement centerline;

Thence along said centerline S 00°00'11" W, a distance of 2626.04 to a point on the South line of said Section 28, said point being S 89°51'05" E, a distance of 224.98 feet from the South 1/4 corner of said Section 28, being a 1989 B.L.M. Brass cap.

Said easement centerline being 2626.04 feet in length, more or less with side lines shortened or extended to the recorded boundary.

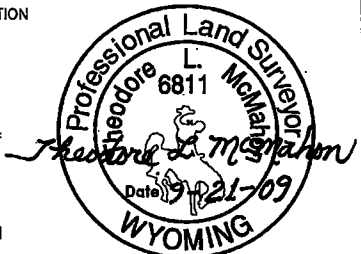

**CERTIFICATE OF SURVEYOR:**  
I, THEODORE L. MCMAHON, BEING A PROFESSIONAL LAND SURVEYOR, REGISTERED UNDER THE LAWS OF THE STATE OF WYOMING, DO HEREBY CERTIFY THAT THE MAP HEREON REPRESENTS AN ACTUAL SURVEY MADE BY MYSELF AND OR BY PERSONNEL OF KNIGHT TECHNOLOGIES INCORPORATED UNDER MY DIRECT SUPERVISION AND THAT SAID PLAT AND LEGAL DESCRIPTION SHOWN ARE ACCURATELY REPRESENTED.

PREPARED FOR:  
BLACK HILLS POWER, INC.  
828 8th STREET  
P.O. BOX 1400  
RAPID CITY, SD 57709



**RIGHT OF WAY EASEMENT  
MANNING FAMILY BYPASS TRUST  
MAE ANN MANNING REVOCABLE TRUST  
SEC. 28, T. 38 N., R. 74 W.  
CONVERSE COUNTY, WYOMING**

**NOTE:**  
ALL CENTERLINE BEARINGS AND DISTANCES HEREIN ARE CONSIDERED TO BE MORE OR LESS. THE CENTERLINE OF THE POWERLINE AS CONSTRUCTED IS THE CENTER LINE OF THE 125' WIDE EASEMENT BEING 62.5' ON EACH SIDE



PREPARED BY:  
KNIGHT TECHNOLOGIES, INC.  
201 W. Lakeway Rd.  
Suite 200  
Gillette, WY 82718  
Office: (307) 682-8547



DATE: 09-21-09	DESIGNED BY: KTI
SCALE: 1" = 1000'	DRAWN BY: KTI/PK
CNTR INTRVL: N/A	APPROVED BY: KTI/TLM
REVISION:	DATE: / /

**RIGHT OF WAY EASEMENT  
BLACK HILLS POWER, INC.  
SECTION 33, T. 38 N., R. 74 W., 6TH P.M.  
CONVERSE COUNTY, WYOMING**

<b>RECORD OWNER</b>	<b>FOOTAGE</b>	<b>RODS</b>
MANNING FAMILY BYPASS TRUST MAE ANN MANNING REVOCABLE TRUST	5272.6'	319.55

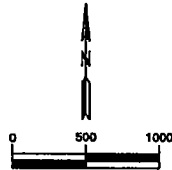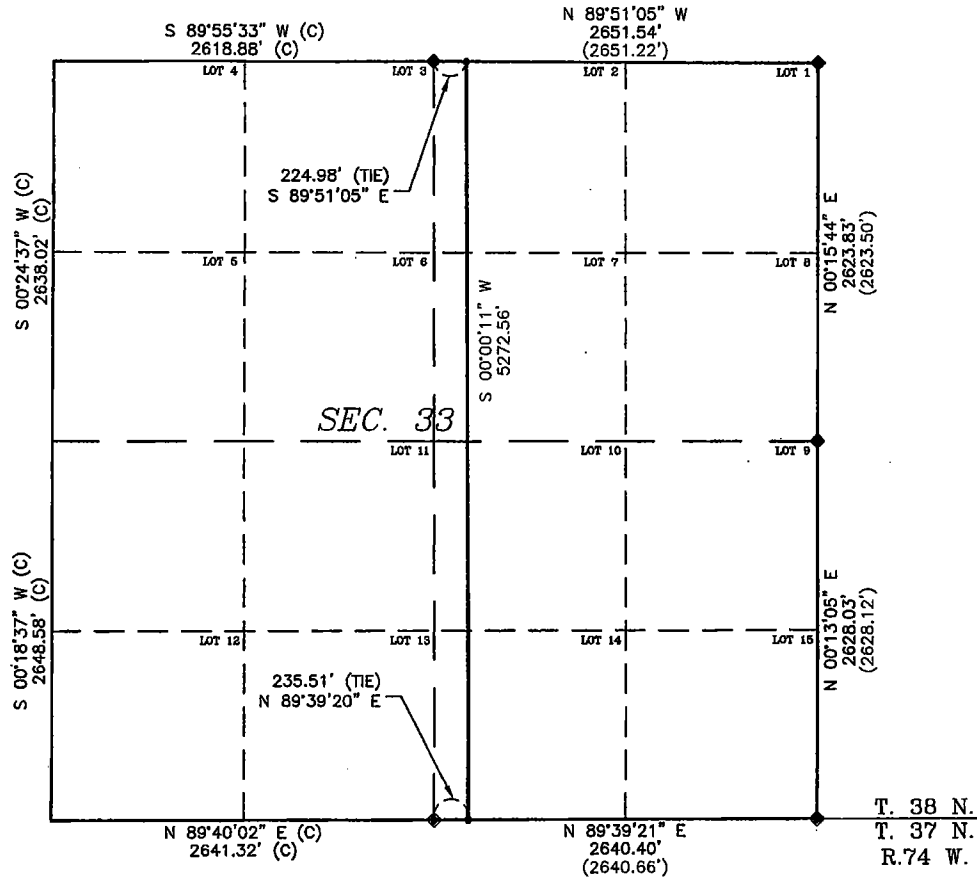

- LEGEND:**
- ◆ 1987 B.L.M. BRASS CAP
  - ◆ 1989 B.L.M. BRASS CAP
  - ( ) RECORDED DISTANCE
  - (C) CALCULATED FROM RECORD
  - CENTERLINE OF RIGHT OF WAY EASEMENT
  - BEGINNING AND END OF ALIGNMENT DESCRIPTION

**BASIS OF BEARING:**  
NAD 83 WYOMING STATE PLANE,  
EAST ZONE-GRID


**LEGAL DESCRIPTION:**

The following is a legal description for a 125 foot wide easement located in portions of Lot 2 (NW 1/4 NE 1/4), Lot 7 (SW 1/4 NE 1/4), Lot 10 (NW 1/4 SE 1/4) and Lot 14 (SW 1/4 SE 1/4) of Section 33, Township 38 North, Range 74 West of the 6th P.M., Converse County, Wyoming. Said easement being 62.5 feet on each side of the following described centerline:

Commencing at the North 1/4 corner of said Section 33, said corner being monumented with a 1989 B.L.M. Brass cap, thence S 89°51'05" E, a distance of 224.98 feet to the True Point of Beginning of said easement centerline;

Thence along said centerline S 00°00'11" W, a distance of 5272.56 to a point on the South line of said Section 33, said point being N 89°39'20" E, a distance of 235.51 feet from the South 1/4 corner of said Section 33, being a 1987 B.L.M. Brass cap.

Said easement centerline being 5272.56 feet in length, more or less with side lines shortened or extended to the recorded boundary.

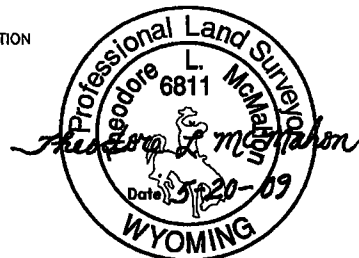

**CERTIFICATE OF SURVEYOR:**  
I, THEODORE L. MCMAHON, BEING A PROFESSIONAL LAND SURVEYOR, REGISTERED UNDER THE LAWS OF THE STATE OF WYOMING, DO HEREBY CERTIFY THAT THE MAP HEREON REPRESENTS AN ACTUAL SURVEY MADE BY MYSELF AND OR BY PERSONNEL OF KNIGHT TECHNOLOGIES INCORPORATED UNDER MY DIRECT SUPERVISION AND THAT SAID PLAT AND LEGAL DESCRIPTION SHOWN ARE ACCURATELY REPRESENTED.

**PREPARED FOR:**  
BLACK HILLS POWER, INC.  
625 8th STREET  
P.O. BOX 1400  
RAPID CITY, SD 57709



**RIGHT OF WAY EASEMENT  
MANNING FAMILY BYPASS TRUST  
MAE ANN MANNING REVOCABLE TRUST  
SEC. 33, T. 38 N., R. 74 W.  
CONVERSE COUNTY, WYOMING**

DATE: 06-14-09	DESIGNED BY: KTI
SCALE: 1" = 1000'	DRAWN BY: KTI/PK
CNTR INTRVL: N/A	APPROVED BY: KTI/TLM
REVISION:	DATE: / /



**NOTE:**  
ALL CENTERLINE BEARINGS AND DISTANCES HEREIN ARE CONSIDERED TO BE MORE OR LESS. THE CENTERLINE OF THE POWERLINE AS CONSTRUCTED IS THE CENTER LINE OF THE 125' WIDE EASEMENT BEING 62.5' ON EACH SIDE

**PREPARED BY:**  
KNIGHT TECHNOLOGIES, INC.  
201 W. Lakeway Rd.  
Suite 200  
Gillette, WY 82718  
Office: (307) 682-8547



**RIGHT OF WAY EASEMENT  
BLACK HILLS POWER, INC.  
SECTION 4, T. 37 N., R. 74 W., 6TH P.M.  
CONVERSE COUNTY, WYOMING**

RECORD OWNER MANNING FAMILY BYPASS TRUST MAE ANN MANNING REVOCABLE TRUST	FOOTAGE 2679.0'	RODS 162.36'
--	--------------------	-----------------

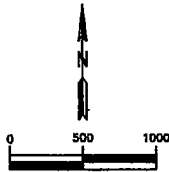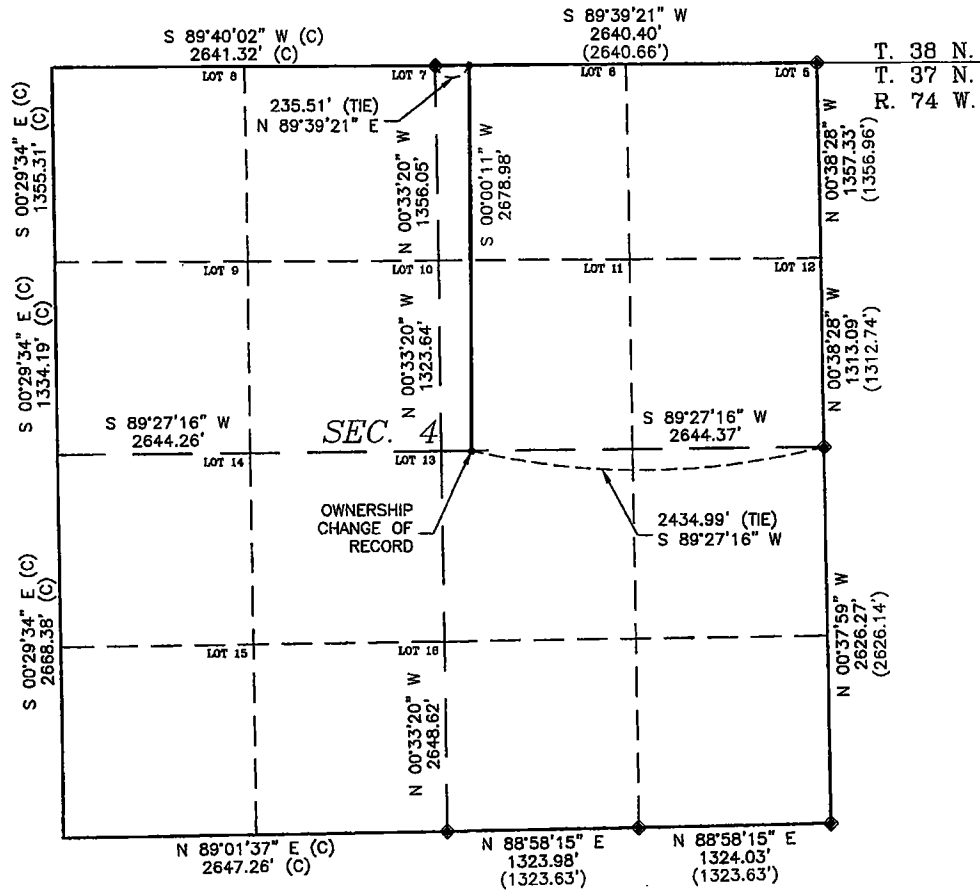

- LEGEND:**
- ◆ 1987 B.L.M. BRASS CAP
  - ( ) RECORDED DISTANCE
  - (C) CALCULATED FROM RECORD
  - CENTERLINE OF RIGHT OF WAY EASEMENT
  - BEGINNING AND END OF ALIGNMENT DESCRIPTION

**BASIS OF BEARING:**  
NAD 83 WYOMING STATE PLANE,  
EAST ZONE-GRID


**LEGAL DESCRIPTION:**

The following is a legal description for a 125 foot wide easement located in portions of Lot 6 (NW 1/4 NE 1/4) and Lot 11 (SW 1/4 NE 1/4) of Section 4, Township 37 North, Range 74 West of the 6th P.M., Converse County, Wyoming. Said easement being 62.5 feet on each side of the following described centerline:

Commencing at the North 1/4 corner of said Section 4, said corner being monumented with a 1987 B.L.M. Brass cap, thence N 89°39'21" E, a distance of 235.51 feet to the True Point of Beginning of said easement centerline;

Thence along said centerline S 00°00'11" W, a distance of 2678.98 feet to a point on the South line of said Lot 11 (SW 1/4 NE 1/4), said point being S 89°27'16" W, a distance of 2434.99 feet from the East 1/4 corner of said Section 4, being a 1987 B.L.M. Brass cap.

Said easement centerline being 2678.98 feet in length, more or less with side lines shortened or extended to the recorded boundary.

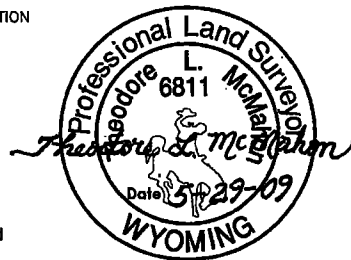

**CERTIFICATE OF SURVEYOR:**  
I, THEODORE L. MCMAHON, BEING A PROFESSIONAL LAND SURVEYOR, REGISTERED UNDER THE LAWS OF THE STATE OF WYOMING, DO HEREBY CERTIFY THAT THE MAP HEREON REPRESENTS AN ACTUAL SURVEY MADE BY MYSELF AND OR BY PERSONNEL OF KNIGHT TECHNOLOGIES INCORPORATED UNDER MY DIRECT SUPERVISION AND THAT SAID PLAN AND LEGAL DESCRIPTION SHOWN ARE ACCURATELY REPRESENTED.

PREPARED FOR:  
BLACK HILLS POWER, INC.  
625 6th STREET  
P.O. BOX 1400  
RAPID CITY, SD 57709



**RIGHT OF WAY EASEMENT  
MANNING FAMILY BYPASS TRUST  
MAE ANN MANNING REVOCABLE TRUST  
SEC. 4, T. 37 N., R. 74 W.  
CONVERSE COUNTY, WYOMING**

PREPARED BY:  
KNIGHT TECHNOLOGIES, INC.  
201 W. Lakeway Rd.  
Suite 200  
Gillette, WY 82718  
Office: (307) 682-8547





DATE: 05-28-09	DESIGNED BY: KTI
SCALE: 1" = 1000'	DRAWN BY: KTI/JMB
CNTR INTRVL: N/A	APPROVED BY: KTI/TLM
REVISION:	DATE: / /

**NOTE:**  
ALL CENTERLINE BEARINGS AND DISTANCES HEREIN ARE CONSIDERED TO BE MORE OR LESS. THE CENTERLINE OF THE POWERLINE AS CONSTRUCTED IS THE CENTER LINE OF THE 125' WIDE EASEMENT BEING 62.5' ON EACH SIDE

**RIGHT OF WAY EASEMENT  
BLACK HILLS POWER, INC.  
SECTION 4, T. 37 N., R. 74 W., 6TH P.M.  
CONVERSE COUNTY, WYOMING**

RECORD OWNER	FOOTAGE	RODS
HENRY LAND COMPANY	2647.2'	160.44

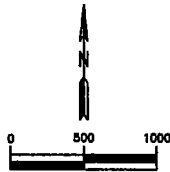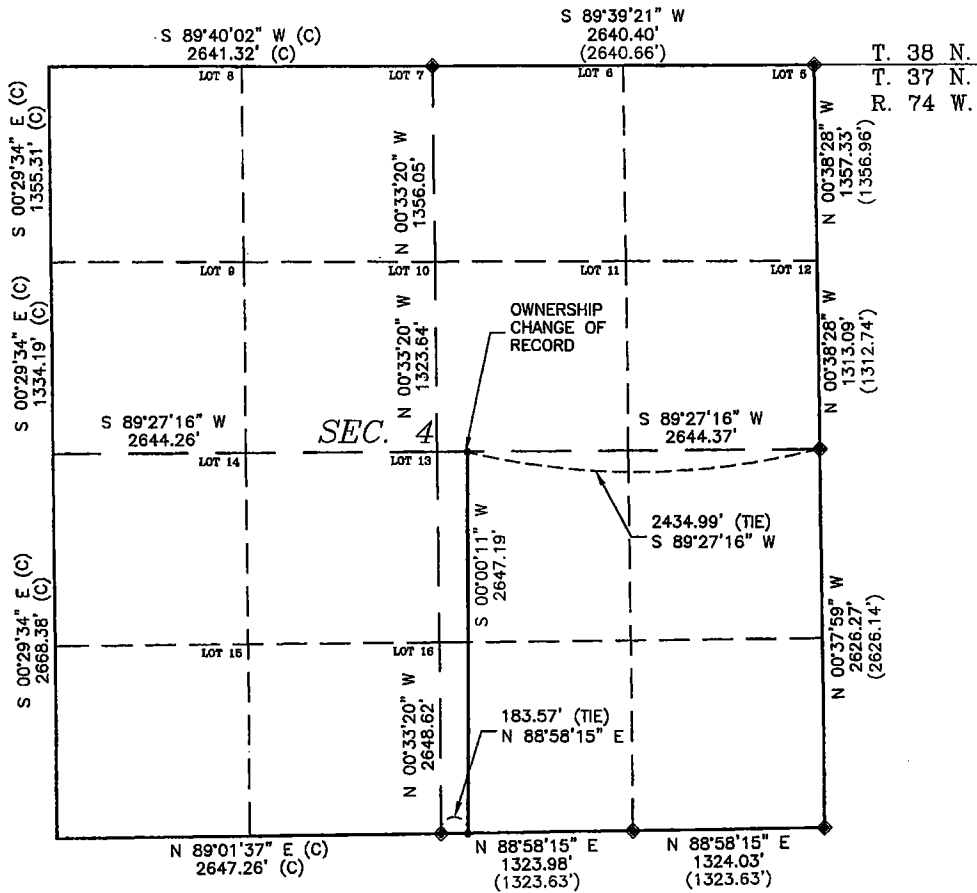

- LEGEND:**
- ◆ 1987 B.L.M. BRASS CAP
  - ( ) RECORDED DISTANCE
  - (C) CALCULATED FROM RECORD
  - CENTERLINE OF RIGHT OF WAY EASEMENT
  - BEGINNING AND END OF ALIGNMENT DESCRIPTION

**BASIS OF BEARING:**  
NAD 83 WYOMING STATE PLANE,  
EAST ZONE-GRID


**LEGAL DESCRIPTION:**

The following is a legal description for a 125 foot wide easement located in portions of NW 1/4 SE 1/4 and SW 1/4 SE 1/4 of Section 4, Township 37 North, Range 74 West of the 6th P.M., Converse County, Wyoming. Said easement being 62.5 feet on each side of the following described centerline:

Commencing at the East 1/4 corner of said Section 4, said corner being monumented with a 1987 B.L.M. Brass cap, thence S 89°27'16" W, a distance of 2434.99 feet to the True Point of Beginning of said easement centerline;

Thence along said centerline S 00°00'11" W, a distance of 2647.19 feet to a point on the South line of said Section 4, said point being N 88°58'15" E, a distance of 183.57 feet from the South 1/4 corner of said Section 4, being a 1987 B.L.M. Brass cap.

Said easement centerline being 2647.19 feet in length, more or less with side lines shortened or extended to the recorded boundary.

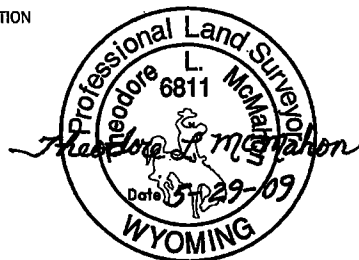

**CERTIFICATE OF SURVEYOR:**  
I, THEODORE L. MCMAHON, BEING A PROFESSIONAL LAND SURVEYOR, REGISTERED UNDER THE LAWS OF THE STATE OF WYOMING, DO HEREBY CERTIFY THAT THE MAP HEREON REPRESENTS AN ACTUAL SURVEY MADE BY MYSELF AND OR BY PERSONNEL OF KNIGHT TECHNOLOGIES INCORPORATED UNDER MY DIRECT SUPERVISION AND THAT SAID PLAT AND LEGAL DESCRIPTION SHOWN ARE ACCURATELY REPRESENTED.

PREPARED FOR:  
BLACK HILLS POWER, INC.  
626 9th STREET  
P.O. BOX 1400  
RAPID CITY, SD 57709



**RIGHT OF WAY EASEMENT  
HENRY LAND COMPANY**

SEC. 4, T. 37 N., R. 74 W.  
CONVERSE COUNTY, WYOMING

**NOTE:**  
ALL CENTERLINE BEARINGS AND DISTANCES HEREIN ARE CONSIDERED TO BE MORE OR LESS. THE CENTERLINE OF THE POWERLINE AS CONSTRUCTED IS THE CENTER LINE OF THE 125' WIDE EASEMENT BEING 62.5' ON EACH SIDE



PREPARED BY:  
KNIGHT TECHNOLOGIES, INC.  
201 W. Lakeway Rd.  
Suite 200  
Gillette, WY 82718  
Office: (307) 682-8547



DATE: 06-26-09	DESIGNED BY: KTI
SCALE: 1" = 1000'	DRAWN BY: KTI/PK
CNTR INTRVL: N/A	APPROVED BY: KTI/TLM
REVISION:	DATE: / /

**RIGHT OF WAY EASEMENT  
BLACK HILLS POWER, INC.  
SECTION 9, T. 37 N., R. 74 W., 6TH P.M.  
CONVERSE COUNTY, WYOMING**

RECORD OWNER	FOOTAGE	RODS
WILLIAM M HENRY, III REVOCABLE TRUST	5262.1'	318.92
SUSAN KAY HENRY REVOCABLE TRUST		

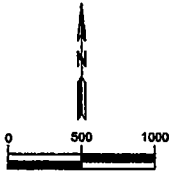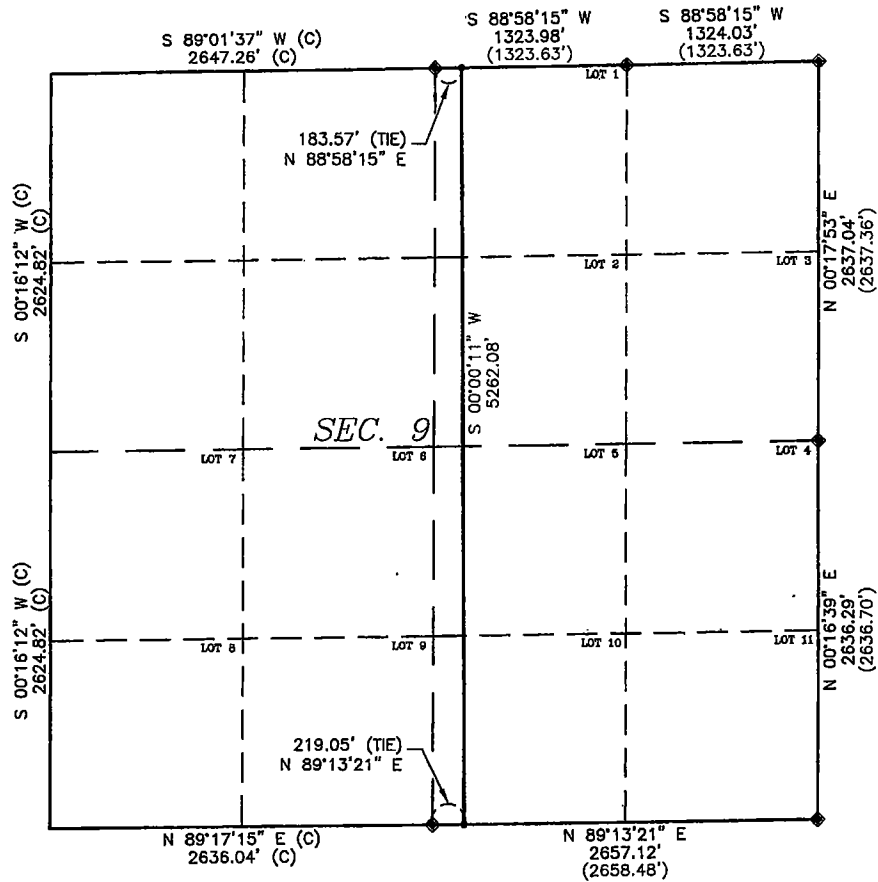

- LEGEND:**
- ◆ 1987 B.L.M. BRASS CAP
  - ( ) RECORDED DISTANCE
  - (C) CALCULATED FROM RECORD
  - CENTERLINE OF RIGHT OF WAY EASEMENT
  - BEGINNING AND END OF ALIGNMENT DESCRIPTION

**BASIS OF BEARING:**  
NAD 83 WYOMING STATE PLANE,  
EAST ZONE--GRID


**LEGAL DESCRIPTION:**

The following is a legal description for a 125 foot wide easement located in portions of Lot 1 (NW 1/4 NE 1/4), Lot 2 (SW 1/4 NE 1/4), Lot 5 (NW 1/4 SE 1/4) and Lot 10 (SW 1/4 SE 1/4) of Section 9, Township 37 North, Range 74 West of the 6th P.M., Converse County, Wyoming. Said easement being 62.5 feet on each side of the following described centerline:

Commencing at the North 1/4 corner of said Section 9, said corner being monumented with a 1987 B.L.M. Brass cap, thence N 88°58'15" E, a distance of 183.57 feet to the True Point of Beginning of said easement centerline;

Thence along said centerline S 00°00'11" W, a distance of 5262.08 feet to a point on the South line of said Section 9, said point being N 89°13'21" E, a distance of 219.05 feet from the South 1/4 corner of said Section 9, being a 1987 B.L.M. Brass cap.

Said easement centerline being 5262.08 feet in length, more or less with side lines shortened or extended to the recorded boundary.

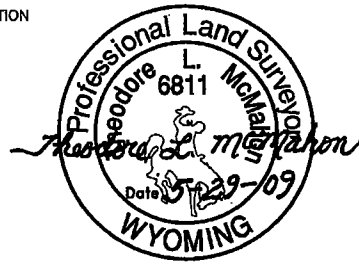

**CERTIFICATE OF SURVEYOR:**  
I, THEODORE L. MCMAHON, BEING A PROFESSIONAL LAND SURVEYOR, REGISTERED UNDER THE LAWS OF THE STATE OF WYOMING, DO HEREBY CERTIFY THAT THE MAP HEREON REPRESENTS AN ACTUAL SURVEY MADE BY MYSELF AND OR BY PERSONNEL OF KNIGHT TECHNOLOGIES INCORPORATED UNDER MY DIRECT SUPERVISION AND THAT SAID PLAT AND LEGAL DESCRIPTION SHOWN ARE ACCURATELY REPRESENTED.

PREPARED FOR:  
BLACK HILLS POWER, INC.  
625 9th STREET  
P.O. BOX 1400  
RAPID CITY, SD 57709

**RIGHT OF WAY EASEMENT  
WILLIAM M HENRY, III REVOCABLE TRUST  
SUSAN KAY HENRY REVOCABLE TRUST  
SEC. 9, T. 37 N., R. 74 W.  
CONVERSE COUNTY, WYOMING**

DATE: 05-28-09	DESIGNED BY: KTI
SCALE: 1" = 1000'	DRAWN BY: KTI/PK
CNTR INTRVL: N/A	APPROVED BY: KTI/TLM
REVISION:	DATE: / /



**NOTE:**  
ALL CENTERLINE BEARINGS AND DISTANCES HEREIN ARE CONSIDERED TO BE MORE OR LESS. THE CENTERLINE OF THE POWERLINE AS CONSTRUCTED IS THE CENTER LINE OF THE 125' WIDE EASEMENT BEING 62.5' ON EACH SIDE

PREPARED BY:  
KNIGHT TECHNOLOGIES, INC.  
201 W. Lakeway Rd.  
Suite 200  
Gillette, WY 82718  
Office: (307) 682-8547



**RIGHT OF WAY EASEMENT  
BLACK HILLS POWER, INC.  
SECTION 21, T. 37 N., R. 74 W., 6TH P.M.  
CONVERSE COUNTY, WYOMING**

RECORD OWNER	FOOTAGE	RODS
WILLIAM M HENRY, III REVOCABLE TRUST SUSAN KAY HENRY REVOCABLE TRUST	2656.6'	161.01

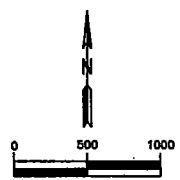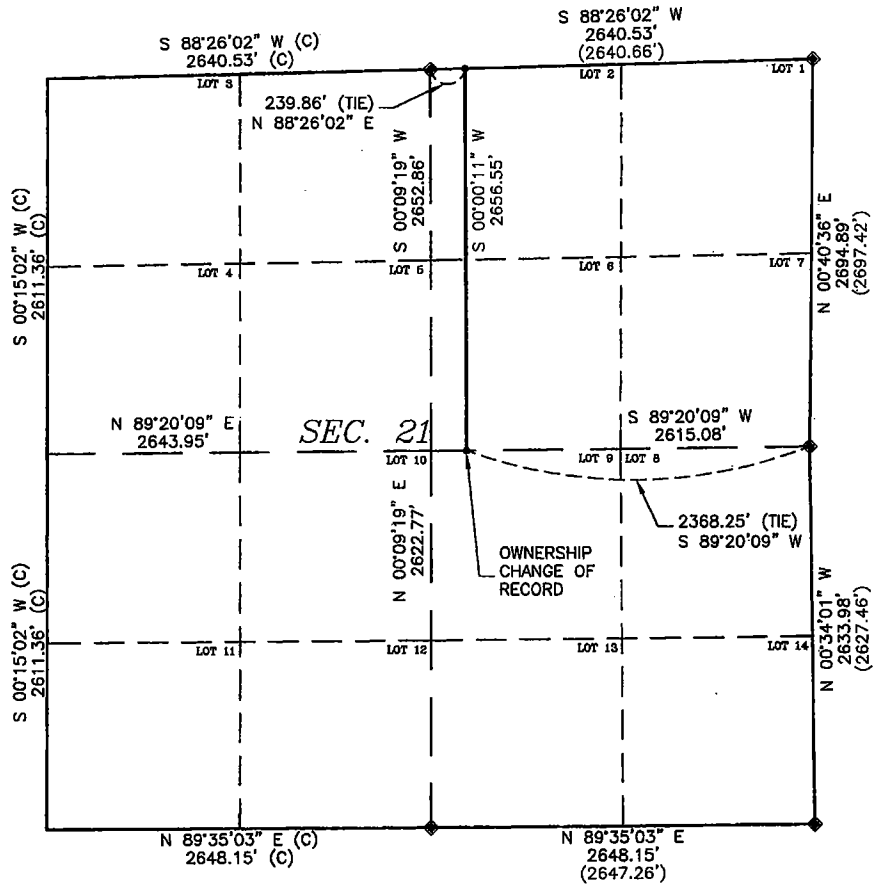

- LEGEND:**
- ◆ 1987 B.L.M. BRASS CAP
  - ( ) RECORDED DISTANCE
  - (C) CALCULATED FROM RECORD
  - CENTERLINE OF RIGHT OF WAY EASEMENT
  - BEGINNING AND END OF ALIGNMENT DESCRIPTION

**BASIS OF BEARING:**  
NAD 83 WYOMING STATE PLANE,  
EAST ZONE--GRID

**LEGAL DESCRIPTION:**

The following is a legal description for a 125 foot wide easement located in portion of Lot 2 (NW 1/4 NE 1/4) and Lot 6 (SW 1/4 NE 1/4) of Section 21, Township 37 North, Range 74 West of the 6th P.M., Converse County, Wyoming. Said easement being 62.5 feet on each side of the following described centerline:

Commencing at the North 1/4 corner of said Section 21, said corner being monumented with a 1987 B.L.M. Brass cap, thence N 88°26'02" E, a distance of 239.86 feet to the True Point of Beginning of said easement centerline;

Thence along said centerline S 00°00'11" W, a distance of 2656.55 feet to a point on the South line of Lot 6 (SW 1/4 NE 1/4) of said Section 21, said point being S 89°20'09" W, a distance of 2368.25 feet from the East 1/4 corner of said Section 21, being a 1987 B.L.M. Brass cap.

Said easement centerline being 2656.55 feet in length, more or less with side lines shortened or extended to the recorded boundary.



**CERTIFICATE OF SURVEYOR:**  
I, THEODORE L. MCMAHON, BEING A PROFESSIONAL LAND SURVEYOR, REGISTERED UNDER THE LAWS OF THE STATE OF WYOMING, DO HEREBY CERTIFY THAT THE MAP HEREON REPRESENTS AN ACTUAL SURVEY MADE BY MYSELF AND OR BY PERSONNEL OF KNIGHT TECHNOLOGIES INCORPORATED UNDER MY DIRECT SUPERVISION AND THAT SAID PLAT AND LEGAL DESCRIPTION SHOWN ARE ACCURATELY REPRESENTED.

PREPARED FOR:  
BLACK HILLS POWER, INC.  
625 9th STREET  
P.O. BOX 1400  
RAPID CITY, SD 57709

**RIGHT OF WAY EASEMENT**  
WILLIAM M HENRY, III REVOCABLE TRUST  
SUSAN KAY HENRY REVOCABLE TRUST  
SEC. 21, T. 37 N., R. 74 W.  
CONVERSE COUNTY, WYOMING

**NOTE:**  
ALL CENTERLINE BEARINGS AND DISTANCES HEREIN ARE CONSIDERED TO BE MORE OR LESS. THE CENTERLINE OF THE POWERLINE AS CONSTRUCTED IS THE CENTER LINE OF THE 125' WIDE EASEMENT BEING 62.5' ON EACH SIDE

PREPARED BY:  
KNIGHT TECHNOLOGIES, INC.  
201 W. Lakeway Rd.  
Suite 200  
Gillette, WY 82718  
Office: (307) 682-8547




DATE: 05-28-09	DESIGNED BY: KTI
SCALE: 1" = 100'	DRAWN BY: KTI/PK
CHTR INTRVL: N/A	APPROVED BY: KTI/TLM
REVISION:	DATE: / /

**RIGHT OF WAY EASEMENT  
BLACK HILLS POWER, INC.**

SECTION 21, T. 37 N., R. 74 W., 6TH P.M.  
CONVERSE COUNTY, WYOMING


RECORD OWNER	FOOTAGE	RODS
HENRY LAND COMPANY	2623.8'	159.02

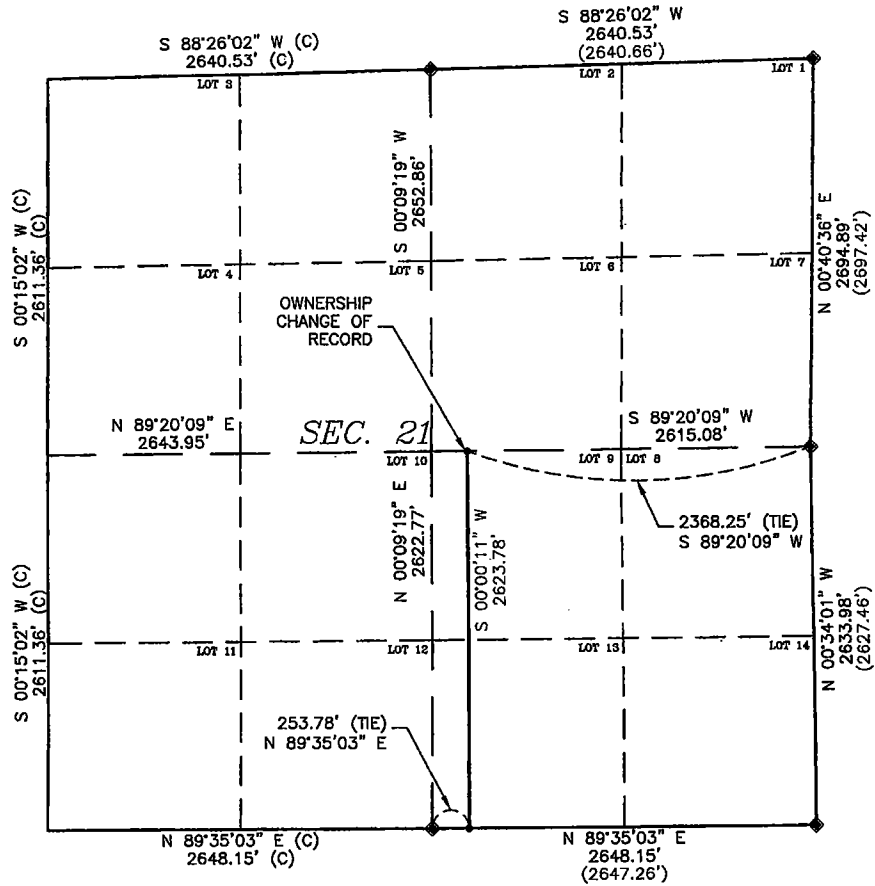

**LEGEND:**

- ◆ 1987 B.L.M. BRASS CAP
- ( ) RECORDED DISTANCE
- (C) CALCULATED FROM RECORD
- CENTERLINE OF RIGHT OF WAY EASEMENT
- BEGINNING AND END OF ALIGNMENT DESCRIPTION

**BASIS OF BEARING:**  
NAD 83 WYOMING STATE PLANE,  
EAST ZONE-GRID

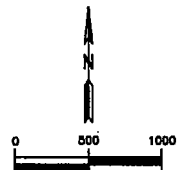

**LEGAL DESCRIPTION:**

The following is a legal description for a 125 foot wide easement located in portions of Lot 9 (NW 1/4 SE 1/4) and Lot 13 (SW 1/4 SE 1/4) of Section 21, Township 37 North, Range 74 West of the 6th P.M., Converse County, Wyoming. Said easement being 62.5 feet on each side of the following described centerline:

Commencing at the East 1/4 corner of said Section 21, said corner being monumented with a 1987 B.L.M. Brass cap, thence S 89°20'09" W, a distance of 2368.25 feet to the True Point of Beginning of said easement centerline;

Thence along said centerline S 00°00'11" W, a distance of 2623.78 feet to a point on the South line of said Section 21, said point being N 89°35'03" E, a distance of 253.78 feet from the South 1/4 corner of said Section 21, being a 1987 B.L.M. Brass cap.

Said easement centerline being 2623.78 feet in length, more or less with side lines shortened or extended to the recorded boundary.



**CERTIFICATE OF SURVEYOR:**  
I, THEODORE L. MCMAHON, BEING A PROFESSIONAL LAND SURVEYOR, REGISTERED UNDER THE LAWS OF THE STATE OF WYOMING, DO HEREBY CERTIFY THAT THE MAP HEREON REPRESENTS AN ACTUAL SURVEY MADE BY MYSELF AND OR BY PERSONNEL OF KNIGHT TECHNOLOGIES INCORPORATED UNDER MY DIRECT SUPERVISION AND THAT SAID PLAT AND LEGAL DESCRIPTION SHOWN ARE ACCURATELY REPRESENTED.

PREPARED FOR:  
BLACK HILLS POWER, INC.  
825 9th STREET  
P.O. BOX 1400  
RAPID CITY, SD 57709



**RIGHT OF WAY EASEMENT  
HENRY LAND COMPANY**

SEC. 21, T. 37 N., R. 74 W.  
CONVERSE COUNTY, WYOMING

**NOTE:**  
ALL CENTERLINE BEARINGS AND DISTANCES HEREIN ARE CONSIDERED TO BE MORE OR LESS. THE CENTERLINE OF THE POWERLINE AS CONSTRUCTED IS THE CENTER LINE OF THE 125' WIDE EASEMENT BEING 62.5' ON EACH SIDE



PREPARED BY:  
KNIGHT TECHNOLOGIES, INC.  
201 W. Lakeway Rd.  
Suite 200  
Gillette, WY 82718  
Office: (307) 682-8547



DATE: 05-28-09	DESIGNED BY: KTY
SCALE: 1" = 1000'	DRAWN BY: KTI/PK
CNTR INTRVL: N/A	APPROVED BY: KTI/TLM
REVISION:	DATE: / /

**RIGHT OF WAY EASEMENT  
BLACK HILLS POWER, INC.  
SECTION 28, T. 37 N., R. 74 W., 6TH P.M.  
CONVERSE COUNTY, WYOMING**

RECORD OWNER HENRY LAND COMPANY	FOOTAGE 5244.7'	RODS 317.86
------------------------------------	--------------------	----------------

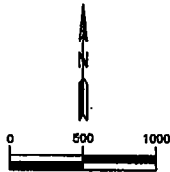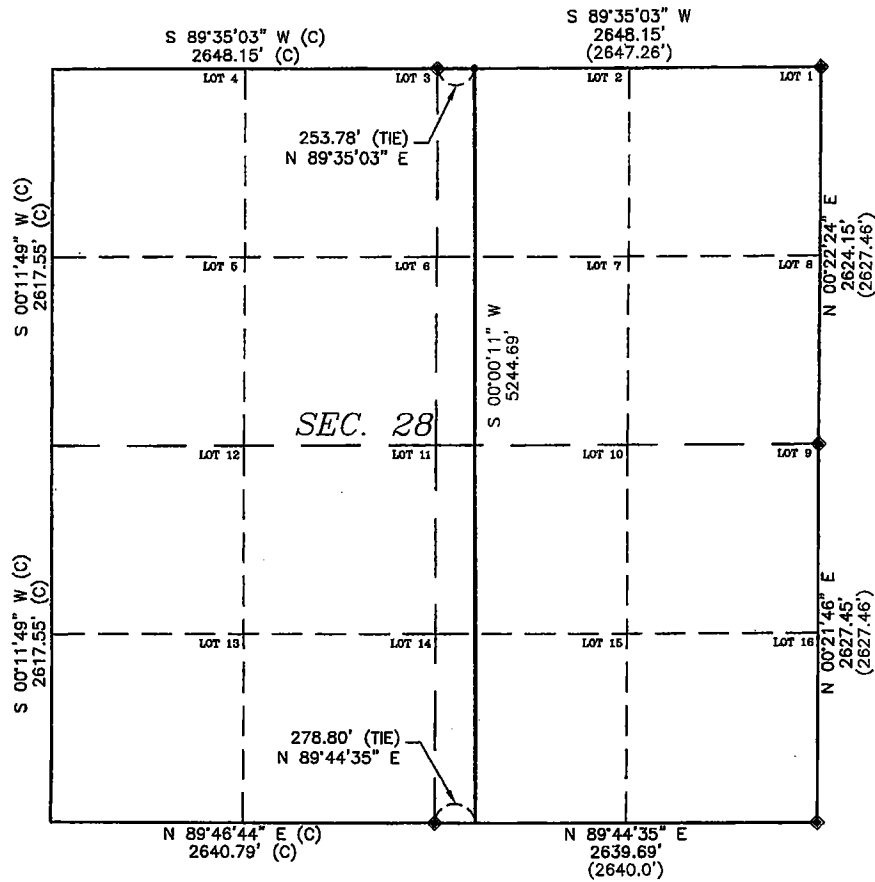

- LEGEND:**
- ◆ 1987 B.L.M. BRASS CAP
  - ( ) RECORDED DISTANCE
  - (C) CALCULATED FROM RECORD
  - CENTERLINE OF RIGHT OF WAY EASEMENT
  - BEGINNING AND END OF ALIGNMENT DESCRIPTION

**BASIS OF BEARING:**  
NAD 83 WYOMING STATE PLANE,  
EAST ZONE—GRID


**LEGAL DESCRIPTION:**

The following is a legal description for a 125 foot wide easement located in portions of Lot 2 (NW 1/4 NE 1/4), Lot 7 (SW 1/4 NE 1/4), Lot 10 (NW 1/4 SE 1/4) and Lot 15 (SW 1/4 SE 1/4) of Section 28, Township 37 North, Range 74 West of the 6th P.M., Converse County, Wyoming. Said easement being 62.5 feet on each side of the following described centerline:

Commencing at the North 1/4 corner of said Section 28, said corner being monumented with a 1987 B.L.M. Brass cap, thence N 89°35'03" E, a distance of 253.78 feet to the True Point of Beginning of said easement centerline;

Thence along said centerline S 00°00'11" W, a distance of 5244.69 feet to a point on the South line of said Section 28, said point being N 89°44'35" E, a distance of 278.80 feet from the South 1/4 corner of said Section 28, being a 1987 B.L.M. Brass cap.

Said easement centerline being 5244.69 feet in length, more or less with side lines shortened or extended to the recorded boundary.

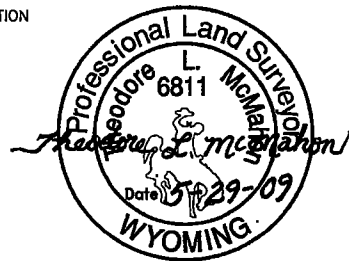

**CERTIFICATE OF SURVEYOR:**  
I, THEODORE L. MCMAHON, BEING A PROFESSIONAL LAND SURVEYOR, REGISTERED UNDER THE LAWS OF THE STATE OF WYOMING, DO HEREBY CERTIFY THAT THE MAP HEREON REPRESENTS AN ACTUAL SURVEY MADE BY MYSELF AND OR BY PERSONNEL OF KNIGHT TECHNOLOGIES INCORPORATED UNDER MY DIRECT SUPERVISION AND THAT SAID PLAT AND LEGAL DESCRIPTION SHOWN ARE ACCURATELY REPRESENTED.

PREPARED FOR:  
BLACK HILLS POWER, INC.  
825 8th STREET  
P.O. BOX 1400  
RAPID CITY, SD 57709

**RIGHT OF WAY EASEMENT  
HENRY LAND COMPANY**

SEC. 28, T. 37 N., R. 74 W.  
CONVERSE COUNTY, WYOMING

DATE: 05-28-09	DESIGNED BY: KTI
SCALE: 1" = 1000'	DRAWN BY: KTI/PK
CNTR INTRVL: N/A	APPROVED BY: KTI/PLM
REVISION:	DATE: / /

**NOTE:**  
ALL CENTERLINE BEARINGS AND DISTANCES HEREIN ARE CONSIDERED TO BE MORE OR LESS. THE CENTERLINE OF THE POWERLINE AS CONSTRUCTED IS THE CENTER LINE OF THE 125' WIDE EASEMENT BEING 62.5' ON EACH SIDE



PREPARED BY:  
KNIGHT TECHNOLOGIES, INC.  
201 W. Lakeway Rd.  
Suite 200  
Gillette, WY 82718  
Office: (307) 682-8547





**RIGHT OF WAY EASEMENT  
BLACK HILLS POWER, INC.  
SECTION 33, T. 37 N., R. 74 W., 6TH P.M.  
CONVERSE COUNTY, WYOMING**

RECORD OWNER HENRY LAND COMPANY	FOOTAGE 1310.9'	RODS 79.45
------------------------------------	--------------------	---------------

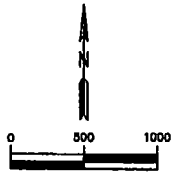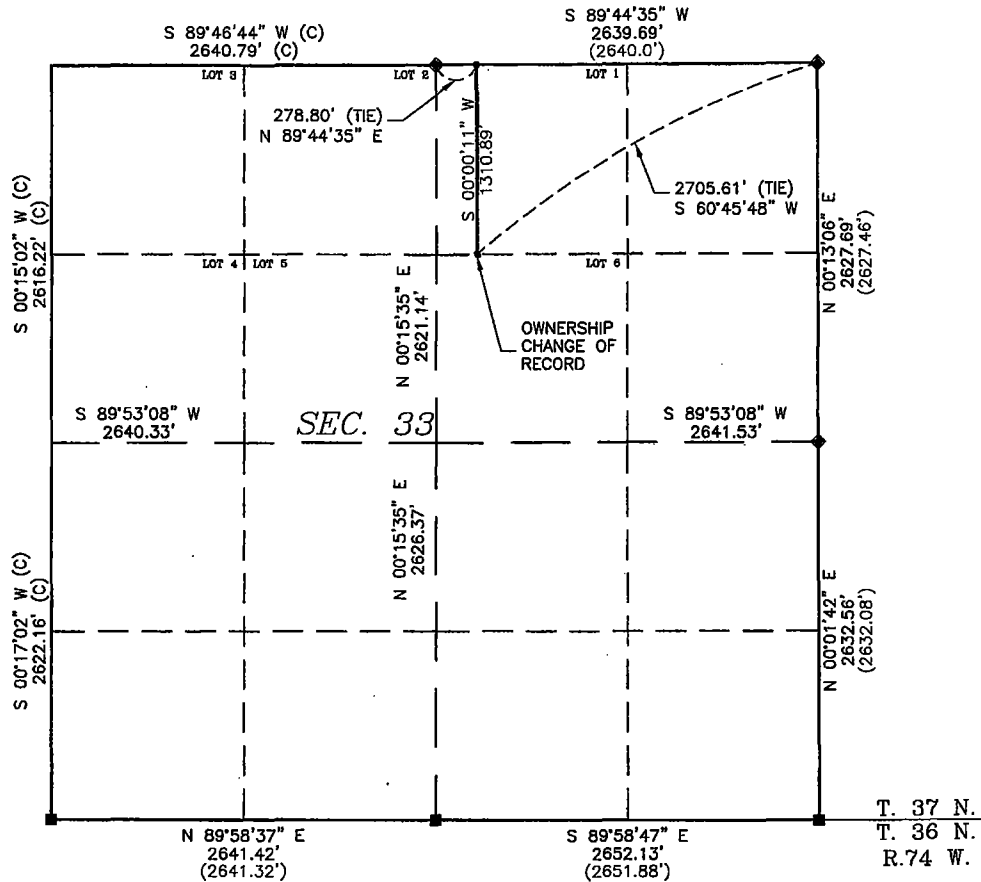

- LEGEND:**
- 1986 B.L.M. BRASS CAP
  - ◆ 1987 B.L.M. BRASS CAP
  - ( ) RECORDED DISTANCE
  - (C) CALCULATED FROM RECORD
  - CENTERLINE OF RIGHT OF WAY EASEMENT
  - BEGINNING AND END OF ALIGNMENT DESCRIPTION

**BASIS OF BEARING:**  
NAD 83 WYOMING STATE PLANE,  
EAST ZONE-GRID


**LEGAL DESCRIPTION:**

The following is a legal description for a 125 foot wide easement located in a portion of Lot 1 (NW 1/4 NE 1/4) of Section 33, Township 37 North, Range 74 West of the 6th P.M., Converse County, Wyoming. Said easement being 62.5 feet on each side of the following described centerline:

Commencing at the North 1/4 corner of said Section 33, said corner being monumented with a 1987 B.L.M. Brass cap, thence N 89°44'35" E, a distance of 278.80 feet to the True Point of Beginning of said easement centerline;

Thence along said centerline S 00°00'11" W, a distance of 1310.89 feet to a point on the South line of Lot 1 (NW 1/4 NE 1/4) said Section 33, said point being S 60°45'48" W, a distance of 2705.61 feet from the Northeast corner of said Section 33, being a 1987 B.L.M. Brass cap.

Said easement centerline being 1310.89 feet in length, more or less with side lines shortened or extended to the recorded boundary.

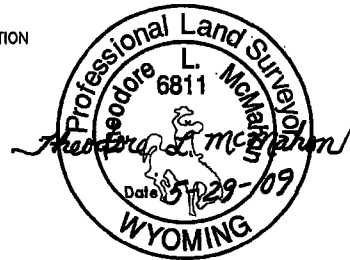

**CERTIFICATE OF SURVEYOR:**  
I, THEODORE L. MCMAHON, BEING A PROFESSIONAL LAND SURVEYOR, REGISTERED UNDER THE LAWS OF THE STATE OF WYOMING, DO HEREBY CERTIFY THAT THE MAP HEREON REPRESENTS AN ACTUAL SURVEY MADE BY MYSELF AND OR BY PERSONNEL OF KNIGHT TECHNOLOGIES INCORPORATED UNDER MY DIRECT SUPERVISION AND THAT SAID PLAT AND LEGAL DESCRIPTION SHOWN ARE ACCURATELY REPRESENTED.

PREPARED FOR:  
BLACK HILLS POWER, INC.  
825 9th STREET  
P.O. BOX 1400  
RAPID CITY, SD 57708



**RIGHT OF WAY EASEMENT  
HENRY LAND COMPANY**

SEC. 33, T. 37 N., R. 74 W.  
CONVERSE COUNTY, WYOMING

**NOTE:**  
ALL CENTERLINE BEARINGS AND DISTANCES HEREIN ARE CONSIDERED TO BE MORE OR LESS. THE CENTERLINE OF THE POWERLINE AS CONSTRUCTED IS THE CENTER LINE OF THE 125' WIDE EASEMENT BEING 62.5' ON EACH SIDE

PREPARED BY:  
KNIGHT TECHNOLOGIES, INC.  
201 W. Lakeway Rd.  
Suite 200  
Gillette, WY 82718  
Office: (307) 682-8547





DATE: 05-28-09	DESIGNED BY: KTI
SCALE: 1" = 1000'	DRAWN BY: KTI/PK
CNTR INTRVL: N/A	APPROVED BY: KTI/TLM
REVISION:	DATE: / /

FILE: F:\2008-020\_BHP\_TRANSMISSION\_LINE-FRABEE\FINAL\PLATS\HDR\_SEC\_PLATS\_GROUND\_WY85-EP

**RIGHT OF WAY EASEMENT  
BLACK HILLS POWER, INC.  
SECTION 33, T. 37 N., R. 74 W., 6TH P.M.  
CONVERSE COUNTY, WYOMING**

RECORD OWNER  
HORNBUCKLE RANCH, INC

FOOTAGE  
3937.9'  
RODS  
238.66

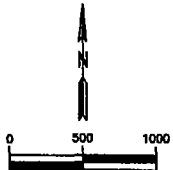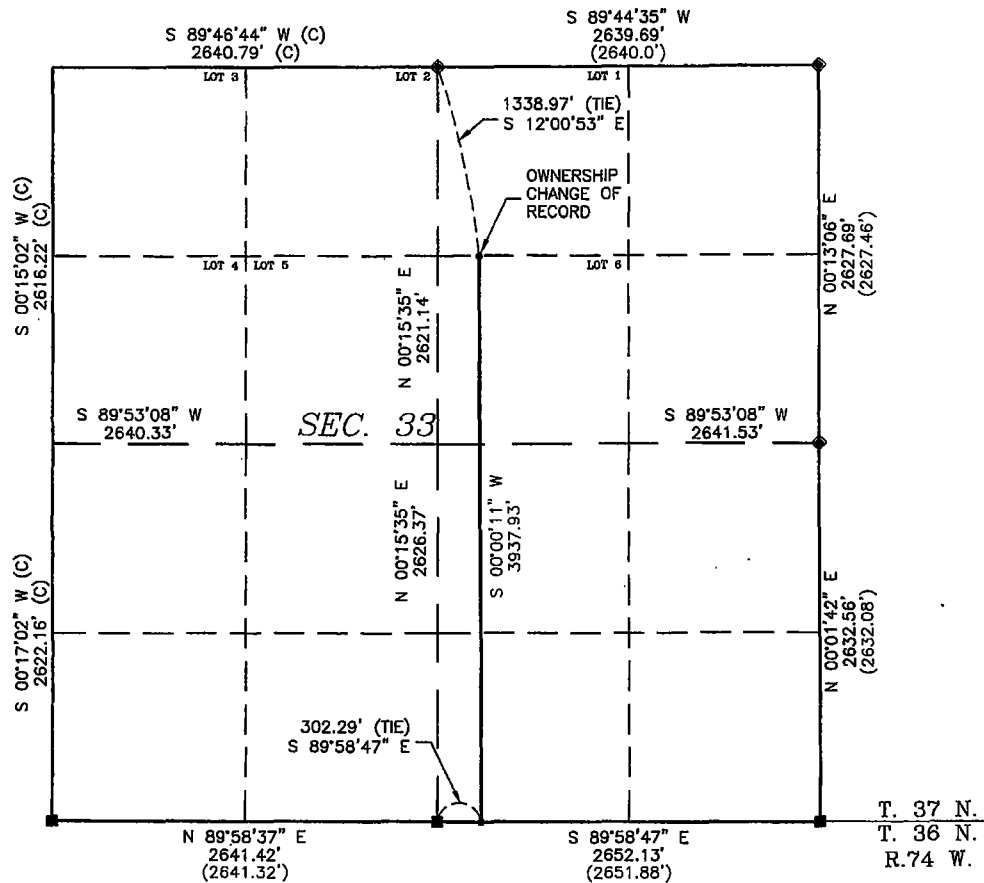

- LEGEND:**
- 1986 B.L.M. BRASS CAP
  - ◆ 1987 B.L.M. BRASS CAP
  - ( ) RECORDED DISTANCE
  - (C) CALCULATED FROM RECORD
  - CENTERLINE OF RIGHT OF WAY EASEMENT
  - BEGINNING AND END OF ALIGNMENT DESCRIPTION

**BASIS OF BEARING:**  
NAD 83 WYOMING STATE PLANE,  
EAST ZONE-GRID


**LEGAL DESCRIPTION:**

The following is a legal description for a 125 foot wide easement located in portions of Lot 6 (SW 1/4 NE 1/4), NW 1/4 SE 1/4 and SW 1/4 SE 1/4 of Section 33, Township 37 North, Range 74 West of the 6th P.M., Converse County, Wyoming. Said easement being 62.5 feet on each side of the following described centerline:

Commencing at the North 1/4 corner of said Section 33, said corner being monumented with a 1987 B.L.M. Brass cap, thence S 12°00'53" E, a distance of 1338.97 feet to the True Point of Beginning of said easement centerline;

Thence along said centerline S 00°00'11" W, a distance of 3937.93 feet to a point on the South line of said Section 33, said point being S 89°58'47" E, a distance of 302.29 feet from the South 1/4 corner of said Section 33, being a 1986 B.L.M. Brass cap.

Said easement centerline being 3937.93 feet in length, more or less with side lines shortened or extended to the recorded boundary.

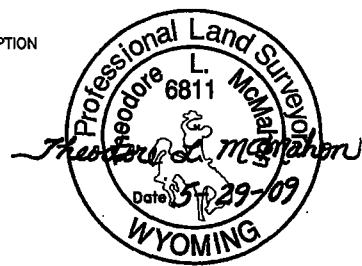



**CERTIFICATE OF SURVEYOR:**  
I, THEODORE L. MCMAHON, BEING A PROFESSIONAL LAND SURVEYOR, REGISTERED UNDER THE LAWS OF THE STATE OF WYOMING, DO HEREBY CERTIFY THAT THE MAP HEREON REPRESENTS AN ACTUAL SURVEY MADE BY MYSELF AND OR BY PERSONNEL OF KNIGHT TECHNOLOGIES INCORPORATED UNDER MY DIRECT SUPERVISION AND THAT SAID PLAT AND LEGAL DESCRIPTION SHOWN ARE ACCURATELY REPRESENTED.

PREPARED FOR: BLACK HILLS POWER, INC. 925 6th STREET P.O. BOX 1400 RAPID CITY, SD 57709	
<b>RIGHT OF WAY EASEMENT</b> HORNBUCKLE RANCH, INC  SEC. 33, T. 37 N., R. 74 W. CONVERSE COUNTY, WYOMING	
PREPARED BY: KNIGHT TECHNOLOGIES, INC. 201 W. Lakeway Rd. Suite 200 Gillette, WY 82718 Office: (307) 682-8547	DATE: 05-28-09 SCALE: 1" = 1000' CNTR INTRVL: N/A REVISION:
DESIGNED BY: KTI DRAWN BY: KTI/PK APPROVED BY: KTI/TLM	DATE: / /

**NOTE:**  
ALL CENTERLINE BEARINGS AND DISTANCES HEREIN ARE CONSIDERED TO BE MORE OR LESS. THE CENTERLINE OF THE POWERLINE AS CONSTRUCTED IS THE CENTER LINE OF THE 125' WIDE EASEMENT BEING 62.5' ON EACH SIDE

**RIGHT OF WAY EASEMENT  
BLACK HILLS POWER, INC.  
SECTION 4, T. 36 N., R. 74 W., 6TH P.M.  
CONVERSE COUNTY, WYOMING**

RECORD OWNER HORNBUCKLE RANCH, INC	FOOTAGE 5270.4'	RODS 319.42
---------------------------------------	--------------------	----------------

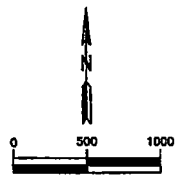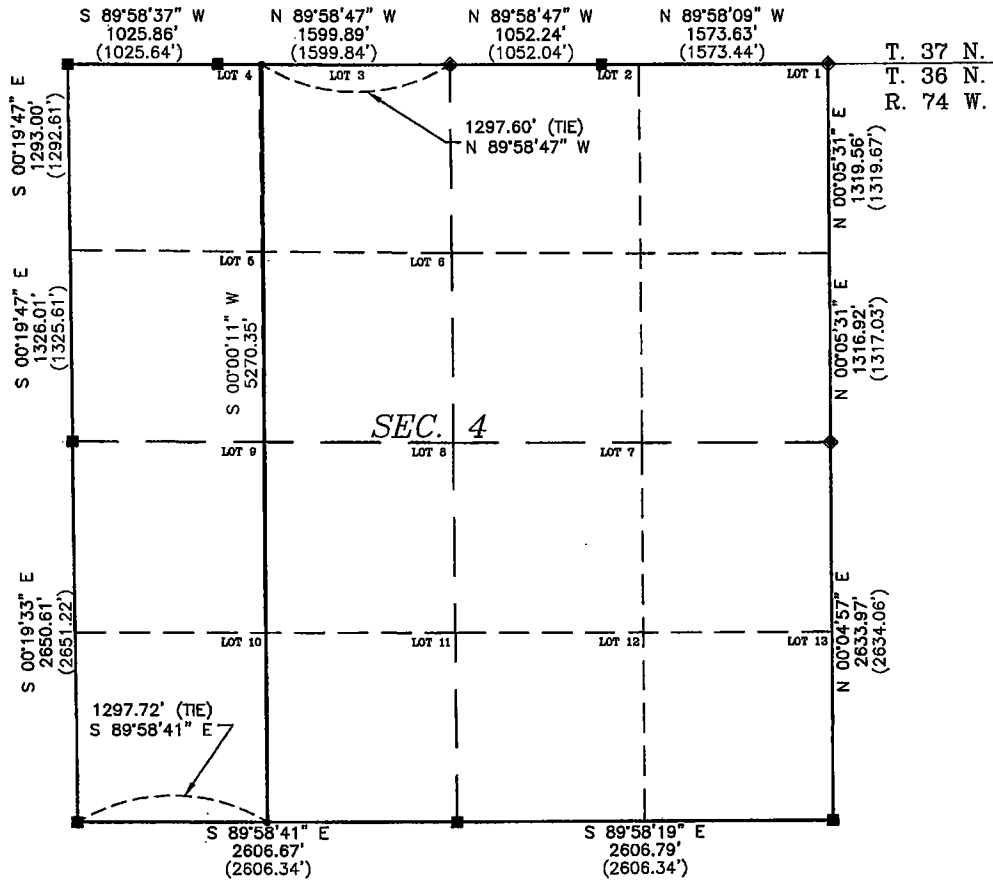

- LEGEND:**
- 1986 B.L.M. BRASS CAP
  - ◆ 1987 B.L.M. BRASS CAP
  - ( ) RECORDED DISTANCE
  - CENTERLINE OF RIGHT OF WAY EASEMENT
  - BEGINNING AND END OF ALIGNMENT DESCRIPTION

**BASIS OF BEARING:**  
NAD 83 WYOMING STATE PLANE,  
EAST ZONE-GRID

**LEGAL DESCRIPTION:**

The following is a legal description for a 125 foot wide easement located in portions of Lot 3 (NE 1/4 NW 1/4), Lot 4 (NW 1/4 NW 1/4), Lot 5 (SW 1/4 NW 1/4), Lot 6 (SE 1/4 NW 1/4), Lot 8 (NE 1/4 SW 1/4), Lot 9 (NW 1/4 SW 1/4), Lot 10 (SW 1/4 SW 1/4) and Lot 11 (SE 1/4 SW 1/4) of Section 4, Township 36 North, Range 74 West of the 6th P.M., Converse County, Wyoming. Said easement being 62.5 feet on each side of the following described centerline:

Commencing at the North 1/4 corner of said Section 4, said corner being monumented with a 1987 B.L.M. Brass cap, thence N 89°58'47" W, a distance of 1297.60 feet to the True Point of Beginning of said easement centerline;

Thence along said centerline S 00°00'11" W, a distance of 5270.35 feet to a point on the South line of Section 4, said point being S 89°58'41" E, a distance of 1297.72 feet from the Southwest corner of said Section 4, being a 1986 B.L.M. Brass cap.

Said easement centerline being 5270.35 feet in length, more or less with side lines shortened or extended to the recorded boundary.



**CERTIFICATE OF SURVEYOR:**  
I, THEODORE L. MCMAHON, BEING A PROFESSIONAL LAND SURVEYOR, REGISTERED UNDER THE LAWS OF THE STATE OF WYOMING, DO HEREBY CERTIFY THAT THE MAP HEREON REPRESENTS AN ACTUAL SURVEY MADE BY MYSELF AND OR BY PERSONNEL OF KNIGHT TECHNOLOGIES INCORPORATED UNDER MY DIRECT SUPERVISION AND THAT SAID PLAT AND LEGAL DESCRIPTION SHOWN ARE ACCURATELY REPRESENTED.

PREPARED FOR:  
BLACK HILLS POWER, INC.  
626 9th STREET  
P.O. BOX 1400  
RAPID CITY, SD 57709

**RIGHT OF WAY EASEMENT  
HORNBUCKLE RANCH, INC**

SEC. 4, T. 36 N., R. 74 W.  
CONVERSE COUNTY, WYOMING

**NOTE:**  
ALL CENTERLINE BEARINGS AND DISTANCES HEREIN ARE CONSIDERED TO BE MORE OR LESS. THE CENTERLINE OF THE POWERLINE AS CONSTRUCTED IS THE CENTER LINE OF THE 125' WIDE EASEMENT BEING 62.5' ON EACH SIDE



PREPARED BY:  
KNIGHT TECHNOLOGIES, INC.  
201 W. Lakeway Rd.  
Suite 200  
Gillette, WY 82718  
Office: (307) 682-8547



DATE: 06-29-09	DESIGNED BY: KTI
SCALE: 1" = 1000'	DRAWN BY: KTI/PK
CNTR INTVL: N/A	APPROVED BY: KTI/TLM
REVISION:	DATE: / /

**RIGHT OF WAY EASEMENT  
BLACK HILLS POWER, INC.  
SECTION 9, T. 36 N., R. 74 W., 6TH P.M.  
CONVERSE COUNTY, WYOMING**

RECORD OWNER	FOOTAGE	RODS
HORNBUCKLE RANCH, INC	5305.1'	321.52

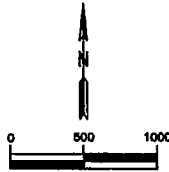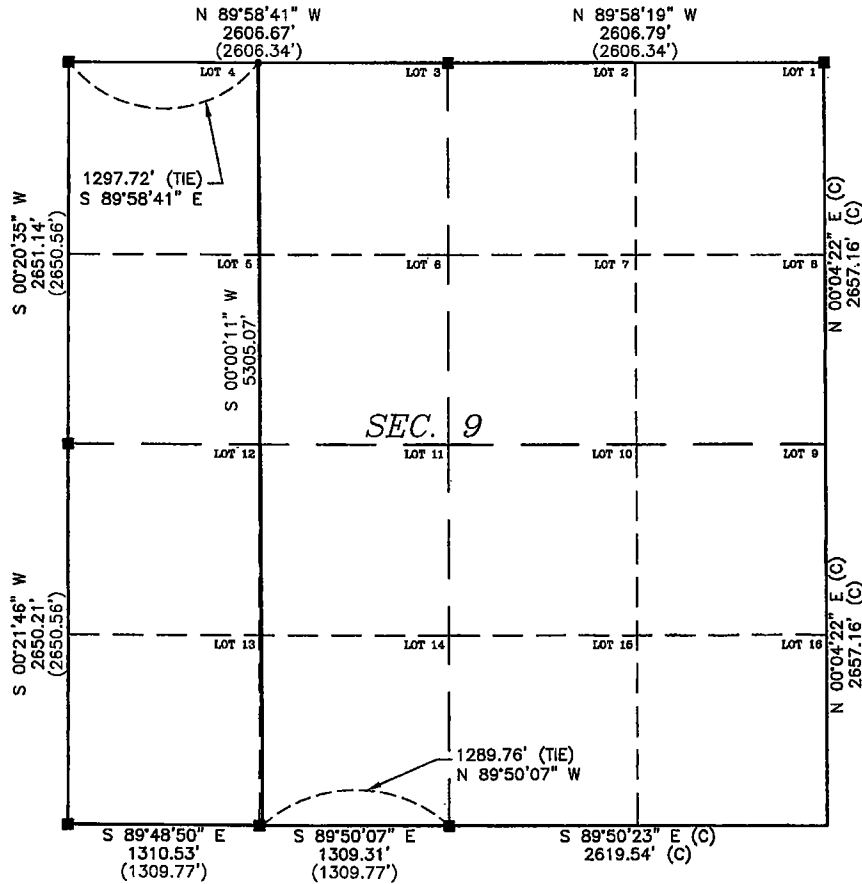

- LEGEND:**
- 1986 B.L.M. BRASS CAP
  - ( ) RECORDED DISTANCE
  - (C) CALCULATED FROM RECORD
  - CENTERLINE OF RIGHT OF WAY EASEMENT
  - BEGINNING AND END OF ALIGNMENT DESCRIPTION

**BASIS OF BEARING:**  
NAD 83 WYOMING STATE PLANE,  
EAST ZONE-GRID


**LEGAL DESCRIPTION:**

The following is a legal description for a 125 foot wide easement located in portions of Lot 3 (NE 1/4 NW 1/4), Lot 4 (NW 1/4 NW 1/4), Lot 5 (SW 1/4 NW 1/4), Lot 6 (SE 1/4 NW 1/4), Lot 11 (NE 1/4 SW 1/4), Lot 12 (NW 1/4 SW 1/4), Lot 13 (SW 1/4 SW 1/4) and Lot 14 (SE 1/4 SW 1/4) of Section 9, Township 36 North, Range 74 West of the 6th P.M., Converse County, Wyoming. Said easement being 62.5 feet on each side of the following described centerline:

Commencing at the Northwest corner of said Section 9, said corner being monumented with a 1986 B.L.M. Brass cap, thence S 89°58'41" E, a distance of 1297.72 feet to the True Point of Beginning of said easement centerline;

Thence along said centerline S 00°00'11" W, a distance of 5305.07 feet to a point on the South line of said Section 9, said point being N 89°50'07" W, a distance of 1289.76 feet from the South 1/4 corner of said Section 9, being a 1986 B.L.M. Brass cap.

Said easement centerline being 5305.07 feet in length, more or less with side lines shortened or extended to the recorded boundary.

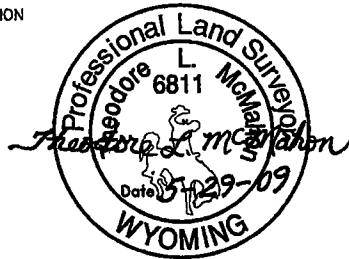

**CERTIFICATE OF SURVEYOR:**  
I, THEODORE L. MCMAHON, BEING A PROFESSIONAL LAND SURVEYOR, REGISTERED UNDER THE LAWS OF THE STATE OF WYOMING, DO HEREBY CERTIFY THAT THE MAP HEREON REPRESENTS AN ACTUAL SURVEY MADE BY MYSELF AND OR BY PERSONNEL OF KNIGHT TECHNOLOGIES INCORPORATED UNDER MY DIRECT SUPERVISION AND THAT SAID PLAT AND LEGAL DESCRIPTION SHOWN ARE ACCURATELY REPRESENTED.

PREPARED FOR:  
BLACK HILLS POWER, INC.  
625 9th STREET  
P.O. BOX 1400  
RAPID CITY, SD 57708



**RIGHT OF WAY EASEMENT  
HORNBUCKLE RANCH, INC**

SEC. 9, T. 36 N., R. 74 W.  
CONVERSE COUNTY, WYOMING

**NOTE:**  
ALL CENTERLINE BEARINGS AND DISTANCES HEREIN ARE CONSIDERED TO BE MORE OR LESS. THE CENTERLINE OF THE POWERLINE AS CONSTRUCTED IS THE CENTER LINE OF THE 125' WIDE EASEMENT BEING 62.5' ON EACH SIDE

PREPARED BY:  
KNIGHT TECHNOLOGIES, INC.  
201 W. Lakeway Rd.  
Suite 200  
Cheyenne, WY 82718  
Office: (307) 652-8547





DATE: 05-28-09	DESIGNED BY: KTI
SCALE: 1" = 1000'	DRAWN BY: KTI/HMB
CNTR INTVL: N/A	APPROVED BY: KTI/TLM
REVISION:	DATE: / /

FILE: F:\6008-080\_BHP\_TRANSMISSION\_LINE-PHASES\FINAL\PLATS\HDR\_SEC\_PLATS\_GROUND\_WY08-FP

**RIGHT OF WAY EASEMENT  
BLACK HILLS POWER, INC.  
SECTION 21, T. 36 N., R. 74 W., 6TH P.M.  
CONVERSE COUNTY, WYOMING**

RECORD OWNER: SMITH SHEEP COMPANY      FOOTAGE: 6119.1'      RODS: 370.85

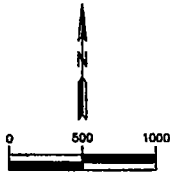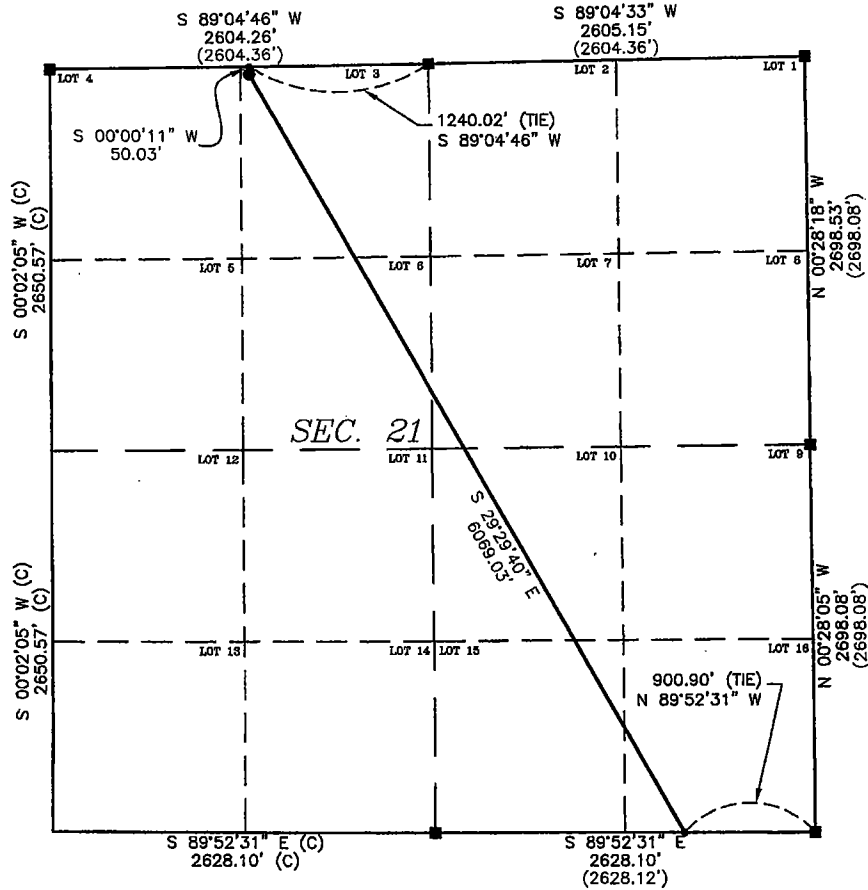

- LEGEND:**
- 1986 B.L.M. BRASS CAP
  - ( ) RECORDED DISTANCE
  - (C) CALCULATED FROM RECORD
  - CENTERLINE OF RIGHT OF WAY EASEMENT
  - BEGINNING AND END OF ALIGNMENT DESCRIPTION
  - POWER LINE PI LOCATION

**BASIS OF BEARING:**  
NAD 83 WYOMING STATE PLANE,  
EAST ZONE-GRID


**LEGAL DESCRIPTION:**

The following is a legal description for a 125 foot wide easement located in portion of Lot 3 (NE 1/4 NW 1/4), Lot 4 (NW 1/4 NW 1/4), Lot 6 (SE 1/4 NW 1/4), Lot 7 (SW 1/4 NE 1/4), Lot 10 (NW 1/4 SE 1/4), Lot 15 (SW 1/4 SE 1/4) and Lot 16 (SE 1/4 SE 1/4) of Section 21, Township 36 North, Range 74 West of the 6th P.M., Converse County, Wyoming. Said easement being 62.5 feet on each side of the following described centerline:

Commencing at the North 1/4 corner of said Section 21, said corner being monumented with a 1986 B.L.M. Brass cap, thence S 89°04'46" W, a distance of 1240.02 feet to the True Point of Beginning of said easement centerline;

Thence along said centerline S 00°00'11" W, a distance of 50.03 feet to a point;  
Thence along said centerline S 29°29'40" E, a distance of 6069.03 feet to a point on the South line of said Section 21, said point being N 89°52'31" W, a distance of 900.90 feet from the Southeast corner of said Section 21, being a 1986 B.L.M. Brass cap.

Said easement centerline being 6119.06 feet in length, more or less with side lines shortened or extended to the recorded boundary.

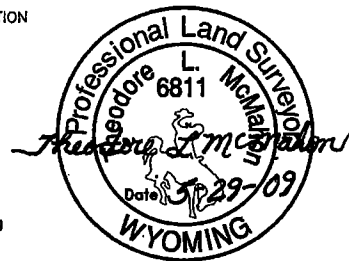

**CERTIFICATE OF SURVEYOR:**  
I, THEODORE L. MCMAHON, BEING A PROFESSIONAL LAND SURVEYOR, REGISTERED UNDER THE LAWS OF THE STATE OF WYOMING, DO HEREBY CERTIFY THAT THE MAP HEREON REPRESENTS AN ACTUAL SURVEY MADE BY MYSELF AND OR BY PERSONNEL OF KNIGHT TECHNOLOGIES INCORPORATED UNDER MY DIRECT SUPERVISION AND THAT SAID PLAT AND LEGAL DESCRIPTION SHOWN ARE ACCURATELY REPRESENTED.

PREPARED FOR:  
BLACK HILLS POWER, INC.  
625 9th STREET  
P.O. BOX 1400  
RAPID CITY, SD 57709



**RIGHT OF WAY EASEMENT  
SMITH SHEEP COMPANY**

SEC. 21, T. 36 N., R. 74 W.  
CONVERSE COUNTY, WYOMING

**NOTE:**  
ALL CENTERLINE BEARINGS AND DISTANCES HEREIN ARE CONSIDERED TO BE MORE OR LESS. THE CENTERLINE OF THE POWERLINE AS CONSTRUCTED IS THE CENTER LINE OF THE 125' WIDE EASEMENT BEING 62.5' ON EACH SIDE



PREPARED BY:  
KNIGHT TECHNOLOGIES, INC.  
201 W. Lakeway Rd.  
Suite 200  
Gillette, WY 82718  
Office: (307) 682-8547



DATE: 05-28-09	DESIGNED BY: KTI
SCALE: 1" = 1000'	DRAWN BY: KTI/PK
CNTR INTRVL: N/A	APPROVED BY: KTI/TLM
REVISION:	DATE: / /

**RIGHT OF WAY EASEMENT  
BLACK HILLS POWER, INC.  
SECTION 27, T. 36 N., R. 74 W., 6TH P.M.  
CONVERSE COUNTY, WYOMING**

RECORD OWNER: SMITH SHEEP COMPANY      FOOTAGE: 4298.1'      RODS: 260.49

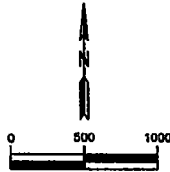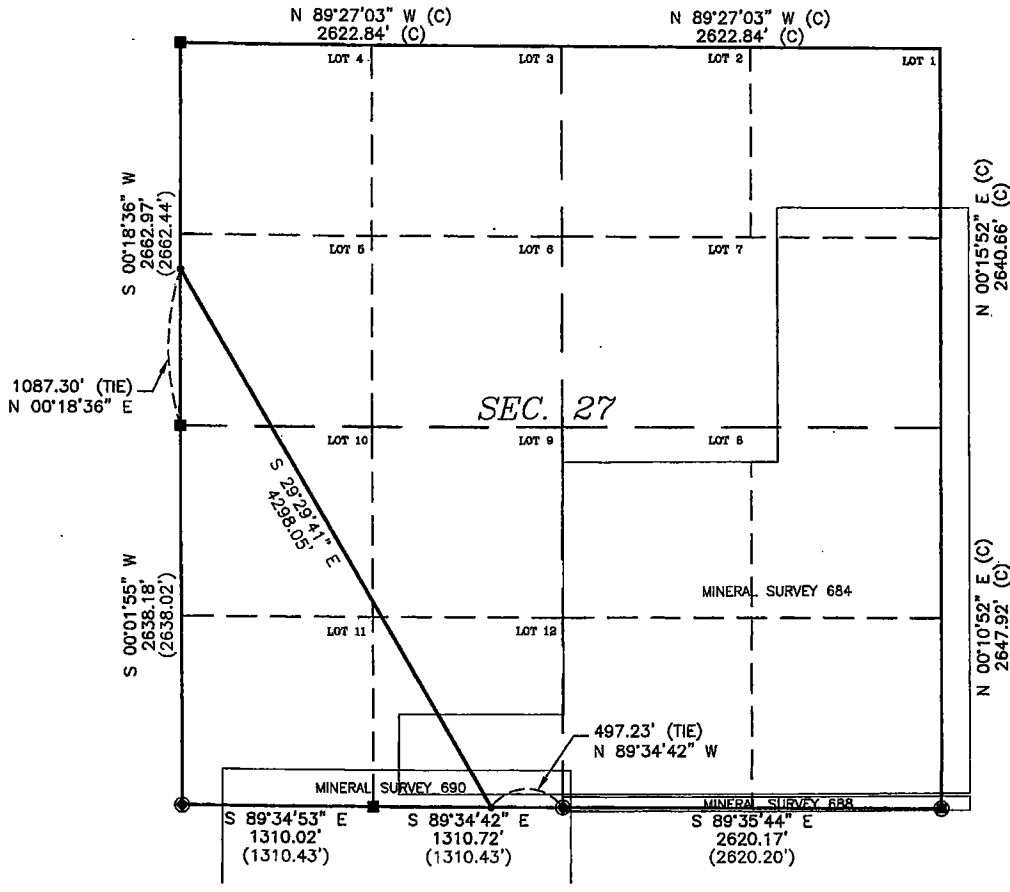

- LEGEND:**
- 1968 LS 520 BRASS CAP
  - 1974 LS 519 BRASS CAP
  - 1986 B.L.M. BRASS CAP
  - ( ) RECORDED DISTANCE
  - (C) CALCULATED FROM RECORD
  - MINERAL SURVEY BOUNDARY LINE
  - CENTERLINE OF RIGHT OF WAY EASEMENT
  - BEGINNING AND END OF ALIGNMENT DESCRIPTION

**BASIS OF BEARING:**  
NAD 83 WYOMING STATE PLANE,  
EAST ZONE-GRID


**LEGAL DESCRIPTION:**

The following is a legal description for a 125 foot wide easement located in portions of Lot 5 (SW 1/4 NW 1/4), Lot 9 (NE 1/4 SE 1/4), Lot 10 (NW 1/4 SW 1/4), Lot 11 (SW 1/4 SW 1/4) and Lot 12 (SE 1/4 SW 1/4) of Section 27, Township 36 North, Range 74 West of the 6th P.M., Converse County, Wyoming. Said easement being 62.5 feet on each side of the following described centerline:

Commencing at the West 1/4 corner of said Section 27, said corner being monumented with a 1986 B.L.M. Brass cap, thence N 00°18'36" E, a distance of 1087.30 feet to the True Point of Beginning of said easement centerline;

Thence along said centerline S 29°29'41" E, a distance of 4298.05 feet to a point on the South line of said Section 27, said point being N 89°34'42" W, a distance of 497.23 feet from the South 1/4 corner of said Section 27, being a 1974 L.S. 519 Brass cap.

Said easement centerline being 4298.05 feet in length, more or less with side lines shortened or extended to the recorded boundary.

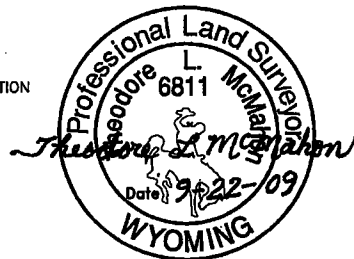

**CERTIFICATE OF SURVEYOR:**  
I, THEODORE L. MCMAHON, BEING A PROFESSIONAL LAND SURVEYOR, REGISTERED UNDER THE LAWS OF THE STATE OF WYOMING, DO HEREBY CERTIFY THAT THE MAP HEREON REPRESENTS AN ACTUAL SURVEY MADE BY MYSELF AND OR BY PERSONNEL OF KNIGHT TECHNOLOGIES INCORPORATED UNDER MY DIRECT SUPERVISION AND THAT SAID PLAT AND LEGAL DESCRIPTION SHOWN ARE ACCURATELY REPRESENTED.

PREPARED FOR:  
BLACK HILLS POWER, INC.  
825 9th STREET  
P.O. BOX 1400  
RAPID CITY, SD 57709

**RIGHT OF WAY EASEMENT  
SMITH SHEEP COMPANY**

SEC. 27, T. 36 N., R. 74 W.  
CONVERSE COUNTY, WYOMING

DATE: 09-22-09	DESIGNED BY: KTI
SCALE: 1" = 1000'	DRAWN BY: KTI/PK
CNTR INTRVL: N/A	APPROVED BY: KTI/TLM
REVISION:	DATE: / /



**NOTE:**  
ALL CENTERLINE BEARINGS AND DISTANCES HEREIN ARE CONSIDERED TO BE MORE OR LESS. THE CENTERLINE OF THE POWERLINE AS CONSTRUCTED IS THE CENTER LINE OF THE 125' WIDE EASEMENT BEING 62.5' ON EACH SIDE

PREPARED BY:  
KNIGHT TECHNOLOGIES, INC.  
201 W. Lokeway Rd.  
Suite 200  
Gillette, WY 82718  
Office: (307) 682-8547



**RIGHT OF WAY EASEMENT  
BLACK HILLS POWER, INC.  
SECTION 28, T. 36 N., R. 74 W., 6TH P.M.  
CONVERSE COUNTY, WYOMING**

RECORD OWNER SMITH SHEEP COMPANY	FOOTAGE 1812.5'	RODS 109.85
-------------------------------------	--------------------	----------------

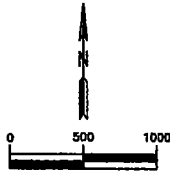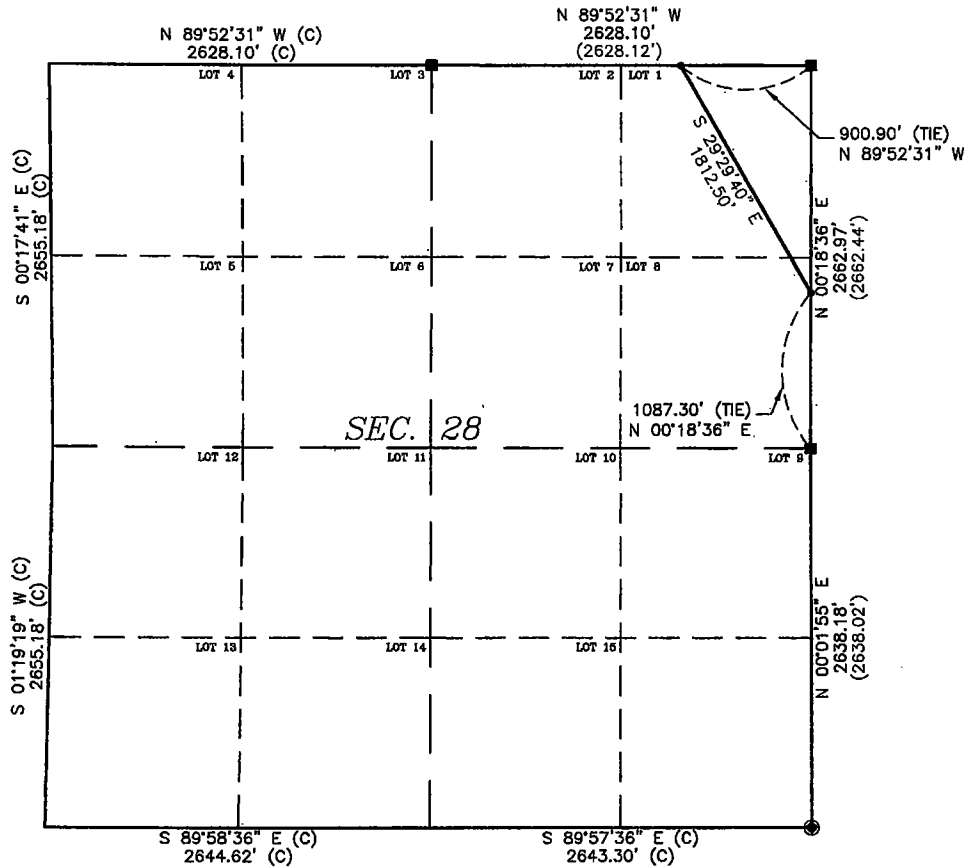

- LEGEND:**
- 1974 LS 519 BRASS CAP
  - 1986 B.L.M. BRASS CAP
  - ( ) RECORDED DISTANCE
  - (C) CALCULATED FROM RECORD
  - CENTERLINE OF RIGHT OF WAY EASEMENT
  - BEGINNING AND END OF ALIGNMENT DESCRIPTION

**BASIS OF BEARING:**  
NAD 83 WYOMING STATE PLANE,  
EAST ZONE-GRID


**LEGAL DESCRIPTION:**

The following is a legal description for a 125 foot wide easement located in portions of Lot 1 (NE 1/4 NE 1/4) and Lot 8 (SE 1/4 NE 1/4) of Section 28, Township 36 North, Range 74 West of the 6th P.M., Converse County, Wyoming. Said easement being 62.5 feet on each side of the following described centerline:

Commencing at the Northeast corner of said Section 28, said corner being monumented with a 1986 B.L.M. Brass cap, thence N 89°52'31" W, a distance of 900.90 feet to the True Point of Beginning of said easement centerline;

Thence along said centerline S 29°29'40" E, a distance of 1812.50 feet to a point on the East line of said Section 28, said point being N 00°18'36" E, a distance of 1087.30 feet from the East 1/4 corner of said Section 28, being a 1986 B.L.M. Brass cap.

Said easement centerline being 1812.50 feet in length, more or less with side lines shortened or extended to the recorded boundary.

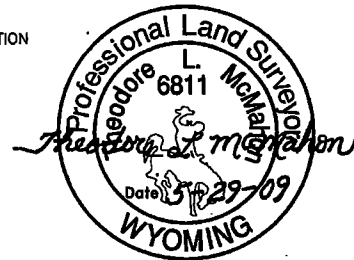

**CERTIFICATE OF SURVEYOR:**  
I, THEODORE L. MCMAHON, BEING A PROFESSIONAL LAND SURVEYOR, REGISTERED UNDER THE LAWS OF THE STATE OF WYOMING, DO HEREBY CERTIFY THAT THE MAP HEREON REPRESENTS AN ACTUAL SURVEY MADE BY MYSELF AND OR BY PERSONNEL OF KNIGHT TECHNOLOGIES INCORPORATED UNDER MY DIRECT SUPERVISION AND THAT SAID PLAT AND LEGAL DESCRIPTION SHOWN ARE ACCURATELY REPRESENTED.

PREPARED FOR:  
BLACK HILLS POWER, INC.  
625 9th STREET  
P.O. BOX 1400  
RAPID CITY, SD 57709

**RIGHT OF WAY EASEMENT  
SMITH SHEEP COMPANY**

SEC. 28, T. 36 N., R. 74 W.  
CONVERSE COUNTY, WYOMING

**NOTE:**  
ALL CENTERLINE BEARINGS AND DISTANCES HEREIN ARE CONSIDERED TO BE MORE OR LESS. THE CENTERLINE OF THE POWERLINE AS CONSTRUCTED IS THE CENTER LINE OF THE 125' WIDE EASEMENT BEING 62.5' ON EACH SIDE

PREPARED BY:  
KNIGHT TECHNOLOGIES, INC.  
201 W. Lakeway Rd.  
Suite 200  
Gillette, WY 82718  
Office: (307) 682-8547





DATE: 06-28-09	DESIGNED BY: KTI
SCALE: 1" = 1000'	DRAWN BY: KTI/PK
CNTR INTRVL: N/A	APPROVED BY: KTI/TLM
REVISION:	DATE: / /

FILE: F:\2006-020\_BHP\_TRANSMISSION\_LINE-PHASE2\FINAL\PLATS\HDR\_SEC\_PLATS\_GROUND\_WY06-09


**RIGHT OF WAY EASEMENT  
BLACK HILLS POWER, INC.  
SECTION 34, T. 36 N., R. 74 W., 6TH P.M.  
CONVERSE COUNTY, WYOMING**

RECORD OWNER SMITH LAND COMPANY	FOOTAGE 6510.4'	RODS 394.57
------------------------------------	--------------------	----------------

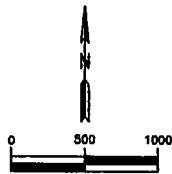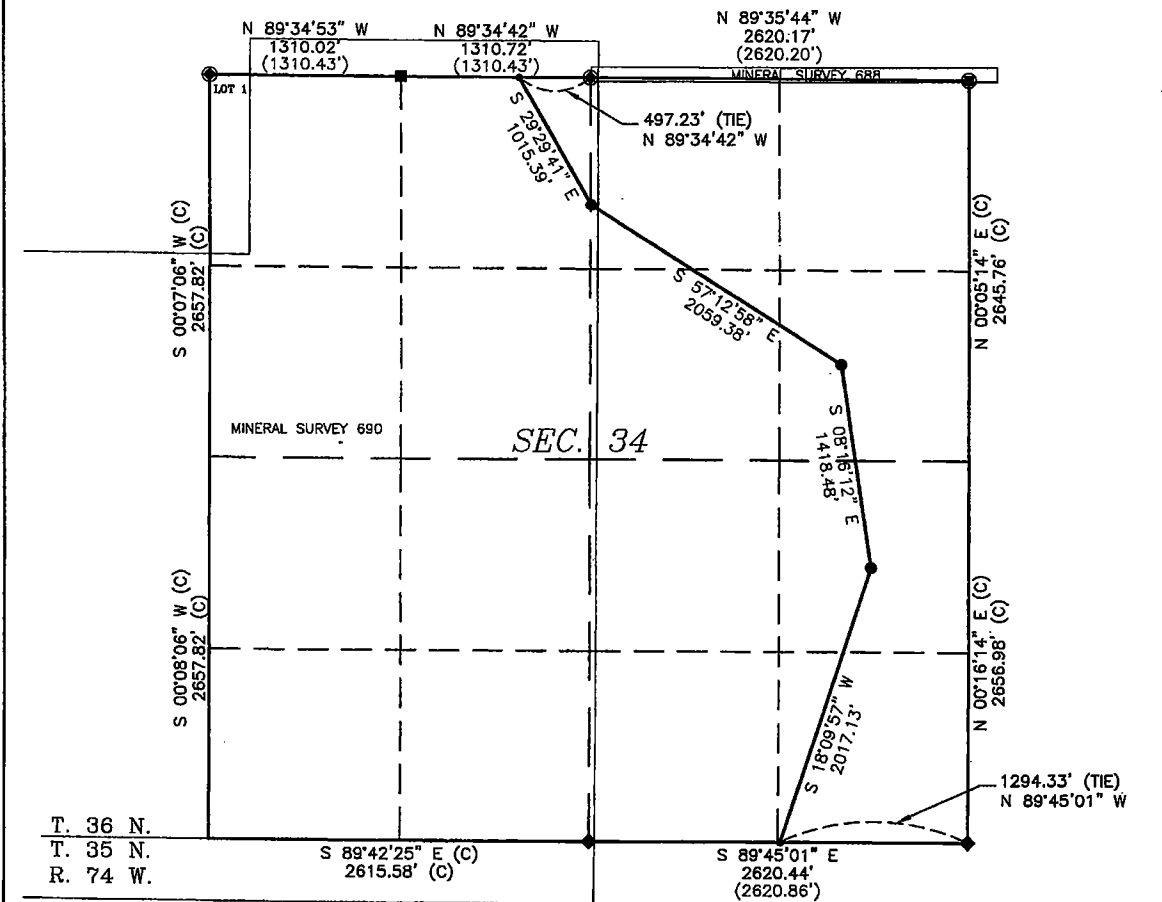

- LEGEND:**
- 1968 LS 520 BRASS CAP
  - 1974 LS 519 BRASS CAP
  - 1986 B.L.M. BRASS CAP
  - ◆ 1987 B.L.M. BRASS CAP
  - ( ) RECORDED DISTANCE
  - (C) CALCULATED FROM RECORD
  - MINERAL SURVEY BOUNDARY LINE
  - CENTERLINE OF RIGHT OF WAY EASEMENT
  - BEGINNING AND END OF ALIGNMENT DESCRIPTION
  - POWER LINE PI LOCATION

**BASIS OF BEARING:**  
NAD 83 WYOMING STATE PLANE,  
EAST ZONE—GRID

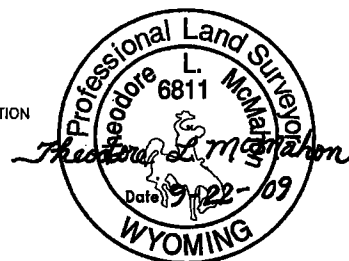

**LEGAL DESCRIPTION:**

The following is a legal description for a 125 foot wide easement located in portions of the NE 1/4 NW 1/4, NW 1/4 NE 1/4, SW 1/4 NE 1/4, SE 1/4 NE 1/4, NE 1/4 SE 1/4, SE 1/4 SE 1/4 and SW 1/4 SE 1/4 of Section 34, Township 36 North, Range 74 West of the 6th P.M., Converse County, Wyoming. Said easement being 62.5 feet on each side of the following described centerline:

Commencing at the North 1/4 corner of said Section 34, said corner being monumented with a 1974 LS 519 Brass cap, thence N 89°34'42" W, a distance of 497.23 feet to the True Point of Beginning of said easement centerline;

Thence along said centerline S 29°29'41" E, a distance of 1015.39 feet to a point;  
Thence along said centerline S 57°12'58" E, a distance of 2059.38 feet to a point;  
Thence along said centerline S 08°16'12" E, a distance of 1418.48 feet to a point;  
Thence along said centerline S 18°09'57" W, a distance of 2017.13 feet to a point on the South line of said Section 34, said point being N 89°45'01" W, a distance of 1294.33 feet from the Southeast corner of said Section 34, being a 1987 B.L.M. Brass cap.

Said easement centerline being 6510.38 feet in length, more or less with side lines shortened or extended to the recorded boundary.

**CERTIFICATE OF SURVEYOR:**

I, THEODORE L. MCMAHON, BEING A PROFESSIONAL LAND SURVEYOR, REGISTERED UNDER THE LAWS OF THE STATE OF WYOMING, DO HEREBY CERTIFY THAT THE MAP HEREON REPRESENTS AN ACTUAL SURVEY MADE BY MYSELF AND OR BY PERSONNEL OF KNIGHT TECHNOLOGIES INCORPORATED UNDER MY DIRECT SUPERVISION AND THAT SAID PLAT AND LEGAL DESCRIPTION SHOWN ARE ACCURATELY REPRESENTED.

PREPARED FOR:  
BLACK HILLS POWER, INC.  
625 6th STREET  
P.O. BOX 1400  
RAPID CITY, SD 57709

**RIGHT OF WAY EASEMENT  
SMITH LAND COMPANY**

SEC. 34, T. 36 N., R. 74 W.  
CONVERSE COUNTY, WYOMING

**NOTE:**  
ALL CENTERLINE BEARINGS AND DISTANCES HEREIN ARE CONSIDERED TO BE MORE OR LESS. THE CENTERLINE OF THE POWERLINE AS CONSTRUCTED IS THE CENTER LINE OF THE 125' WIDE EASEMENT BEING 62.5' ON EACH SIDE

PREPARED BY:  
**KNIGHT TECHNOLOGIES, INC.**  
201 W. Lakeway Rd.  
Suite 200  
Gillette, WY 82718  
Office: (307) 682-8547





DATE: 09-22-09	DESIGNED BY: KTI
SCALE: 1" = 1000'	DRAWN BY: KTI/PK
CNTR. INSTRVL: N/A	APPROVED BY: KTI/TLM
REVISION:	DATE: / /




**RIGHT OF WAY EASEMENT  
BLACK HILLS POWER, INC.  
SECTION 23, T. 40 N., R. 74 W., 6TH P.M.  
CONVERSE COUNTY, WYOMING**

RECORD OWNER: DILTS RANCH COMPANY & STEVEN K DILTS      FOOTAGE: 4650.8'      RODS: 281.87

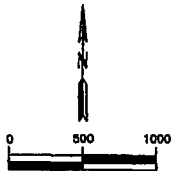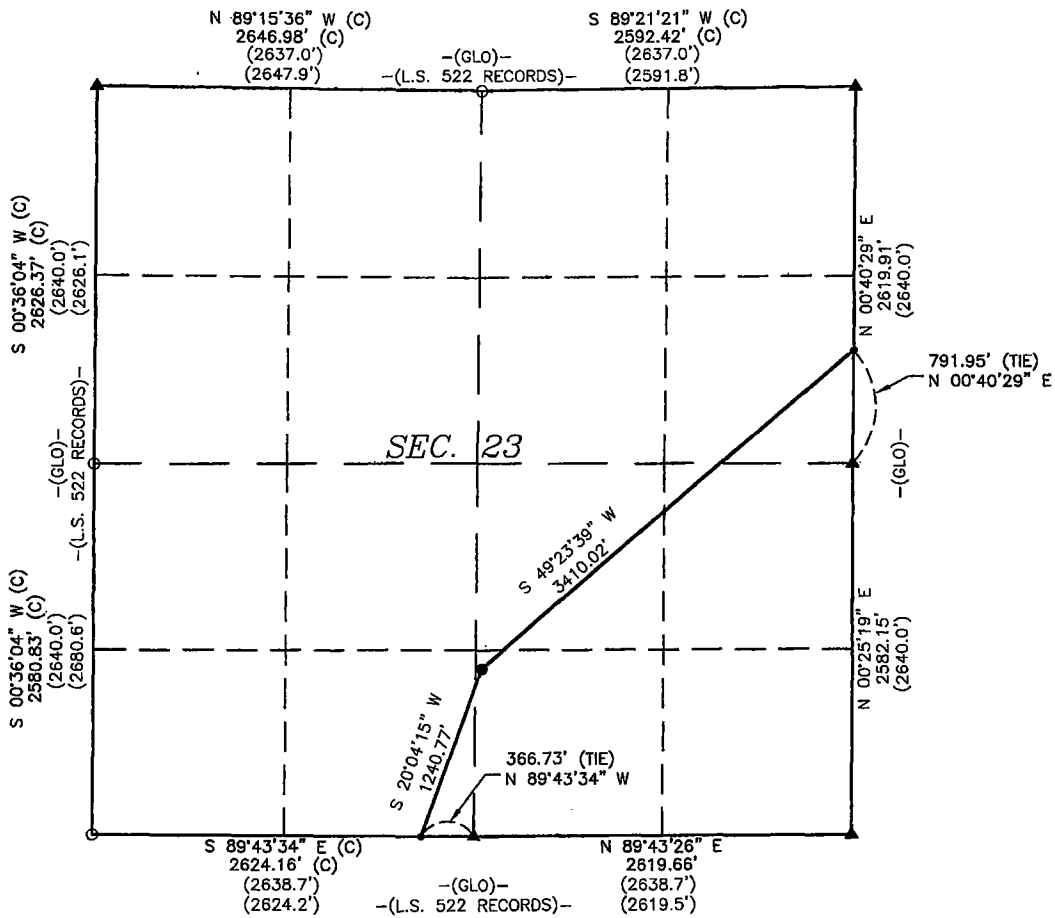

- LEGEND:**
- ▲ ORIGINAL STONE MARKER
  - CALCULATED CORNER POSITION (NOT SET)
  - ( ) RECORDED DISTANCE
  - (C) CALCULATED FROM RECORD
  - CENTERLINE OF RIGHT OF WAY EASEMENT
  - BEGINNING AND END OF ALIGNMENT DESCRIPTION
  - POWER LINE PI LOCATION
- (GLO) REFERS TO RECORDS OF ORIGINAL GENERAL LAND OFFICE  
(L.S. 522) REFERS TO RECORDS OF LAND SURVEYOR 522

**BASIS OF BEARING:**  
NAD 83 WYOMING STATE PLANE,  
EAST ZONE—GRID

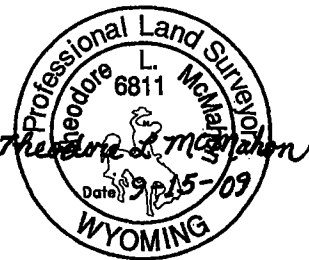

**LEGAL DESCRIPTION:**

The following is a legal description for a 125 foot wide easement located in portions of SE 1/4 NE 1/4, NE 1/4 SE 1/4, NW 1/4 SE 1/4, SW 1/4 SE 1/4 and SE 1/4 SW 1/4 of Section 23, Township 40 North, Range 74 West of the 6th P.M., Converse County, Wyoming. Said easement being 62.5 feet on each side of the following described centerline:

Commencing at the East 1/4 corner of said Section 23, said corner being monumented with an original stone marker, thence N 00°40'29" E, a distance of 791.95 feet to the True Point of Beginning of said easement centerline;

Thence along said centerline S 49°23'39" W, a distance of 3410.02 feet to a point; Thence along said centerline S 20°04'15" W, a distance of 1240.77 feet to a point on the South line of said Section 23, said point being N 89°43'34" W, a distance of 366.73 feet from the South 1/4 corner of said Section 23, being an original stone marker.

Said easement centerline being 4650.79 feet in length, more or less with side lines shortened or extended to the recorded boundary.

**CERTIFICATE OF SURVEYOR:**  
I, THEODORE L. MCMAHON, BEING A PROFESSIONAL LAND SURVEYOR, REGISTERED UNDER THE LAWS OF THE STATE OF WYOMING, DO HEREBY CERTIFY THAT THE MAP HEREON REPRESENTS AN ACTUAL SURVEY MADE BY MYSELF AND OR BY PERSONNEL OF KNIGHT TECHNOLOGIES INCORPORATED UNDER MY DIRECT SUPERVISION AND THAT SAID PLAT AND LEGAL DESCRIPTION SHOWN ARE ACCURATELY REPRESENTED.

PREPARED FOR:  
BLACK HILLS POWER, INC.  
926 9th STREET  
P.O. BOX 1400  
RAPID CITY, SD 57709

**RIGHT OF WAY EASEMENT**  
DILTS RANCH COMPANY &  
STEVEN K DILTS  
SEC. 23, T. 40 N., R. 74 W.  
CONVERSE COUNTY, WYOMING



**NOTE:**  
ALL CENTERLINE BEARINGS AND DISTANCES HEREIN ARE CONSIDERED TO BE MORE OR LESS. THE CENTERLINE OF THE POWERLINE AS CONSTRUCTED IS THE CENTER LINE OF THE 125' WIDE EASEMENT BEING 62.5' ON EACH SIDE

PREPARED BY:  
KNIGHT TECHNOLOGIES, INC.  
201 W. Lakeway Rd.  
Suite 200  
Gillette, WY 82718  
Office: (307) 682-8547

DATE: 09-15-09	DESIGNED BY: KTI
SCALE: 1" = 1000'	DRAWN BY: KTI/PK
CNTR INTRVL: N/A	APPROVED BY: KTI/TLM
REVISION:	DATE: / /

**RIGHT OF WAY EASEMENT  
BLACK HILLS POWER, INC.  
SECTION 24, T. 40 N., R. 74 W., 6TH P.M.  
CONVERSE COUNTY, WYOMING**

RECORD OWNER: DILTS RANCH COMPANY & STEVEN K DILTS      FOOTAGE: 2480.0'      RODS: 150.30

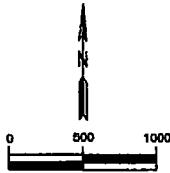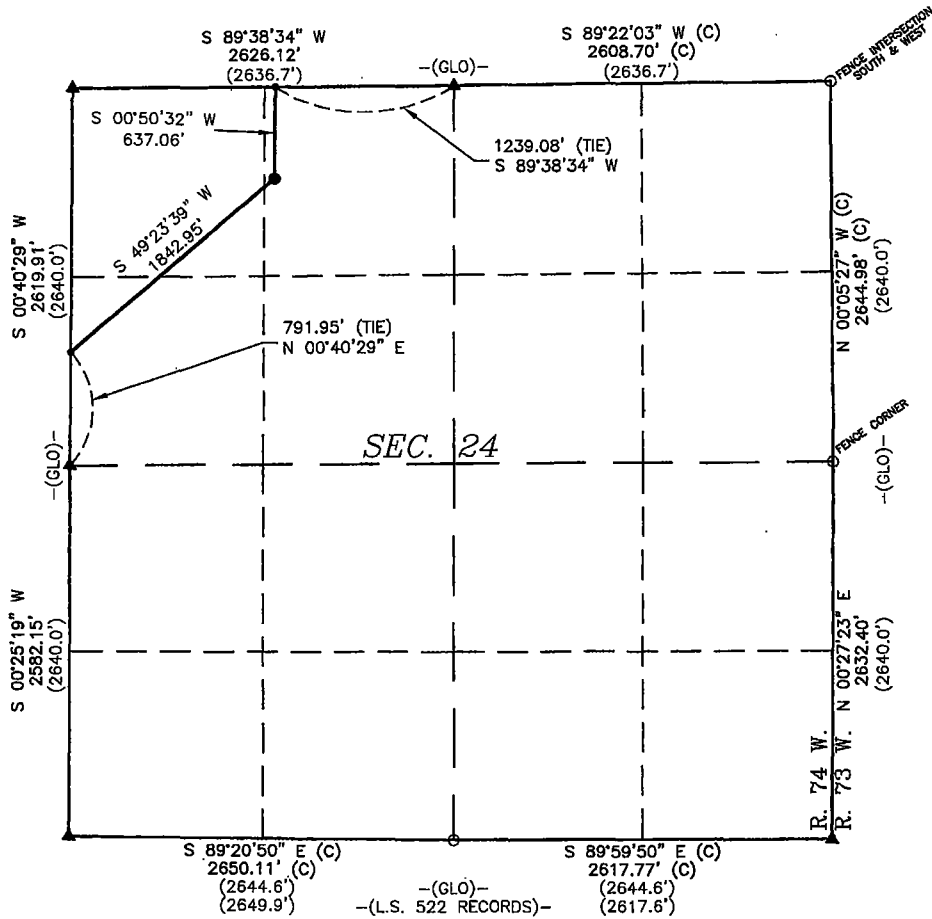

- LEGEND:**
- ▲ ORIGINAL STONE MARKER
  - CALCULATED CORNER POSITION (NOT SET)
  - ( ) RECORDED DISTANCE
  - (C) CALCULATED FROM RECORD
  - CENTERLINE OF RIGHT OF WAY EASEMENT
  - BEGINNING AND END OF ALIGNMENT DESCRIPTION
  - POWER LINE PI LOCATION
  - (GLO) REFERS TO RECORDS OF ORIGINAL GENERAL LAND OFFICE
  - (L.S. 522) REFERS TO RECORDS OF LAND SURVEYOR 522

**BASIS OF BEARING:**  
NAD 83 WYOMING STATE PLANE,  
EAST ZONE-GRID



**LEGAL DESCRIPTION:**

The following is a legal description for a 125 foot wide easement located in portions of NE 1/4 NW 1/4, NW 1/4 NW 1/4 and SW 1/4 NW 1/4 of Section 24, Township 40 North, Range 74 West of the 6th P.M., Converse County, Wyoming. Said easement being 62.5 feet on each side of the following described centerline:

Commencing at the North 1/4 corner of said Section 24, said corner being monumented with an original stone marker, thence S 89°38'34" W, a distance of 1239.08 feet to the True Point of Beginning of said easement centerline;

Thence along said centerline S 00°50'32" W, a distance of 637.06 feet to a point; Thence along said centerline S 49°23'39" W, a distance of 1842.95 feet to a point on the West line of said Section 24, said point being N 00°40'29" E, a distance of 791.95 feet from the West 1/4 corner of said Section 24, being an original stone marker.

Said easement centerline being 2480.01 feet in length, more or less with side lines shortened or extended to the recorded boundary.

**CERTIFICATE OF SURVEYOR:**  
I, THEODORE L. MCMAHON, BEING A PROFESSIONAL LAND SURVEYOR, REGISTERED UNDER THE LAWS OF THE STATE OF WYOMING, DO HEREBY CERTIFY THAT THE MAP HEREON REPRESENTS AN ACTUAL SURVEY MADE BY MYSELF AND OR BY PERSONNEL OF KNIGHT TECHNOLOGIES INCORPORATED UNDER MY DIRECT SUPERVISION AND THAT SAID PLAT AND LEGAL DESCRIPTION SHOWN ARE ACCURATELY REPRESENTED.

PREPARED FOR:  
BLACK HILLS POWER, INC.  
626 9th STREET  
P.O. BOX 1400  
RAPID CITY, SD 57709



**RIGHT OF WAY EASEMENT**  
DILTS RANCH COMPANY &  
STEVEN K DILTS  
SEC. 24, T. 40 N., R. 74 W.  
CONVERSE COUNTY, WYOMING

**NOTE:**

ALL CENTERLINE BEARINGS AND DISTANCES HEREIN ARE CONSIDERED TO BE MORE OR LESS. THE CENTERLINE OF THE POWERLINE AS CONSTRUCTED IS THE CENTER LINE OF THE 125' WIDE EASEMENT BEING 62.5' ON EACH SIDE



PREPARED BY:  
KNIGHT TECHNOLOGIES, INC.  
201 W. Lakeway Rd.  
Suite 200  
Gillette, WY 82718  
Office: (307) 682-8547



DATE: 09-16-09	DESIGNED BY: KTI
SCALE: 1" = 1000'	DRAWN BY: KTI/PK
CNTR INTVL: N/A	APPROVED BY: KTI/MLM
REVISION: /	DATE: / /


**RIGHT OF WAY EASEMENT  
BLACK HILLS POWER, INC.  
SECTION 26, T. 40 N., R. 74 W., 6TH P.M.  
CONVERSE COUNTY, WYOMING**

<b>RECORD OWNER</b>	<b>FOOTAGE</b>	<b>RODS</b>
DILTS RANCH COMPANY & STEVEN K DILTS	5591.0'	338.85

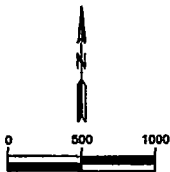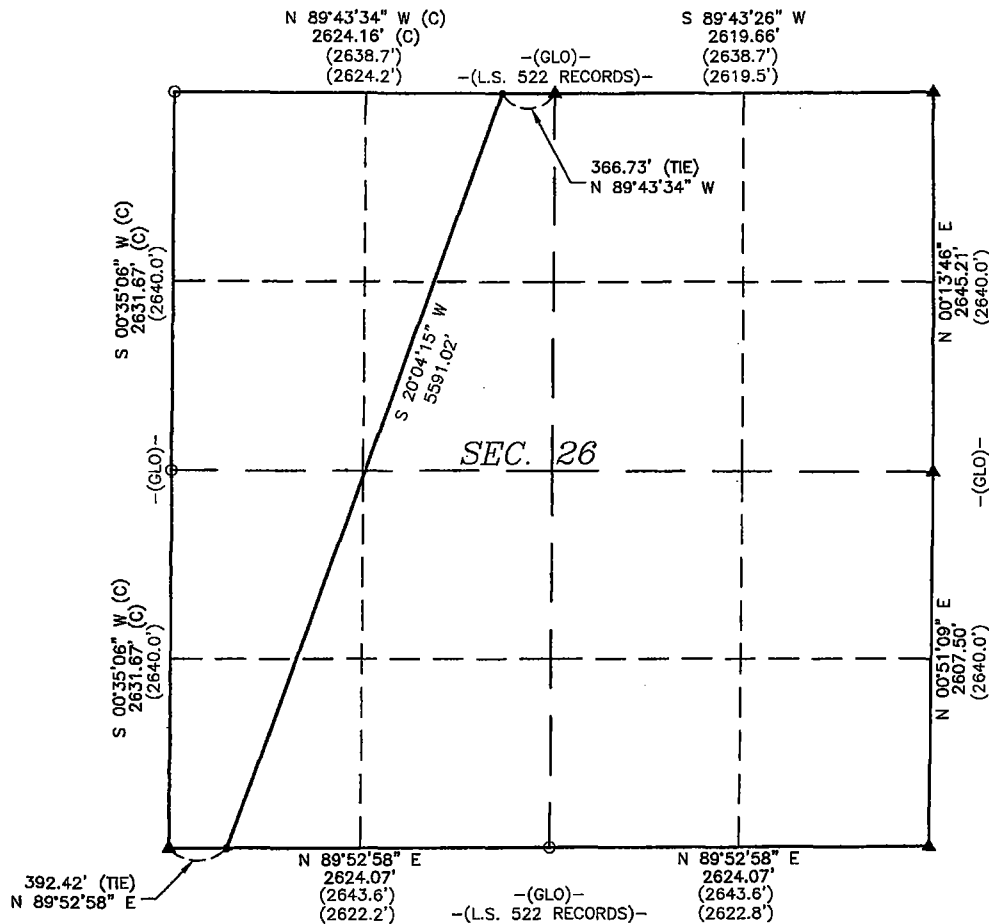

- LEGEND:**
- ▲ ORIGINAL STONE MARKER
  - CALCULATED CORNER POSITION (NOT SET)
  - ( ) RECORDED DISTANCE
  - (C) CALCULATED FROM RECORD
  - CENTERLINE OF RIGHT OF WAY EASEMENT
  - BEGINNING AND END OF ALIGNMENT DESCRIPTION
  - (GLO) REFERS TO RECORDS OF ORIGINAL GENERAL LAND OFFICE
  - (L.S. 522) REFERS TO RECORDS OF LAND SURVEYOR 522

**BASIS OF BEARING:**  
NAD 83 WYOMING STATE PLANE,  
EAST ZONE--GRID

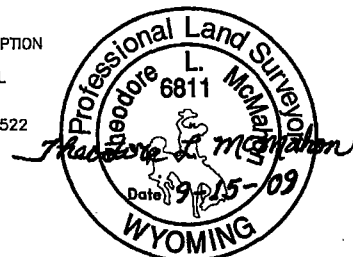

**LEGAL DESCRIPTION:**

The following is a legal description for a 125 foot wide easement located in portions of NE 1/4 NW 1/4, SW 1/4 NW 1/4, SE 1/4 NW 1/4, NE 1/4 SW 1/4, NW 1/4 SW 1/4 and SW 1/4 SW 1/4 of Section 26, Township 40 North, Range 74 West of the 6th P.M., Converse County, Wyoming. Said easement being 62.5 feet on each side of the following described centerline:

Commencing at the North 1/4 corner of said Section 26, said corner being monumented with an original stone marker, thence N 89°43'34" W, a distance of 366.73 feet to the True Point of Beginning of said easement centerline;

Thence along said centerline S 20°04'15" W, a distance of 5591.02 feet to a point on the South line of said Section 26, said point being N 89°52'58" E, a distance of 392.42 feet from the Southwest corner of said Section 26, being an original stone marker.

Said easement centerline being 5591.02 feet in length, more or less with side lines shortened or extended to the recorded boundary.

**CERTIFICATE OF SURVEYOR:**  
I, THEODORE L. MCMAHON, BEING A PROFESSIONAL LAND SURVEYOR, REGISTERED UNDER THE LAWS OF THE STATE OF WYOMING, DO HEREBY CERTIFY THAT THE MAP HEREON REPRESENTS AN ACTUAL SURVEY MADE BY MYSELF AND OR BY PERSONNEL OF KNIGHT TECHNOLOGIES INCORPORATED UNDER MY DIRECT SUPERVISION AND THAT SAID PLAT AND LEGAL DESCRIPTION SHOWN ARE ACCURATELY REPRESENTED.

PREPARED FOR:  
BLACK HILLS POWER, INC.  
826 8th STREET  
P.O. BOX 1400  
RAPID CITY, SD 57709

**RIGHT OF WAY EASEMENT**  
DILTS RANCH COMPANY &  
STEVEN K DILTS  
SEC. 26, T. 40 N., R. 74 W.  
CONVERSE COUNTY, WYOMING

**NOTE:**  
ALL CENTERLINE BEARINGS AND DISTANCES HEREIN ARE CONSIDERED TO BE MORE OR LESS. THE CENTERLINE OF THE POWERLINE AS CONSTRUCTED IS THE CENTER LINE OF THE 125' WIDE EASEMENT BEING 62.5' ON EACH SIDE



PREPARED BY:  
KNIGHT TECHNOLOGIES, INC.  
201 W. Lakeway Rd.  
Suite 200  
Gillette, WY 82718  
Office: (307) 682-8547



DATE: 09-15-09	DESIGNED BY: KTI
SCALE: 1" = 1000'	DRAWN BY: KTI/PK
CNTR INTRVL: N/A	APPROVED BY: KTI/TLM
REVISION:	DATE: / /

**RIGHT OF WAY EASEMENT  
BLACK HILLS POWER, INC.  
SECTION 34, T. 40 N., R. 74 W., 6TH P.M.  
CONVERSE COUNTY, WYOMING**

RECORD OWNER	FOOTAGE	RODS
DILTS RANCH COMPANY & STEVEN K DILTS INTER VIVOS TRUST	4366.4'	264.63

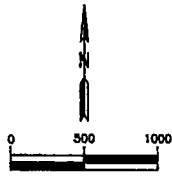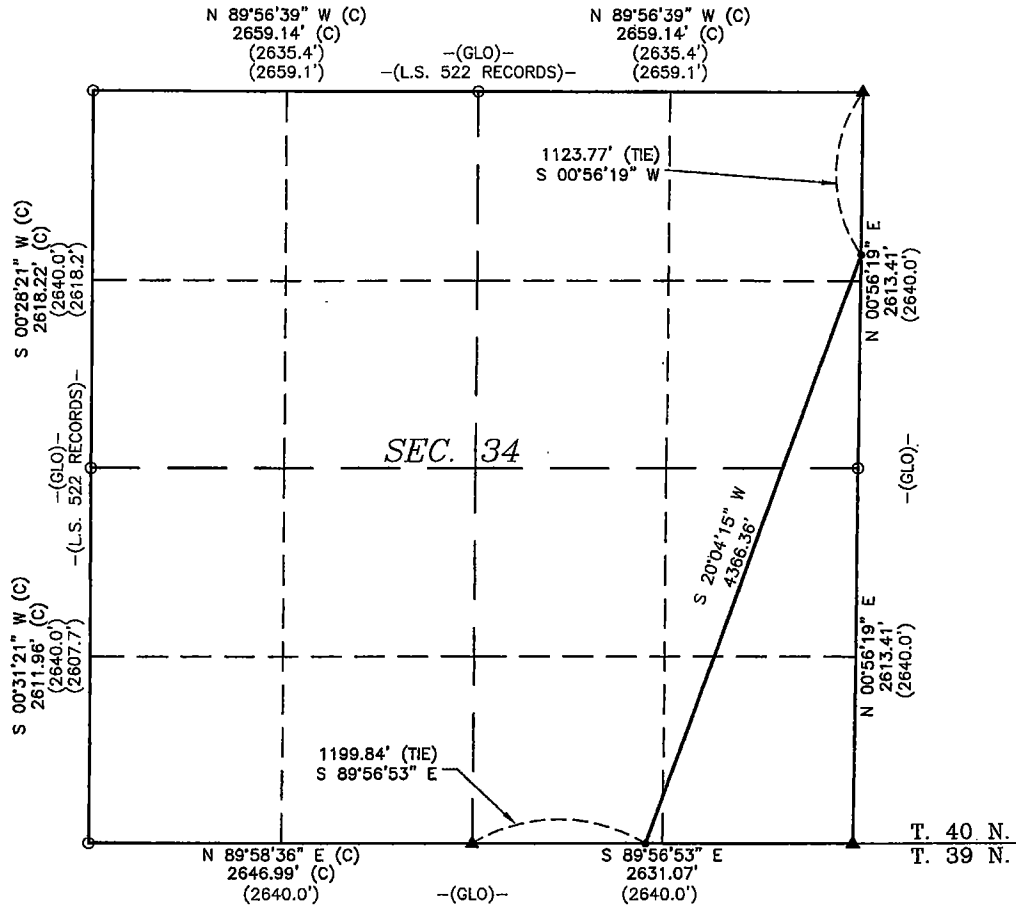

- LEGEND:**
- ▲ ORIGINAL STONE MARKER
  - CALCULATED CORNER POSITION (NOT SET)
  - ( ) RECORDED DISTANCE
  - (C) CALCULATED FROM RECORD
  - CENTERLINE OF RIGHT OF WAY EASEMENT
  - BEGINNING AND END OF ALIGNMENT DESCRIPTION
  - (GLO) REFERS TO RECORDS OF ORIGINAL GENERAL LAND OFFICE
  - (L.S. 522) REFERS TO RECORDS OF LAND SURVEYOR 522

**BASIS OF BEARING:**  
NAD 83 WYOMING STATE PLANE,  
EAST ZONE-GRID



**LEGAL DESCRIPTION:**

The following is a legal description for a 125 foot wide easement located in portions of NE 1/4 NE 1/4, SE 1/4 NE 1/4, NE 1/4 SE 1/4, SW 1/4 SE 1/4 and SE 1/4 SE 1/4 of Section 34, Township 40 North, Range 74 West of the 6th P.M., Converse County, Wyoming. Said easement being 62.5 feet on each side of the following described centerline:

Commencing at the Northeast corner of said Section 34, said corner being monumented with an original stone marker, thence S 00°56'19" W, a distance of 1123.77 feet to the True Point of Beginning of said easement centerline;

Thence along said centerline S 20°04'15" W, a distance of 4366.36 feet to a point on the South line of said Section 34, said point being S 89°56'53" E, a distance of 1199.84 feet from the South 1/4 corner of said Section 34, being an original stone marker.

Said easement centerline being 4366.36 feet in length, more or less with side lines shortened or extended to the recorded boundary.

**CERTIFICATE OF SURVEYOR:**  
I, THEODORE L. MCMAHON, BEING A PROFESSIONAL LAND SURVEYOR, REGISTERED UNDER THE LAWS OF THE STATE OF WYOMING, DO HEREBY CERTIFY THAT THE MAP HERON REPRESENTS AN ACTUAL SURVEY MADE BY MYSELF AND OR BY PERSONNEL OF KNIGHT TECHNOLOGIES INCORPORATED UNDER MY DIRECT SUPERVISION AND THAT SAID PLAT AND LEGAL DESCRIPTION SHOWN ARE ACCURATELY REPRESENTED.

PREPARED FOR:  
BLACK HILLS POWER, INC.  
626 9th STREET  
P.O. BOX 1400  
RAPID CITY, SD 57709

**RIGHT OF WAY EASEMENT  
DILTS RANCH COMPANY &  
STEVEN K DILTS INTER VIVOS TRUST  
SEC. 34, T. 40 N., R. 74 W.  
CONVERSE COUNTY, WYOMING**

**NOTE:**  
ALL CENTERLINE BEARINGS AND DISTANCES HEREIN ARE CONSIDERED TO BE MORE OR LESS. THE CENTERLINE OF THE POWERLINE AS CONSTRUCTED IS THE CENTER LINE OF THE 125' WIDE EASEMENT BEING 62.5' ON EACH SIDE



PREPARED BY:  
KNIGHT TECHNOLOGIES, INC.  
201 W. Lakeway Rd.  
Suite 200  
Gillette, WY 82718  
Office: (307) 682-8547



DATE: 08-16-09	DESIGNED BY: KTI
SCALE: 1" = 1000'	DRAWN BY: KTI/PK
CNTR INTVL: N/A	APPROVED BY: KTI/TLM
REVISION:	DATE: / /


**RIGHT OF WAY EASEMENT  
BLACK HILLS POWER, INC.  
SECTION 35, T. 40 N., R. 74 W., 6TH P.M.  
CONVERSE COUNTY, WYOMING**

<b>RECORD OWNER</b>	<b>FOOTAGE</b>	<b>RODS</b>
DILTS RANCH COMPANY & STEVEN K DILTS INTER VIVOS TRUST	1197.1'	72.55

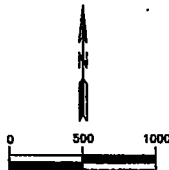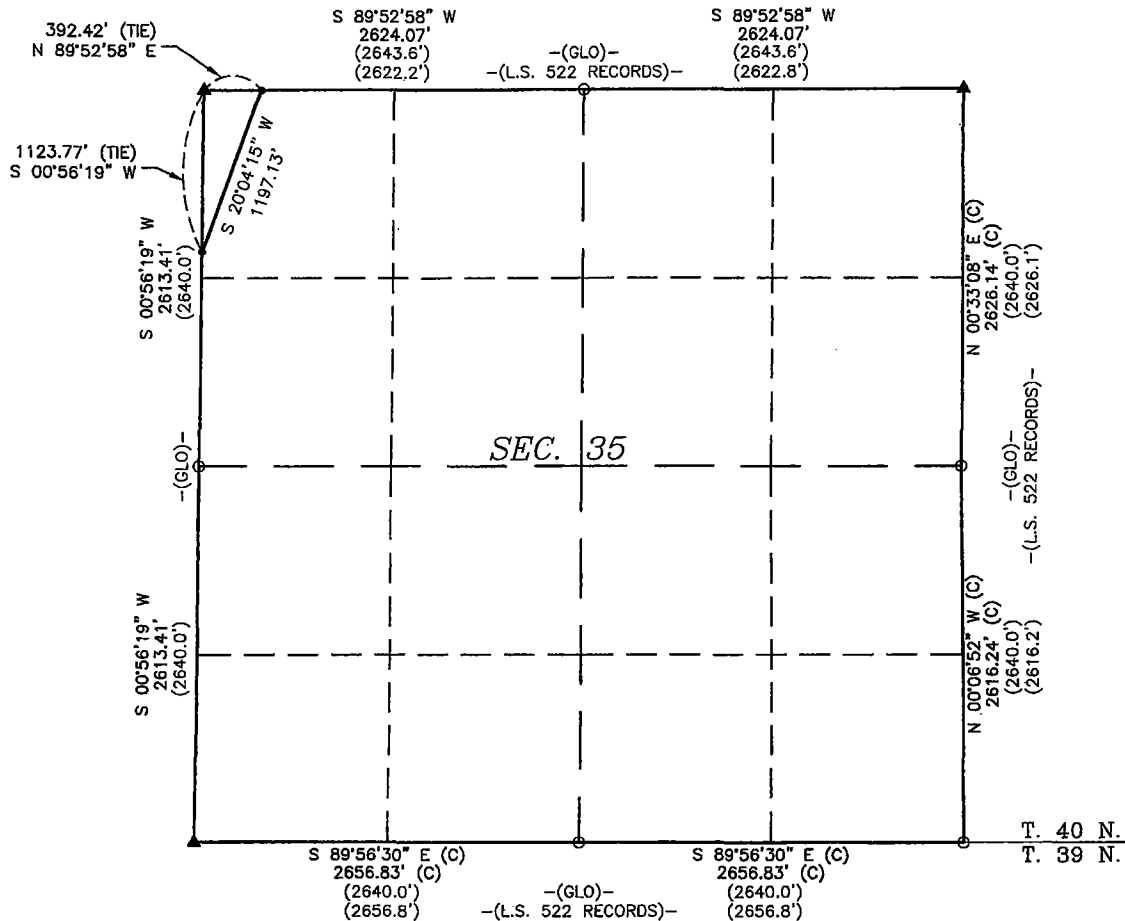

- LEGEND:**
- ▲ ORIGINAL STONE MARKER
  - CALCULATED CORNER POSITION (NOT SET)
  - ( ) RECORDED DISTANCE
  - (C) CALCULATED FROM RECORD
  - CENTERLINE OF RIGHT OF WAY EASEMENT
  - BEGINNING AND END OF ALIGNMENT DESCRIPTION
  - (GLO) REFERS TO RECORDS OF ORIGINAL GENERAL LAND OFFICE
  - (L.S. 522) REFERS TO RECORDS OF LAND SURVEYOR 522

**BASIS OF BEARING:**  
NAD 83 WYOMING STATE PLANE,  
EAST ZONE-GRID

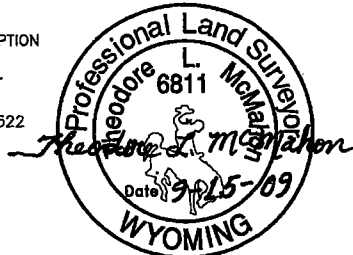

**LEGAL DESCRIPTION:**

The following is a legal description for a 125 foot wide easement located in a portion of the NW 1/4 NW 1/4 of Section 35, Township 40 North, Range 74 West of the 6th P.M., Converse County, Wyoming. Said easement being 62.5 feet on each side of the following described centerline:

Commencing at the Northwest corner of said Section 35, said corner being monumented with an original stone marker, thence N 89°52'58" E, a distance of 392.42 feet to the True Point of Beginning of said easement centerline;

Thence along said centerline S 20°04'15" W, a distance of 1197.13 feet to a point on the West line of said Section 35, said point being S 00°56'19" W, a distance of 1123.77 feet from the Northwest corner of said Section 35, being an original stone marker.

Said easement centerline being 1197.13 feet in length, more or less with side lines shortened or extended to the recorded boundary.

**CERTIFICATE OF SURVEYOR:**  
I, THEODORE L. MCMAHON, BEING A PROFESSIONAL LAND SURVEYOR, REGISTERED UNDER THE LAWS OF THE STATE OF WYOMING, DO HEREBY CERTIFY THAT THE MAP HEREON REPRESENTS AN ACTUAL SURVEY MADE BY MYSELF AND OR BY PERSONNEL OF KNIGHT TECHNOLOGIES INCORPORATED UNDER MY DIRECT SUPERVISION AND THAT SAID PLAT AND LEGAL DESCRIPTION SHOWN ARE ACCURATELY REPRESENTED.

**PREPARED FOR:**  
BLACK HILLS POWER, INC.  
626 8th STREET  
P.O. BOX 1400  
RAPID CITY, SD 57709

**RIGHT OF WAY EASEMENT  
DILTS RANCH COMPANY &  
STEVEN K DILTS INTER VIVOS TRUST  
SEC. 35, T. 40 N., R. 74 W.  
CONVERSE COUNTY, WYOMING**

**NOTE:**  
ALL CENTERLINE BEARINGS AND DISTANCES HEREIN ARE CONSIDERED TO BE MORE OR LESS. THE CENTERLINE OF THE POWERLINE AS CONSTRUCTED IS THE CENTER LINE OF THE 125' WIDE EASEMENT BEING 62.5' ON EACH SIDE

**PREPARED BY:**  
KNIGHT TECHNOLOGIES, INC.  
201 W. Lakeway Rd.  
Suite 200  
Giblette, WY 82718  
Office: (307) 682-8547

DATE: 09-16-08	DESIGNED BY: KTI
SCALE: 1" = 1000'	DRAWN BY: KTI/PK
CNTR INTVL: N/A	APPROVED BY: KTI/TLM
REVISION:	DATE: / /