

NOTE: REFER TO THE STRUCTURE LIST FOR DETAILED DESIGN INFORMATION.

FILED UNDER: XXXXX




REV	DESCRIPTION	DWN	DGN	CHK	DATE
12	AS-BUILT W.D. #0972	MWB	MWB	HWD	05/01/15
11	REPLACE MARKUPS INCORPORATED	MWB	MWB	HWD	07/25/14
10	SWAPPED STRUCTURE #301 WITH #44 (145') IN SEG 7. SEE STRUCTURE LOCATION MATRIX REV 11 FOR DETAILS.	MWB	MWB	HWD	06/26/14
9	MOVED STRUCTURE 043 WEST. SEE 0972-BROOKINGS-LYON STRUCTURE LOCATION MATRIX REV 10 FOR DETAILS.	MWB	MWB	HWD	02/04/14
8	VARIOUS STAKING REVIEW MOVES. SEE 0972-BROOKINGS-LYON STRUCTURE MATRIX REV 8 FOR DETAILS.	MWB	MWB	HWD	12/13/13

APPROVALS	DATE	DESIGN DATA
DRAWN BY: MWB	05/01/15	CONDUCTOR: 954 ACSS/TW 20/7
DESIGN BY: MWB	05/01/15	SHIELD WIRE: 3/8 EHS / DNO-8959 OPGW
CHECKED BY: HWD	05/01/15	
APPROVED BY: LDK	05/01/15	

GREAT RIVER ENERGY™

BROOKINGS - LYON COUNTY
345 KV DOUBLE CIRCUIT TRANSMISSION LINE

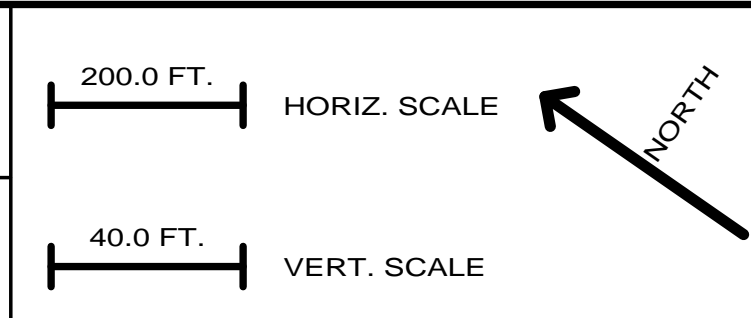

DWG. NO.
0972-91D
REVISION: 12
SHEET 1 OF 60