

NOTE: REFER TO THE STRUCTURE LIST FOR DETAILED DESIGN INFORMATION.


FILED UNDER: XXXX



REVISIONS				APPROVALS		DESIGN DATA	
12	AS-BUILT W.D. #0972	MWB	MWB	HWD	05/01/15	CONDUCTOR: 954 ACSS/TW/07	
11	SWAPPED STRUCTURE #301 WITH #84 (145) IN SEG 7. SEE STRUCTURE LOCATION MATRIX REV 11 FOR DETAILS.	MWB	MWB	HWD	07/25/14	SHIELD WIRE: 3/8 EHS / DNO-8959 OPGW	
10	MOVED STRUCTURE 043 WEST. SEE 0972 BROOKINGS-LYON STRUCTURE LOCATION MATRIX REV 10 FOR DETAILS.	MWB	MWB	HWD	06/26/14	DESIGN BY: MWB	05/01/15
9	UPDATED STRUCTURE NOTES	MWB	MWB	HWD	02/04/14	CHECKED BY: HWD	05/01/15
8	VARIOUS STAKING REVISIONS. SEE 0972 BROOKINGS-LYON STRUCTURE MATRIX REV 8 FOR DETAILS.	MWB	MWB	HWD	12/13/13	APPROVED BY: LDK	05/01/15
REV	DESCRIPTION	DWN	DGN	CHK	DATE		

GREAT RIVER ENERGY™

BROOKINGS - LYON COUNTY
345 KV DOUBLE CIRCUIT TRANSMISSION LINE

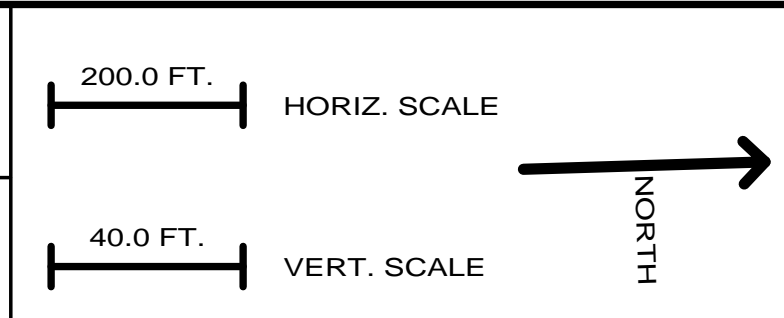

DWG. NO.
0972-91D

REVISION: 12

SHEET 11 OF 60