

NOTE: REFER TO THE STRUCTURE LIST FOR DETAILED DESIGN INFORMATION.



FILED UNDER: XXXXX



REVISIONS				APPROVALS		DATE	DESIGN DATA
12	AS-BUILT W.O. #0972	MWB	MWB	HWD	05/01/15	05/01/15	CONDUCTOR: 954 ACSS/TW 20/7
11	RELINE MARKUPS INCORPORATED	MWB	MWB	HWD	07/25/14	05/01/15	SHIELD WIRE: 3/8 EHS / DNO-8959 OPGW
10	SWAPPED STRUCTURE #001 WITH #04 (145') IN SEG 7. SEE STRUCTURE LOCATION MATRIX REV 11 FOR DETAILS	MWB	MWB	HWD	06/26/14	05/01/15	
9	MOVED STRUCTURE 043 WEST. SEE 0972 BROOKINGS-LYON STRUCTURE LOCATION MATRIX REV 10 FOR DETAILS.	MWB	MWB	HWD	02/04/14	05/01/15	
8	UPDATED STRUCTURE NOTES	MWB	MWB	HWD	12/13/13	05/01/15	
7	VARIOUS STAKING REVISIONS. SEE 0972 BROOKINGS-LYON STRUCTURE MATRIX REV 8 FOR DETAILS.	MWB	MWB	HWD	12/13/13	05/01/15	
REV	DESCRIPTION	DWN	DGN	CHK	DATE	DATE	

GREAT RIVER ENERGY

BROOKINGS - LYON COUNTY
345 KV DOUBLE CIRCUIT TRANSMISSION LINE

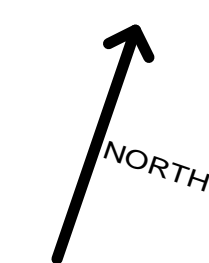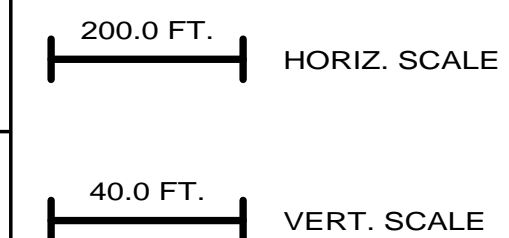

DWG. NO.
0972-91D
REVISION: 12
SHEET 3 OF 60