


ATTACHMENT A
PUBLIC

Reference

NAD 1983 StatePlane South Dakota North FIPS 4001 Feet

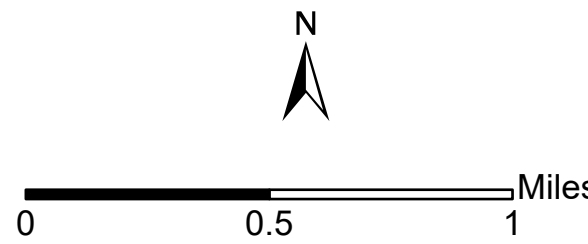

Legend


- Turbine AsBuilt**
-
- Tower**
- ADLS Tower
 - ▲ Permanent Met
- Access Roads AsBuilt**
-
- ADLS Fiber AsBuilt**
-
- Collection Line AsBuilt rev1**
-
- OHTL AsBuilt**
-
- O&M Building**
-
- POI**
-
- Project Substation**
-
- Project Parcel**
- Participant
 - Cooperation Agreement
- County Boundary**
-

Project Location



Dakota Range III Wind Project
As-Built Map


7/27/2021

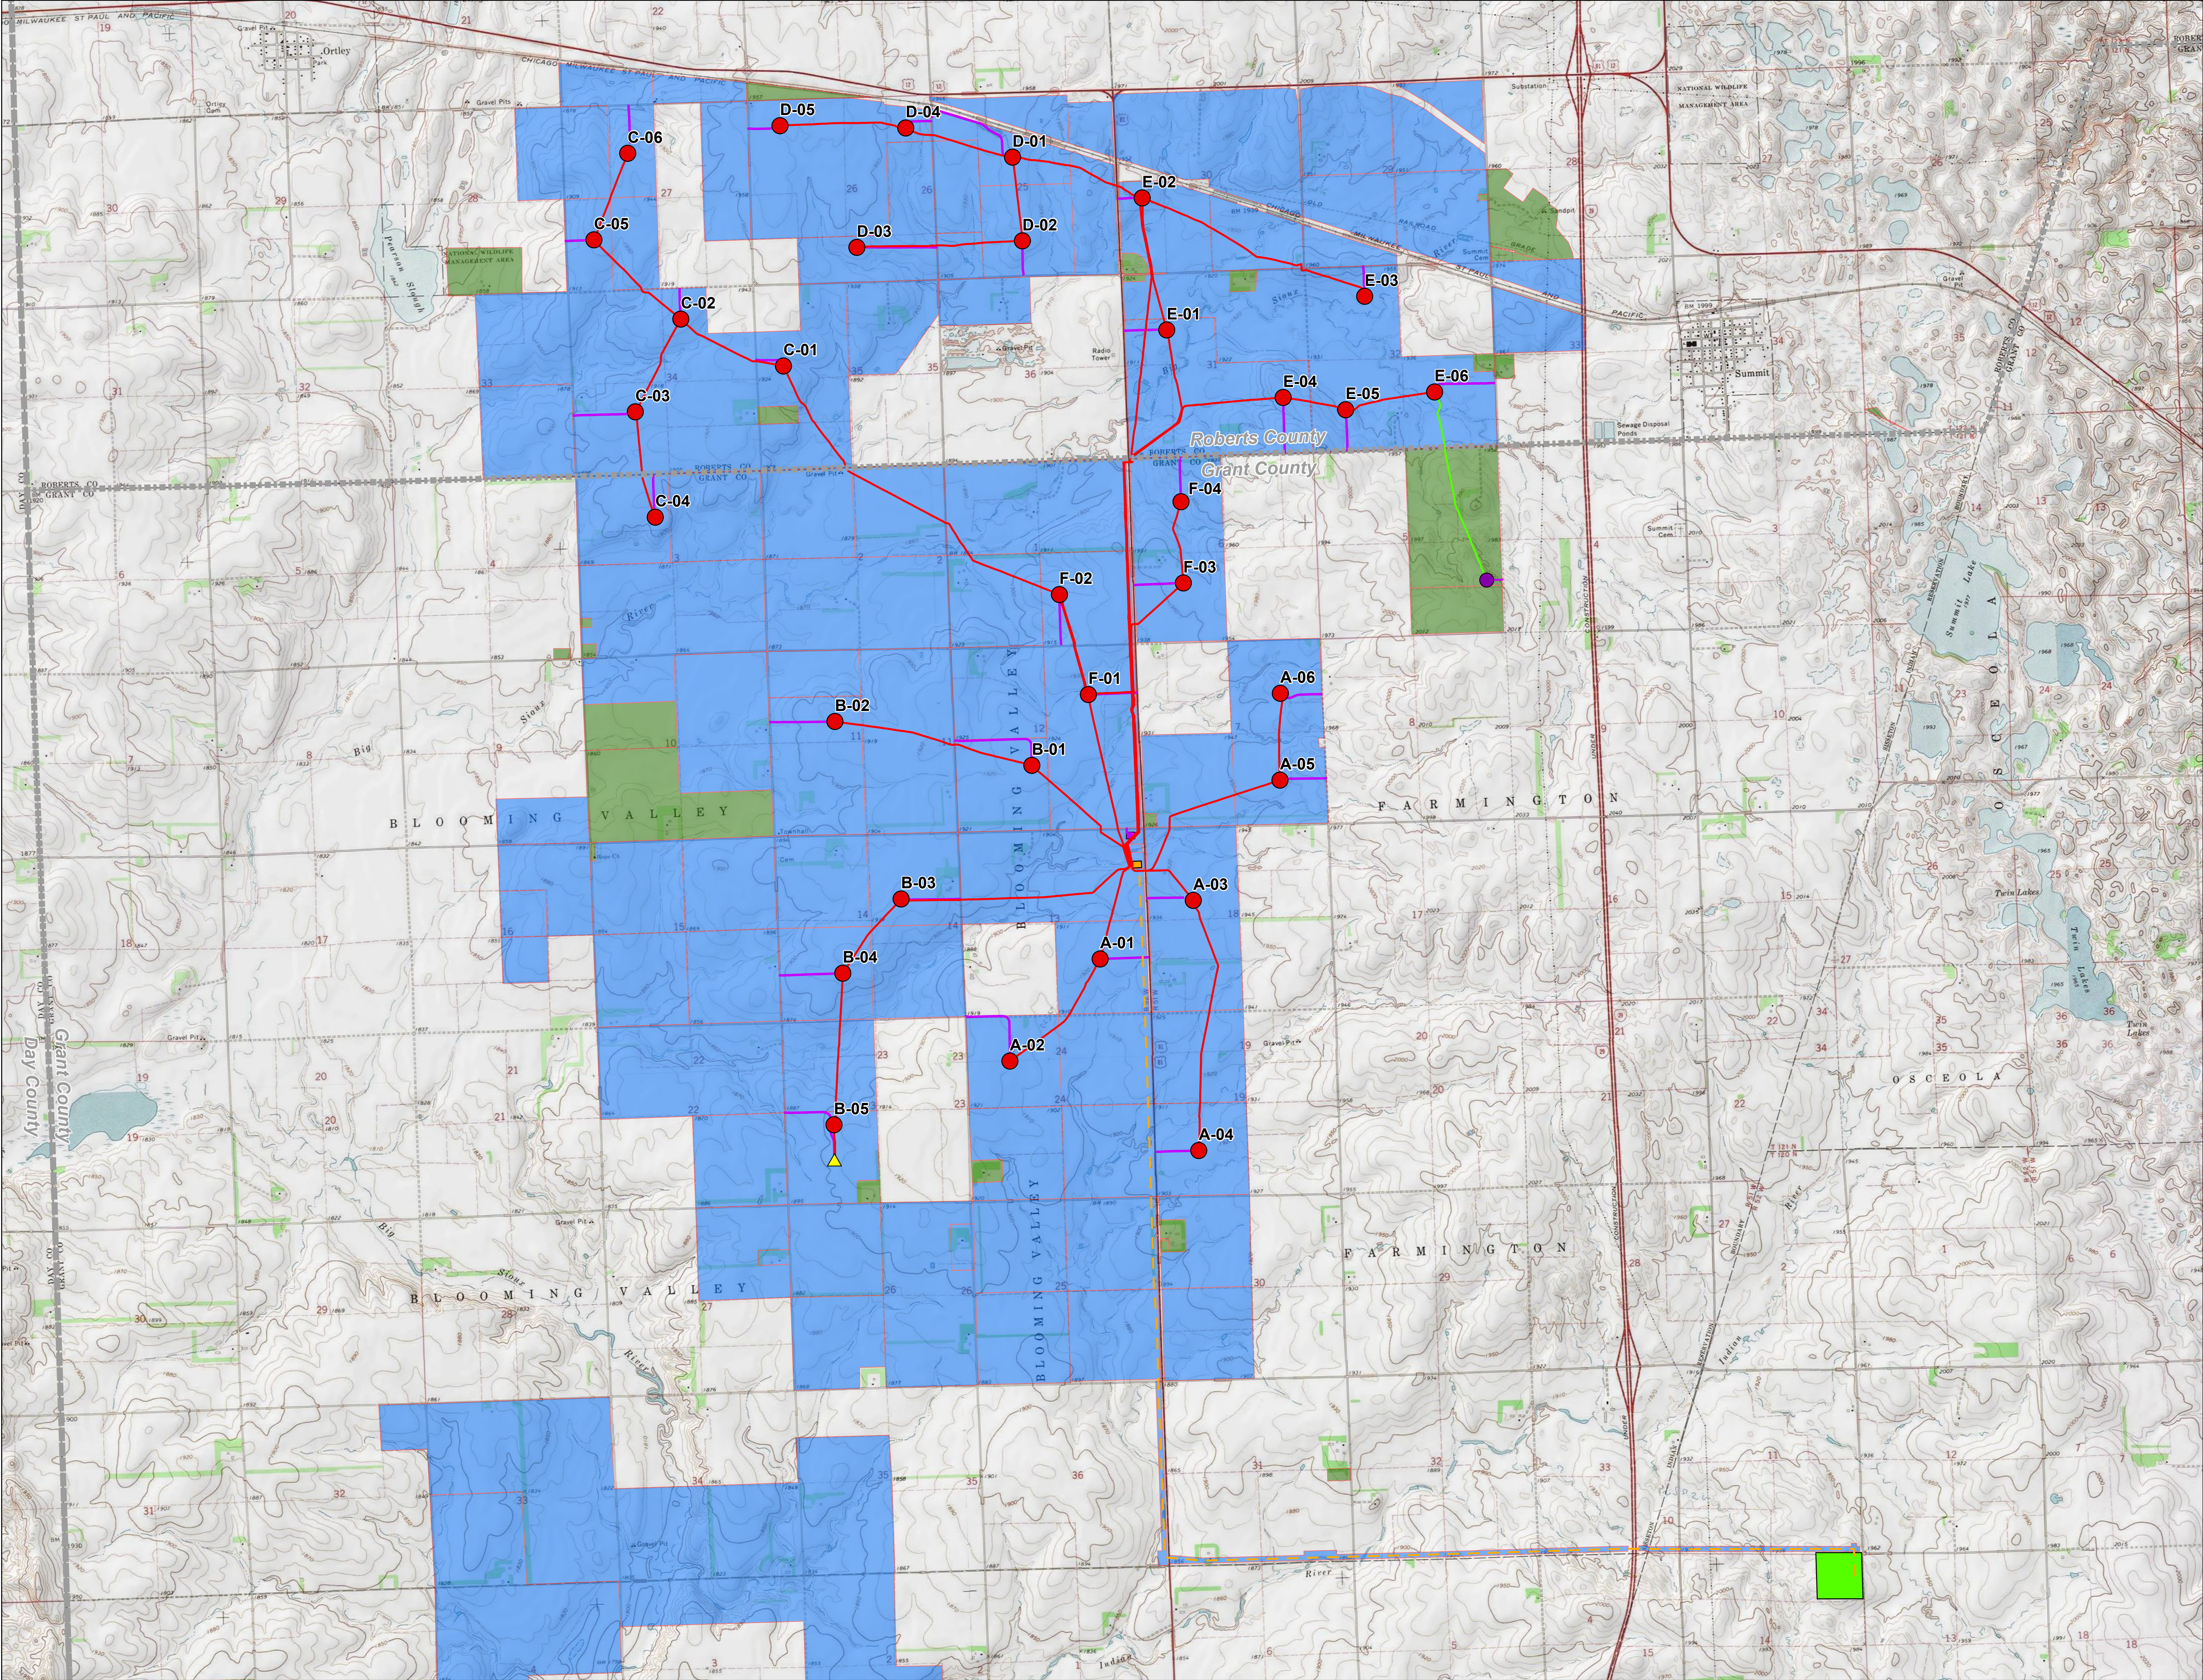

ATTACHMENT A
PUBLIC

Reference


NAD 1983 StatePlane South Dakota North FIPS 4001 Feet

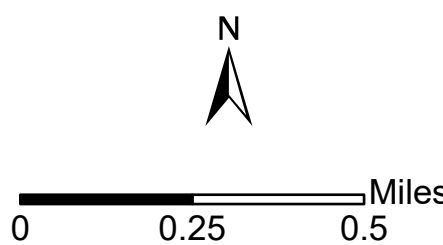

Legend


- Turbine AsBuilt
- Occupied Structure
- Roberts County Structure Setback
- Grant County Nonparticipant Structure Setback
- Grant County Participant Structure Setback
- County Boundary
- Project Parcel
- Participant
- Cooperation Agreement

Project Location

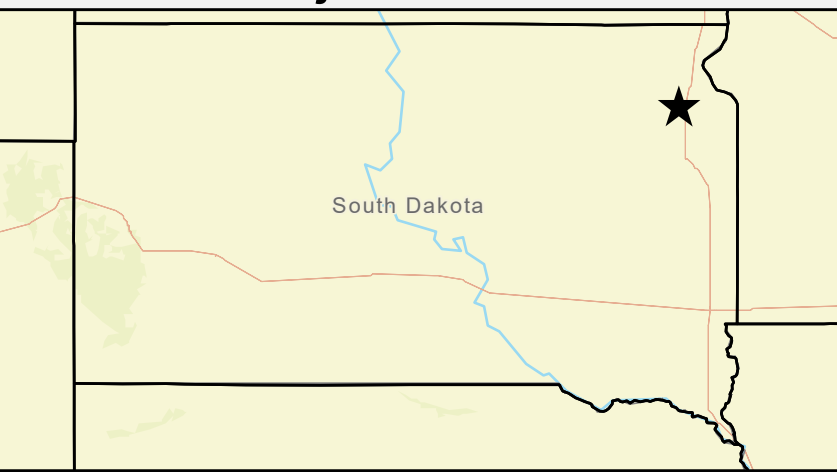

Dakota Range III Wind Project
As-Built Setback Map
Occupied Structures


7/27/2021

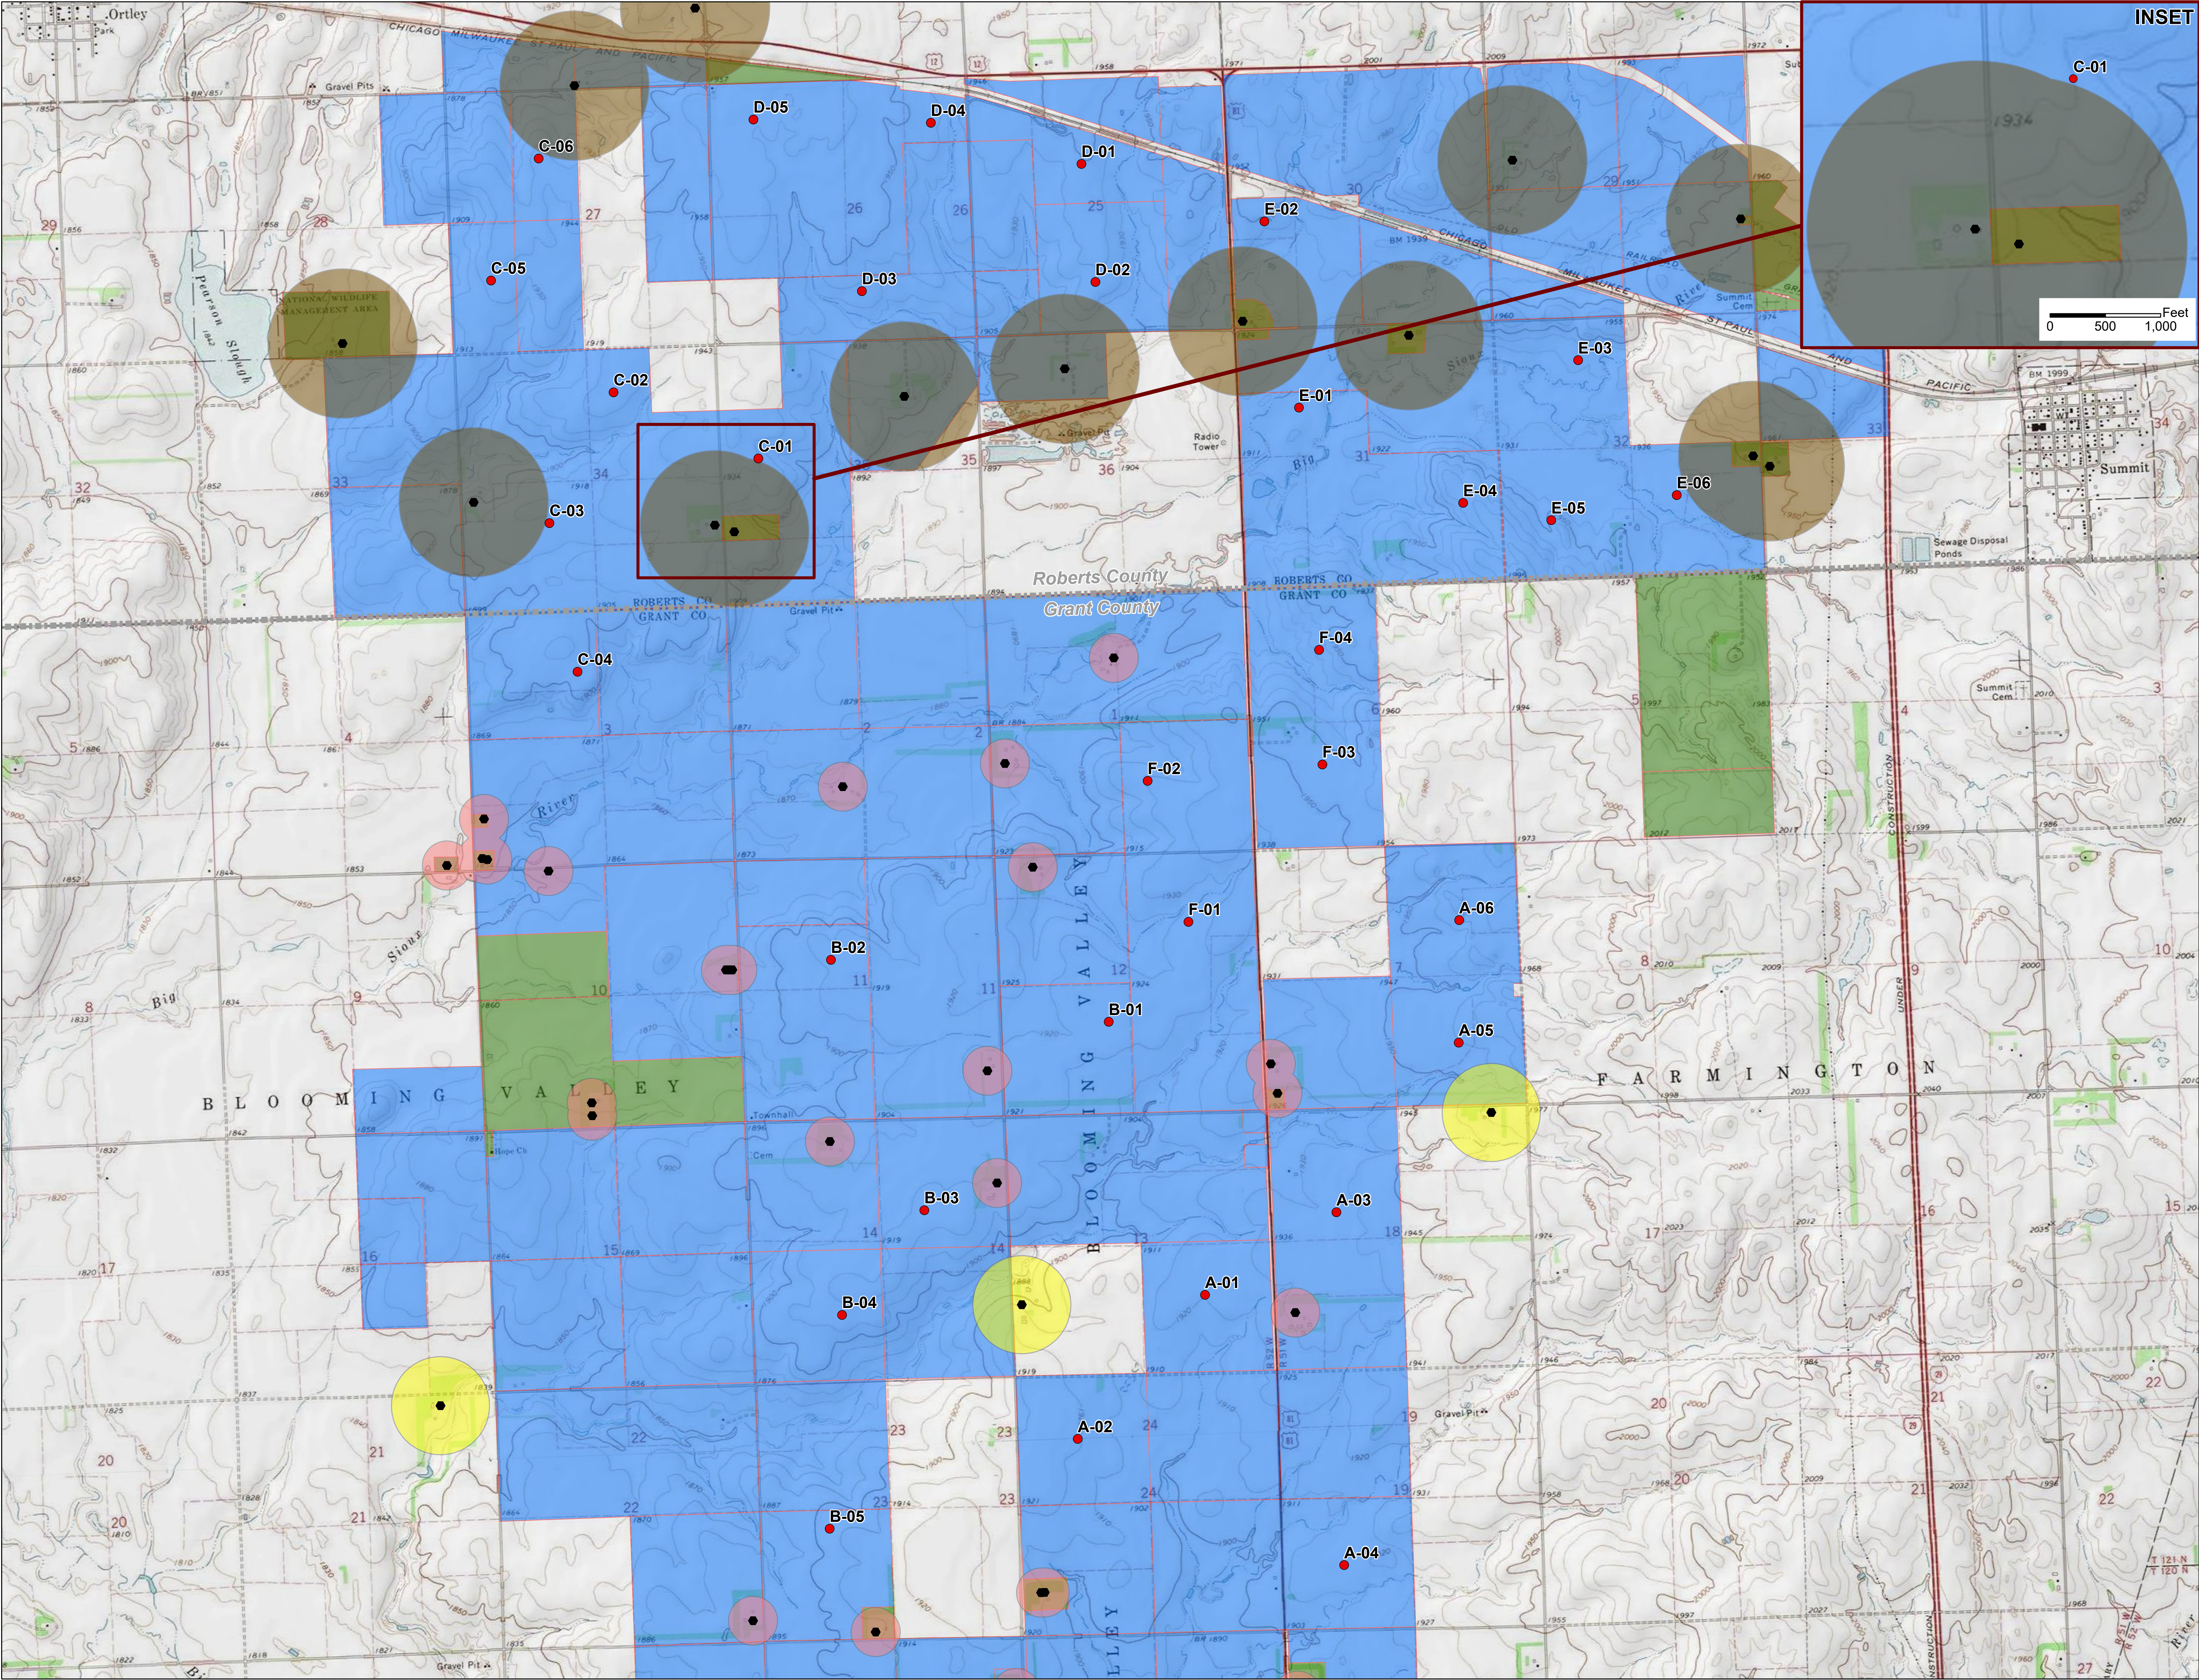

ATTACHMENT A
PUBLIC

Reference


NAD 1983 StatePlane South Dakota North FIPS 4001 Feet

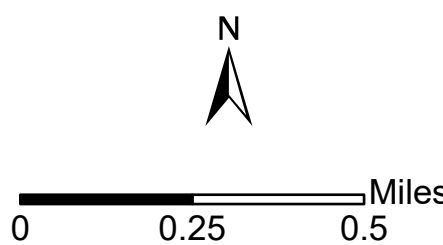

Legend


- Turbine AsBuilt**
-
- Nonparticipating Property Line Setback**
- 1.1 x Tip Height = 658.7ft
- County Boundary**
- Roberts County
 - Grant County
- Project Parcel**
- Participant
 - Cooperation Agreement

Project Location

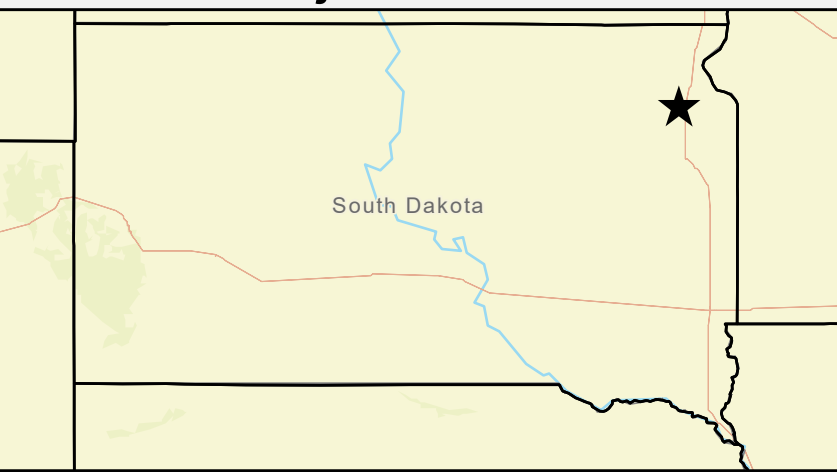

Dakota Range III Wind Project
As-Built Setback Map
Property Lines


7/27/2021

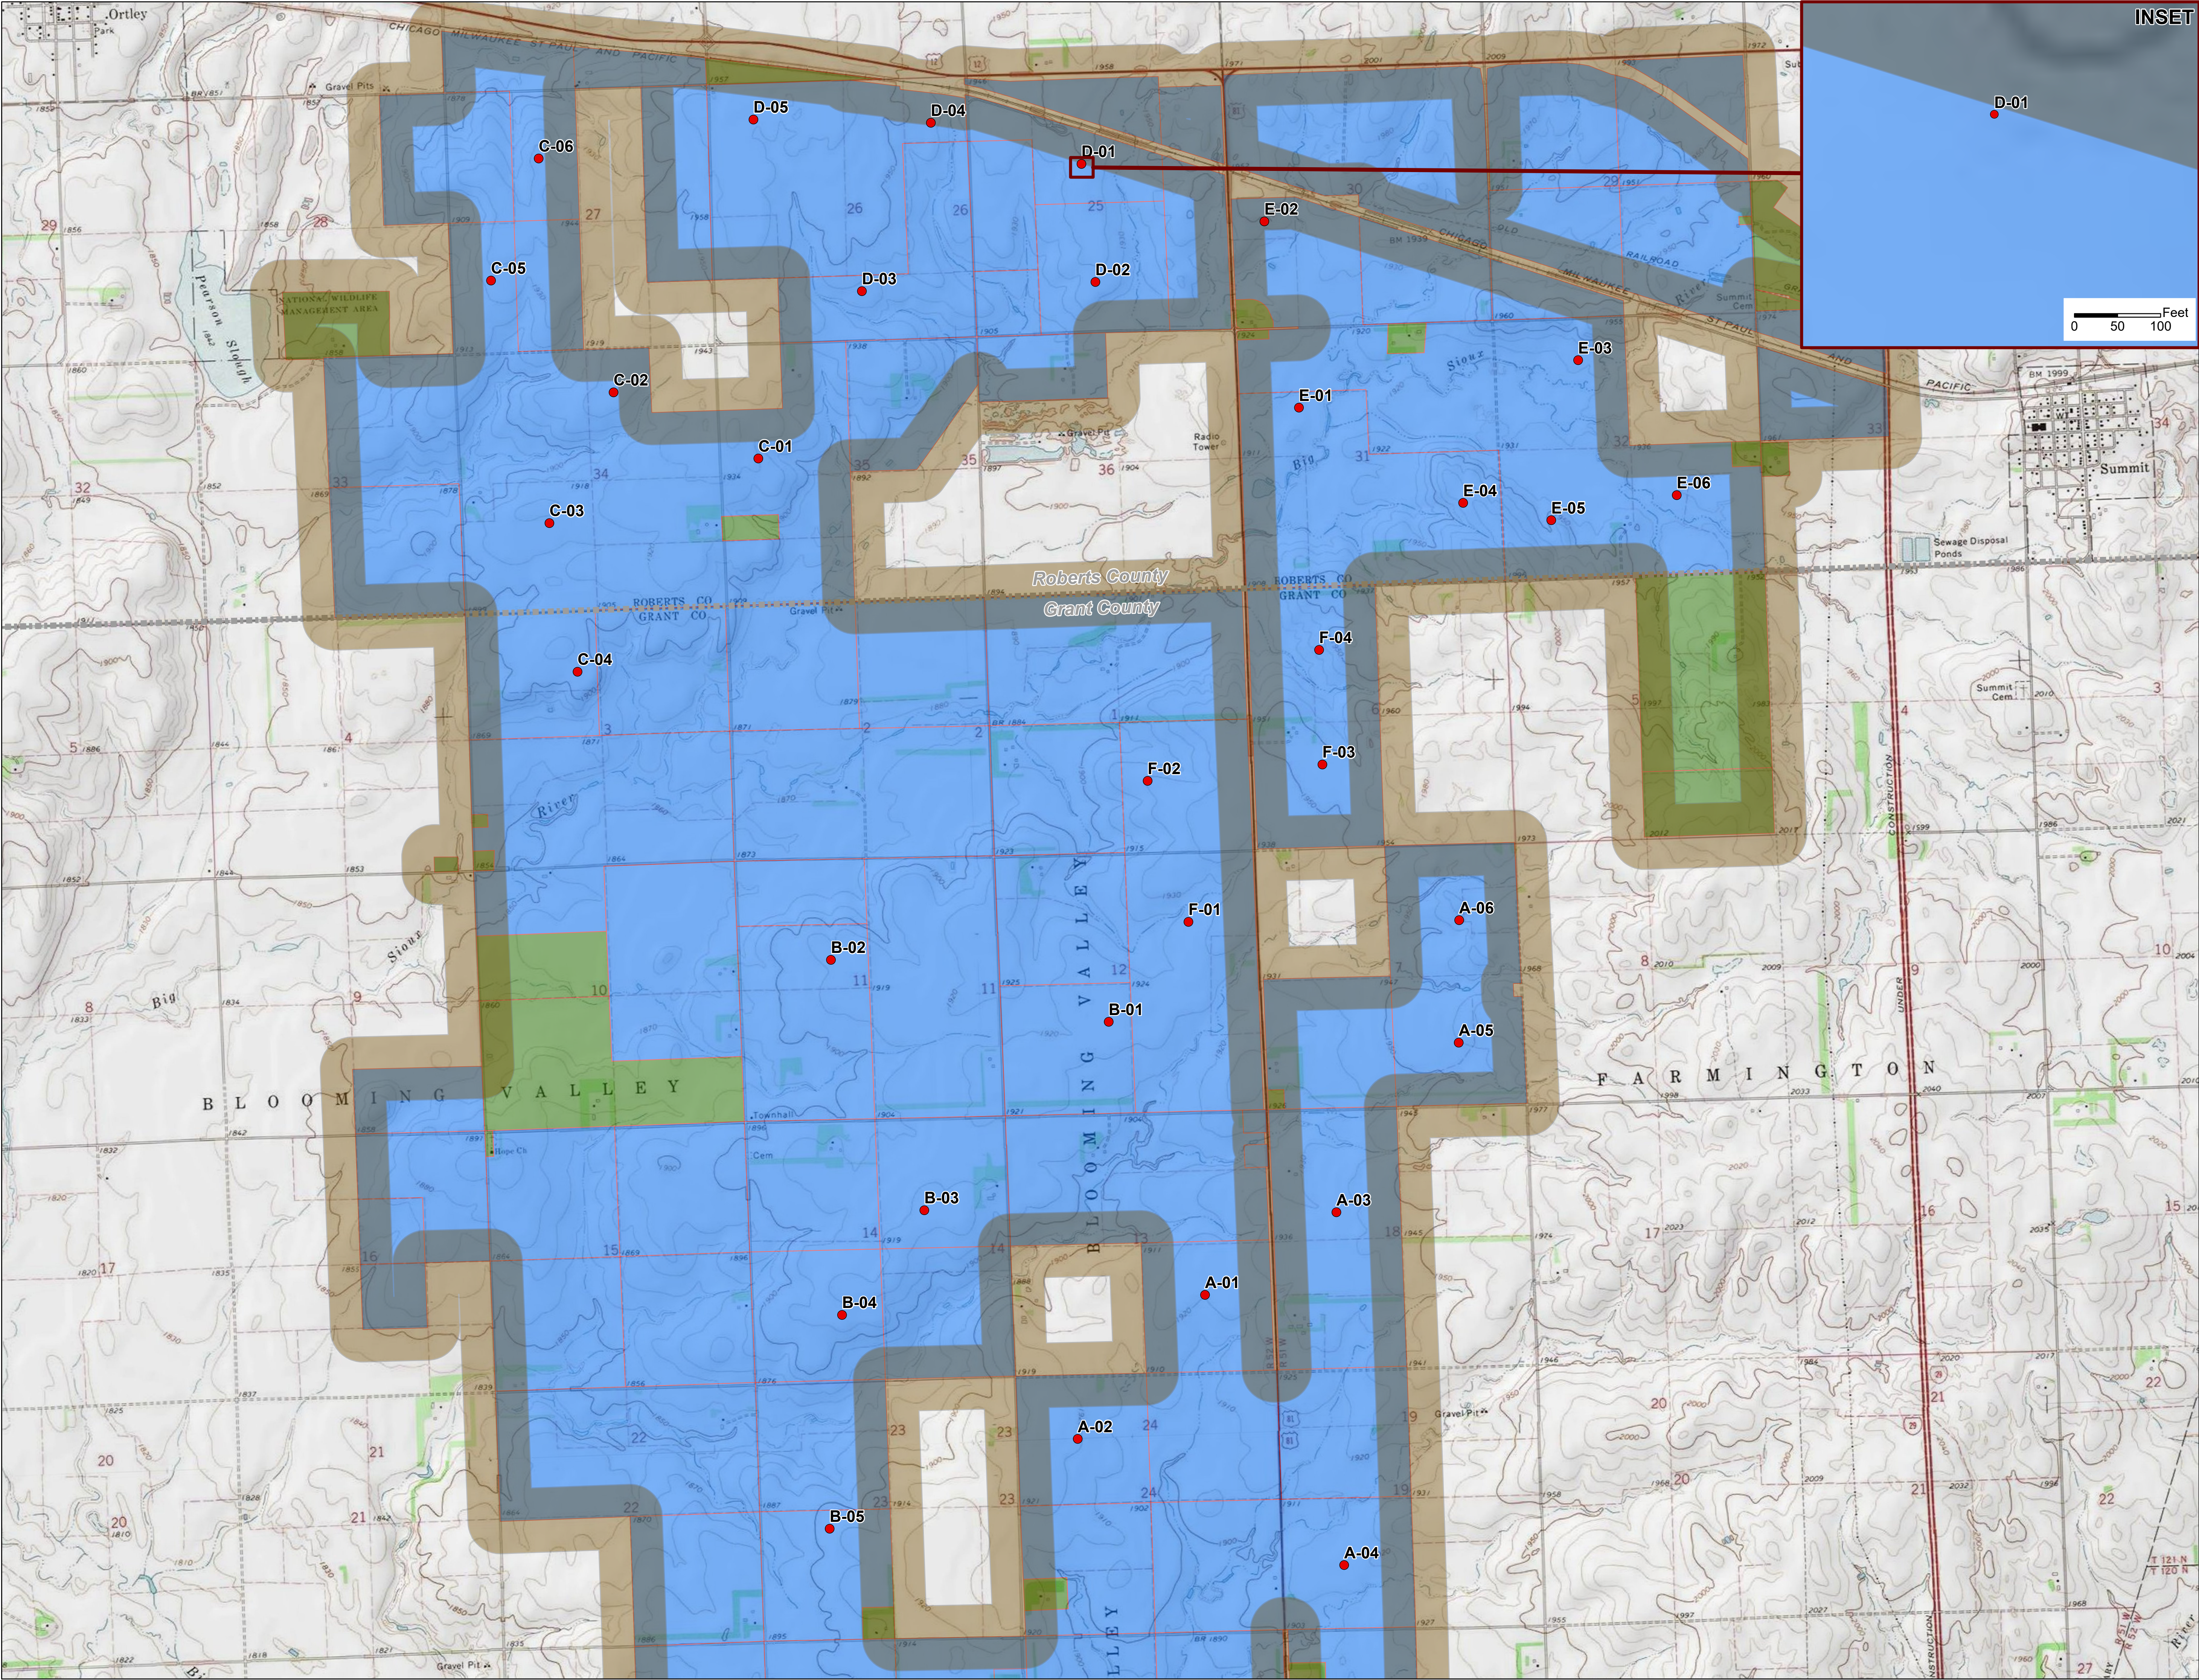

ATTACHMENT A
PUBLIC

Reference

NAD 1983 StatePlane South Dakota North FIPS 4001 Feet

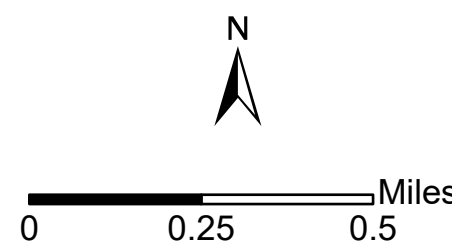

Legend

- Turbine AsBuilt**
-
- Public Road or Section Line**
-
- Public Road Setback**
- 1.1 x Tip Height = 658.7ft
- Project Parcel**
- Participant
 - Cooperation Agreement
- County Boundary**
-

Project Location



Dakota Range III Wind Project
As-Built Setback Map
Public Roads

7/27/2021

