
















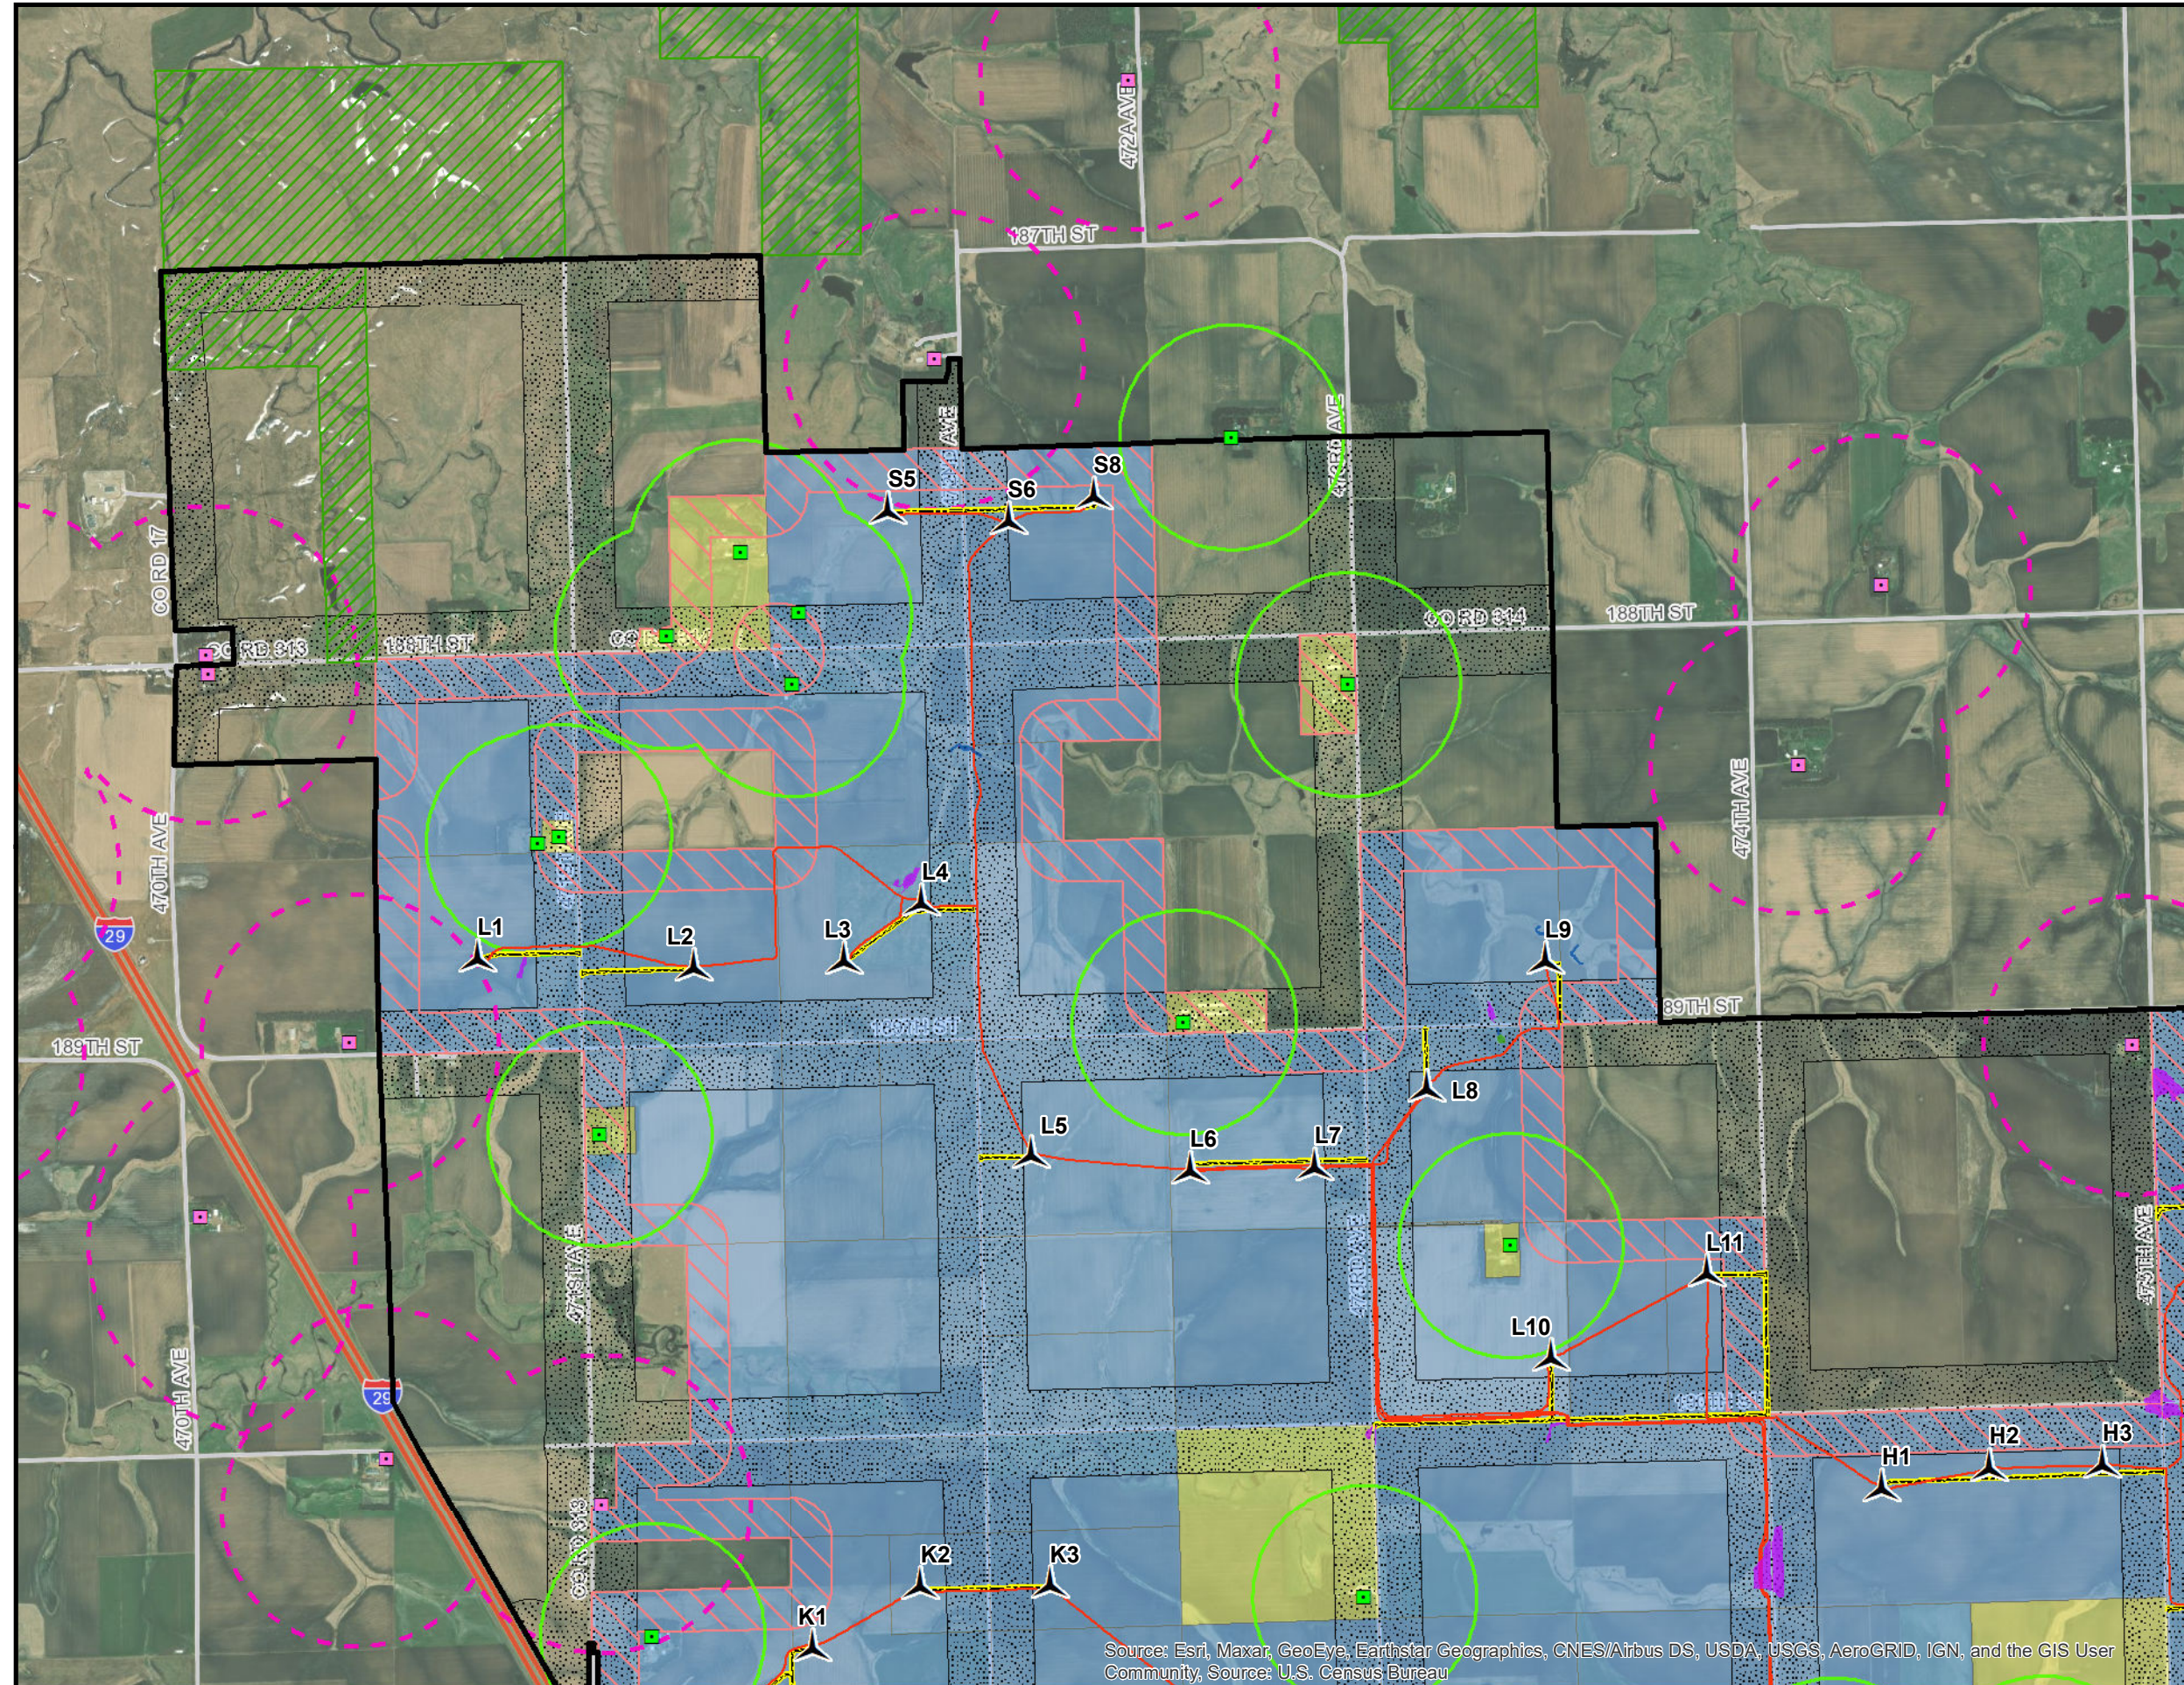
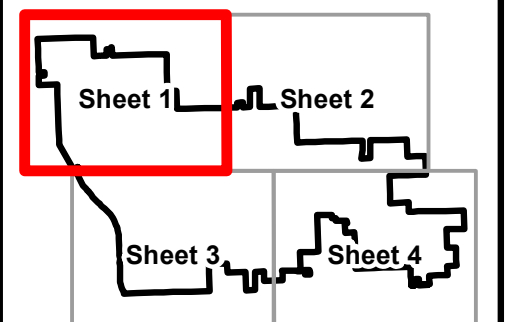
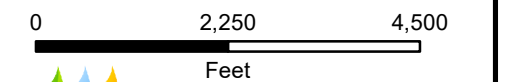


# As-Built Project Facilities Map Tatanka Wind Project Deuel County, SD




 










## Legend




-  Turbine
  -  Non-Participating Residence
  -  Participating Residence
  -  Underground Collection Line
  -  New Road (Permanent, edge of road)
  -  Site Boundary
  -  Grassland Easement
  -  Delineated Pond
  -  Delineated Stream Channel
  -  Delineated Wetland
- Setbacks**
-  Participating Residence Setback = 1,500 ft
  -  Non-Participating Residence Setback (4\*TH) = 1,996 ft
  -  Public Road Setback (1.1 TH) = 549 ft
  -  Non-participating Property Setback (1.1 TH) = 549 ft
- Site Control**
-  Signed by Landowner, Easement: Electrical (No Turbines)
  -  Signed by Landowner, Lease
  -  Signed by Landowner, Setback Waiver / GNA



# As-Built Project Facilities Map Tatanka Wind Project Deuel County, SD

## Legend



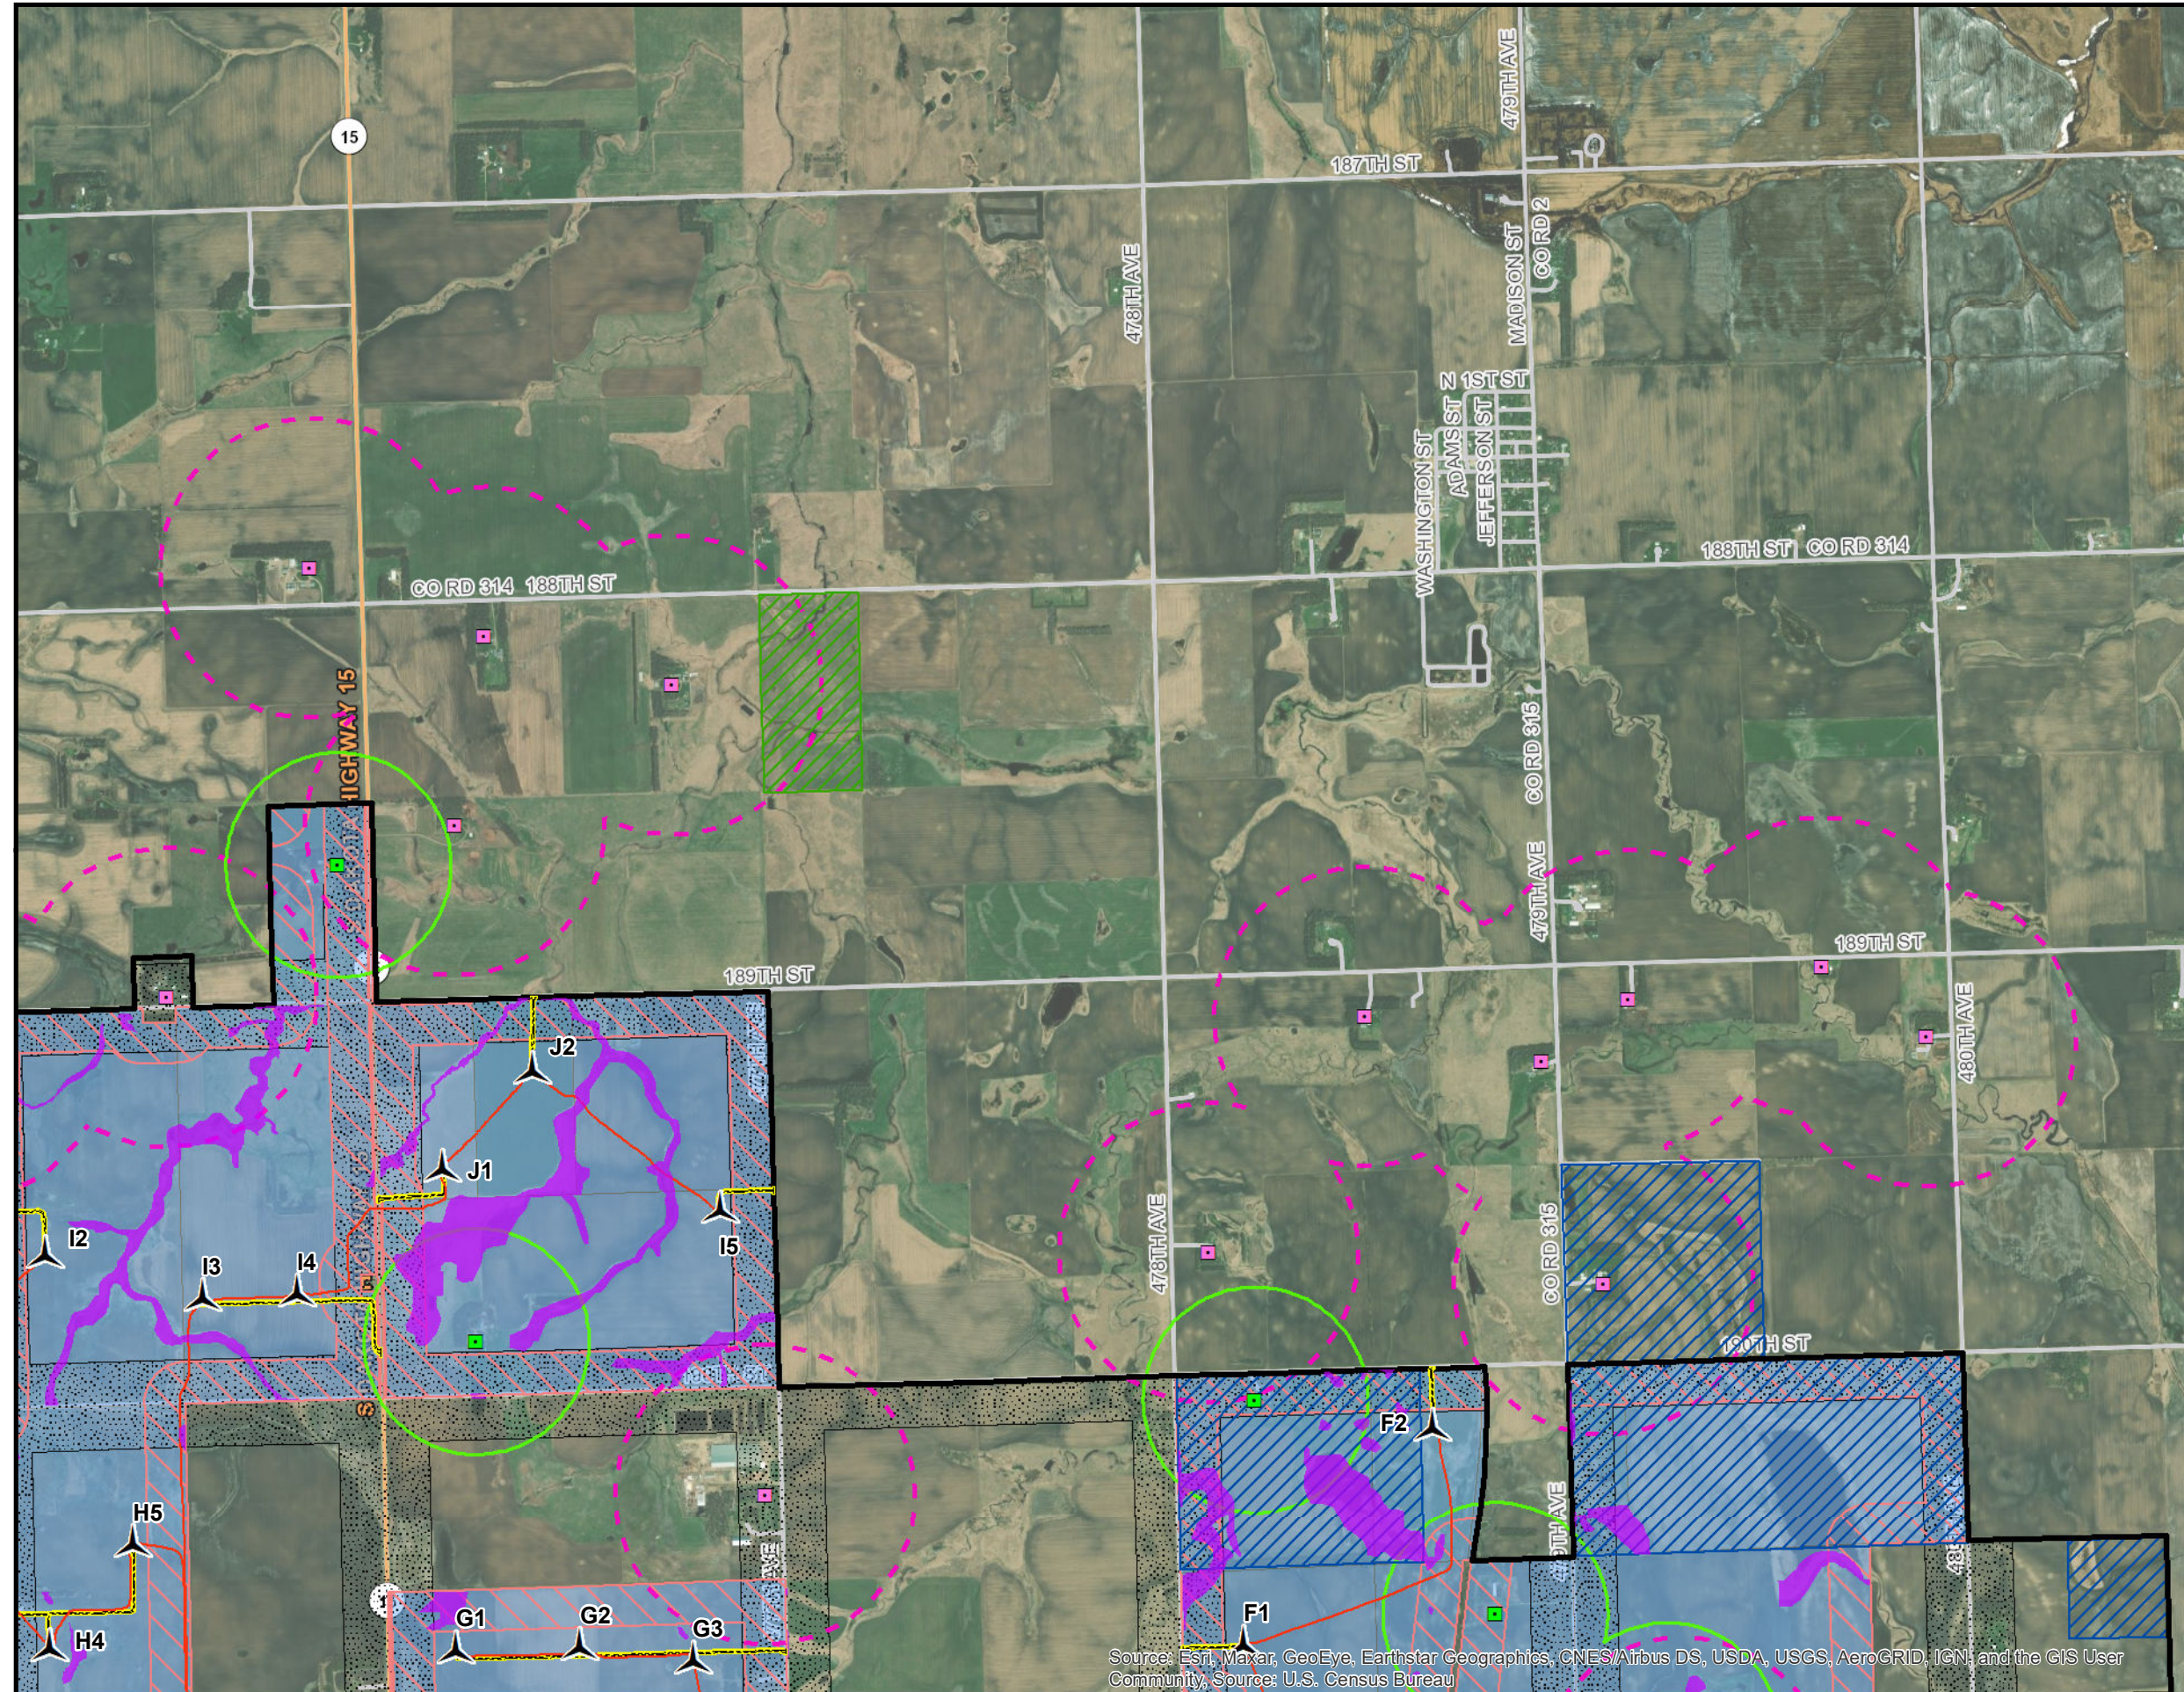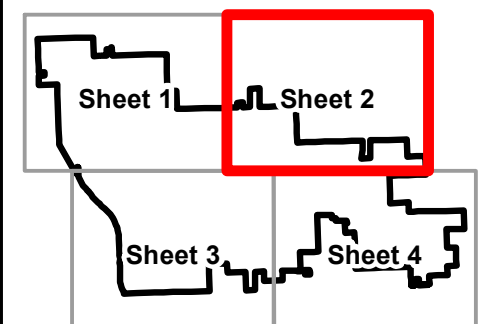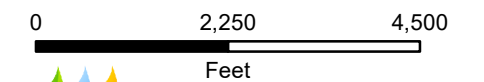













-  Turbine
-  Non-Participating Residence
-  Participating Residence
-  Underground Collection Line
-  New Road (Permanent, edge of road)
-  Site Boundary
-  Grassland Easement
-  Wetland Easement
-  Delineated Wetland
- Setbacks**
-  Participating Residence Setback = 1,500 ft
-  Non-Participating Residence Setback (4\*TH) = 1,996 ft
-  Public Road Setback (1.1 TH) = 549 ft
-  Non-participating Property Setback (1.1 TH) = 549 ft
- Site Control**
-  Signed by Landowner, Lease






Source: Esri, Maxar, GeoEye, Earthstar Geographics, CNES/Airbus DS, USDA, USGS, AeroGRID, IGN, and the GIS User Community, Source: U.S. Census Bureau

# As-Built Project Facilities Map Tatanka Wind Project Deuel County, SD

## Legend

-  Turbine
  -  Permanent Met Tower
  -  Non-Participating Residence
  -  Participating Residence
  -  Underground Collection Line
  -  New Road (Permanent, edge of road)
  -  Site Boundary
  -  Delineated Wetland
- ### Setbacks
-  Participating Residence Setback = 1,500 ft
  -  Non-Participating Residence Setback (4\*TH) = 1,996 ft
  -  Public Road Setback (1.1 TH) = 549 ft
  -  Non-participating Property Setback (1.1 TH) = 549 ft
  -  Toronto Municipal Setback = 1.5 mi
- ### Site Control
-  Signed by Landowner, Easement: Electrical (No Turbines)
  -  Signed by Landowner, Lease
  -  Signed by Landowner, Setback Waiver / GNA

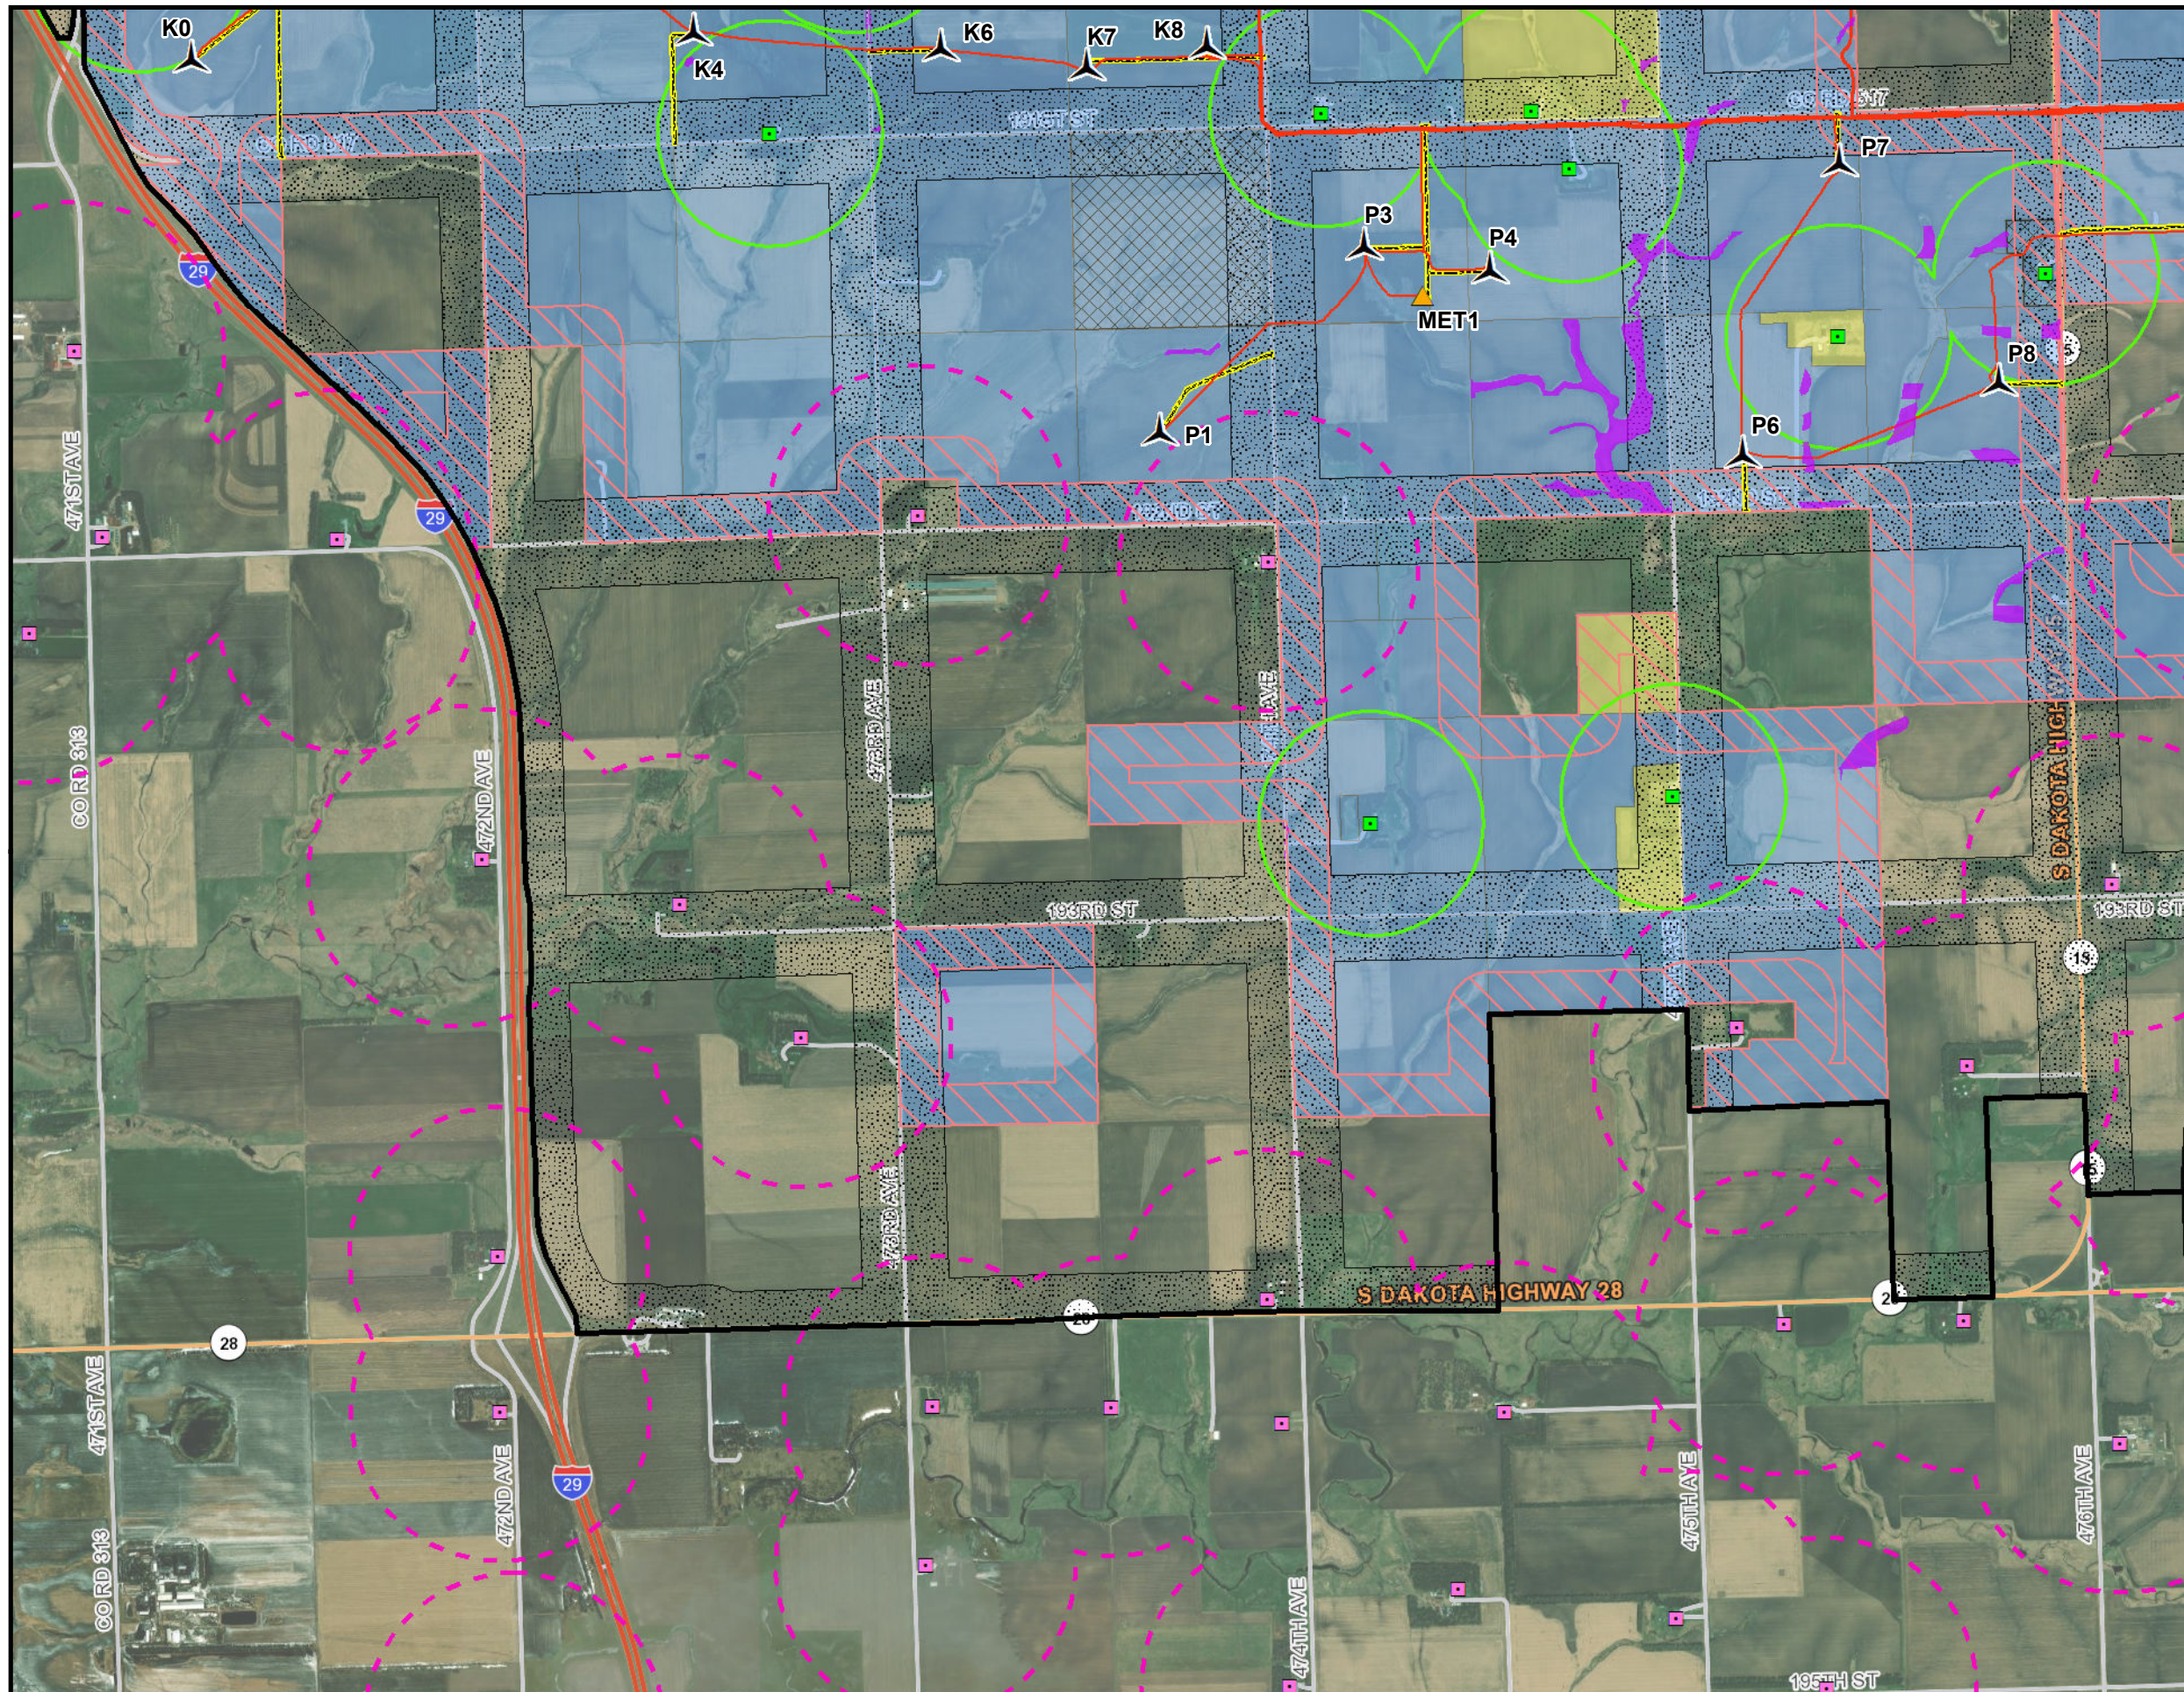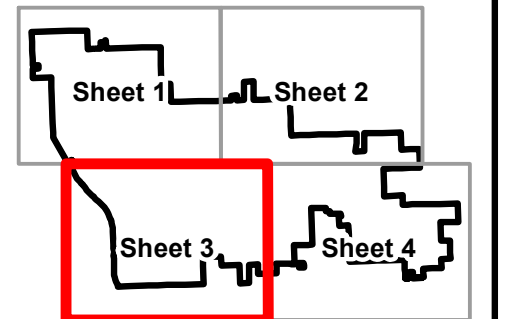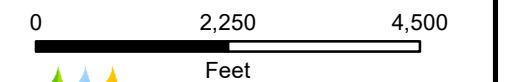

# As-Built Project Facilities Map

## Tatanka Wind Project

Deuel County, SD

### Legend

- Turbine
  - Non-Participating Residence
  - Participating Residence
  - ADLS Tower
  - Tie Line
  - Underground Collection Line
  - New Road (Permanent, edge of road)
  - O&M Facility
  - Substation
  - Site Boundary
  - Public Land Easement
  - Grassland Easement
  - Wetland Easement
  - Delineated Wetland
- ### Setbacks
- Participating Residence Setback = 1,500 ft
  - Non-Participating Residence Setback (4\*TH) = 1,996 ft
  - Public Road Setback (1.1 TH) = 549 ft
  - Non-participating Property Setback (1.1 TH) = 549 ft
  - Toronto Municipal Setback = 1.5 mi
- ### Site Control
- Pending Purchase Option
  - Signed by Landowner, Easement: Electrical (No Turbines)
  - Signed by Landowner, Lease
  - Signed by Landowner, Setback Waiver / GNA

