

Crowned Ridge II Wind Farm

Codington, Deuel, Grant Counties, South Dakota

Record Civil Plans

REGIONAL MAP



VICINITY MAP



**RECORD CIVIL PLANS**  
CONFORMING TO CONSTRUCTION RECORDS PROVIDED  
BY BLATTNER AND FIELD SURVEY, PROVIDED BY BLATTNER,  
COMPLETED OCTOBER 2020. PLANS DO NOT INCLUDE COLLECTION.

DATA SET INFORMATION			
BASE FILE	FILE NAME / NOTES	PROVIDER	DATE
AERIAL IMAGE	AERIAL.jp2	Public	3/25/2020
LAND CONTROL	CROWNED RIDGE WIND II LLC - 200MW TURBINE SITE PLAN ISSUED 02-05-2020.KMZ	Blattner	3/26/2020
ALTA SURVEY	*	*	*
TOPOGRAPHY	2020-03-23 Data Gateway (1 Meter)	Blattner	3/23/2020
TURBINE ARRAY	Crowned Ridge II Road & Turbine As Built.dwg	Blattner	10/15/2020
UNDERGROUND COLLECTION	CROWNED RIDGE WIND II LLC - 200MW TURBINE SITE PLAN ISSUED 04-06-2020	Blattner	5/8/2020
GEN-TIE	CROWNED RIDGE WIND II LLC - 200MW TURBINE SITE PLAN ISSUED 02-05-2020.KMZ	Blattner	2/26/2020
STREAMS/WETLANDS	CROWNED RIDGE WIND II LLC - 200MW TURBINE SITE PLAN ISSUED 04-06-2020	Blattner	5/8/2020
CULTURAL RESOURCES	CROWNED RIDGE WIND II LLC - 200MW TURBINE SITE PLAN ISSUED 04-06-2020	Blattner	5/8/2020
FEMA INFO	S_WTR_LN.shp	Blattner	3/24/2020

CONTACT INFORMATION			
PROJECT ROLE	CONTACT NAME	COMPANY	PHONE
PROJECT MANAGER	ALEX ALVARADO	WESTWOOD	(214) 473-4648
ENGINEER OF RECORD	ROB COPOULS	WESTWOOD	(952) 906-7470
CONTRACTOR	JASON ZIERDEN	BLATTNER	

**Westwood**


Phone (214) 473-4640 2740 Dallas Parkway, Suite 280  
Toll Free (888) 937-5150 Plano, TX 75093  
westwoodps.com  
Westwood Professional Services, Inc.

PREPARED FOR:

**BLATTNER**  
**ENERGY**


392 COUNTY RD 50  
AVON, MN 56310

ISSUE FOR RECORD


NO		REVISION		ZONE	DATE	BY	CHK	ENG	NO	REVISION		ZONE	DATE	BY	CHK	ENG	REFERENCE DRAWINGS			<div><div><div>NORTHERN STATES POWER COMPANY CROWNED RIDGE II WIND FARM CODINGTON, DEUEL, GRANT COUNTIES, SOUTH DAKOTA</div></div><div><div>DWN: MDR</div><div>ENG: MDR</div><div>PM: AA</div><div>APVD:</div></div><div><div>DATE: 11/12/2020</div><div>DATE: 11/12/2020</div><div>DATE: 11/12/2020</div><div>DATE:</div></div><div><div>CHK: AA</div><div>CHK:</div><div>SCALE: NONE</div></div><div><div>DATE: 11/12/2020</div><div>DATE:</div><div>PROJ. NO: 22590</div></div></div> <div>THIS MAP/DOCUMENT IS A TOOL TO ASSIST EMPLOYEES IN THE PERFORMANCE OF THEIR JOBS. YOUR PERSONAL SAFETY IS PROVIDED FOR BY USING SAFETY PRACTICES, PROCEDURES, AND EQUIPMENT AS DESCRIBED IN THE SAFETY TRAINING PROGRAMS AND MANUALS.</div> <div>ENERGY SUPPLY ENGINEERING &amp; CONSTRUCTION</div>				UNIT 0 CIVIL ACCESS ROADS		COVER		NH-275900-1-1		REV 1
																	DWG NO.	MANUFACTURER	DESCRIPTION											
0		ISSUED FOR CONSTRUCTION			5/29/2020	MDR	AA	MDR																						
1		ISSUED FOR RECORD - CROWNED RIDGE 22590			11/12/2020	MDR	AA	MDR																						



Sheet Number	Sheet Title
NH-275900-8-20	Civil Site Plan T-56
NH-275900-8-21	Civil Site Plan T-50, T-51, T-54, T-55
NH-275900-8-22	Civil Site Plan T-49, T-53
NH-275900-8-23	Civil Site Plan T-28, T-43
NH-275900-8-24	Civil Site Plan T-42, T-57
NH-275900-8-25	Civil Site Plan 1
NH-275900-8-26	Civil Site Plan T-39
NH-275900-8-27	Civil Site Plan T-36, T-37
NH-275900-8-28	Civil Site Plan T-34, T-35
NH-275900-8-29	Civil Site Plan T-38, T-40
NH-275900-8-30	Civil Site Plan T-41
NH-275900-8-31	Civil Site Plan T-58
NH-275900-8-32	Civil Site Plan T-59, T-60, T-61
NH-275900-8-33	Civil Site Plan T-68
NH-275900-8-34	Civil Site Plan T-66, T-67, T-70
NH-275900-8-35	Civil Site Plan T-64, T-65
NH-275900-8-36	Civil Site Plan T-62, T-63
NH-275900-8-37	Civil Site Plan T-76, T-77
NH-275900-8-38	Civil Site Plan T-69, T-78
NH-275900-8-39	Civil Site Plan T-71, T-72, T-81
NH-275900-8-40	Civil Site Plan T-73, T-74, T-75
NH-275900-8-41	Civil Site Plan T-85
NH-275900-8-42	Civil Site Plan T-84, T-86, T-87, ADLS-2
NH-275900-8-43	Civil Site Plan T-79, T-80, T-83, MET-1
NH-275900-8-44	Civil Site Plan T-82
NH-275900-8-45	Civil Site Plan T-88
NH-275900-8-46	Civil Site Plan 2
NH-275900-8-47	Civil Site Plan 3
NH-275900-8-48	Civil Site Plan Substation
NH-275900-8-49	Civil Site Plan T-44 T-45

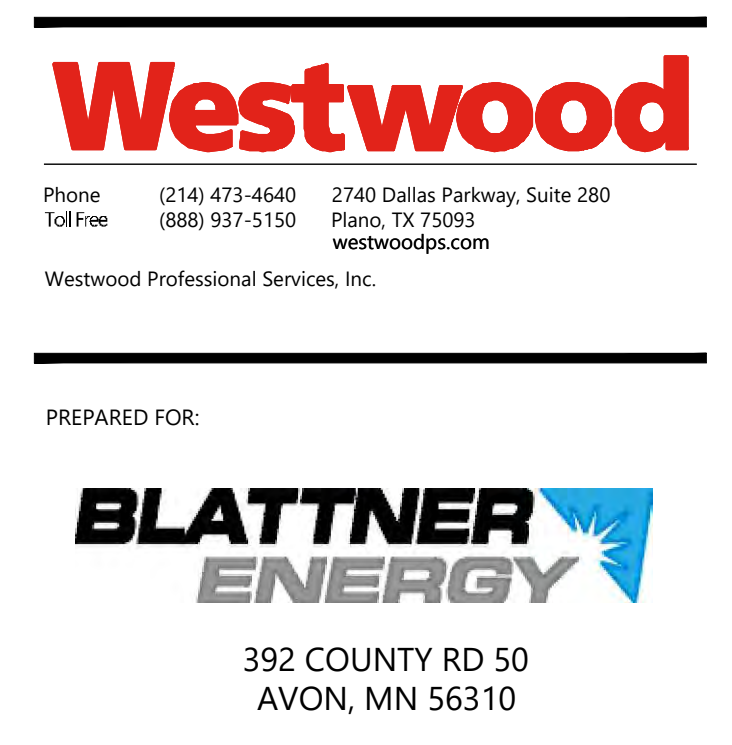

ISSUE FOR RECORD

NO	REVISION	ZONE	DATE	BY	CHK	ENG	NO	REVISION	ZONE	DATE	BY	CHK	ENG	REFERENCE DRAWINGS			<div><div><div>NORTHERN STATES POWER COMPANY CROWNED RIDGE II WIND FARM CODINGTON, DEUEL, GRANT COUNTIES, SOUTH DAKOTA</div></div><table><tr><td>DWN: MDR</td><td>DATE: 11/12/2020</td><td>CHK: AA</td><td>DATE: 11/12/2020</td></tr><tr><td>ENG: MDR</td><td>DATE: 11/12/2020</td><td>CHK:</td><td>DATE:</td></tr><tr><td>PM: AA</td><td>DATE: 11/12/2020</td><td colspan="2">PROJ. NO: 22590</td></tr><tr><td>APVD:</td><td>DATE:</td><td colspan="2">SCALE: NONE</td></tr></table></div> <div>THIS MAP/DOCUMENT IS A TOOL TO ASSIST EMPLOYEES IN THE PERFORMANCE OF THEIR JOBS. YOUR PERSONAL SAFETY IS PROVIDED FOR BY USING SAFETY PRACTICES, PROCEDURES, AND EQUIPMENT AS DESCRIBED IN THE SAFETY TRAINING PROGRAMS AND MANUALS.</div>	DWN: MDR	DATE: 11/12/2020	CHK: AA	DATE: 11/12/2020	ENG: MDR	DATE: 11/12/2020	CHK:	DATE:	PM: AA	DATE: 11/12/2020	PROJ. NO: 22590		APVD:	DATE:	SCALE: NONE		UNIT 0 CIVIL ACCESS ROADS	
DWN: MDR	DATE: 11/12/2020	CHK: AA	DATE: 11/12/2020																																
ENG: MDR	DATE: 11/12/2020	CHK:	DATE:																																
PM: AA	DATE: 11/12/2020	PROJ. NO: 22590																																	
APVD:	DATE:	SCALE: NONE																																	
															SHEET LIST																				
															ENERGY SUPPLY ENGINEERING & CONSTRUCTION		NH-275900-1-2	REV 1																	



PERMANENT DRAINAGE CROSSING SCHEDULE

ENTRANCE CULVERT SCHEDULE

Crossing Number	50-Year LWC
DC-4	STANDARD DUTY
DC-6	STANDARD DUTY
DC-9	STANDARD DUTY
DC-10	STANDARD DUTY
DC-13	STANDARD DUTY
DC-14	STANDARD DUTY
DC-18	STANDARD DUTY
DC-20	STANDARD DUTY
DC-21	STANDARD DUTY
DC-24	STANDARD DUTY
DC-26	STANDARD DUTY
DC-27	STANDARD DUTY
DC-29	STANDARD DUTY
DC-32	STANDARD DUTY
DC-34	STANDARD DUTY
DC-37	STANDARD DUTY
DC-39	STANDARD DUTY
DC-41	STANDARD DUTY
DC-42	STANDARD DUTY
DC-43	STANDARD DUTY
DC-44	STANDARD DUTY
DC-45	STANDARD DUTY
DC-46	STANDARD DUTY
DC-48	STANDARD DUTY
DC-49	STANDARD DUTY
DC-50	STANDARD DUTY
DC-51	STANDARD DUTY
DC-52	STANDARD DUTY
DC-53	STANDARD DUTY
DC-55	STANDARD DUTY
DC-56	STANDARD DUTY
DC-57	STANDARD DUTY
DC-59	STANDARD DUTY
DC-60	STANDARD DUTY
DC-61	STANDARD DUTY
DC-63	STANDARD DUTY
DC-64	STANDARD DUTY
DC-65	STANDARD DUTY
DC-66	STANDARD DUTY
DC-70	STANDARD DUTY

Crossing Number	50-Year LWC
DC-71	STANDARD DUTY
DC-72	STANDARD DUTY
DC-73	STANDARD DUTY
DC-74	REFER TO RD11
DC-75	STANDARD DUTY
DC-76	REFER TO RD11
DC-77	STANDARD DUTY
DC-78	STANDARD DUTY
DC-79	STANDARD DUTY
DC-80	STANDARD DUTY
DC-81	STANDARD DUTY
DC-82	STANDARD DUTY
DC-83	STANDARD DUTY
DC-84	STANDARD DUTY
DC-85	STANDARD DUTY
DC-86	STANDARD DUTY
DC-87	STANDARD DUTY
DC-88	STANDARD DUTY
DC-89	STANDARD DUTY
DC-90	STANDARD DUTY
DC-91	STANDARD DUTY
DC-92	STANDARD DUTY
DC-93	STANDARD DUTY
DC-94	STANDARD DUTY
DC-95	STANDARD DUTY

Road #	Entrance Size
T-06	18" CMP
T-07	18" CMP
T-14	18" CMP
T-19	18" CMP
T-21	12" HDPE
T-26	18" CMP
T-29	18" CMP
T-31	18" CMP
T-32	40" RCP
T-39	18" CMP
T-42	18" CMP
T-43	18" CMP
T-44	18" CMP
T-48	18" CMP
T-51	18" CMP
T-52	24" CMP
T-56	18" CMP
T-57	18" CMP
T-57	18" CMP
T-66	18" CMP
BETWEEN T-70, T-66	18" CMP
T-74	18" CMP
T-77	18" CMP
T-80	18" CMP
T-81	18" CMP

Westwood

Phone (214) 473-4640 2740 Dallas Parkway, Suite 280  
TollFree (888) 937-5150 Plano, TX 75093  
westwoodps.com


Westwood Professional Services, Inc.

PREPARED FOR:

BLATTNER  
ENERGY

392 COUNTY RD 50  
AVON, MN 56310

ISSUE FOR RECORD

NO		REVISION	ZONE	DATE	BY	CHK	ENG	NO	REVISION	ZONE	DATE	BY	CHK	ENG	REFERENCE DRAWINGS			<div><p>NORTHERN STATES POWER COMPANY CROWNED RIDGE II WIND FARM CODINGTON, DEUEL, GRANT COUNTIES, SOUTH DAKOTA</p><table><tr><td>DWN: MDR</td><td>DATE: 11/12/2020</td><td>CHK: AA</td><td>DATE: 11/12/2020</td></tr><tr><td>ENG: MDR</td><td>DATE: 11/12/2020</td><td>CHK:</td><td>DATE:</td></tr><tr><td>PM: AA</td><td>DATE: 11/12/2020</td><td>PROJ. NO: 22590</td><td></td></tr><tr><td>APVD:</td><td>DATE:</td><td>SCALE: NONE</td><td></td></tr></table></div> <div>THIS MAP/DOCUMENT IS A TOOL TO ASSIST EMPLOYEES IN THE PERFORMANCE OF THEIR JOBS. YOUR PERSONAL SAFETY IS PROVIDED FOR BY USING SAFETY PRACTICES, PROCEDURES, AND EQUIPMENT AS DESCRIBED IN THE SAFETY TRAINING PROGRAMS AND MANUALS.</div> <div>UNIT 0 CIVIL ACCESS ROADS</div> <div>DRAINAGE CROSSING SCHEDULE</div>				DWN: MDR	DATE: 11/12/2020	CHK: AA	DATE: 11/12/2020	ENG: MDR	DATE: 11/12/2020	CHK:	DATE:	PM: AA	DATE: 11/12/2020	PROJ. NO: 22590		APVD:	DATE:	SCALE: NONE		REV	
DWN: MDR	DATE: 11/12/2020	CHK: AA	DATE: 11/12/2020																																				
ENG: MDR	DATE: 11/12/2020	CHK:	DATE:																																				
PM: AA	DATE: 11/12/2020	PROJ. NO: 22590																																					
APVD:	DATE:	SCALE: NONE																																					
0	ISSUED FOR CONSTRUCTION			05/29/2020	MDR	AA	MDR								DWG NO.	MANUFACTURER	DESCRIPTION																						
1	ISSUED FOR RECORD - CROWNED RIDGE 22590			11/12/2020	MDR	AA	MDR																																



TURBINE ARRAY

Turbine ID	Northing (m)	Easting (m)	Elevation (ft)
WTG-01	377225.55	2756805.91	1930
WTG-02	378603.61	2759466.79	1928.8
WTG-03	378797.31	2762078.76	1935
WTG-04	380335.64	2753521.77	1892.9
WTG-05	380318.72	2757512.16	1934.3
WTG-06	381061.38	2767858.26	1898.3
WTG-07	380999.91	2778197.72	1901.3
WTG-08	388176.08	2761188.57	1950.5
WTG-09	385889.28	2764078.85	1946.2
WTG-10	385784.85	2767474.78	1921
WTG-11	386173.96	2771882.52	1923.1
WTG-12	386667.48	2774606.34	1932.4
WTG-13	386355.59	2776963.39	1924.1
WTG-14	386304.29	2780503.1	1954.4
WTG-15	387767.45	2784741.62	1955.1
WTG-16	387795.29	2787543.49	1963.5
WTG-17	388730.3	2772989.35	1961.3
WTG-18	389004.83	2776826.28	1963.5
WTG-19	389609.88	2779090.98	1961.2
WTG-20	391966.99	2772821.77	1948.5
WTG-21	392796.93	2777848.55	1995.9
WTG-22	402619.56	2779622.68	2014.3
WTG-23	402958.52	2788559.1	1962.2
WTG-24	405442.03	2775433.15	2016.9
WTG-25	404075.7	2777441.4	2015.3
WTG-26	404779.4	2779930.14	2023.1
WTG-27	405867.51	2788556.67	1947.9
WTG-28	410517.15	2771652.69	1993.8
WTG-29	408408.74	2773893.72	2017.8
WTG-30	406872.61	2777807.25	2012.9

Turbine ID	Northing (m)	Easting (m)	Elevation (ft)
WTG-31	410263.66	2784829.5	1970.5
WTG-32	410452.61	2788432.69	1941.6
WTG-33	408725.49	2793333.16	1896.2
WTG-34	408926.78	2751411.53	1901.8
WTG-35	409344.49	2755370.17	1958
WTG-36	406112.57	2757008.08	1973.7
WTG-37	407381.45	2759315.23	1984.1
WTG-38	412497.6	2750979.82	1891.5
WTG-39	411611.44	2763305.45	1958.8
WTG-40	414599.57	2750005.58	1870.7
WTG-41	414926.71	2756350.93	1918.4
WTG-42	414742.61	2768381.38	1991
WTG-43	413681.75	2773644.49	2017.2
WTG-44	416033.65	2778924.08	1990.4
WTG-45	416105.91	2781540.95	1949.2
WTG-46	414967.92	2785560.57	1956.7
WTG-47	413595.81	2785526.77	1959.3
WTG-48	412511.12	2787193.53	1949.8
WTG-49	418522.27	2773699.67	2010.1
WTG-50	418680.64	2777266.87	2020.3
WTG-51	418557.9	2779752.68	1969.3
WTG-52	418172.88	2785535.07	1934.4
WTG-53	420863.91	2774142.66	2018
WTG-54	420627.96	2777416.47	1996.3
WTG-55	421377.04	2779110.23	1925.7
WTG-56	421445.94	2785146.9	1922.6
WTG-57	419737.68	2766632.4	1954.6
WTG-58	421018.72	2769005.5	1985.4
WTG-59	422486.01	2771091.35	1995.9
WTG-60	423085.56	2774207.07	2014.4

Turbine ID	Northing (m)	Easting (m)	Elevation (ft)
WTG-61	425060.64	2771836	1989.5
WTG-62	428044.96	2756084.05	1924.9
WTG-63	430233.42	2756830.61	1937.5
WTG-64	427386.78	2760652.7	1930.6
WTG-65	427960.35	2762748.46	1947.5
WTG-66	430505.65	2768254.86	2016.3
WTG-67	429699.67	2770742.38	1995.8
WTG-68	429239.34	2775991.33	1946.3
WTG-69	433717.06	2765617.22	1981.1
WTG-70	432988.99	2768681.86	2015.9
WTG-71	435305.67	2768236.1	1980.8
WTG-72	435159.77	2770321.08	1994
WTG-73	434498.29	2772962.73	1970
WTG-74	433345.18	2776533.19	1927
WTG-75	436554.92	2773961.29	1934.5
WTG-76	434893.06	2755292.87	1932.4
WTG-77	435922.56	2759716.41	1945.9
WTG-78	436560.77	2761909.58	1983.3
WTG-79	438106.56	2763343.92	1991.4
WTG-80	438639.41	2765831.35	1995
WTG-81	438975.23	2767805.94	1982.9
WTG-82	441488.87	2757484.79	1957.9
WTG-83	440724.7	2765936.64	1989.5
WTG-84	442156.12	2768219.24	1996.4
WTG-85	441584.92	2776124.62	1913.2
WTG-86	444497.51	2767297.23	1990.4
WTG-87	444138.3	2770487.27	1966.5
WTG-88	447018.51	2767375.02	1992.9
N Radar	444014.06	2769352.35	1987.2
S Radar	391706.2	2777749.97	1992.5

NOTE:  
1. TURBINE ARRAY NORTHING AND EASTING VALUES IN THE NSRS 2011 SOUTH DAKOTA STATE PLANES, NORTH ZONE, US FOOT COORDINATE SYSTEM

Westwood

Phone (214) 473-4640  
TollFree (888) 937-5150

2740 Dallas Parkway, Suite 280  
Plano, TX 75093  
westwoodps.com

Westwood Professional Services, Inc.

PREPARED FOR:


BLATTNER  
ENERGY

392 COUNTY RD 50  
AVON, MN 56310

ISSUE FOR RECORD

NO		REVISION		ZONE	DATE	BY	CHK	ENG	NO	REVISION		ZONE	DATE	BY	CHK	ENG	REFERENCE DRAWINGS			<div><div><div><div><div></div><div></div></div><div><div></div><div></div></div></div><div><div><div>XcelEnergy®</div><div>NORTHERN STATES POWER COMPANY CROWNED RIDGE II WIND FARM CODINGTON, DEUEL, GRANT COUNTIES, SOUTH DAKOTA</div></div><div><div>DWN: MDR</div><div>DATE: 11/12/2020</div><div>CHK: AA</div><div>DATE: 11/12/2020</div></div><div><div>ENG: MDR</div><div>DATE: 11/12/2020</div><div>CHK:</div><div>DATE:</div></div><div><div>PM: AA</div><div>DATE: 11/12/2020</div><div>PROJ. NO: 22590</div></div><div><div>APVD:</div><div>DATE:</div><div>SCALE: NONE</div></div></div><div>THIS MAP/DOCUMENT IS A TOOL TO ASSIST EMPLOYEES IN THE PERFORMANCE OF THEIR JOBS. YOUR PERSONAL SAFETY IS PROVIDED FOR BY USING SAFETY PRACTICES, PROCEDURES, AND EQUIPMENT AS DESCRIBED IN THE SAFETY TRAINING PROGRAMS AND MANUALS.</div><div>ENERGY SUPPLY ENGINEERING &amp; CONSTRUCTION</div></div></div>			UNIT 0 CIVIL ACCESS ROADS		TURBINE ARRAY		NH-275900-2-2		REV 1
DWG NO.		MANUFACTURER		DESCRIPTION																									



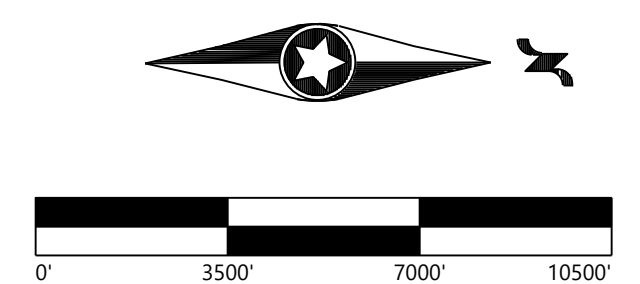

Phone (214) 473-4640 2740 Dallas Parkway, Suite 280  
Toll Free (888) 937-5150 Plano, TX 75093  
**westwoodps.com**

Westwood Professional Services, Inc.

PREPARED FOR:

392 COUNTY RD 50  
AVON, MN 56310

ISSUE FOR RECORD

THIS MAP/DOCUMENT IS A TOOL  
TO ASSIST EMPLOYEES IN THE  
PERFORMANCE OF THEIR JOBS.  
YOUR PERSONAL SAFETY IS  
PROVIDED FOR BY USING  
SAFETY PRACTICES,  
PROCEDURES, AND EQUIPMENT  
AS DESCRIBED IN THE SAFETY  
TRAINING PROGRAMS AND  
MANUALS

**ENERGY SUPPLY**  
ENGINEERING & CONSTRUCTION


UNIT 0  
CIVIL ACCESS ROAD

## OVERALL PLAN

NH-275900-3


REV  
1



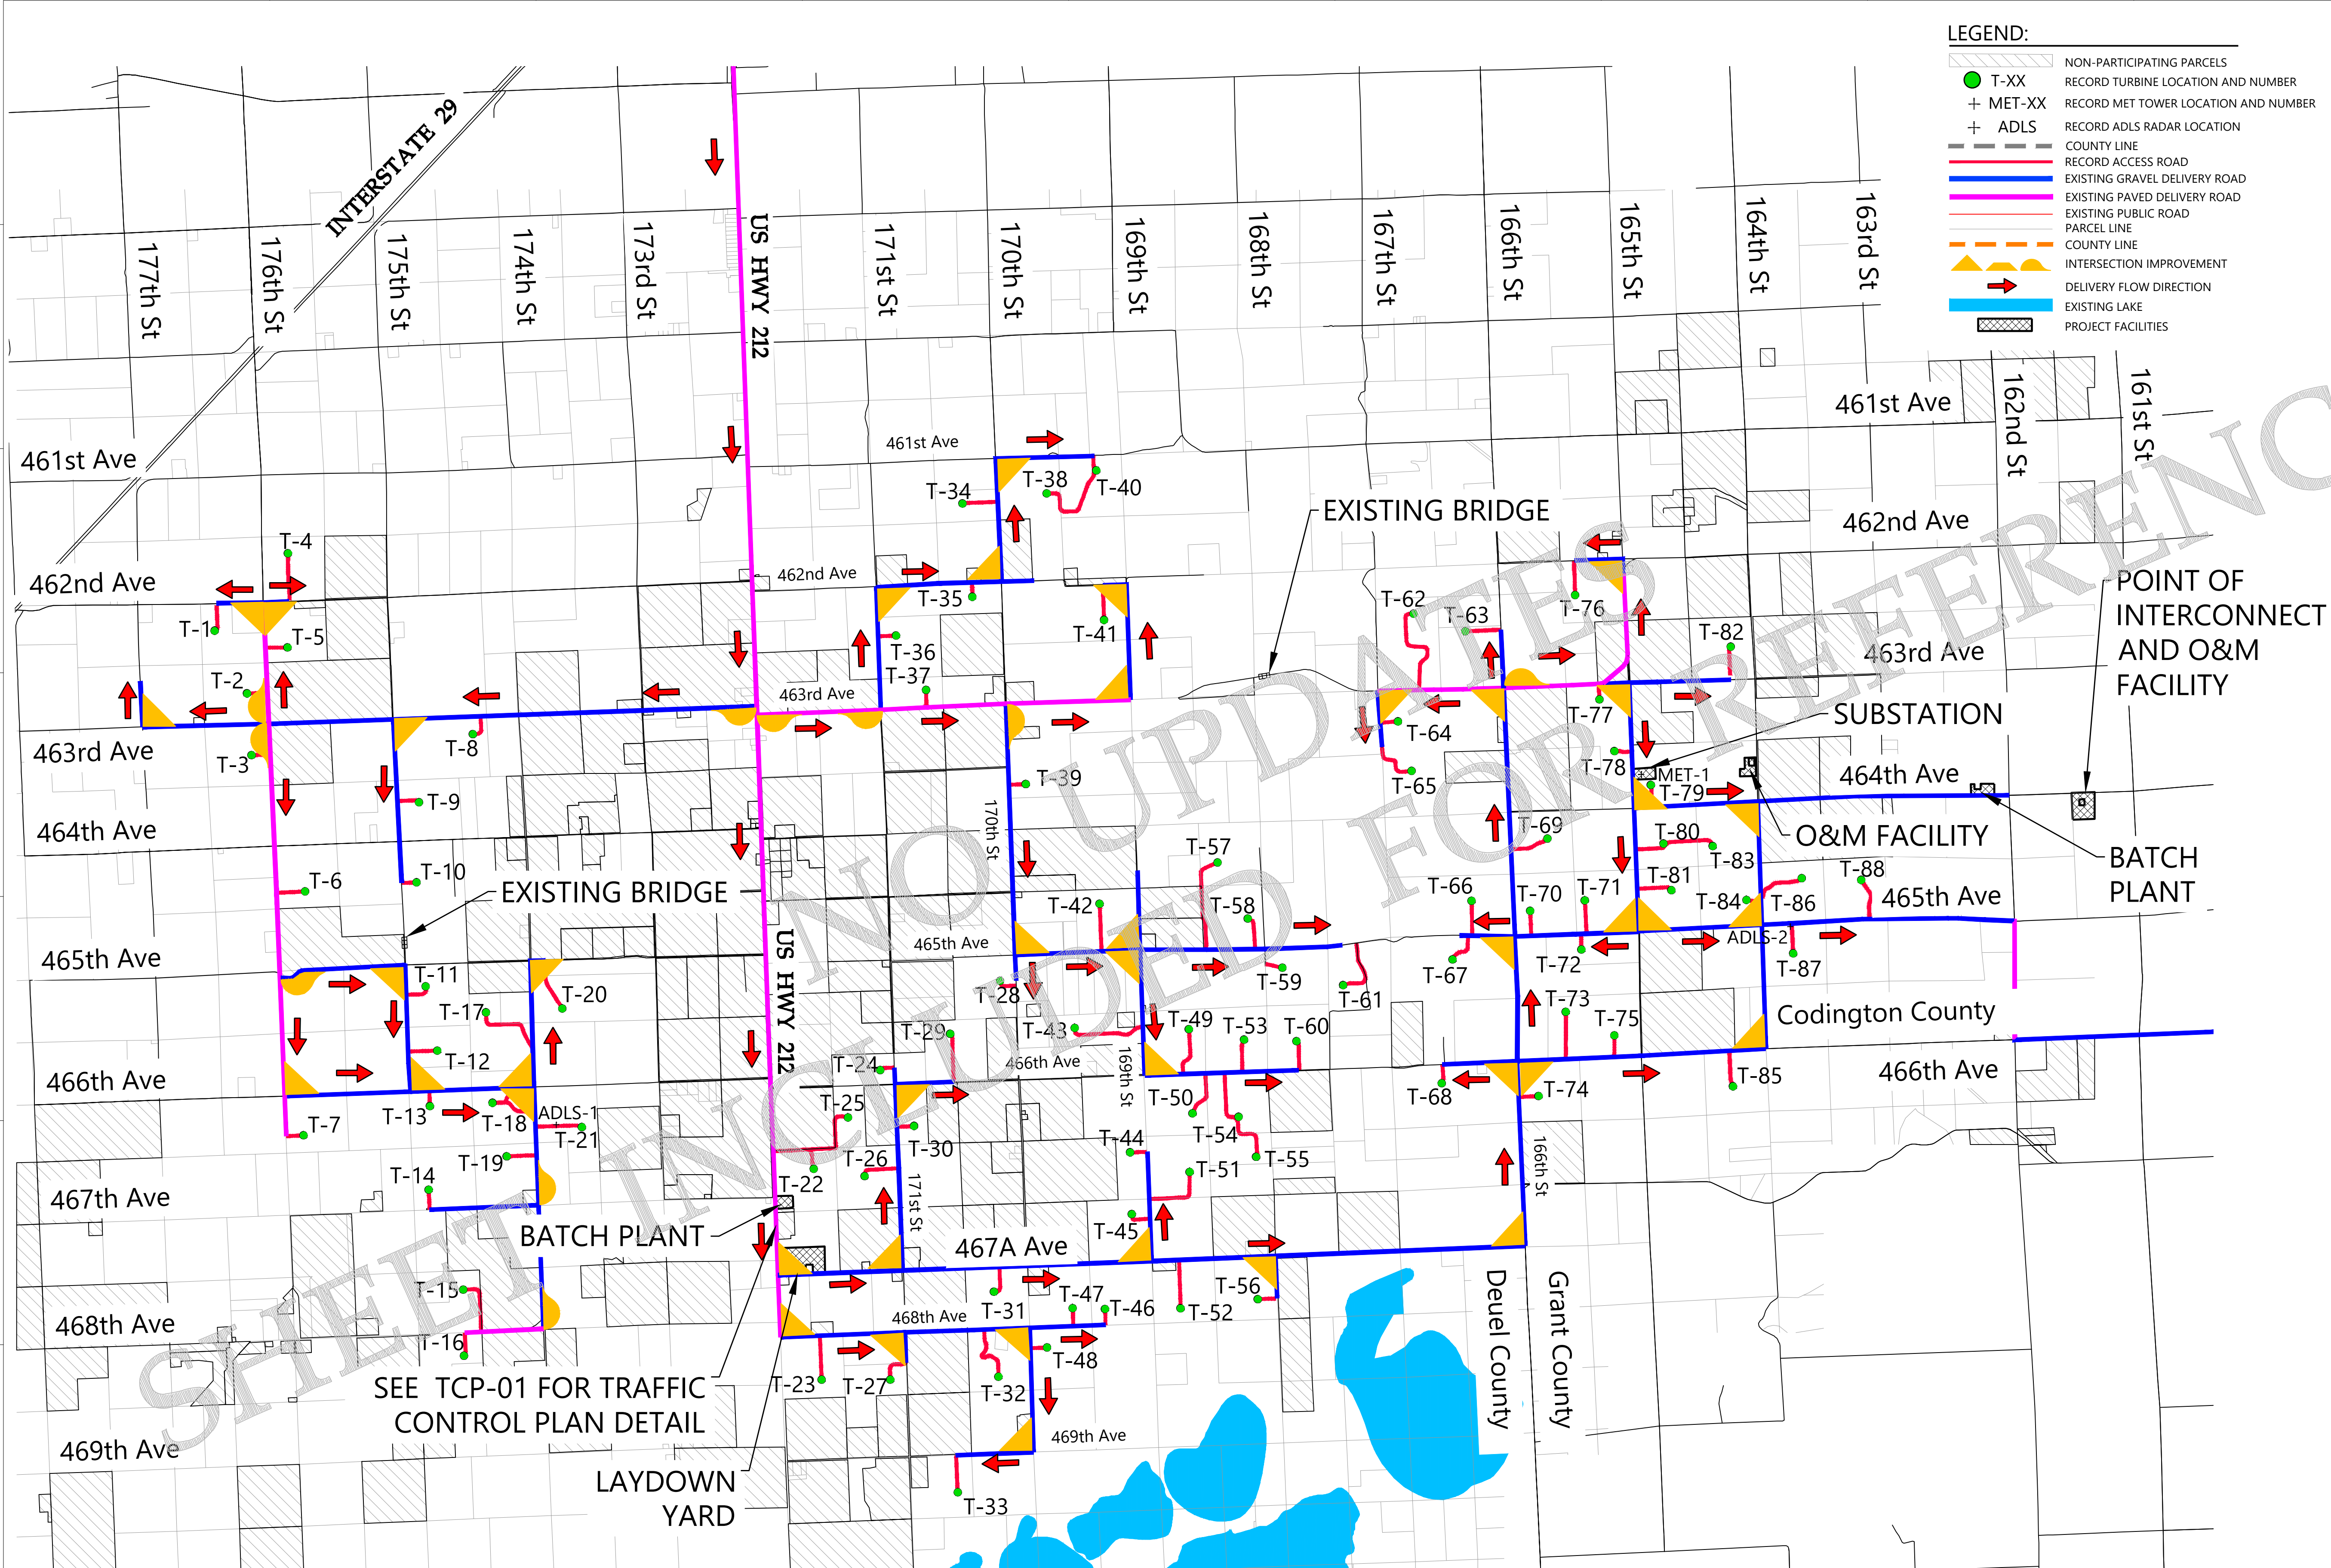

LEGEND:

- NON-PARTICIPATING PARCELS
- T-XX RECORD TURBINE LOCATION AND NUMBER
- + MET-XX RECORD MET TOWER LOCATION AND NUMBER
- + ADLS RECORD ADLS RADAR LOCATION
- COUNTY LINE
- RECORD ACCESS ROAD
- EXISTING GRAVEL DELIVERY ROAD
- EXISTING PAVED DELIVERY ROAD
- EXISTING PUBLIC ROAD
- PARCEL LINE
- COUNTY LINE
- INTERSECTION IMPROVEMENT
- DELIVERY FLOW DIRECTION
- EXISTING LAKE
- PROJECT FACILITIES

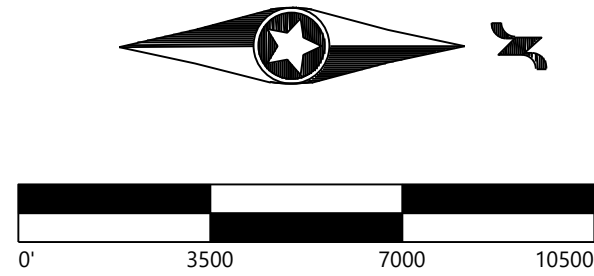

**Westwood**


Phone (214) 473-4640 2740 Dallas Parkway, Suite 280  
Toll Free (888) 937-5150 Plano, TX 75093  
westwoodps.com  
Westwood Professional Services, Inc.

PREPARED FOR:





**BLATTNER ENERGY**

392 COUNTY RD 50  
AVON, MN 56310

ISSUE FOR RECORD

REVISION		ZONE	DATE	BY	CHK	ENG	NO	REVISION		ZONE	DATE	BY	CHK	ENG	REFERENCE DRAWINGS			<div> NORTHERN STATES POWER COMPANY CROWNED RIDGE II WIND FARM <small>CODINGTON, DEUEL, GRANT COUNTIES, SOUTH DAKOTA</small></div> <div><div>DWN: MDR</div><div>ENG: MDR</div><div>PM: AA</div><div>APVD:</div><div>DATE: 11/12/2020</div><div>CHK: AA</div><div>DATE: 11/12/2020</div><div>CHK:</div><div>PROJ. NO: 22590</div><div>SCALE: 1" = 3,500'</div></div> <div>THIS MAP/DOCUMENT IS A TOOL TO ASSIST EMPLOYEES IN THE PERFORMANCE OF THEIR JOBS. YOUR PERSONAL SAFETY IS PROVIDED FOR BY USING SAFETY PRACTICES, PROCEDURES, AND EQUIPMENT AS DESCRIBED IN THE SAFETY TRAINING PROGRAMS AND MANUALS.</div> <div>ENERGY SUPPLY ENGINEERING &amp; CONSTRUCTION</div>				UNIT 0 CIVIL ACCESS ROADS		DELIVERY FLOW PLAN	
DWG NO.	MANUFACTURER	DESCRIPTION													NH-275900-4		REV 1								
0	ISSUED FOR CONSTRUCTION		05/29/2020	MDR	AA	MDR																			
1	ISSUED FOR RECORD - CROWNED RIDGE 22590		11/12/2020	MDR	AA	MDR																			



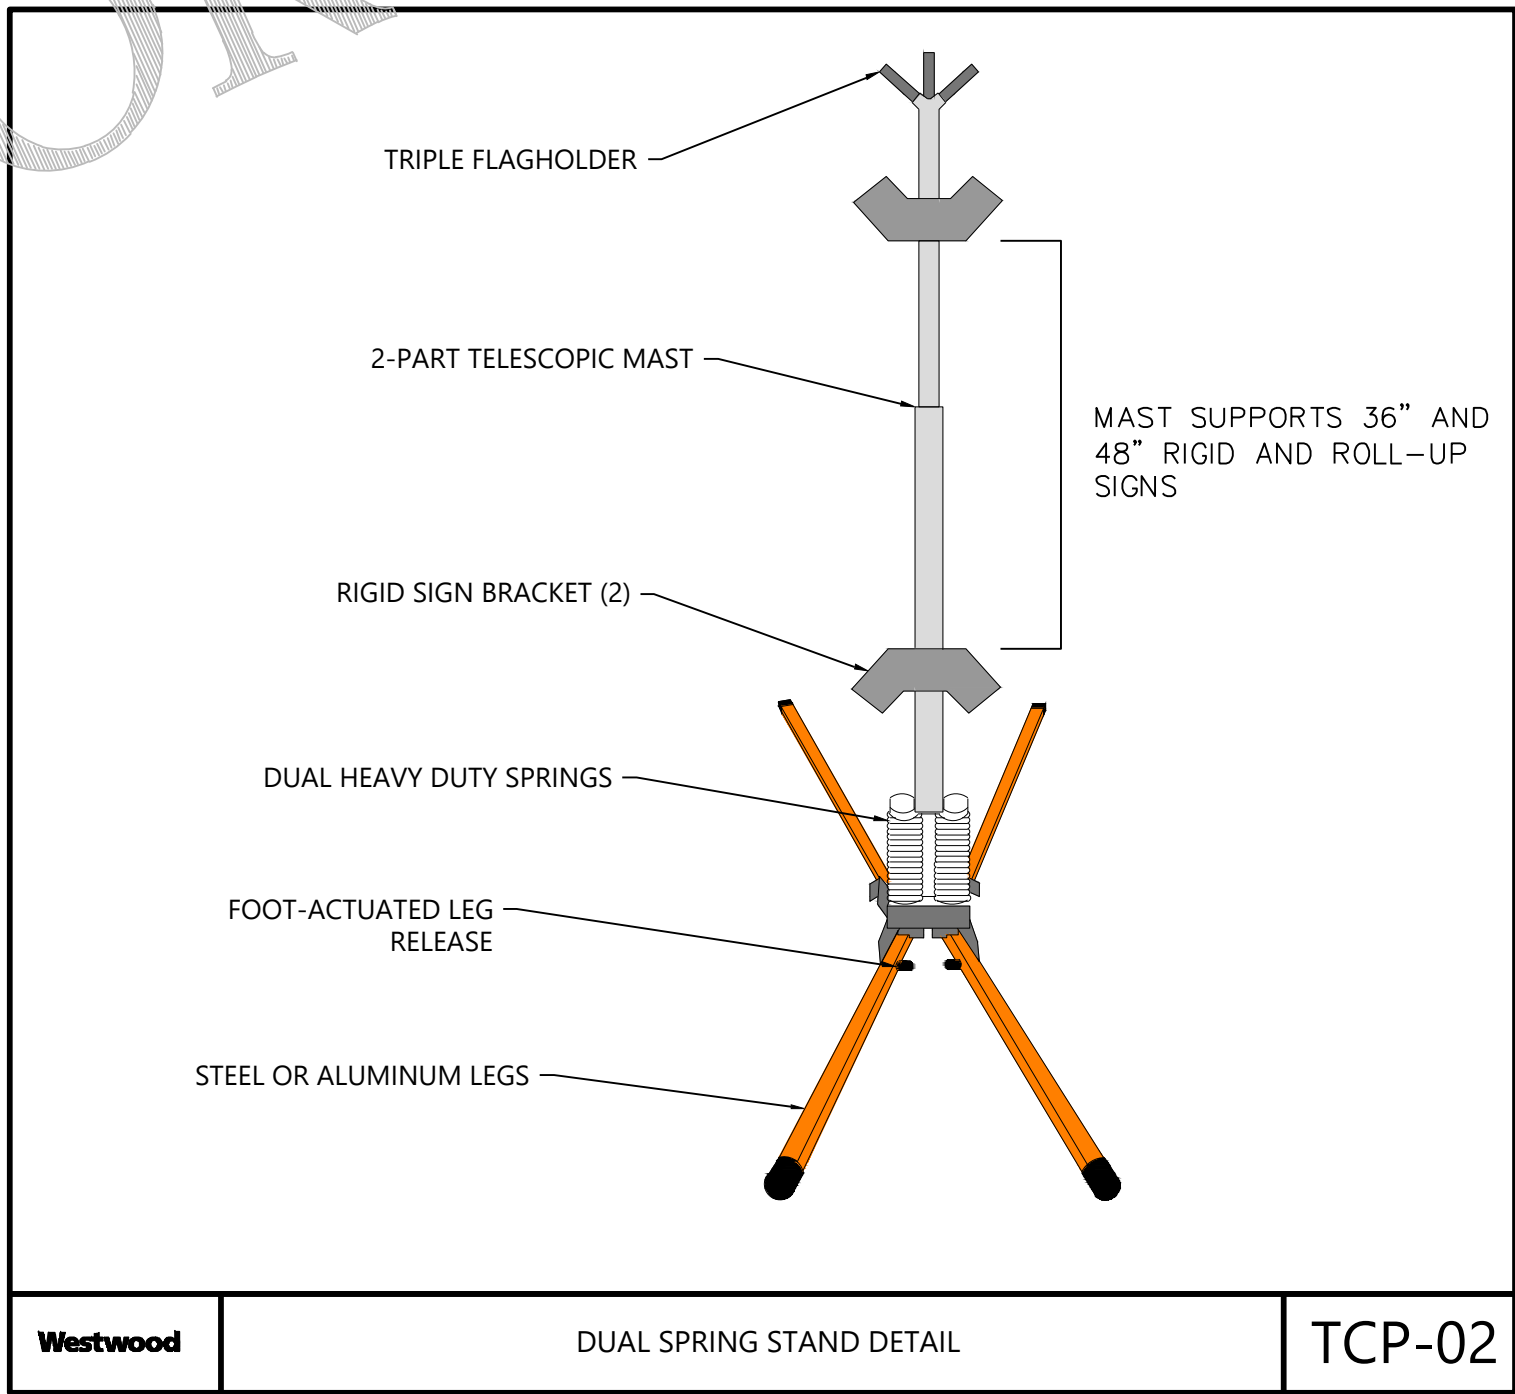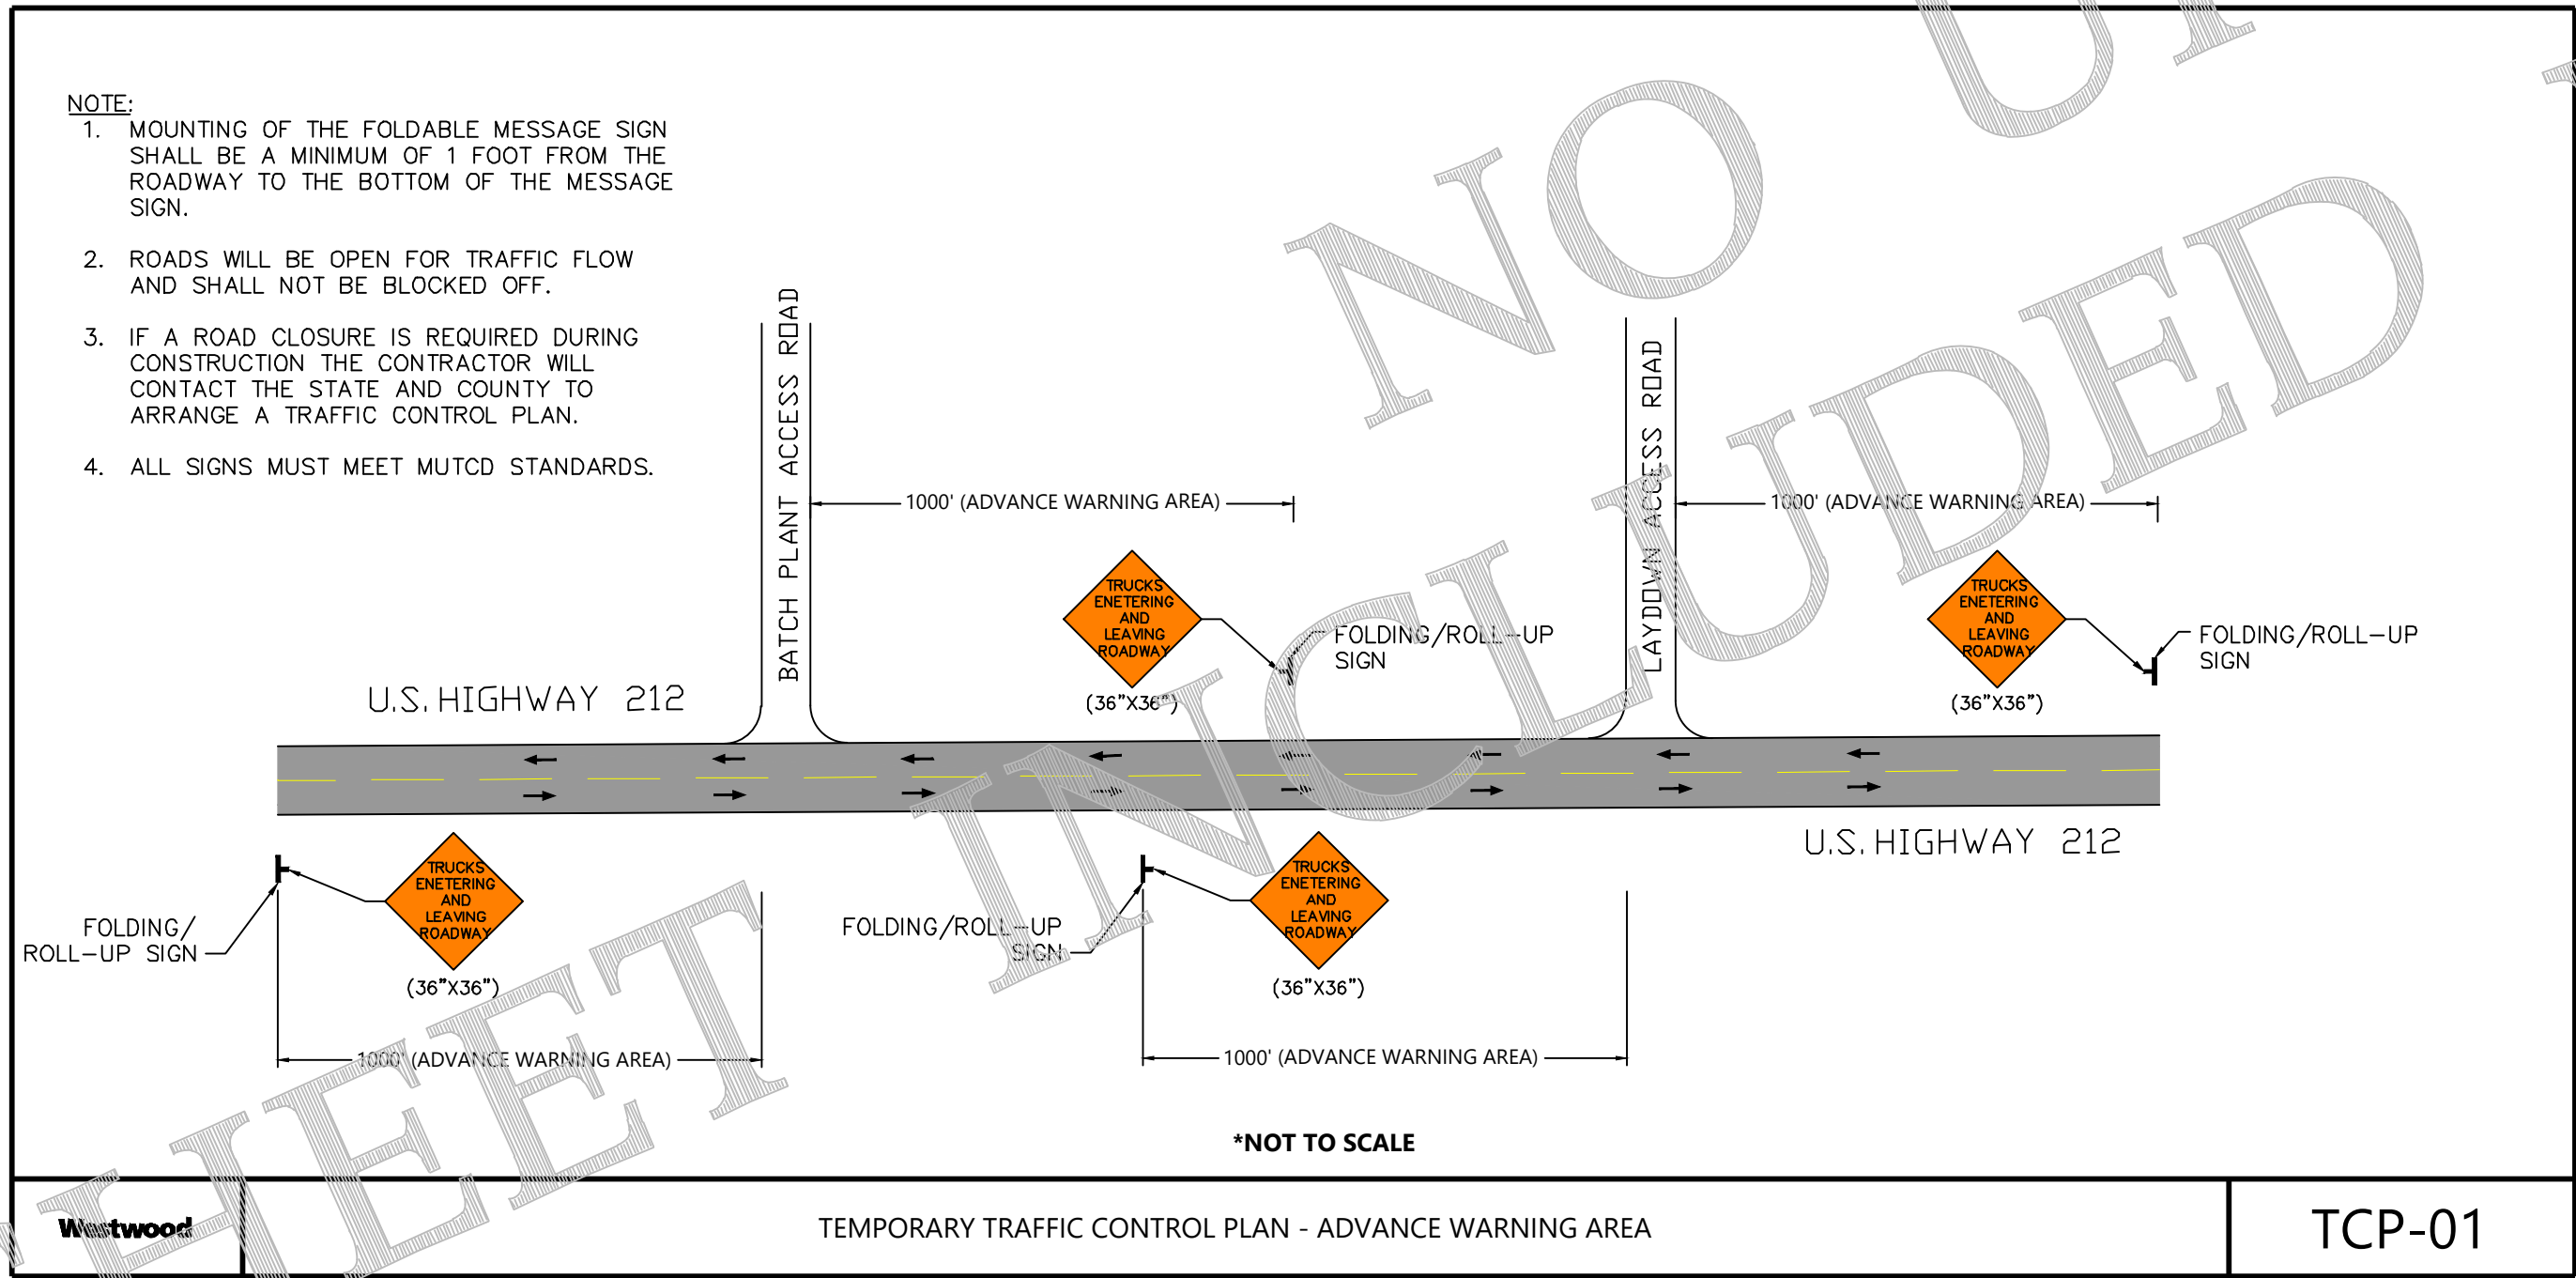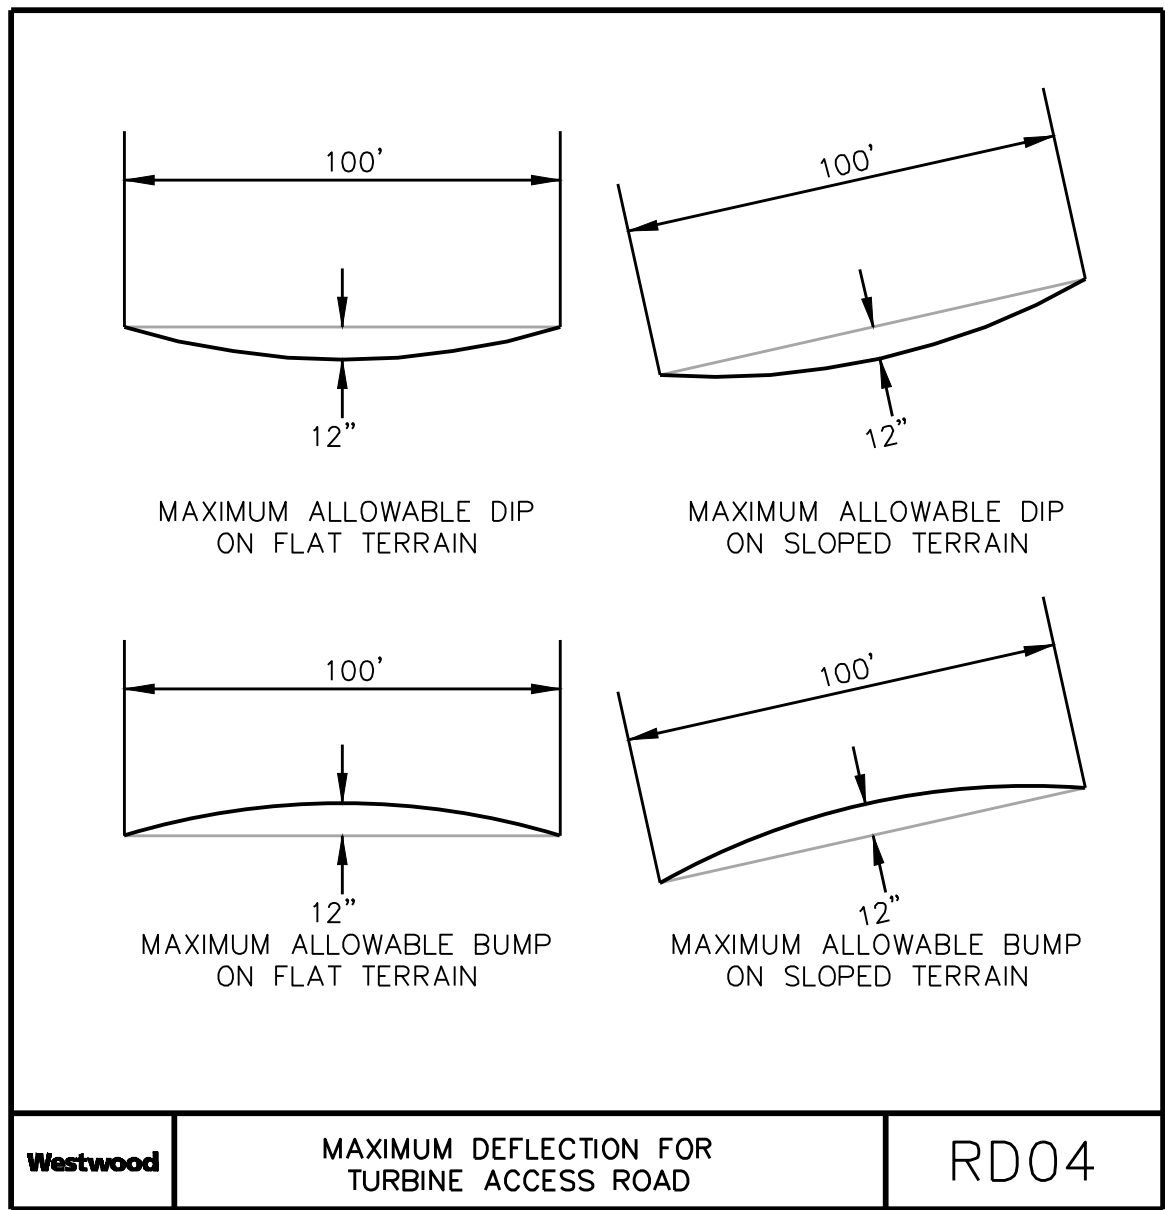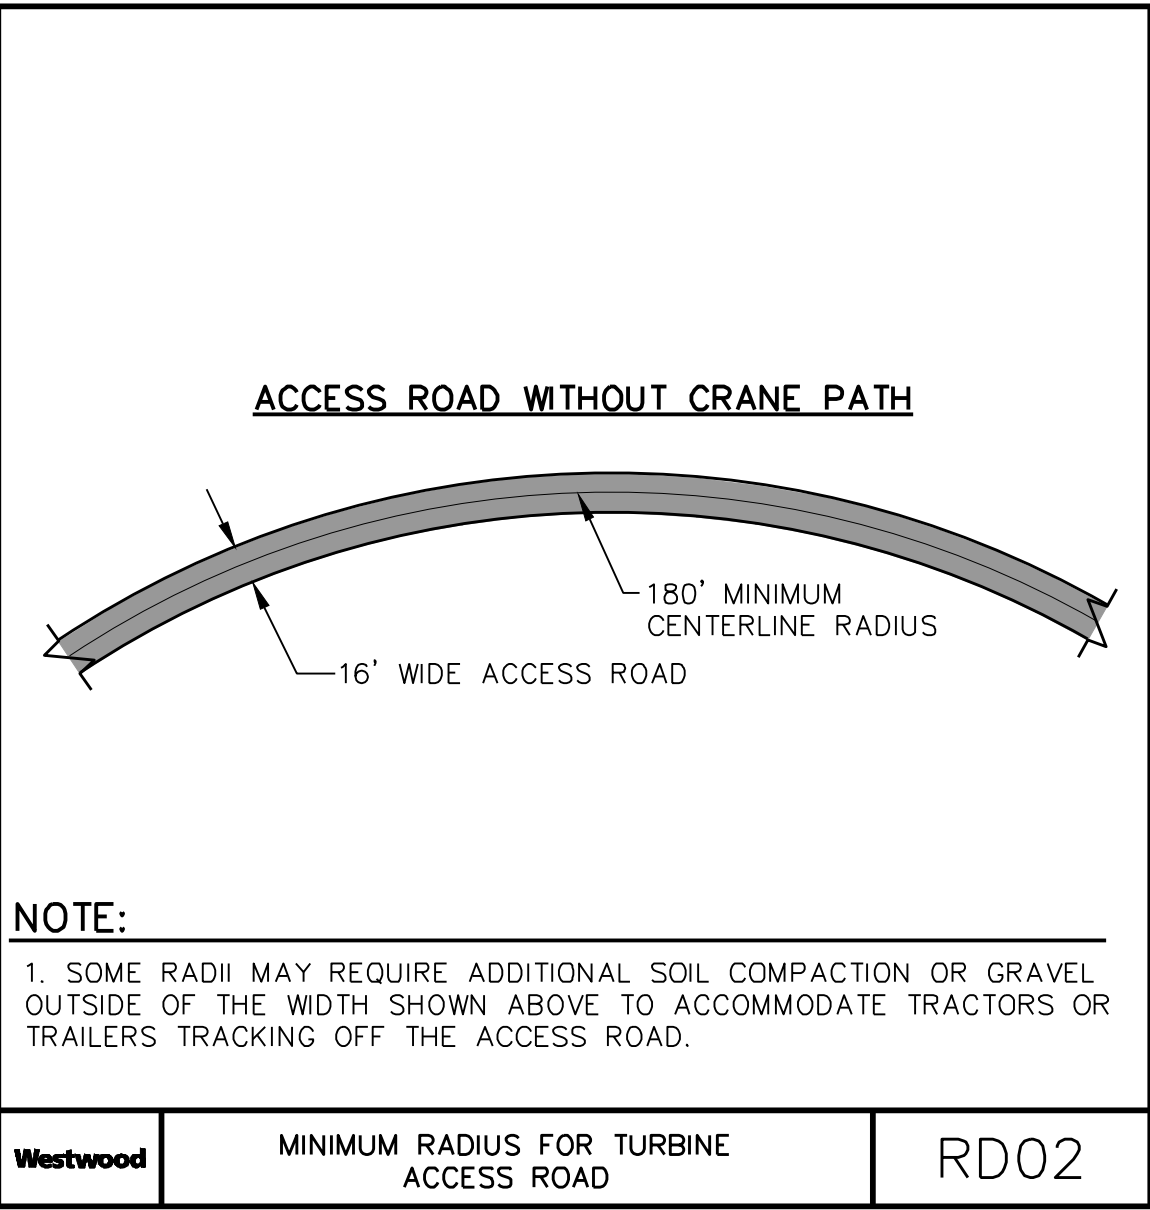

**Westwood**

Phone (214) 473-4640 2740 Dallas Parkway, Suite 280  
TollFree (888) 937-5150 Plano, TX 75093  
westwoodps.com


Westwood Professional Services, Inc.

PREPARED FOR:

**BLATTNER ENERGY**

392 COUNTY RD 50  
AVON, MN 56310

ISSUE FOR RECORD

NO	REVISION	ZONE	DATE	BY	CHK	ENG	NO	REVISION	ZONE	DATE	BY	CHK	ENG	REFERENCE DRAWINGS			<div><div></div><div>NORTHERN STATES POWER COMPANY CROWNED RIDGE II WIND FARM CODINGTON, DEUEL, GRANT COUNTIES, SOUTH DAKOTA</div></div>	THIS MAP/DOCUMENT IS A TOOL TO ASSIST EMPLOYEES IN THE PERFORMANCE OF THEIR JOBS. YOUR PERSONAL SAFETY IS PROVIDED FOR BY USING SAFETY PRACTICES, PROCEDURES, AND EQUIPMENT AS DESCRIBED IN THE SAFETY TRAINING PROGRAMS AND MANUALS.	UNIT 0 CIVIL ACCESS ROADS			
														DWG NO.	MANUFACTURER	DESCRIPTION					CONSTRUCTION DETAILS	
0	ISSUED FOR CONSTRUCTION		05/29/2020	MDR	AA	MDR																
1	ISSUED FOR RECORD - CROWNED RIDGE 22590		11/12/2020	MDR	AA	MDR																
															DWN: MDR	DATE: 11/12/2020	CHK: AA	DATE: 11/12/2020	ENERGY SUPPLY ENGINEERING & CONSTRUCTION		NH-275900-5-1	REV 1
														ENG: MDR	DATE: 11/12/2020	CHK:	DATE:					
															PM: AA	DATE: 11/12/2020	PROJ. NO: 22590					
															APVD:	DATE:	SCALE: NONE					



# Westwood

Phone (214) 473-4640 2740 Dallas Parkway, Suite 280  
Toll Free (888) 937-5150 Plano, TX 75093  
westwoodps.com

Westwood Professional Services, Inc.


---

PREPARED FOR:





**BLATTNER**  
**ENERGY**

392 COUNTY RD 50  
AVON, MN 56310

ISSUE FOR RECORD

NO	REVISION	ZONE	DATE	BY	CHK	ENG	NO	REVISION	ZONE	DATE	BY	CHK	ENG	REFERENCE DRAWINGS			<div> NORTHERN STATES POWER COMPANY CROWNED RIDGE II WIND FARM CODINGTON, DEUEL, GRANT COUNTIES, SOUTH DAKOTA</div> <table><tr><td>DWN: MDR</td><td>DATE: 11/12/2020</td><td>CHK: AA</td><td>DATE: 11/12/2020</td></tr><tr><td>ENG: MDR</td><td>DATE: 11/12/2020</td><td>CHK:</td><td>DATE:</td></tr><tr><td>PM: AA</td><td>DATE: 11/12/2020</td><td>PROJ. NO: 22590</td><td></td></tr><tr><td>APVD:</td><td>DATE:</td><td>SCALE: NONE</td><td></td></tr></table>	DWN: MDR	DATE: 11/12/2020	CHK: AA	DATE: 11/12/2020	ENG: MDR	DATE: 11/12/2020	CHK:	DATE:	PM: AA	DATE: 11/12/2020	PROJ. NO: 22590		APVD:	DATE:	SCALE: NONE		THIS MAP/DOCUMENT IS A TOOL TO ASSIST EMPLOYEES IN THE PERFORMANCE OF THEIR JOBS. YOUR PERSONAL SAFETY IS PROVIDED FOR BY USING SAFETY PRACTICES, PROCEDURES, AND EQUIPMENT AS DESCRIBED IN THE SAFETY TRAINING PROGRAMS AND MANUALS.		UNIT 0 CIVIL ACCESS ROADS	
														DWN: MDR	DATE: 11/12/2020	CHK: AA		DATE: 11/12/2020																			
														ENG: MDR	DATE: 11/12/2020	CHK:		DATE:																			
PM: AA	DATE: 11/12/2020	PROJ. NO: 22590																																			
APVD:	DATE:	SCALE: NONE																																			
														ENERGY SUPPLY ENGINEERING & CONSTRUCTION		CONSTRUCTION DETAILS																					
														NH-275900-5-2		REV 1																					



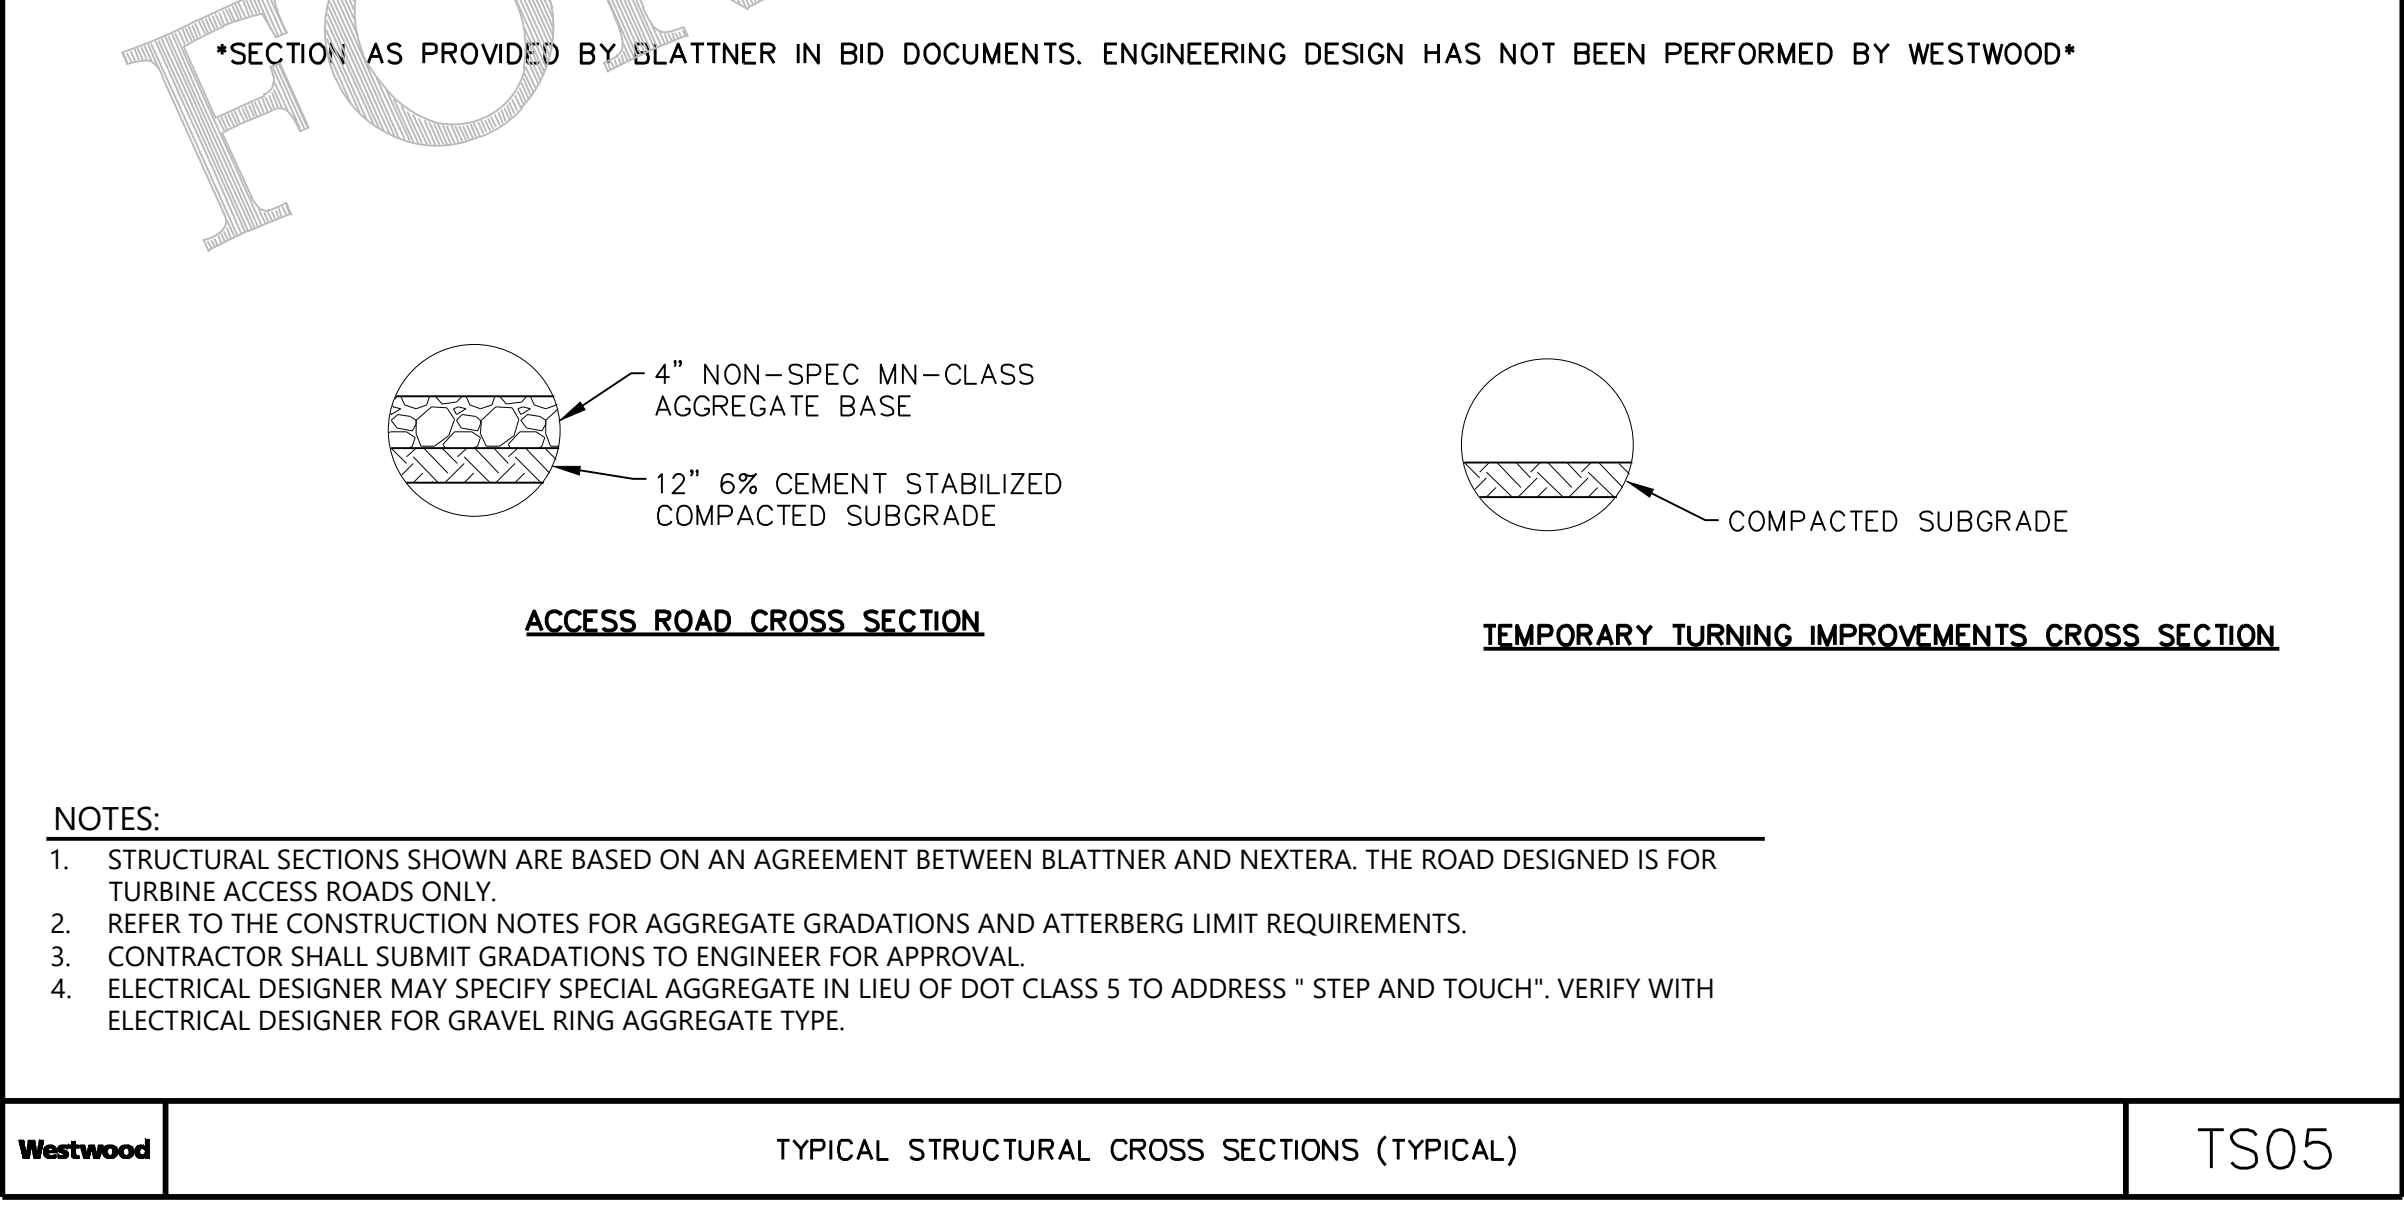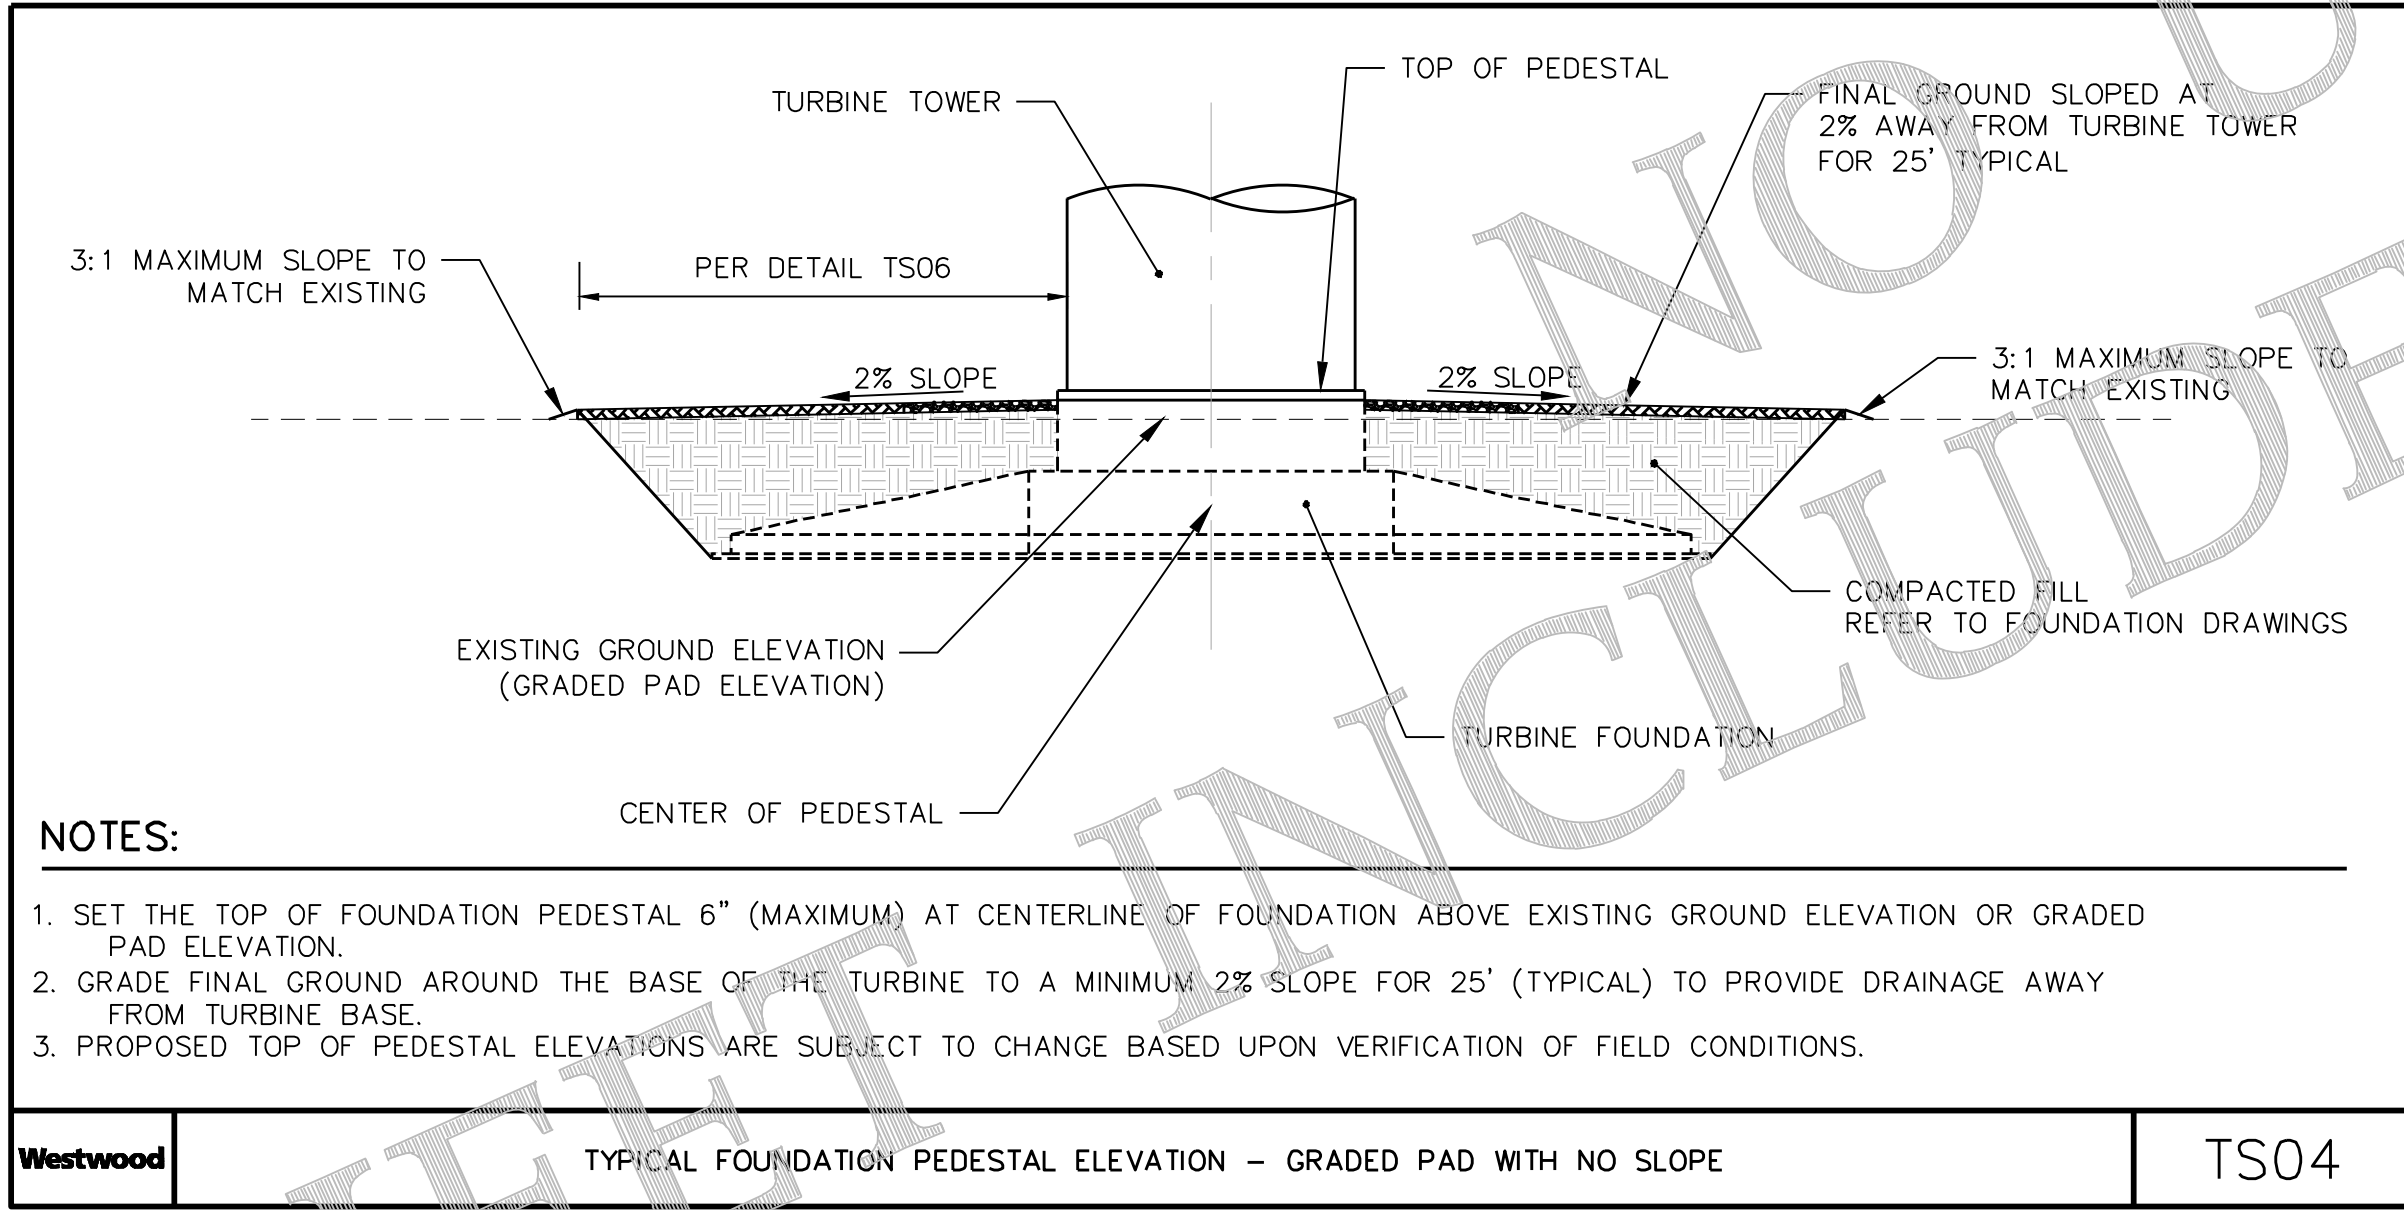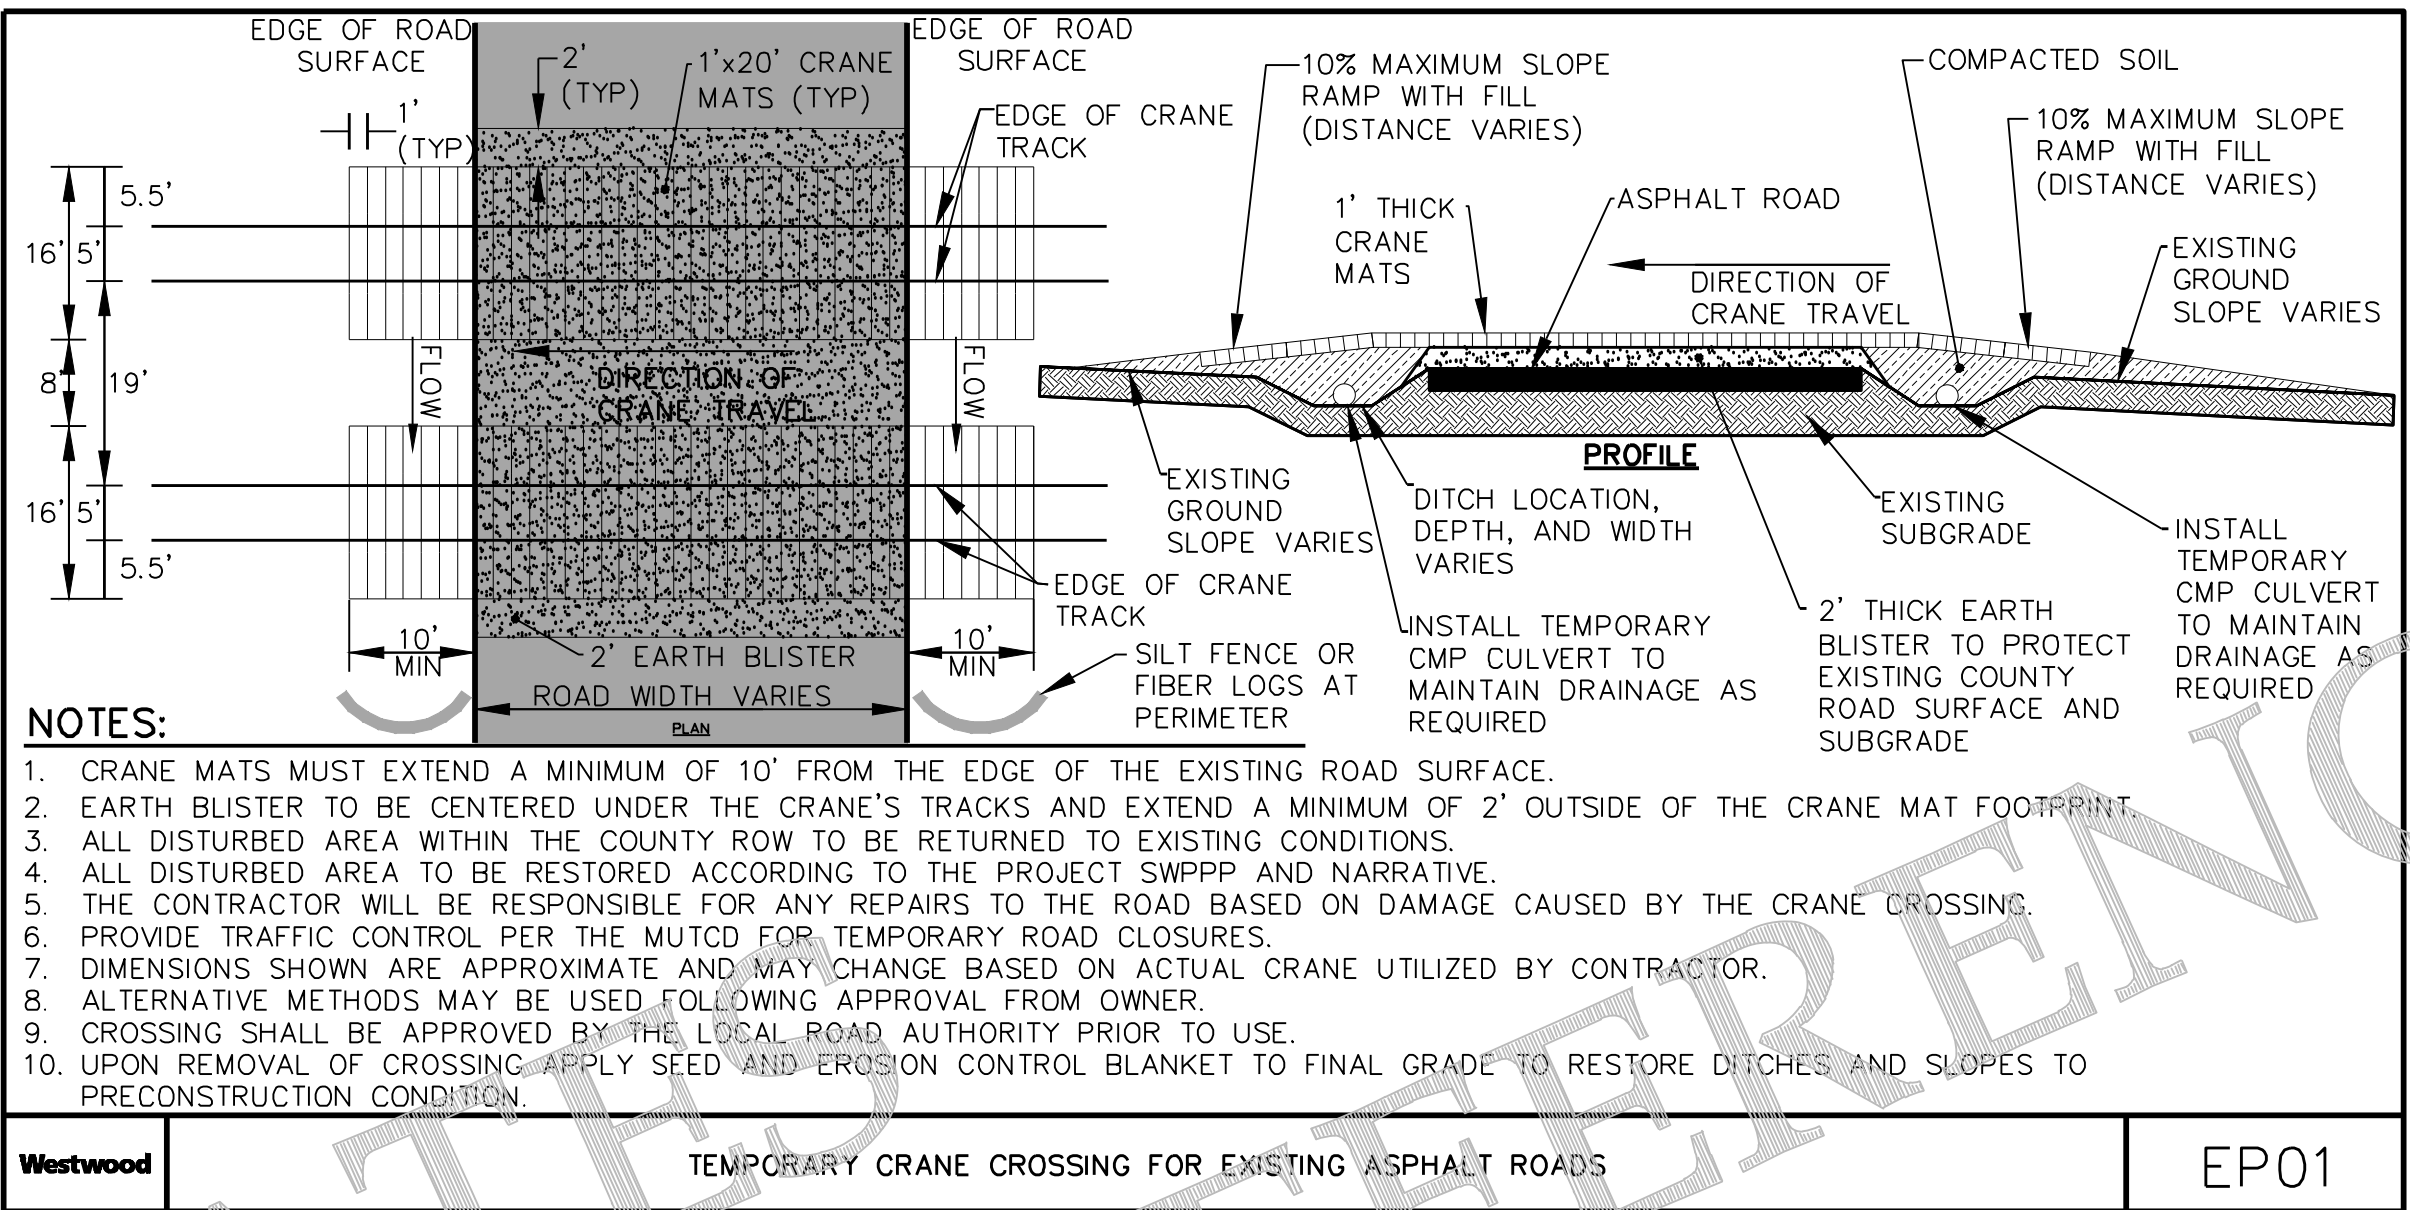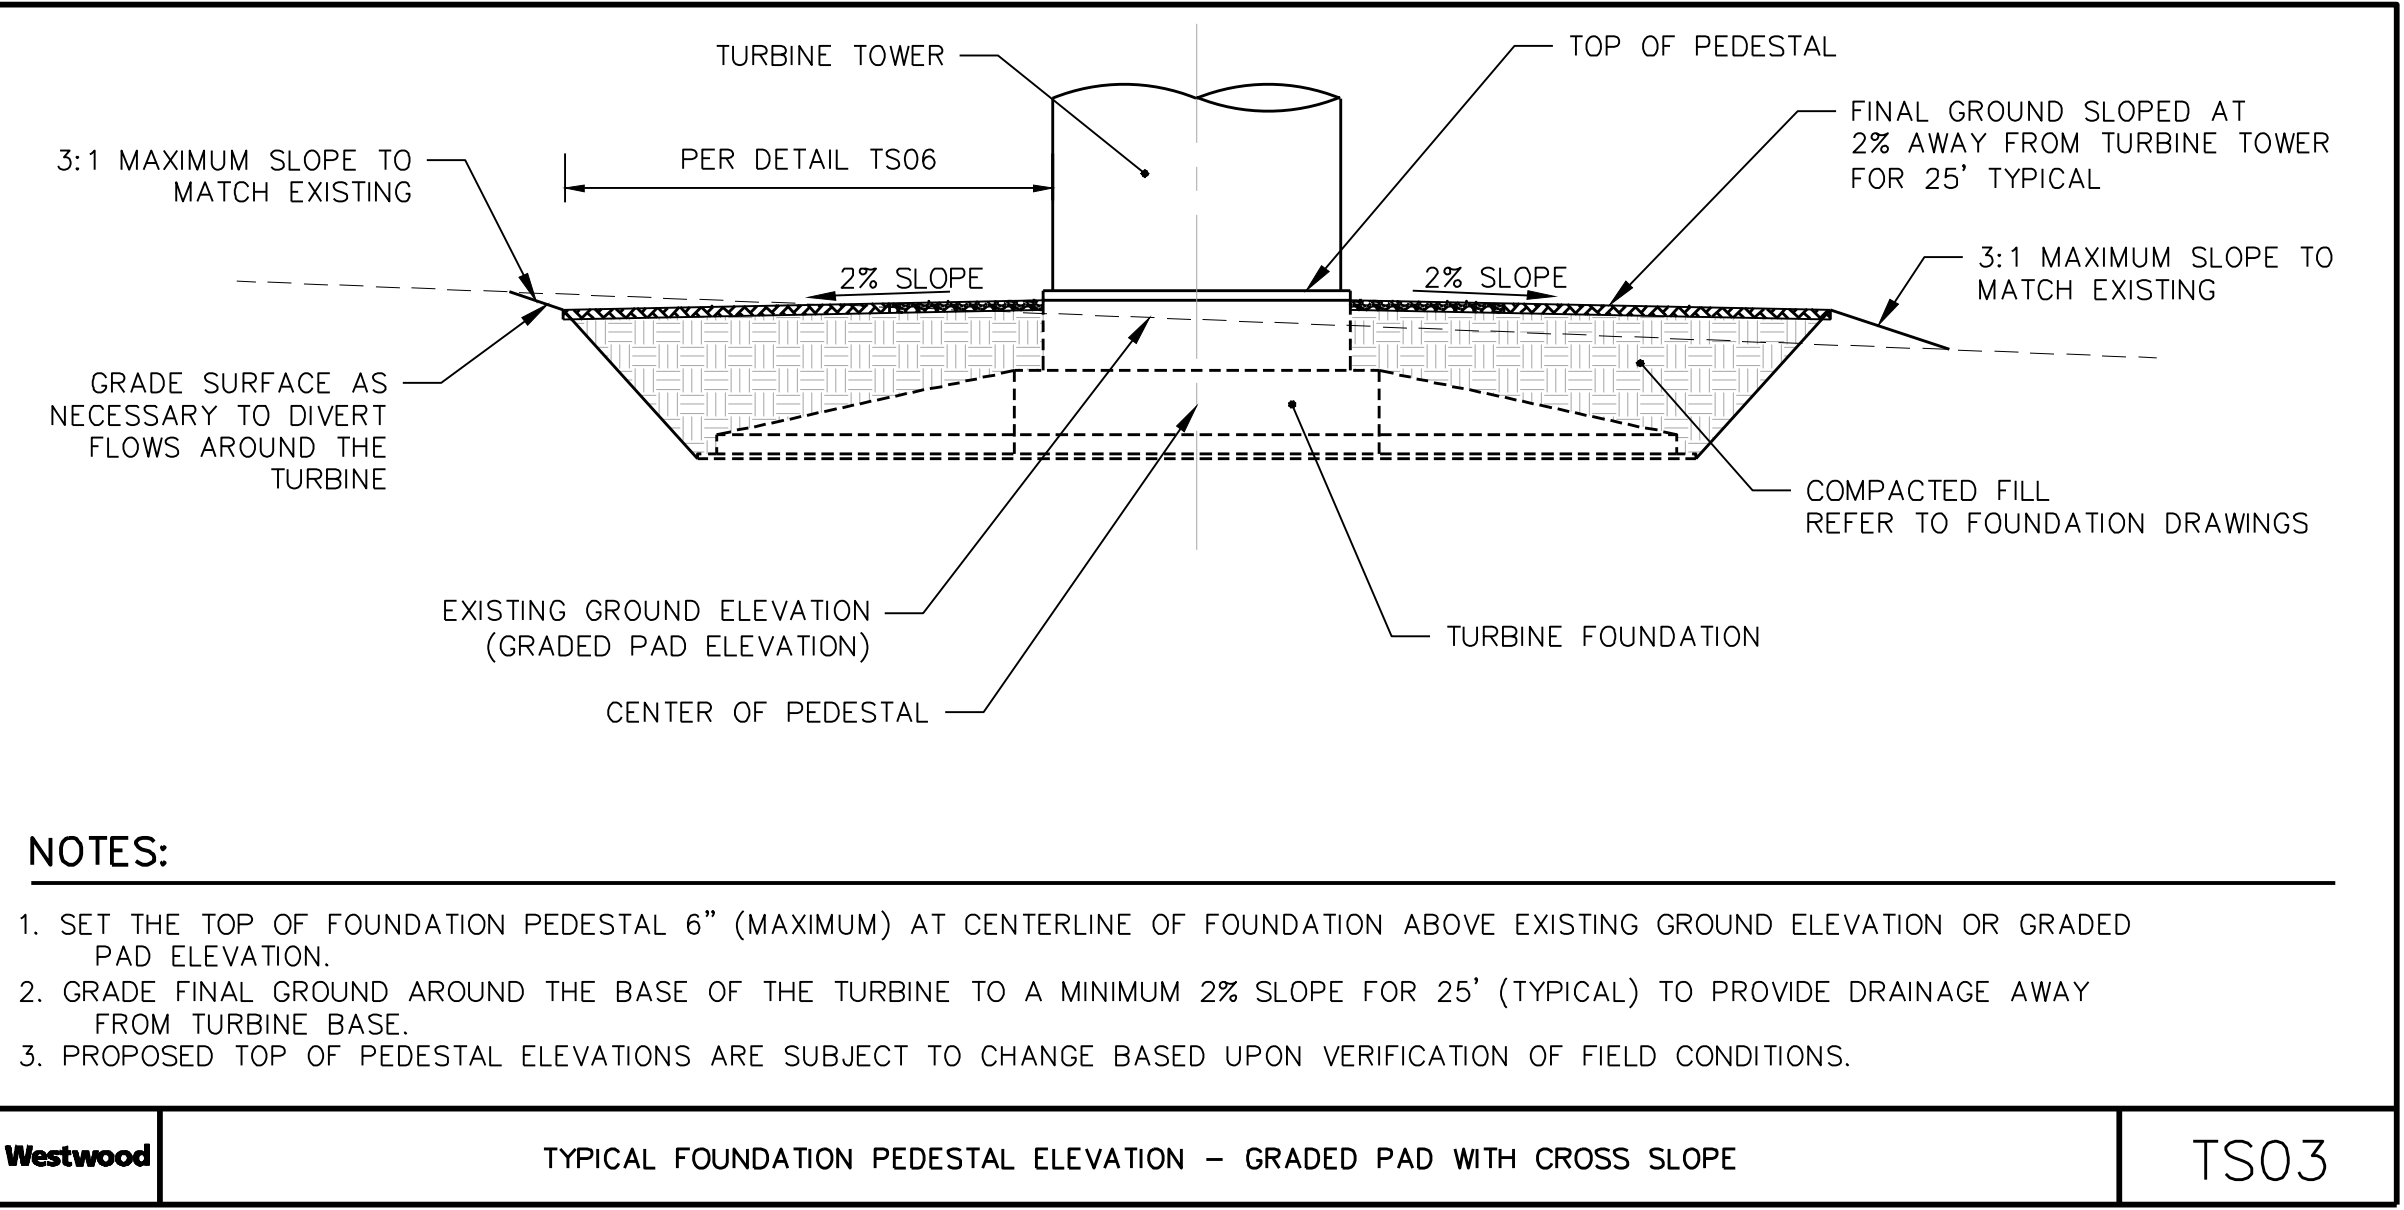

Westwood

Phone (214) 473-4640 2740 Dallas Parkway, Suite 280  
TollFree (888) 937-5150 Plano, TX 75093  
westwoodps.com


Westwood Professional Services, Inc.

PREPARED FOR:


BLATTNER  
ENERGY

392 COUNTY RD 50  
AVON, MN 56310

ISSUE FOR RECORD

REVISION		ZONE	DATE	BY	CHK	ENG	NO	REVISION		ZONE	DATE	BY	CHK	ENG	REFERENCE DRAWINGS			<div> NORTHERN STATES POWER COMPANY CROWNED RIDGE II WIND FARM CODINGTON, DEUEL, GRANT COUNTIES, SOUTH DAKOTA</div>	THIS MAP/DOCUMENT IS A TOOL TO ASSIST EMPLOYEES IN THE PERFORMANCE OF THEIR JOBS. YOUR PERSONAL SAFETY IS PROVIDED FOR BY USING SAFETY PRACTICES, PROCEDURES, AND EQUIPMENT AS DESCRIBED IN THE SAFETY TRAINING PROGRAMS AND MANUALS.	UNIT 0 CIVIL ACCESS ROADS							
0	ISSUED FOR CONSTRUCTION		05/29/2020	MDR	AA	MDR									DWG NO.	MANUFACTURER	DESCRIPTION			CONSTRUCTION DETAILS							
1	ISSUED FOR RECORD - CROWNED RIDGE 22590		11/12/2020	MDR	AA	MDR														NH-275900-5-3		REV 1					
																				DWN: MDR	DATE: 11/12/2020	CHK: AA	DATE: 11/12/2020				
																		ENG: MDR	DATE: 11/12/2020	CHK:	DATE:			ENERGY SUPPLY ENGINEERING & CONSTRUCTION			
																		PM: AA	DATE: 11/12/2020	PROJ. NO: 22590							
																		APVD:	DATE:	SCALE: NONE							




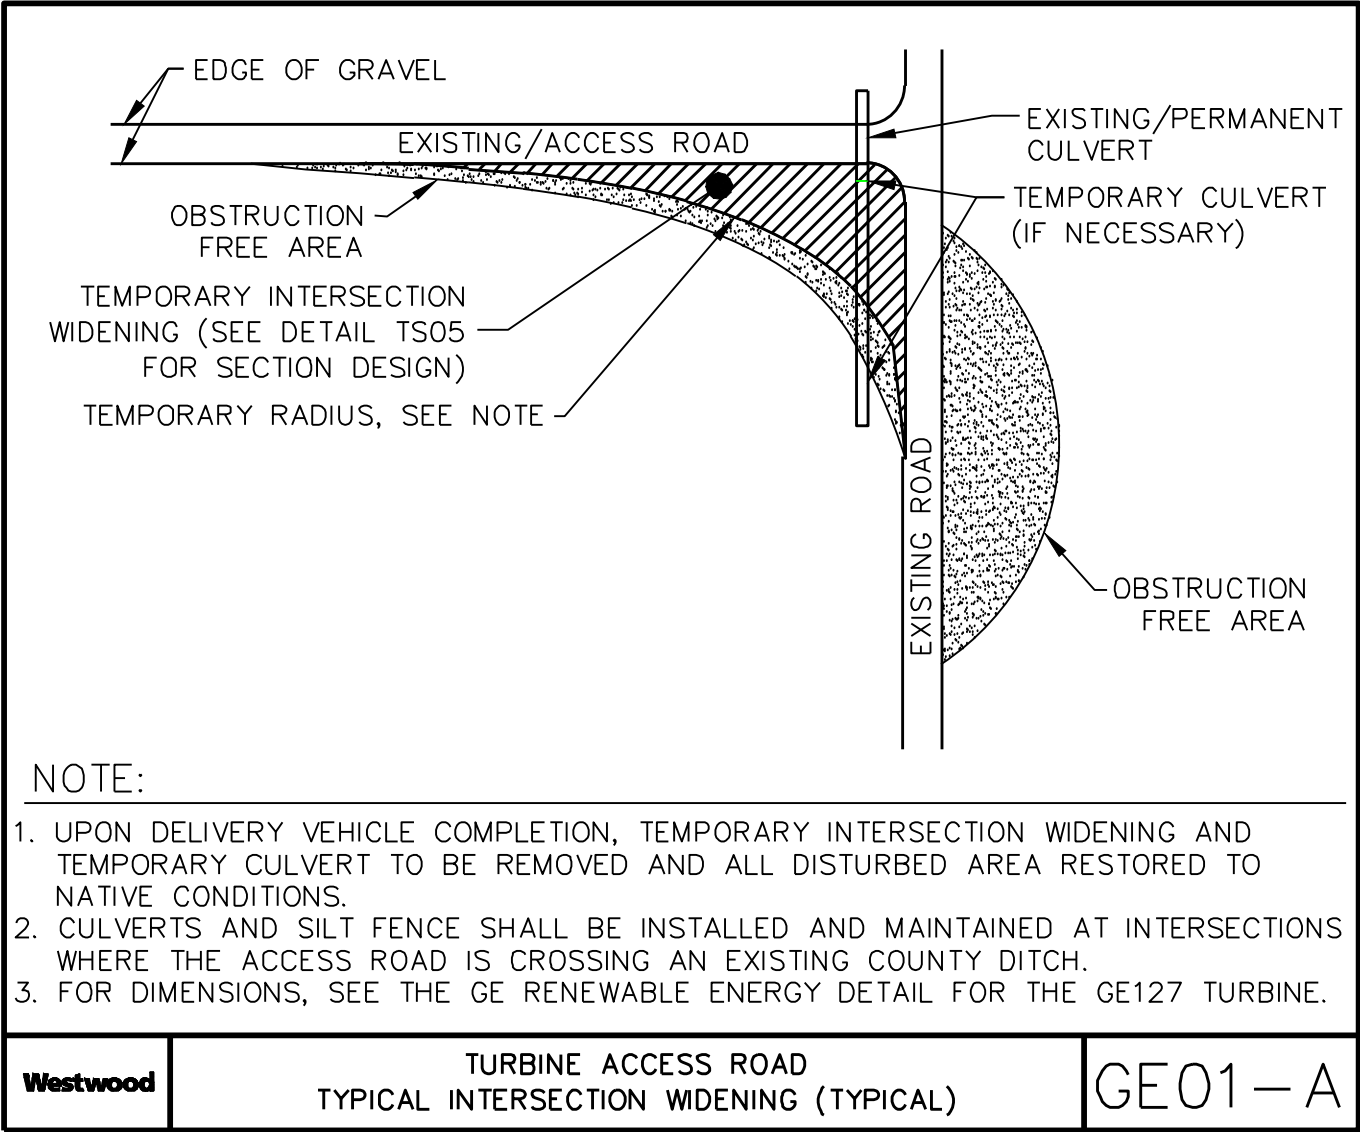

Westwood

TURBINE ACCESS ROAD  
TYPICAL INTERSECTION WIDENING (TYPICAL)


GE01-A

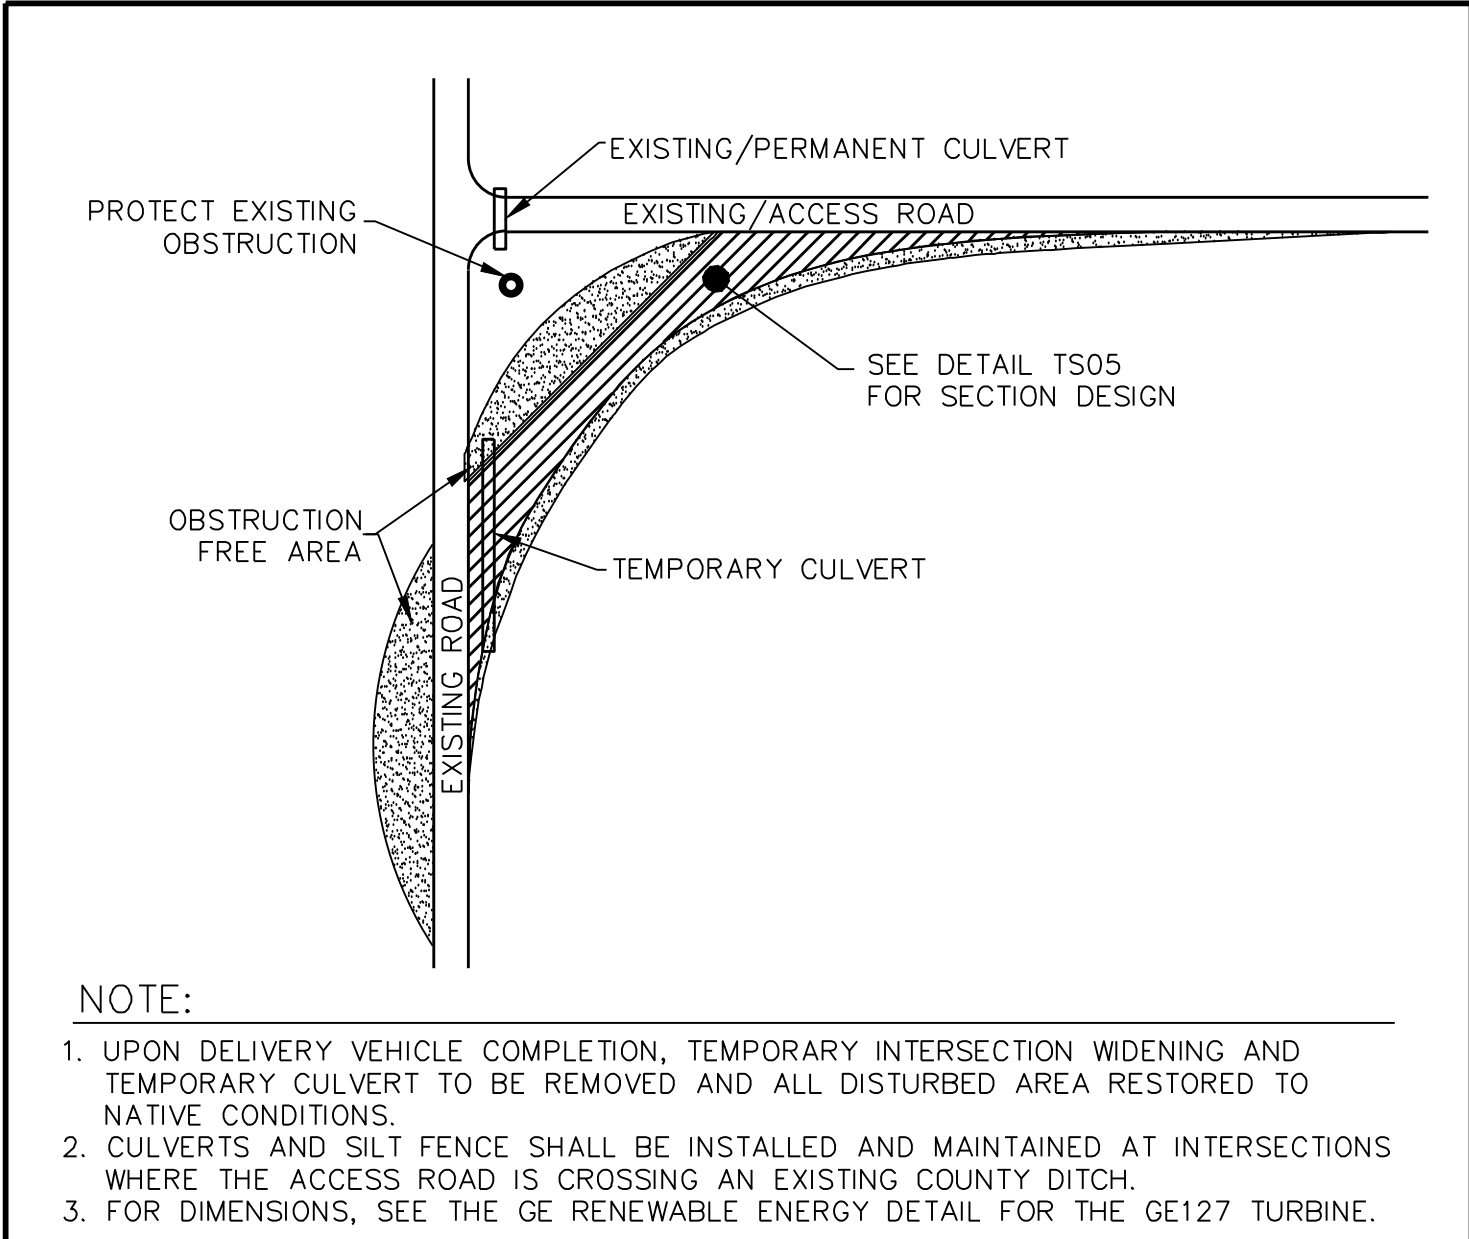

Westwood

TRUCK TRAFFIC TURNING LANE  
SWEEP (TYPICAL)


GE01-B

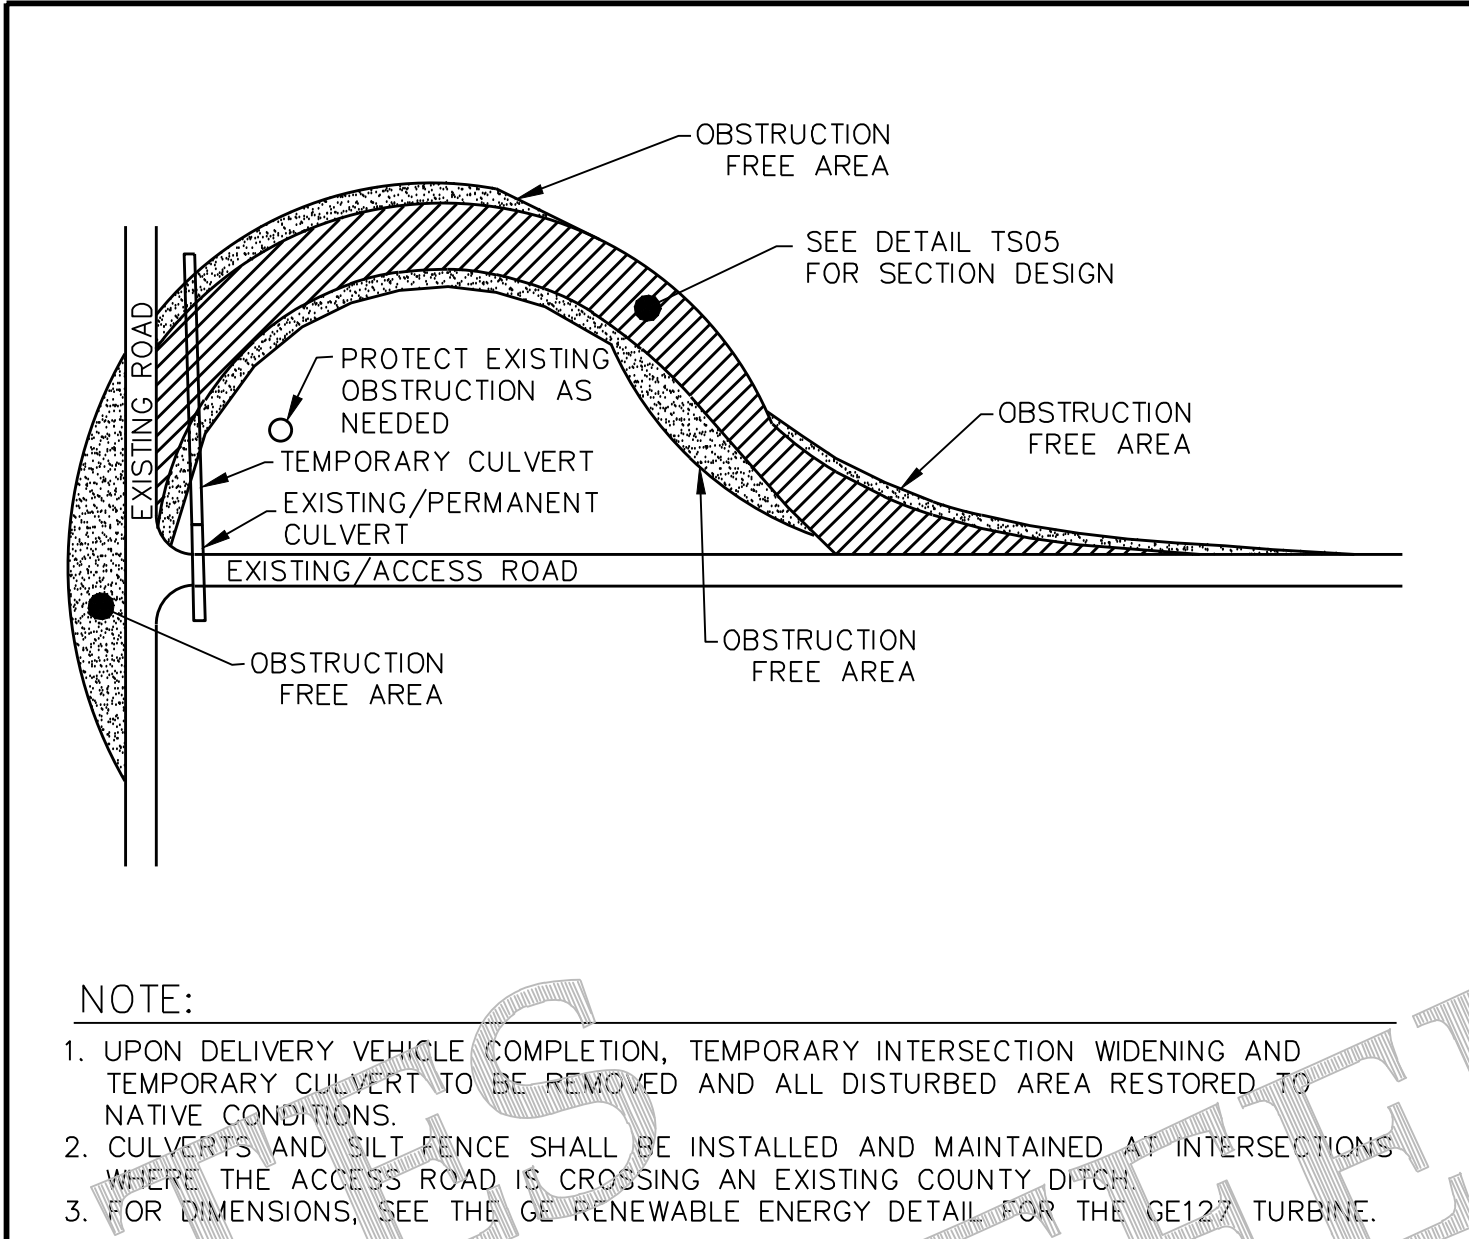

Westwood

TRUCK TRAFFIC TURNING LANE  
SWEEP (TYPICAL)


GE01-C

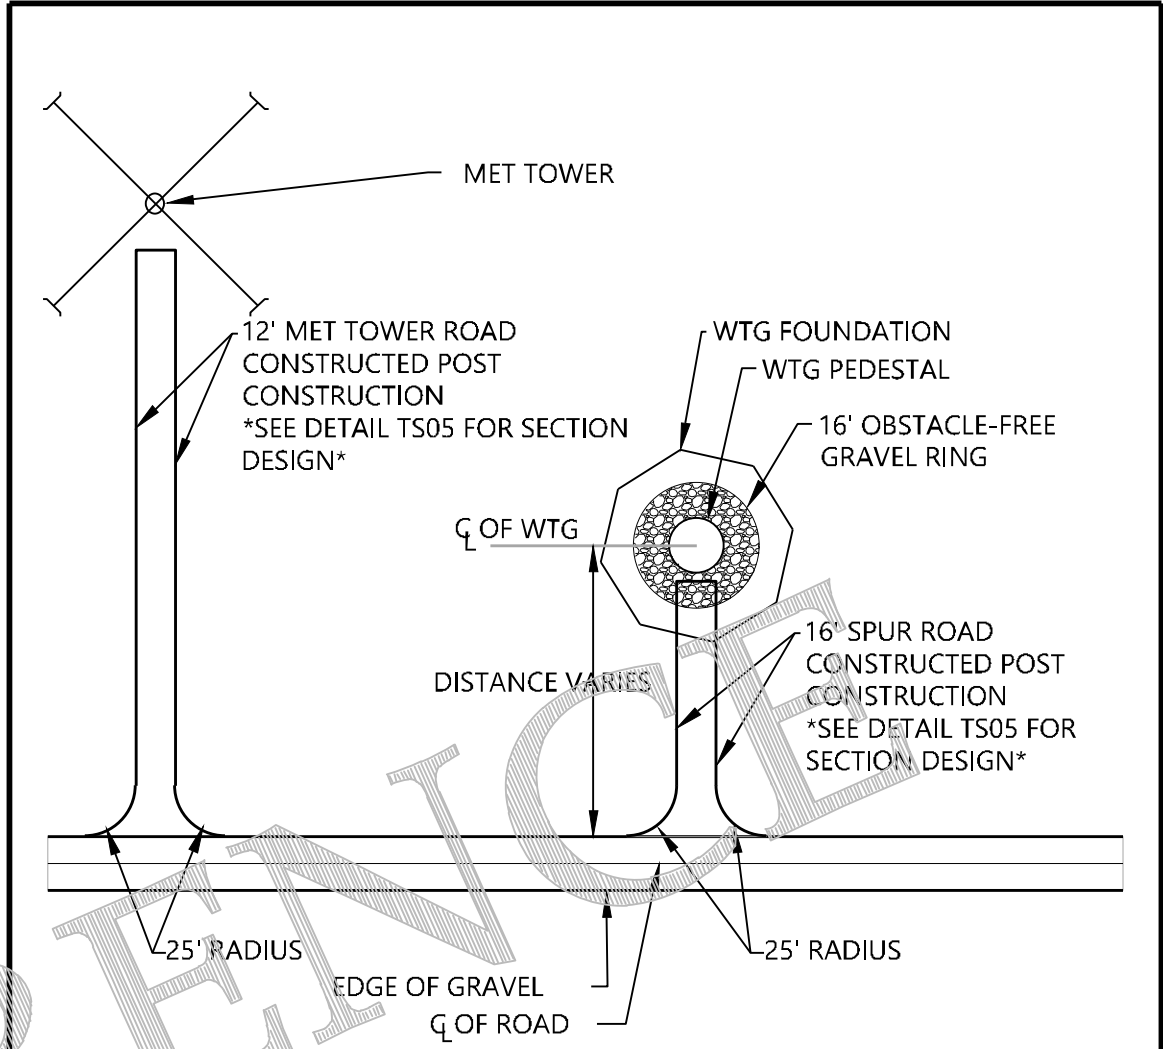

Westwood

TYPICAL SPUR AND MET  
TOWER ROAD (TYPICAL)


TS06

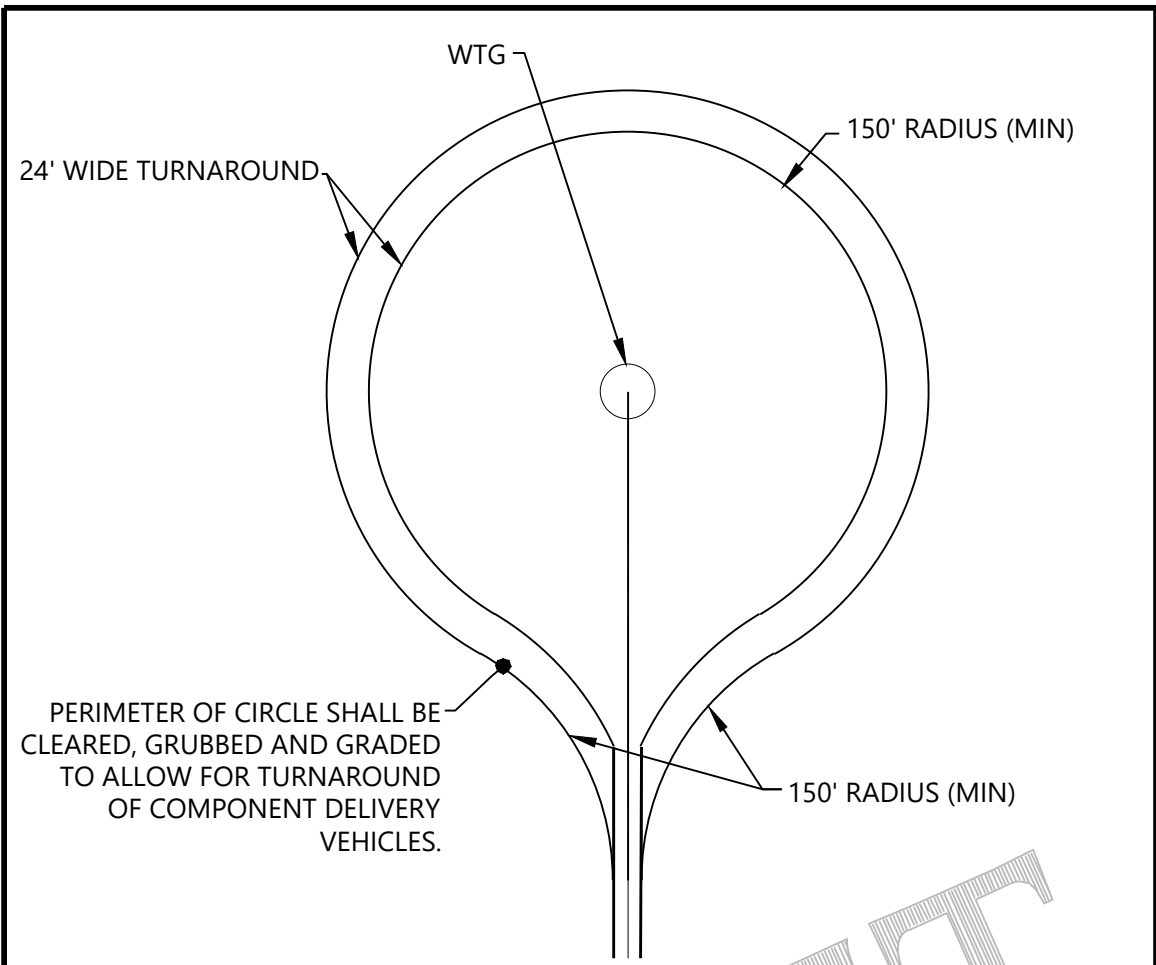

Westwood

PROPOSED CIRCULAR  
TURNAROUND (TYPICAL)


TS09

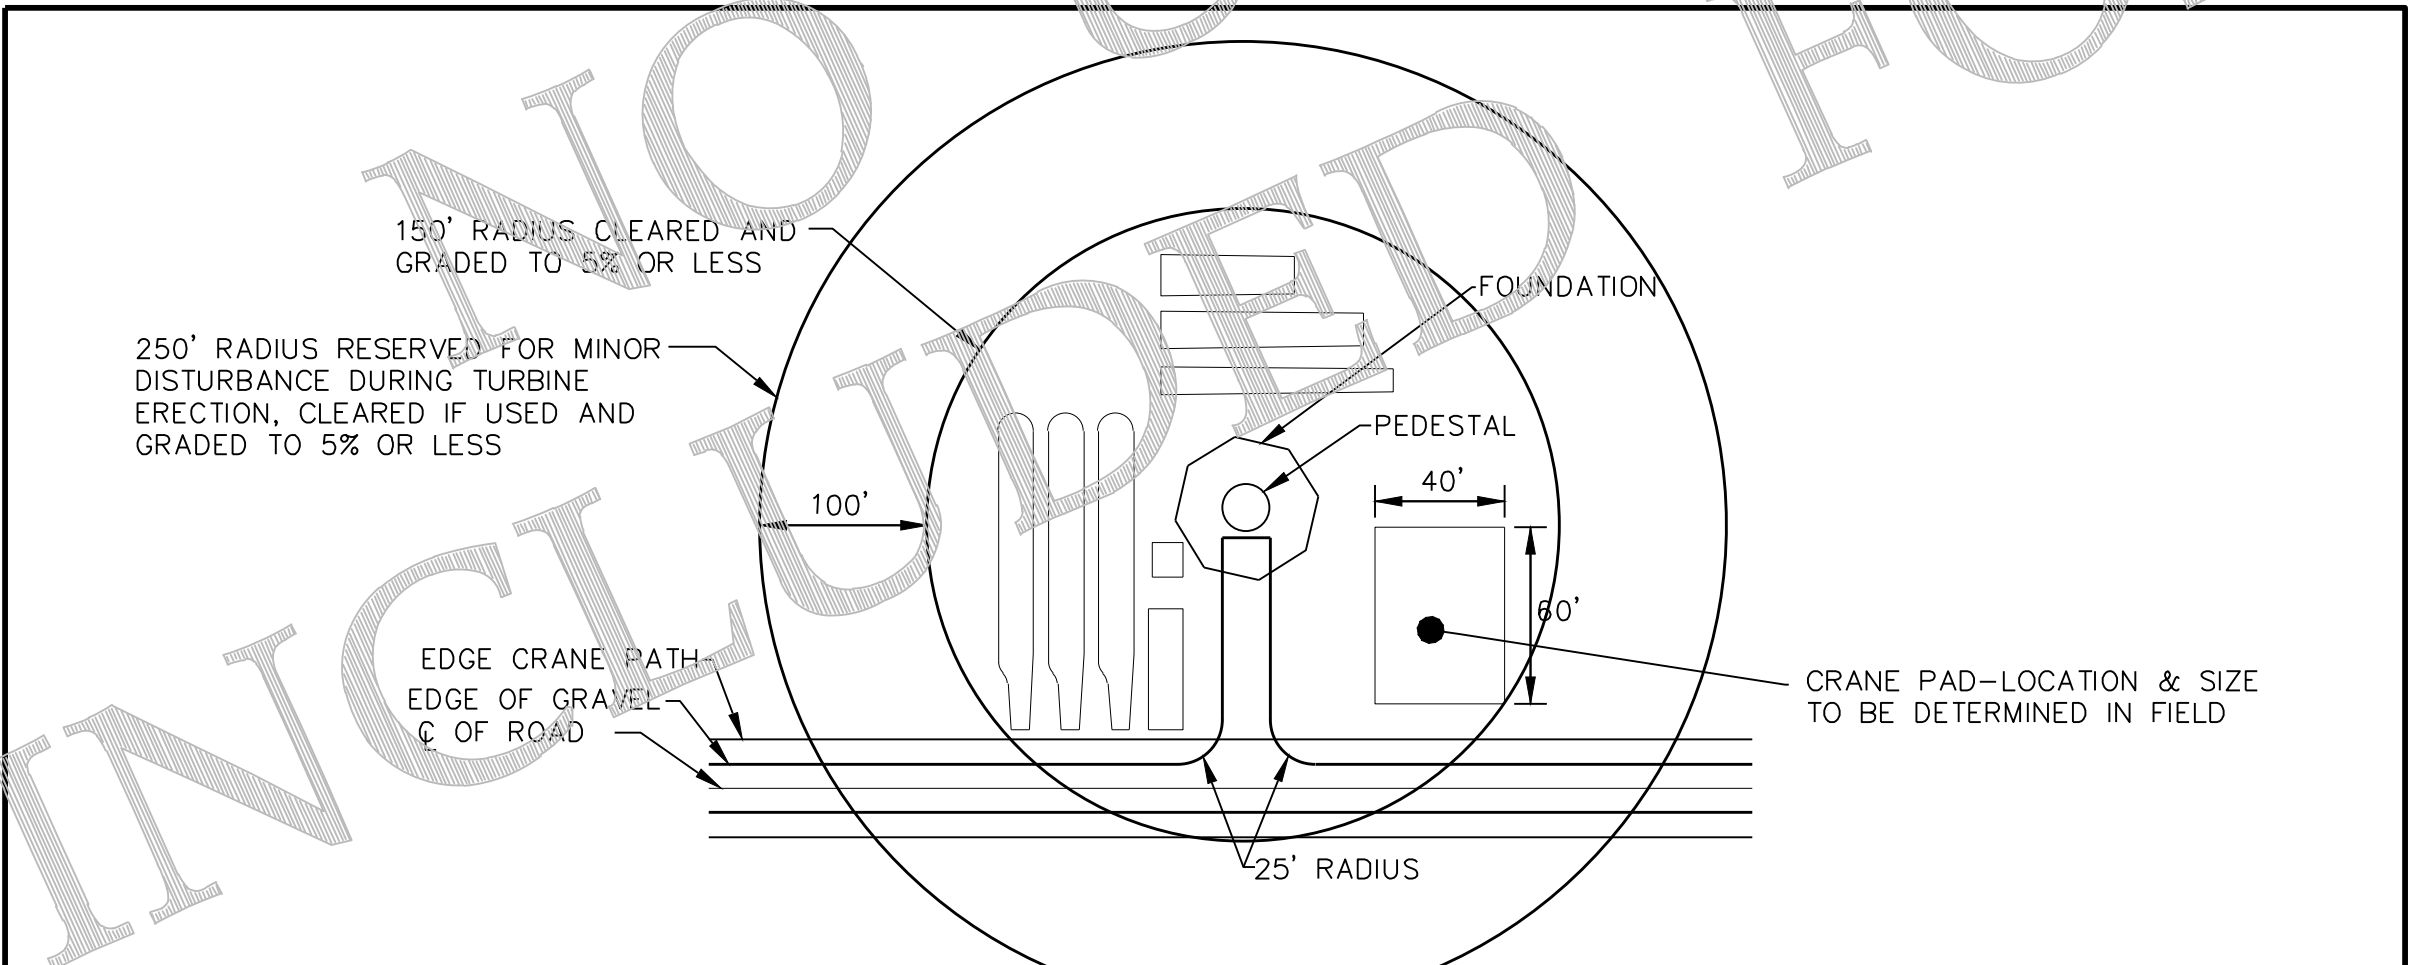

Westwood

TYPICAL WTG SITE - PLAN VIEW (TYPICAL)

TS01

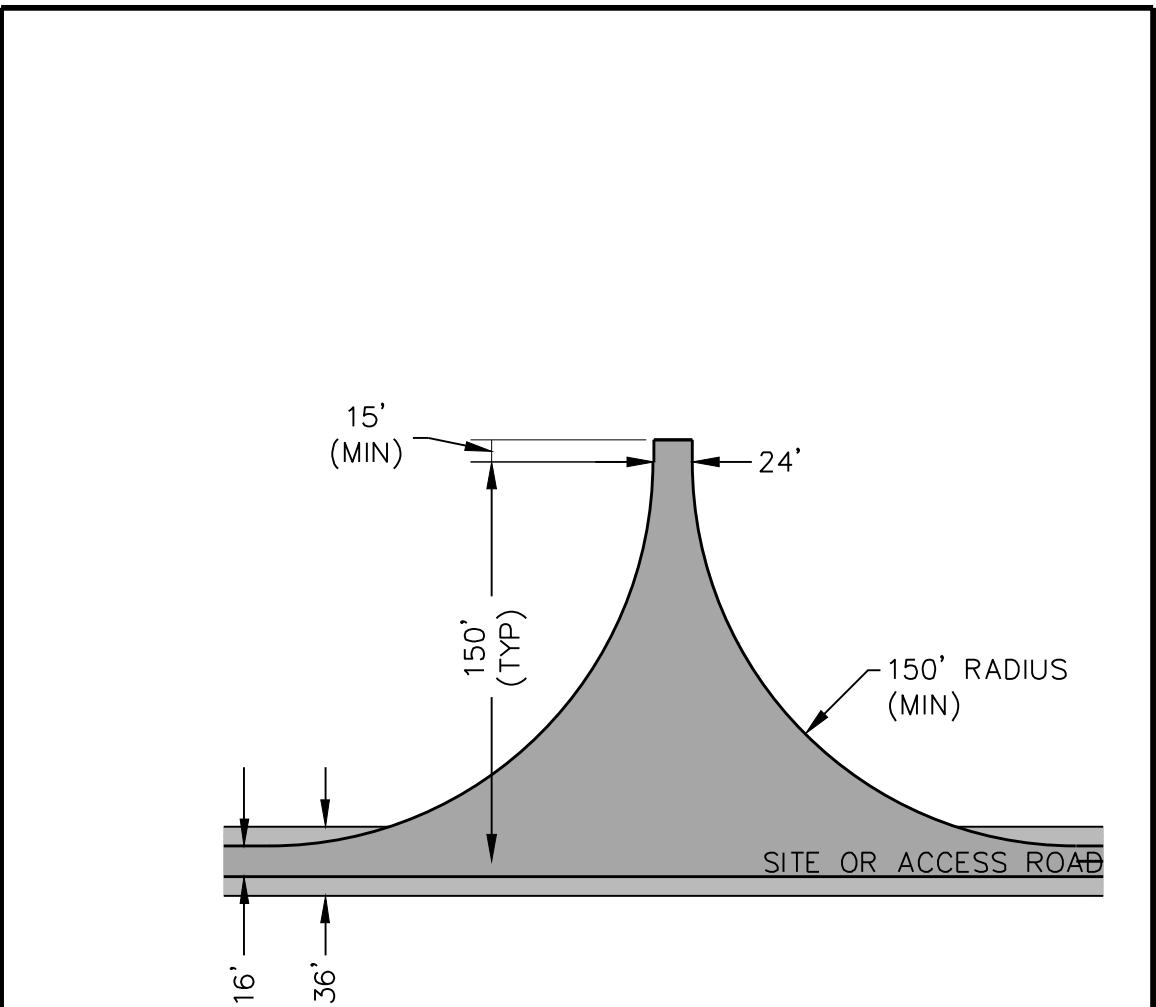

Westwood

TEMPORARY HAMMERHEAD TURNAROUND

TS10

**Westwood**


Phone (214) 473-4640 2740 Dallas Parkway, Suite 280  
Tollfree (888) 937-5150 Plano, TX 75093  
westwoodps.com  
Westwood Professional Services, Inc.

PREPARED FOR:





**BLATTNER**  
**ENERGY**

392 COUNTY RD 50  
AVON, MN 56310

ISSUE FOR RECORD

NO		REVISION	ZONE	DATE	BY	CHK	ENG	NO	REVISION	ZONE	DATE	BY	CHK	ENG	REFERENCE DRAWINGS			<div><div>NORTHERN STATES POWER COMPANY CROWNED RIDGE II WIND FARM CODINGTON, DEUEL, GRANT COUNTIES, SOUTH DAKOTA</div></div> <div><div>DWN: MDR    DATE: 11/12/2020    CHK: AA    DATE: 11/12/2020</div><div>ENG: MDR    DATE: 11/12/2020    CHK:    DATE:</div><div>PM: AA    DATE: 11/12/2020    PROJ. NO: 22590</div><div>APVD:    DATE:    SCALE: NONE</div></div> <div>THIS MAP/DOCUMENT IS A TOOL TO ASSIST EMPLOYEES IN THE PERFORMANCE OF THEIR JOBS. YOUR PERSONAL SAFETY IS PROVIDED FOR BY USING SAFETY PRACTICES, PROCEDURES, AND EQUIPMENT AS DESCRIBED IN THE SAFETY TRAINING PROGRAMS AND MANUALS.</div> <div>ENERGY SUPPLY ENGINEERING &amp; CONSTRUCTION</div>				UNIT 0 CIVIL ACCESS ROADS	
															DWG NO.	MANUFACTURER	DESCRIPTION					CONSTRUCTION DETAILS	
0		ISSUED FOR CONSTRUCTION		05/29/2020	MDR	AA	MDR																
1		ISSUED FOR RECORD - CROWNED RIDGE 22590		11/12/2020	MDR	AA	MDR																



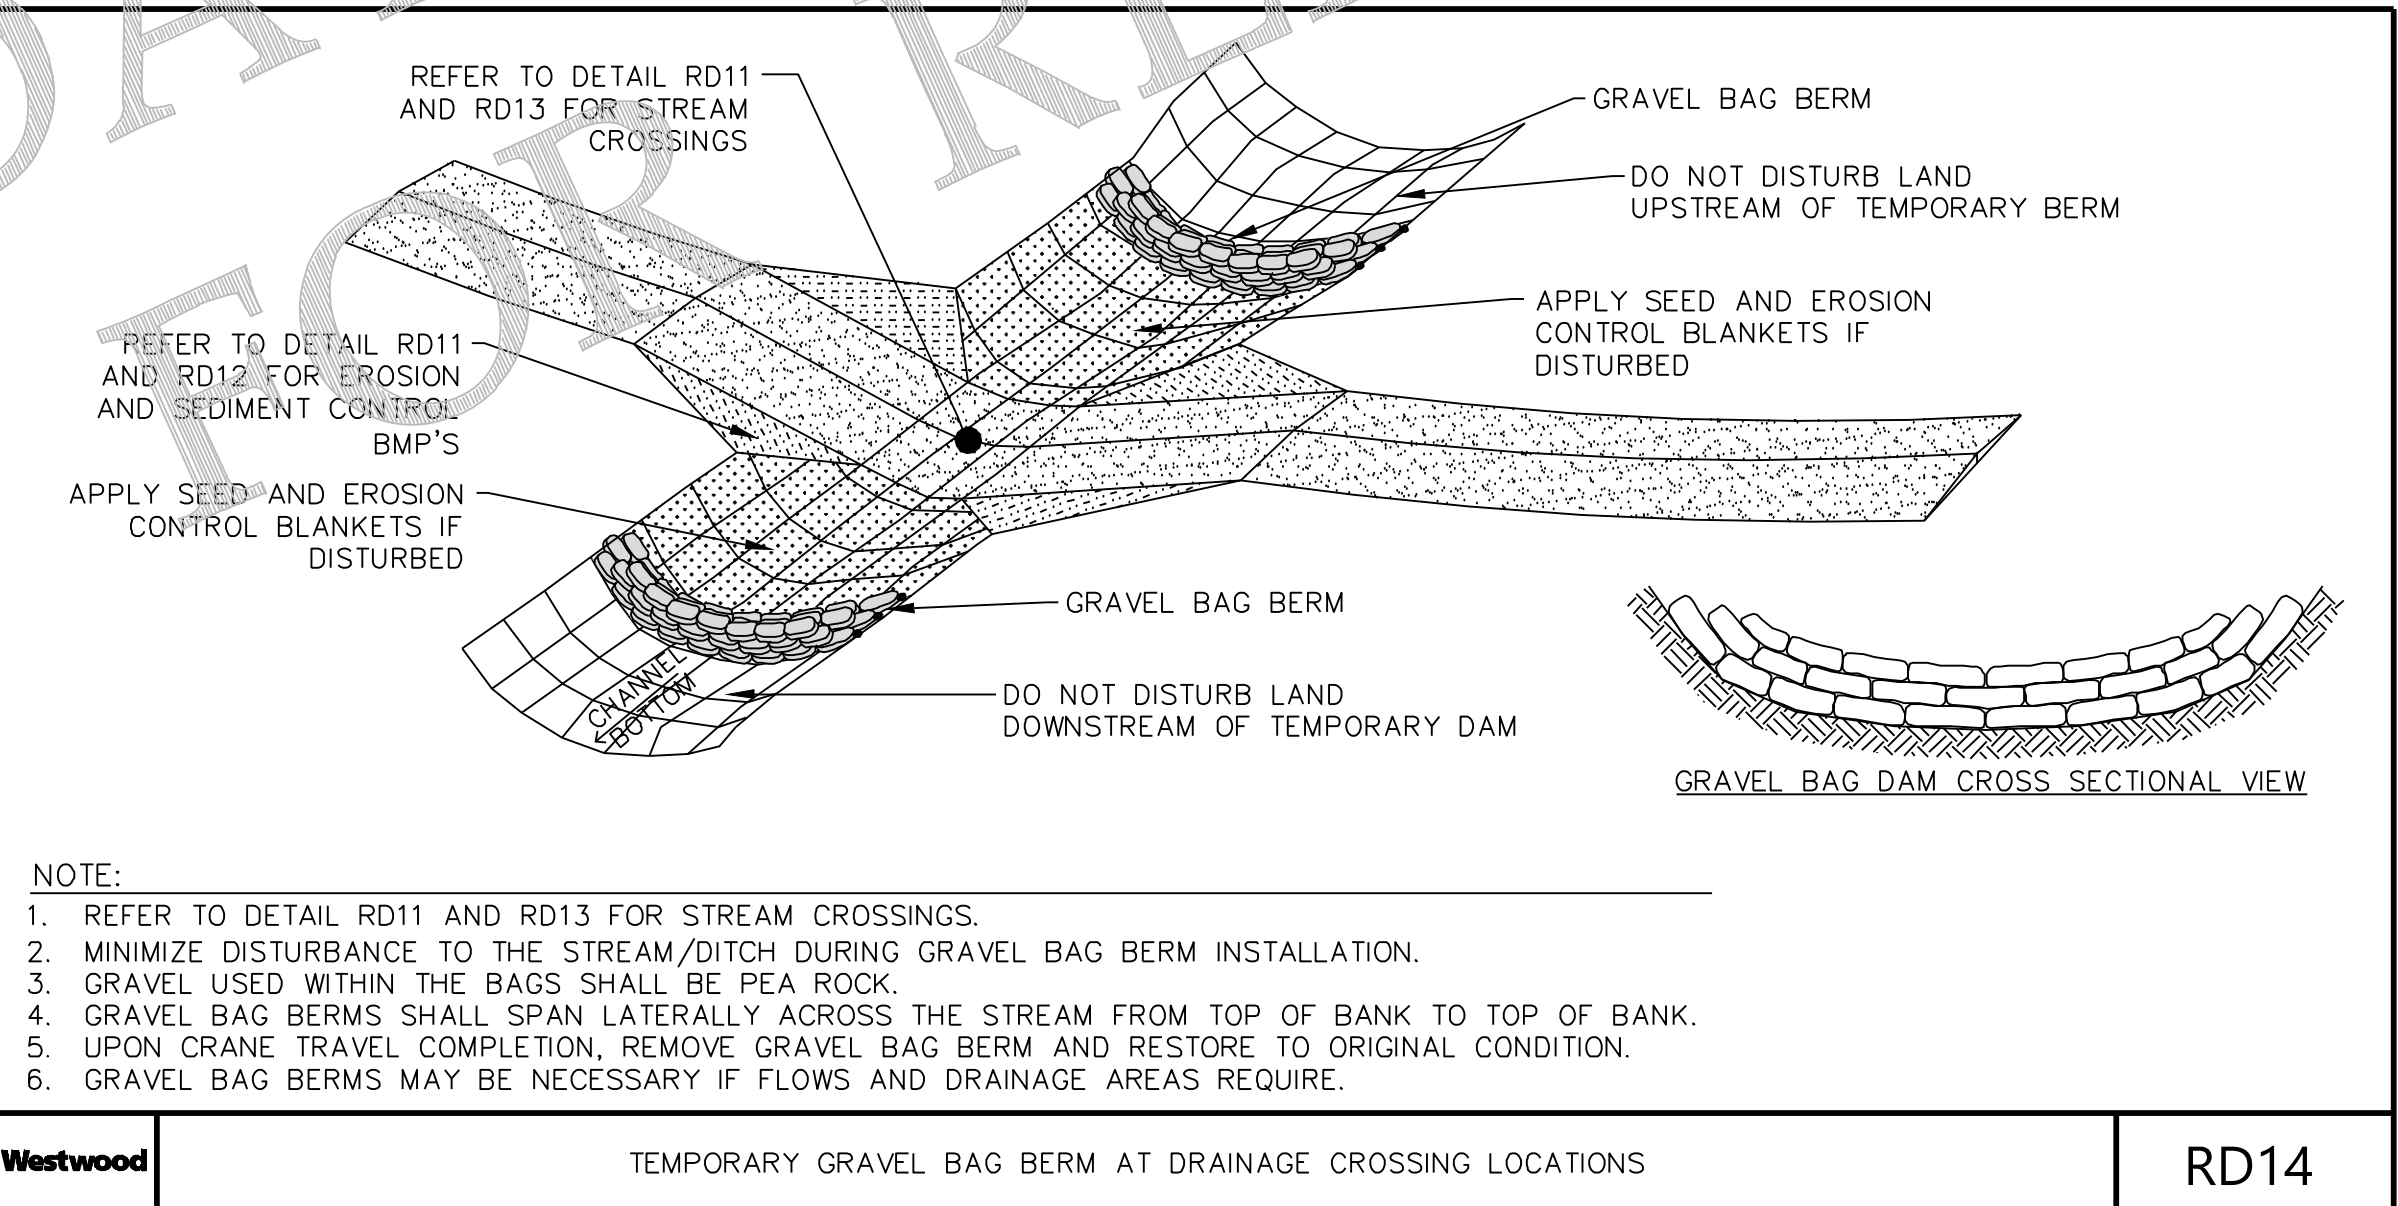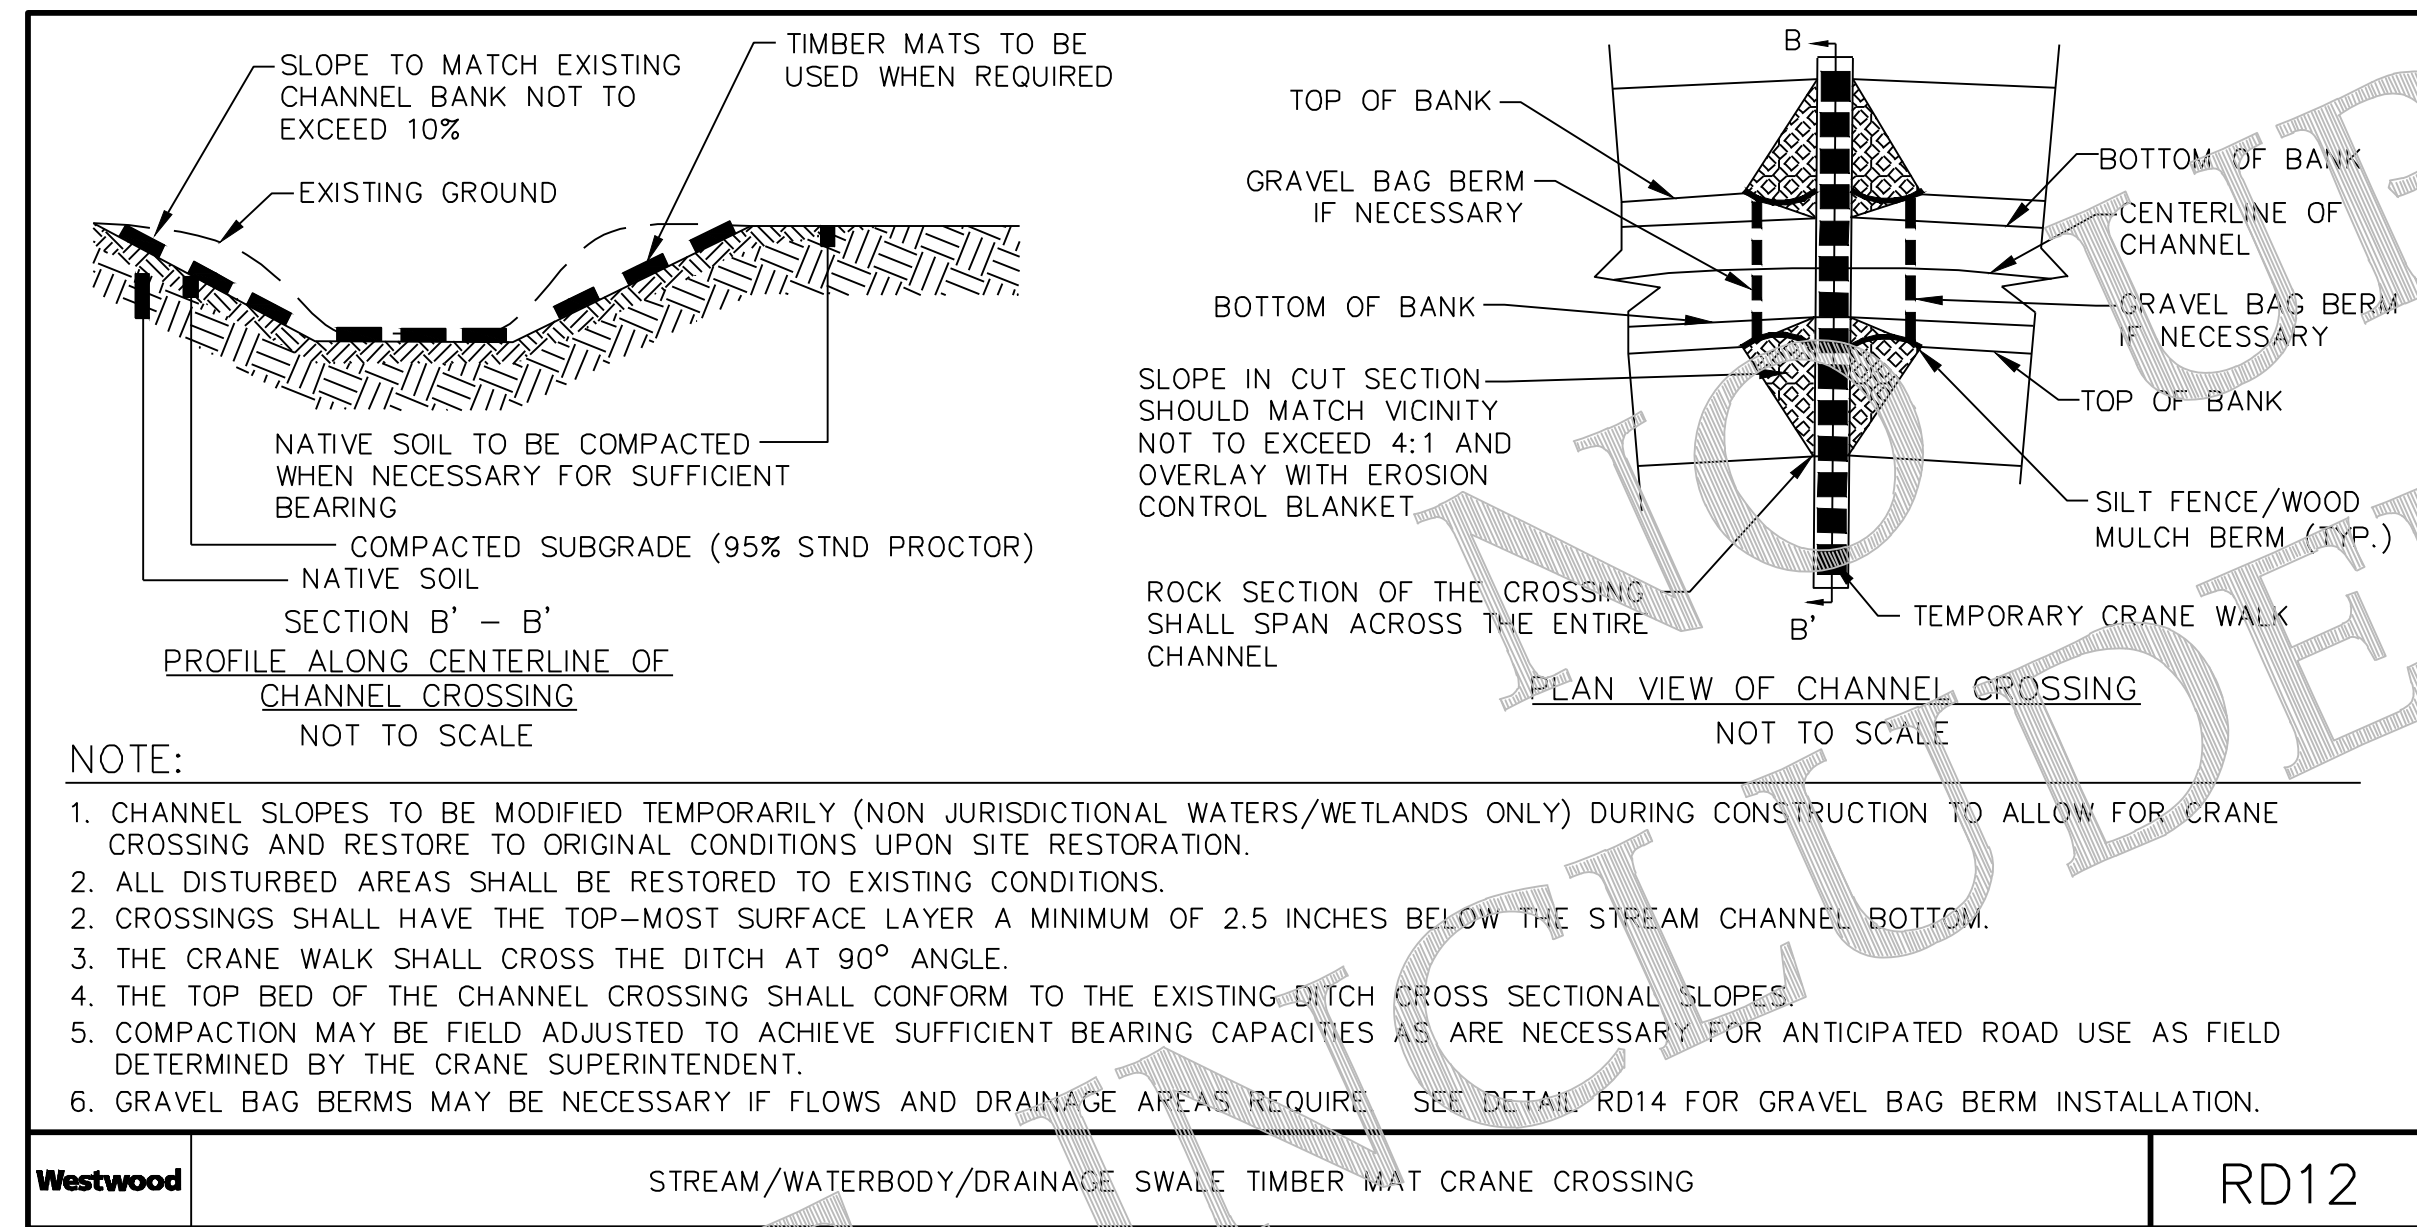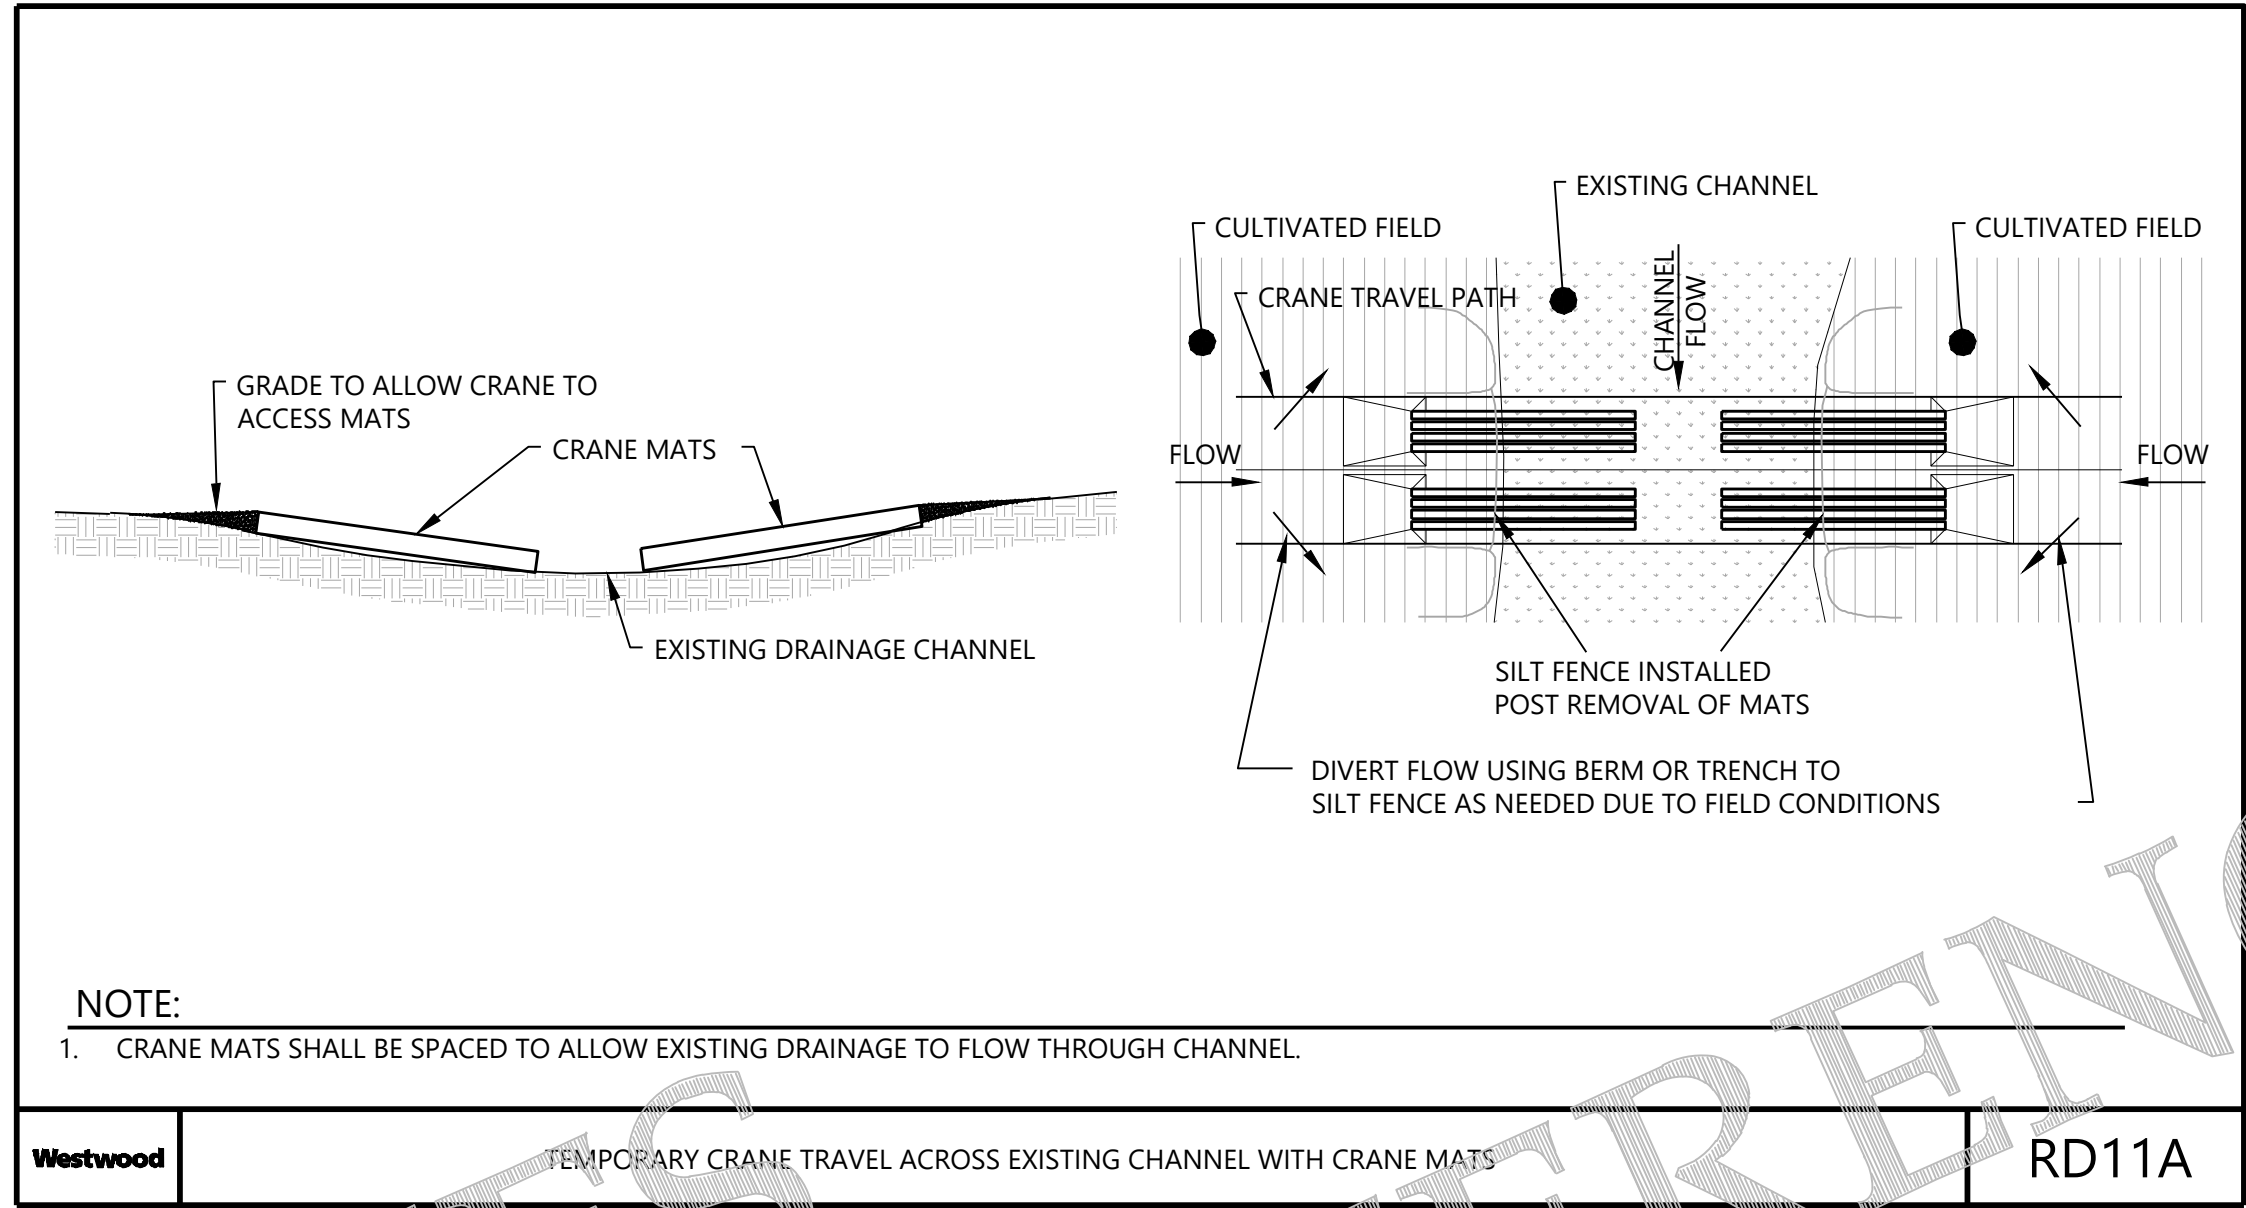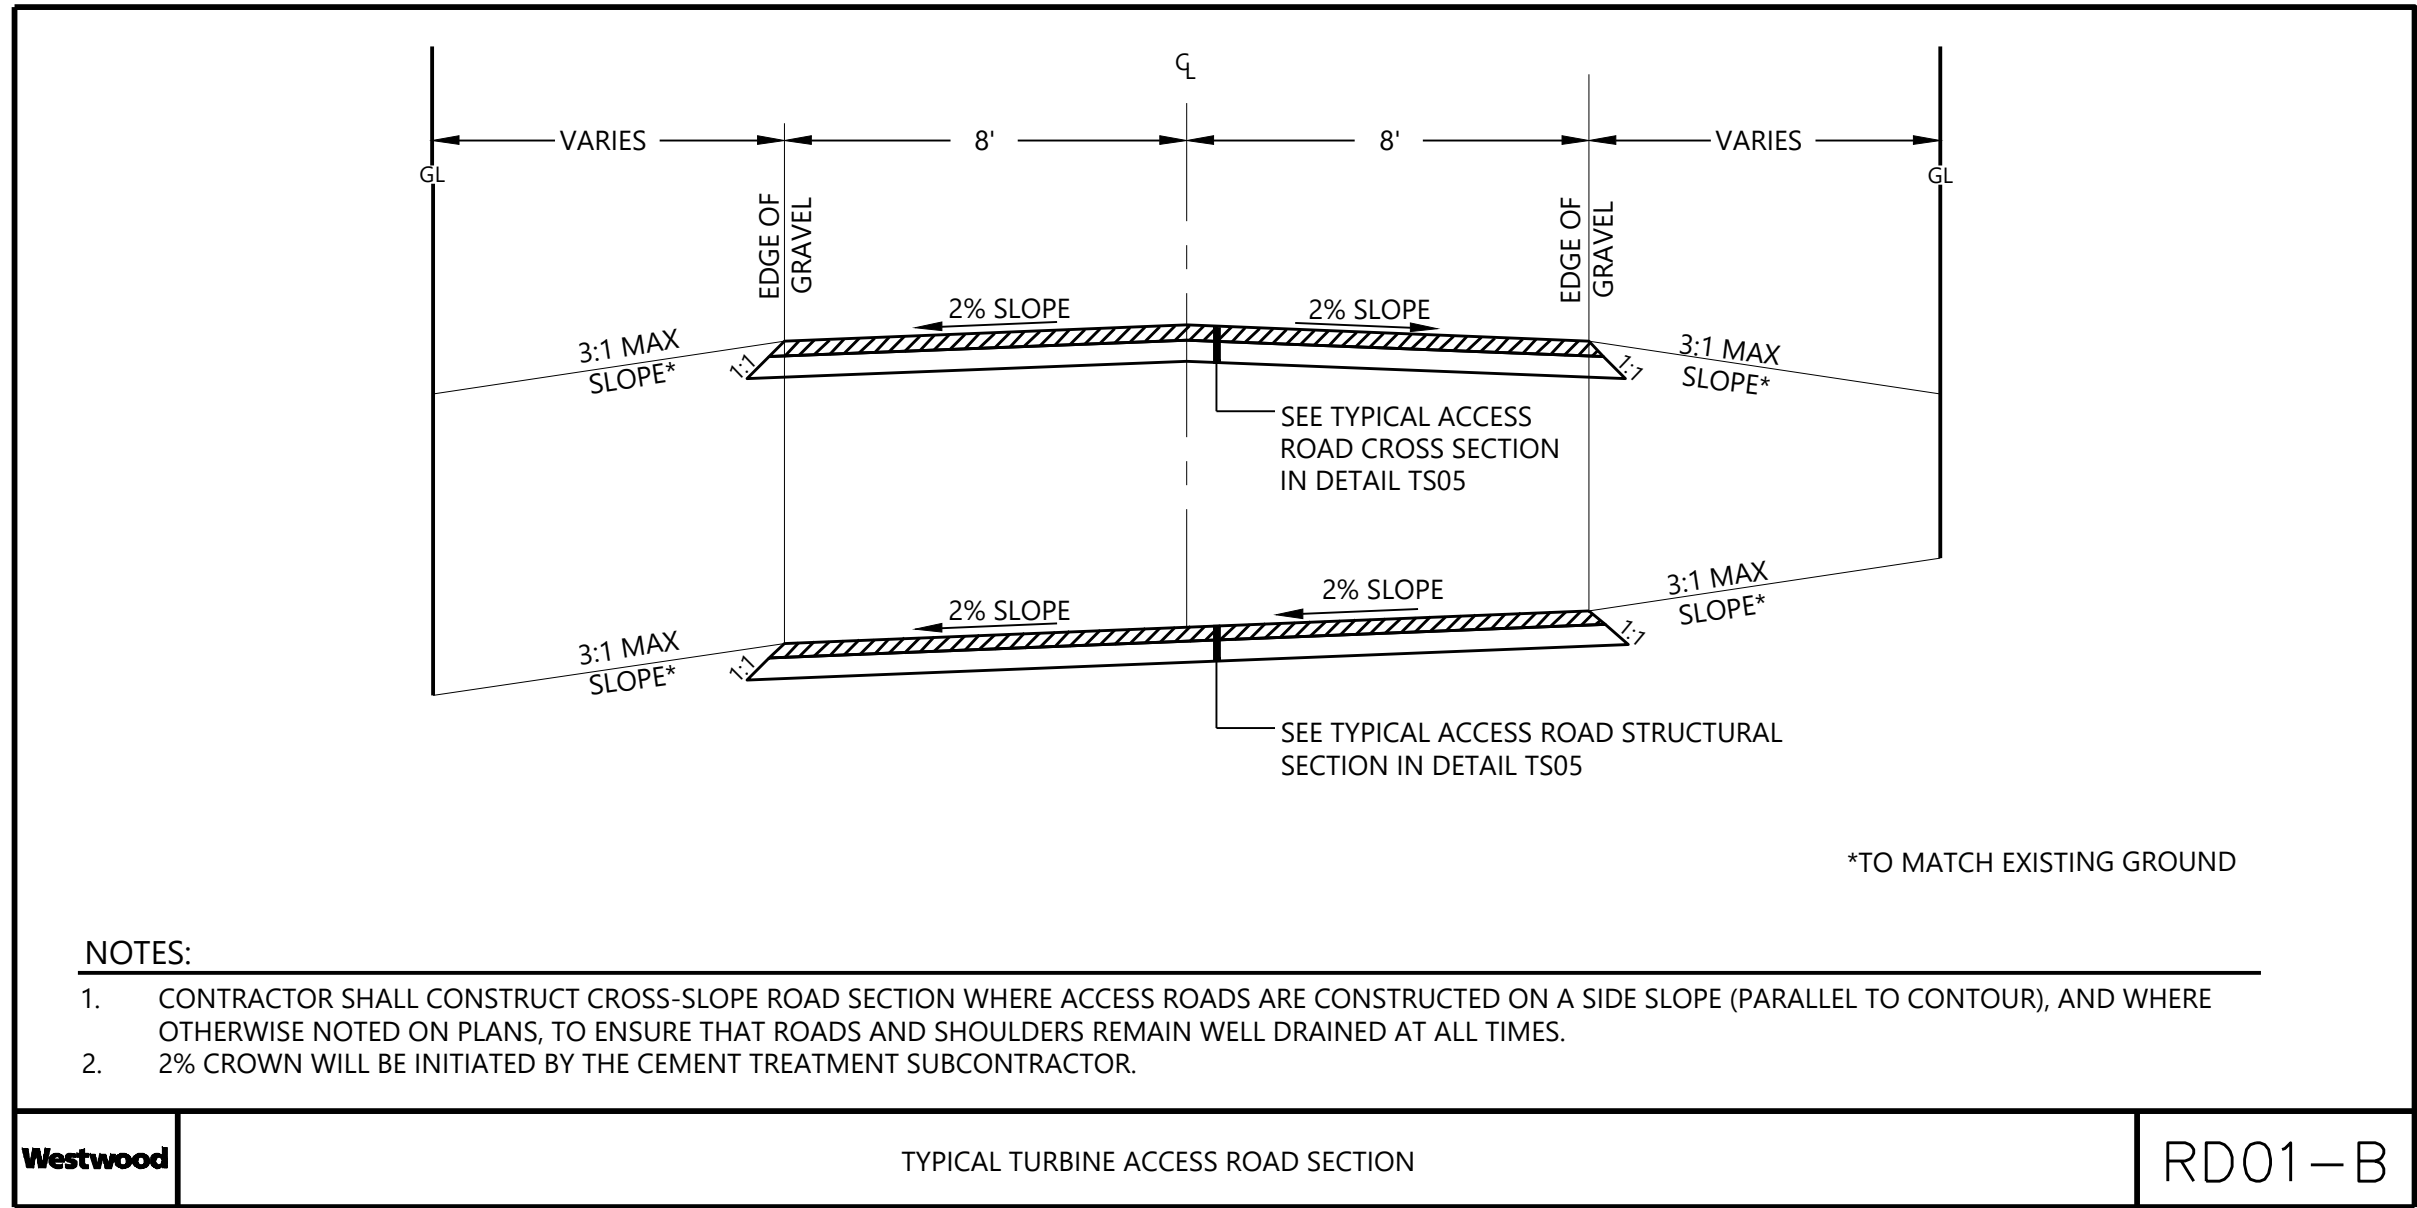

**Westwood**

Phone (214) 473-4640 2740 Dallas Parkway, Suite 280  
TollFree (888) 937-5150 Plano, TX 75093  
westwoodps.com


Westwood Professional Services, Inc.

PREPARED FOR:

**BLATTNER**  
**ENERGY**

392 COUNTY RD 50  
AVON, MN 56310

ISSUE FOR RECORD

NO		REVISION	ZONE	DATE	BY	CHK	ENG	NO	REVISION	ZONE	DATE	BY	CHK	ENG	REFERENCE DRAWINGS			 <b>NORTHERN STATES POWER COMPANY</b> <b>CROWNED RIDGE II WIND FARM</b> <small>CODINGTON, DEUEL, GRANT COUNTIES, SOUTH DAKOTA</small>	THIS MAP/DOCUMENT IS A TOOL TO ASSIST EMPLOYEES IN THE PERFORMANCE OF THEIR JOBS. YOUR PERSONAL SAFETY IS PROVIDED FOR BY USING SAFETY PRACTICES, PROCEDURES, AND EQUIPMENT AS DESCRIBED IN THE SAFETY TRAINING PROGRAMS AND MANUALS.	UNIT 0 CIVIL ACCESS ROADS	
														DWG NO.	MANUFACTURER	DESCRIPTION	CONSTRUCTION DETAILS				
0		ISSUED FOR CONSTRUCTION		05/29/2020	MDR	AA	MDR														
1		ISSUED FOR RECORD - CROWNED RIDGE 22590		11/12/2020	MDR	AA	MDR														



ROAD DESIGN PARAMETERS

- 1
1.

AGGREGATE-SURFACE ROADS WILL REQUIRE ONGOING MAINTENANCE TO KEEP THEM IN A SERVICEABLE CONDITION, REGARDLESS OF AGGREGATE THICKNESS AND SUBGRADE PREPARATION.
2.

IT IS NOT PRACTICAL TO DESIGN AN AGGREGATE SECTION OF ADEQUATE THICKNESS THAT PREVENTS ONGOING MAINTENANCE.
3.

RUTS, DEPRESSIONS, AND SOFT SUBGRADE MUST BE REPAIRED AS NEEDED TO FACILITATE TRAFFIC DURING CONSTRUCTION AND OVER THE LIFE OF THE PROJECT.

PRODUCTS

- 2
1.

TURBINE ACCESS ROAD BASE SHALL CONSIST OF LOCALLY SOURCED AGGREGATE MEETING THE GRADATION PROVIDED IN TABLE 1.
2.

LAYDOWN YARD/BATCH PLANT AGGREGATE BASE SHALL CONSIST OF LOCALLY SOURCED AGGREGATE MEETING THE GRADATION PROVIDED IN TABLE 1.
3.

ROAD SUBGRADE SHALL CONSIST OF COMPACTED NATIVE SOILS.
4.

CULVERTS: SEE PLAN FOR CULVERT LOCATIONS. CULVERTS SHALL BE A MINIMUM 16 GA. SPIRAL CORRUGATED METAL PIPE. TEMPORARY CULVERTS SHALL BE A MINIMUM DUAL WALL HDPE PIPE. CULVERTS SHALL MEET THE MINIMUM SPECIFICATIONS SET FORTH BY THE SOUTH DAKOTA DEPARTMENT OF TRANSPORTATION AND/OR CODINGTON, DEUEL, AND GRANT COUNTIES.

EXECUTION

- 3
1.

CLEARING AND GRUBBING

A.

THE CONTRACTOR SHALL BE REQUIRED TO REMOVE ALL TREES, STUMPS, BRUSH, AND DEBRIS WITHIN THE GRADING AREAS SHOWN ON THE PLANS.
2.

TOPSOIL STRIPPING

A.

ANY TOPSOIL, THAT HAS BEEN STRIPPED, SHALL BE RE-SPREAD OR STOCKPILED WITHIN GRADING AREAS AND/OR USED AS FILL OUTSIDE OF THE DISTURBANCE AREAS, AS DIRECTED BY THE ENGINEER. ALL TOPSOIL SHALL BE REDISTRIBUTED TO THE LAND OWNER'S PROPERTY OF WHERE IT ORIGINATED FROM.
3.

EMBANKMENT CONSTRUCTION

A.

EMBANKMENT CONSTRUCTION SHALL CONSIST OF THE PLACING OF SUITABLE FILL MATERIAL, AFTER TOPSOIL STRIPPING, ABOVE THE EXISTING GRADE. GENERALLY, EMBANKMENTS SHALL HAVE COMPACTED SUPPORT SLOPES OF ONE FOOT HORIZONTAL TO ONE FOOT VERTICAL. THE MATERIAL FOR EMBANKMENT CONSTRUCTION SHALL BE OBTAINED FROM THE ACCESS ROAD EXCAVATION (SEE GEOTECHNICAL REPORT FOR RESTRICTIONS), OR ANY SUITABLE, APPROVED SOIL OBTAINED OFFSITE BY CONTRACTOR, AS DIRECTED OR APPROVED BY THE ENGINEER. THIS MATERIAL SHALL BE PLACED IN LIFTS NOT TO EXCEED 9" FOR COHESIVE SOILS OR 12" FOR GRANULAR SOILS.

B.

SIDE SLOPES GREATER THAN 3:1 WILL NOT BE PERMITTED, UNLESS OTHERWISE NOTED ON THE PLAN OR TO NATURE CUNTURE.

STORM WATER DESIGN PARAMETERS

- 4
4.

SEE SHEET NH-275900-2-2 FOR CULVERT SIZING AND DESIGN PARAMETERS. SEE HYDROLOGY MEMO FOR FURTHER DESIGN CALCULATIONS. CULVERTS SHALL BE MINIMUM 18" CORRUGATED METAL PIPE. TEMPORARY CULVERTS SHALL BE MINIMUM 15" DUAL WALL HDPE PIPE. ALL TEMPORARY PORTIONS OF THE INSTALLED CULVERTS SHALL BE REMOVED UPON COMPLETION OF THE PROJECT.
5.

IT IS EXPECTED THAT CULVERTS WILL BE OVERTOPPED DURING SOME STORMS AND MAINTENANCE WILL BE REQUIRED THROUGH THE LIFE OF THE PROJECT.
6.

WHEN INSTALLING DRAINAGE CULVERTS THE CONTRACTOR SHALL USE JUDGEMENT IN SETTING THE FLOW LINE ELEVATIONS AND CULVERT LONGITUDINAL SLOPE. TYPICALLY THE FLOW LINE ELEVATIONS AND LONGITUDINAL SLOPE OF THE CULVERT SHOULD MATCH THE NATURAL GROUND ELEVATIONS AND SLOPE TO ENSURE POSITIVE DRAINAGE. WHEN POSSIBLE ALL CULVERTS SHOULD BE PLACED AT A MINIMUM 0.5% GRADE.
7.

ANTICIPATED CULVERT CROSSINGS ARE SHOWN ON THE CONSTRUCTION PLAN. ADDITIONAL CULVERTS MAY NEED TO BE INSTALLED IN AREAS WHERE CONCENTRATED FLOW IS EXPECTED DUE TO CONSTRUCTION ACTIVITIES.
8.

CONSTRUCTION DRAINAGE CROSSINGS TO MAINTAIN EXISTING FLOW CHARACTERISTICS OF THE FEATURES. FEATURES SHALL BE GRADED TO PRECONSTRUCTION CONTOURS.

TESTING:

1.
- TESTING SHALL BE PERFORMED BY A DESIGNATED INDEPENDENT TESTING AGENCY.
2.
- SUBMIT ONE SET OF TESTING AND INSPECTION RECORDS SPECIFIED TO THE CIVIL ENGINEER OF RECORD.
3.
- CONTRACTOR SHALL MAINTAIN A TESTING LOG TO ENSURE THAT TESTING IS PERFORMED AND RESULTS ARE ACCEPTABLE.

DEFINITIONS:

1.
- PROOF ROLLING:  
SHALL BE PERFORMED IN ACCORDANCE WITH THE GEOTECHNICAL REPORT AND IN THE PRESENCE OF THE GEOTECHNICAL ENGINEER OR QUALIFIED GEOTECHNICAL REPRESENTATIVE USING A FULLY LOADED TANDEM AXLE DUMP TRUCK OR WATER TRUCK WITH A MINIMUM GROSS WEIGHT OF 25 TONS OR A FULLY LOADED BELLY DUMP WITH AN EQUIVALENT AXLE LOADING. PROOF-ROLLING ACCEPTANCE STANDARDS INCLUDE NO RUTTING GREATER THAN 1.5 INCHES, AND NO "PUMPING" OF THE SOIL BEHIND THE LOADED TRUCK.
2.
- SIEVE ANALYSIS:  
SHALL BE CONDUCTED IN ACCORDANCE WITH AASHTO T27
3.
- PROCTORS:  
SHALL BE DETERMINED IN ACCORDANCE WITH AASHTO T99
4.
- ATTERBERG LIMITS:  
SHALL BE DETERMINED IN ACCORDANCE WITH AASHTO T89 AND T90
5.
- MOISTURE DENSITY (NUCLEAR DENSITY):  
SHALL BE DONE IN ACCORDANCE WITH AASHTO T310
6.
- DYNAMIC CONE PENETROMETER (DCP) TESTING:  
SHALL BE DONE IN ACCORDANCE WITH ASTM D6951-03

REQUIREMENTS:

1.
- FILL MATERIAL:  
A.
- SOILS USED AS FILL MATERIAL SHALL BE TESTED FOR MOISTURE CONTENT, ATTERBERG LIMITS ON FINES CONTENT, AND PROCTOR TESTS (STANDARD DRY MAX DENSITY) IN ACCORDANCE WITH THE GEOTECHNICAL REPORT RECOMMENDATIONS.
- B.
- IN ROADWAY CUT AREAS, OR WHERE EMBANKMENT CONSTRUCTION REQUIRES LESS THAN 12 INCHES OF FILL PLACEMENT, COMPACT TO A MINIMUM OF 95 PERCENT OF THE MATERIAL'S STANDARD PROCTOR MAXIMUM DRY DENSITY. THE SCARIFICATION DEPTH SHALL BE ADJUSTED SUCH THAT THE COMBINED THICKNESS OF THE EMBANKMENT FILL MATERIAL AND SCARIFICATION DEPTH SHALL BE 12 INCHES OR GREATER.
2.
- AGGREGATE BASE:  
A.
- AGGREGATE BASE SHALL BE PROOF-ROLLED OVER THE ENTIRE LENGTH. IF PROOF ROLLING DETERMINES THAT THE ROAD IS UNSTABLE, ADDITIONAL AGGREGATE SHALL BE ADDED UNTIL THE UNSTABLE SECTION IS ABLE TO PASS A PROOF ROLL.
- B.
- PROVIDE 1 SIEVE ANALYSIS (PROJECT MAX OF 20) PER 2500 CY OF ROAD BASE PLACED.
3.
- CRANE PAD AND CRANE PATHS / CRANE TRAVEL SHOULDERS:  
A.
- CRANE WALK AND CRANE PAD PREPARATION SPECIFICATION BY CONTRACTOR.

GENERAL NOTES:

1.
- GROUND SURFACE CONTOURS (AT TWO-FOOT VERTICAL INTERVALS) AND ELEVATIONS ARE BASED ON DATA PROVIDED BY BLATTNER ENERGY. IF MAJOR DISCREPANCIES ARE FOUND IN THE GROUND ELEVATIONS DURING FIELD STAKING TO THE GROUND ELEVATIONS SHOWN ON THE PLANS, THE OWNER AND ENGINEER SHALL BE NOTIFIED.
2.
- WHERE SECTION OR SUBSECTION MONUMENTS ARE ENCOUNTERED, THE OWNER SHALL BE NOTIFIED BEFORE SUCH MONUMENTS ARE REMOVED. THE CONTRACTOR SHALL PROTECT AND CAREFULLY PRESERVE ALL PROPERTY MARKERS AND MONUMENTS UNTIL THE OWNER, AN AUTHORIZED SURVEYOR OR AGENT HAS WITNESSED OR OTHERWISE REFERENCED THEIR LOCATION. THE CONTRACTOR IS RESPONSIBLE FOR REPLACING DAMAGED PROPERTY MARKERS AND MONUMENTS.
3.
- EFFORTS SHALL BE MADE TO MINIMIZE SOIL DISTURBANCE TO AREAS OUTSIDE OF THE ROAD GRADING LIMITS, CRANE PATHS, AND TURBINE SITES. TYPICAL DISTURBANCE SHALL BE LIMITED TO APPROXIMATELY 200 L.F. WIDE CORRIDOR FOR PROPOSED ACCESS ROADS AND CRANE TRAVEL PATHS, AND SHALL BE LIMITED TO AN APPROXIMATELY 300 L.F. RADIUS AROUND THE PROPOSED WIND TURBINE GENERATORS.
4.
- THE CONTRACTOR SHALL MAKE ALL EFFORTS TO KEEP ACTIVITIES WITHIN THE ERECTION AREAS SHOWN ON THE PLANS BUT IT IS UNDERSTOOD THAT SOME ACTIVITIES THAT WILL NOT REQUIRE GRADING OR SOIL DISTURBANCE MAY EXTEND BEYOND THE DEFINED LIMITS. DURING THE ERECTION OF THE ROTOR, TRUCKS AND/OR FORKLIFTS MAY EXTEND BEYOND THESE LIMITS. SEE DETAIL TS01 FOR TYPICAL ERECTION AREAS.
5.
- FINALIZE GRADING AROUND THE BASE OF TURBINES IN ACCORDANCE WITH DETAILS TS-03 AND TS-04.
6.
- IF LOCALIZED LOW POINTS ARE ENCOUNTERED DURING TOPSOIL STRIPPING, GRADE SURROUNDING AREA TO MAINTAIN POSITIVE DIRECTION OF DRAINAGE TO MINIMIZE PONDING OF STORMWATER DURING RAINFALL EVENT.
7.
- ANY FACILITIES REMOVED TO ALLOW FOR CONSTRUCTION (MAILBOXES, SIGNS, FENCES, ETC.) SHALL BE REPLACED BY THE CONTRACTOR IN A CONDITION AS GOOD AS EXISTING.
8.
- THE CONTRACTOR IS RESPONSIBLE FOR MAINTAINING DRAINAGE THROUGHOUT THE CONSTRUCTION OF THIS PROJECT. CONSTRUCTION ACTIVITIES SHALL NOT BLOCK THE NATURAL OR MANMADE CREEKS OR DRAINAGE SWALES CAUSING RAINWATER TO POND. DEPENDING ON FIELD CONDITIONS, ADDITIONAL CULVERTS IN EXCESS OF THOSE ON THE PLANS MAY BE REQUIRED.
9.
- WHILE BUILDING THE ROADS AND EXCAVATING THE TURBINE FOUNDATIONS, EXCESS SOIL WILL RESULT. THE CONTRACTOR SHALL DISPOSE OF THIS EXCESS SOIL IN AN APPROVED MANNER. EXCESS TOPSOIL SHALL BE DISTRIBUTED INTO A THIN LAYER ON LAND IMMEDIATELY ADJACENT TO WHERE THE TOPSOIL ORIGINATED. ALL EXCESS TOPSOIL TO BE WASTED ONSITE. WHILE DOING SO THE CONTRACTOR SHALL AVOID CAUSING RIDGES OR MOUNDS THAT WOULD MAKE IT DIFFICULT FOR STORM WATER RUNOFF TO DRAIN. THE FINAL SURFACE OF THE DISTURBED TOPSOIL SHALL BE SMOOTH AND FOLLOW THE NATURAL CONTOUR OF THE LAND.
10.
- THE CONTRACTOR SHALL NOTIFY SOUTH DAKOTA 811 AT LEAST 48 HOURS BEFORE EXCAVATION ACTIVITIES COMMENCE.
11.
- TEMPORARY INTERSECTION WIDENING SHALL, UPON COMPLETION OF ALL PROJECT CONSTRUCTION OR UPON NOTIFICATION OF THE ENGINEER, BE REMOVED AND THE AREA RESTORED TO ITS ORIGINAL LINES AND GRADES WITH TOPSOIL REPLACED, EXCEPT WHERE REQUESTED BY THE TOWNSHIP OR COUNTY TO PERMANENTLY REMAIN. DISTURBED AREAS OUTSIDE OF THE FINAL ROADWAY SHALL BE STABILIZED.
12.
- TURBINE SETBACKS ARE NOT IDENTIFIED ON THE CONSTRUCTION PLANS. IT SHALL BE THE RESPONSIBILITY OF THE OWNER AND CONTRACTOR TO ENSURE THAT ALL TURBINE SETBACKS MEET PROJECT REQUIREMENTS.
13.
- ELECTRICAL INFORMATION SHOWN ON THE PLANS IS FOR REFERENCE ONLY. REFER TO ELECTRICAL CONSULTANT'S PLANS FOR SPECIFIC LOCATIONS AND CONSTRUCTION DETAILS FOR THE UNDERGROUND POWER COLLECTION SYSTEM AND SUBSTATION.
14.
- FINAL GEOTECHNICAL REPORTS WITH RECOMMENDATIONS HAVE BEEN PROVIDED BY THE OWNER. ALL GRADING SHALL CONFORM TO THE GEOTECHNICAL ENGINEERING REPORT AND RECOMMENDATIONS FOR SLOPE STABILITIES.
15.
- FINAL CRANE PATH ALIGNMENTS SHALL BE DETERMINED BY THE CONTRACTOR BASED ON FIELD CONDITIONS WITHIN THE WETLAND AND CULTURAL RESOURCE CORRIDORS, SPECIAL LANDOWNER AGREEMENTS AND THE PROJECT BOUNDARY.
16.
- AN ALTA SURVEY HAS NOT BEEN PROVIDED. CONTRACTOR AND OWNER ARE RESPONSIBLE FOR LOCATING ALL UTILITIES AND VERIFYING LOCATION OF CONSTRUCTION ACTIVITIES PRIOR TO COMMENCING WORK.

STORMWATER POLLUTION PREVENTION PLAN (SWPPP):

1.
- THE CONTRACTOR SHALL PROVIDE EROSION CONTROL MEASURES AS PLANNED AND SPECIFIED FOLLOWING BEST MANAGEMENT PRACTICES AS OUTLINED BY THE SOUTH DAKOTA DEPARTMENT OF ENVIRONMENT & NATURAL RESOURCES AND BEING IN CONFORMANCE WITH THE NATIONAL POLLUTANT DISCHARGE ELIMINATION SYSTEM (NPDES) GENERAL STORMWATER PERMIT.
2.
- ALL PASTURES AND DRAINAGE SWALES DISTURBED DURING CONSTRUCTION ACTIVITIES AND NOT COVERED BY ROAD SURFACING MATERIALS, SHALL BE SEEDED IN ACCORDANCE WITH THE SWPP PLAN.
3.
- TEMPORARY EROSION CONTROL SHALL BE THE RESPONSIBILITY OF THE CONTRACTOR. THE TEMPORARY EROSION CONTROL PLAN SHALL BE IN ACCORDANCE WITH THE SOUTH DAKOTA DEPARTMENT OF ENVIRONMENT & NATURAL RESOURCES AND THE CROWNED RIDGE II WIND PROJECT STORMWATER POLLUTION PREVENTION PLAN ON FILE. IT IS THE CONTRACTOR'S/OPERATOR'S RESPONSIBILITY TO MAINTAIN COMPLIANCE.
4.
- ANY DISTURBED AREA SHALL BE STABILIZED PER THE SWPPP.
5.
- SEED MIX SHOULD BE AGREED UPON BY DEVELOPER AND LAND OPERATOR/OWNER.

Westwood

Phone (214) 473-4640 2740 Dallas Parkway, Suite 280  
TollFree (888) 937-5150 Plano, TX 75093  
westwoodps.com


Westwood Professional Services, Inc.

PREPARED FOR:


BLATTNER  
ENERGY

392 COUNTY RD 50  
AVON, MN 56310

ISSUE FOR RECORD

NO		REVISION	ZONE	DATE	BY	CHK	ENG	NO	REVISION	ZONE	DATE	BY	CHK	ENG	REFERENCE DRAWINGS			<div><div></div><div>NORTHERN STATES POWER COMPANY CROWNED RIDGE II WIND FARM CODDINGTON, DEUEL, GRANT COUNTIES, SOUTH DAKOTA</div></div>	THIS MAP/DOCUMENT IS A TOOL TO ASSIST EMPLOYEES IN THE PERFORMANCE OF THEIR JOBS. YOUR PERSONAL SAFETY IS PROVIDED FOR BY USING SAFETY PRACTICES, PROCEDURES, AND EQUIPMENT AS DESCRIBED IN THE SAFETY TRAINING PROGRAMS AND MANUALS.	UNIT 0 CIVIL ACCESS ROADS			
															DWG NO.	MANUFACTURER	DESCRIPTION			GENERAL NOTES			
0		ISSUED FOR CONSTRUCTION		05/29/2020	MDR	AA	MDR																
1		ISSUED FOR RECORD - CROWNED RIDGE 22590		11/12/2020	MDR	AA	MDR																
															DWN: MDR	DATE: 11/12/2020	CHK: AA	DATE: 11/12/2020					
															ENG: MDR	DATE: 11/12/2020	CHK:	DATE:					
															PM: AA	DATE: 11/12/2020	PROJ. NO: 22590						
															APVD:	DATE:	SCALE: NONE						



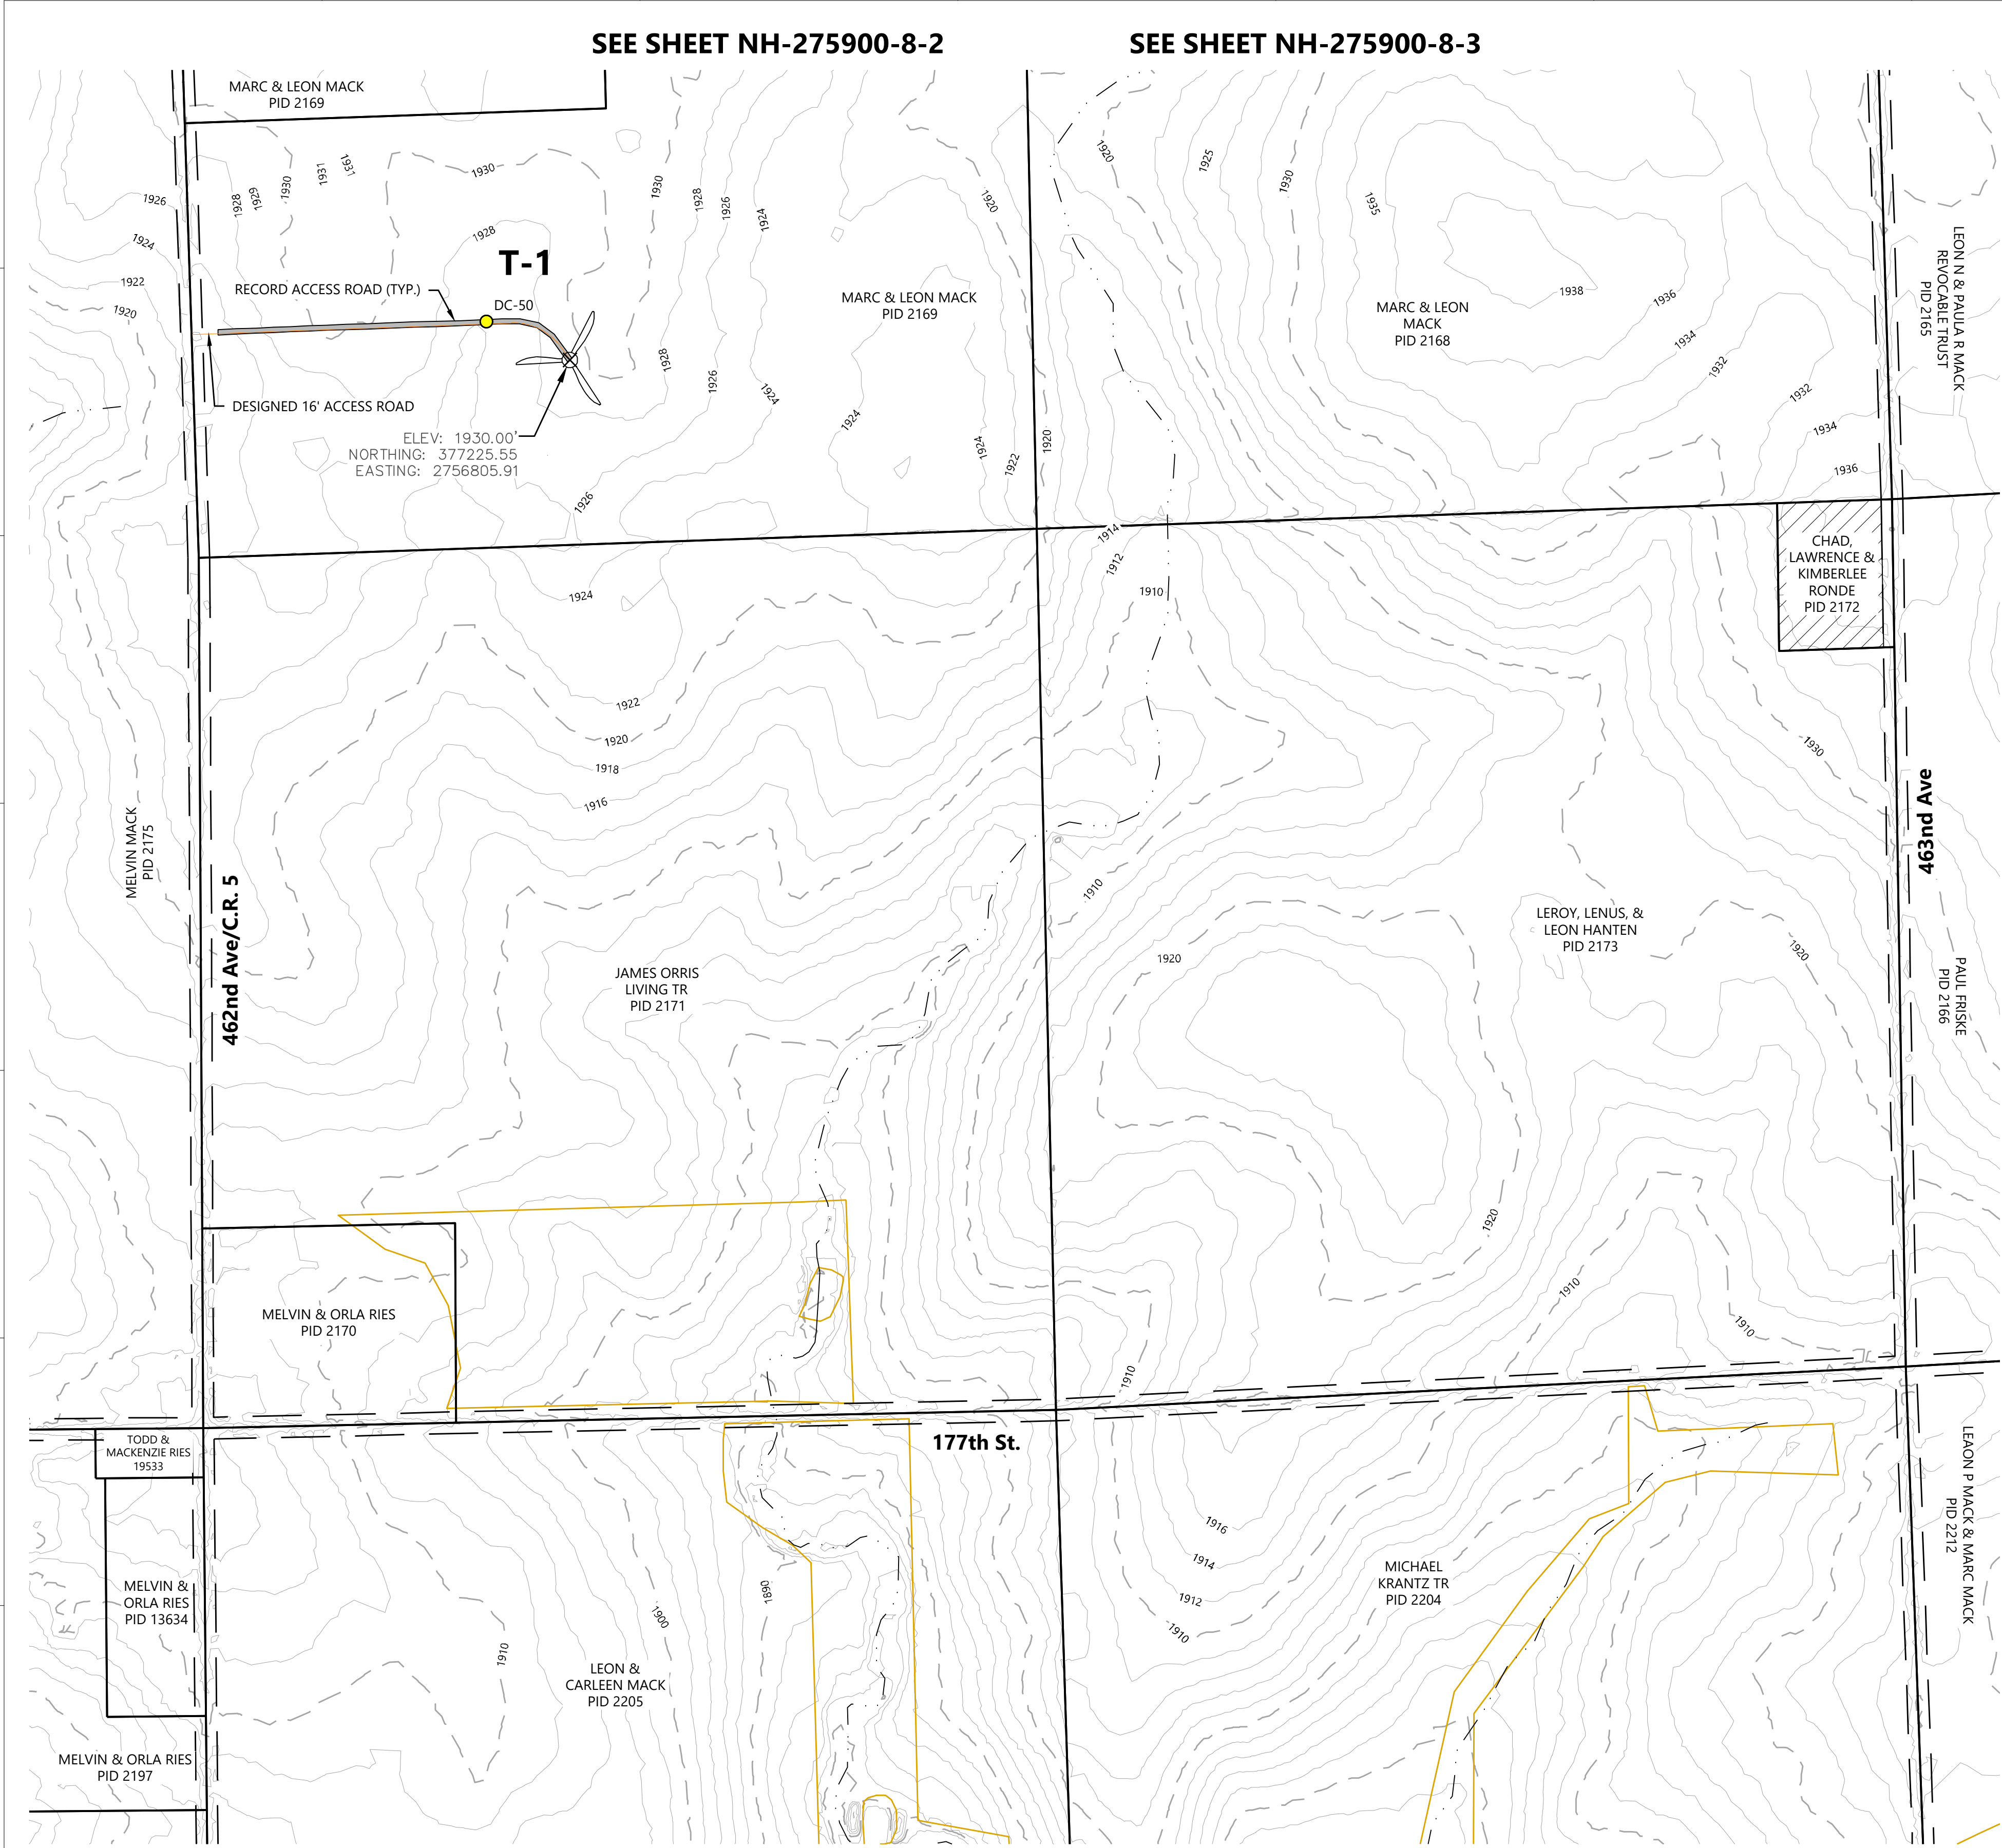

LEGEND:

T-#

RECORD TURBINE LOCATION

MET-XX

MET TOWER LOCATION

ADLS

ADLS RADAR LOCATION

DESIGNED ACCESS ROAD

RECORD ACCESS ROAD

P-PUG

DESIGNED UNDERGROUND COLLECTION

P-POH

DESIGNED OVERHEAD TRANSMISSION

NON-PARTICIPATING LAND

PROPERTY LINE

RIGHT-OF-WAY LINES

EASEMENT LINES

POH

EX. OVERHEAD POWER

GAS

EX. GAS PIPELINE

STREAM CHANNEL

EX. STREAM CHANNEL

WETLAND

EX. WETLAND

WATER SETBACK LINE

EX. WATER SETBACK LINE

FEMA FLOOD ZONE

PROTECTED WILDLIFE BUFFER LINE  
(FINAL BORDERS WILL BE DEFINED  
BY FINAL SWCA PLAN)

ARCHEOLOGICAL AVOIDANCE AREA

EXISTING LAKE

RECORD LOW WATER CROSSING

RECORD CULVERT

EX. INDEX CONTOUR

EX. INTERVAL CONTOUR

KEY MAP:


**Westwood**

Phone (214) 473-4640 2740 Dallas Parkway, Suite 280  
Toll Free (888) 937-5150 Plano, TX 75093  
westwoodps.com  
Westwood Professional Services, Inc.

PREPARED FOR:

**BLATTNER ENERGY**

392 COUNTY RD 50  
AVON, MN 56310

NO		REVISION	ZONE	DATE	BY	CHK	ENG	NO	REVISION		ZONE	DATE	BY	CHK	ENG	REFERENCE DRAWINGS			 <b>NORTHERN STATES POWER COMPANY</b> <b>CROWNED RIDGE II WIND FARM</b> <small>CODINGTON, DEUEL, GRANT COUNTIES, SOUTH DAKOTA</small>	THIS MAP/DOCUMENT IS A TOOL TO ASSIST EMPLOYEES IN THE PERFORMANCE OF THEIR JOBS. YOUR PERSONAL SAFETY IS PROVIDED FOR BY USING SAFETY PRACTICES, PROCEDURES, AND EQUIPMENT AS DESCRIBED IN THE SAFETY TRAINING PROGRAMS AND MANUALS.	UNIT 0 CIVIL ACCESS ROADS									
																DWG NO.	MANUFACTURER	DESCRIPTION			CIVIL SITE PLAN T-1									
0		ISSUED FOR CONSTRUCTION		05/29/2020	MDR	AA	MDR																							
1		ISSUED FOR RECORD - CROWNED RIDGE 22590		11/12/2020	MDR	AA	MDR																							
DWN: MDR		DATE: 11/12/2020		CHK: AA		DATE: 11/12/2020														ENG: MDR		DATE: 11/12/2020		CHK:		DATE:		ENERGY SUPPLY ENGINEERING & CONSTRUCTION	NH-275900-8-1	REV 1
PM: AA		DATE: 11/12/2020		PROJ. NO: 22590														APVD:		DATE:		SCALE: 1" = 300'								







**SEE SHEET NH-275900-8-4**



**SEE SHEET NH-275900-8-1**

**T-#**  
RECORD TURBINE LOCATION

**MET-XX**  
MET TOWER LOCATION

**ADLS**  
ADLS RADAR LOCATION

DESIGNED ACCESS ROAD

RECORD ACCESS ROAD

DESIGNED UNDERGROUND COLLECTION

DESIGNED OVERHEAD TRANSMISSION

NON-PARTICIPATING LAND

PROPERTY LINE

RIGHT-OF-WAY LINES

EASEMENT LINES

POH  
GAS

EX. OVERHEAD POWER  
EX. GAS PIPELINE  
EX. STREAM CHANNEL  
EX. WETLAND  
WATER SETBACK LINE  
FEMA FLOOD ZONE  
PROTECTED WILDLIFE BUFFER LINE  
(FINAL BORDERS WILL BE DEFINED BY FINAL SWCA PLAN)  
ARCHAEOLOGICAL AVOIDANCE AREA

EXISTING LAKE


RECORD LOW WATER CROSSING

DC-XX

RECORD CULVERT

EX. INDEX CONTOUR  
EX. INTERVAL CONTOUR

A triangular arrangement of 36 boxes, each containing a subtraction problem. The boxes are arranged in a grid-like pattern, with some boxes containing the same problem. The problems are: 8-48, 8-47, 8-46, 8-45, 8-42, 8-41, 8-44, 8-43, 8-39, 8-40, 8-37, 8-38, 8-34, 8-33, 8-36, 8-35, 8-31, 8-32, 8-29, 8-30, 8-25, 8-24, 8-22, 8-21, 8-20, 8-28, 8-26, 8-23, 8-19, 8-18, 8-17, 8-14, 8-15, 8-16, 8-13, 8-12, 8-11, 8-10, 8-9, 8-8, 8-7, 8-6, 8-5, 8-4, 8-3, 8-2, 8-1.

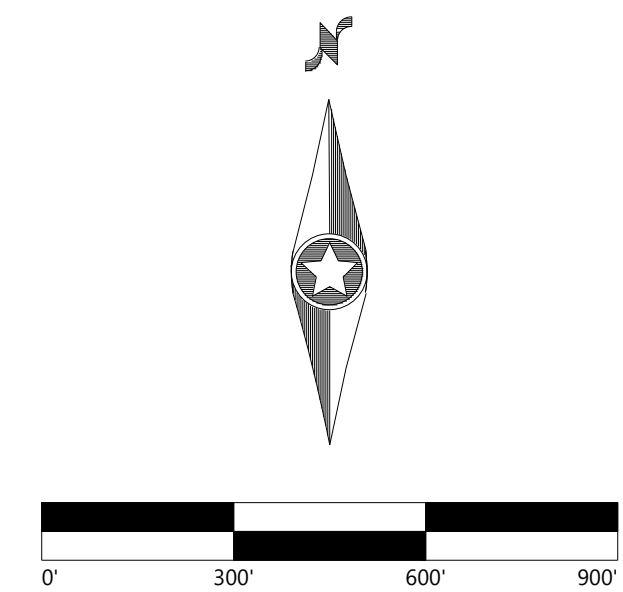

# Westwood

Phone (214) 473-4640 2740 Dallas Parkway, Suite 280  
Toll Free (888) 937-5150 Plano, TX 75093  
westwoodps.com

Westwood Professional Services, Inc.


---

PREPARED FOR:

**BLATTNER**  
**ENERGY**

392 COUNTY RD 50  
AVON, MN 56310

ISSUE FOR RECORD

REVISION							REVISION							REFERENCE DRAWINGS							<div><p><b>THIS MAP/DOCUMENT IS A TOOL TO ASSIST EMPLOYEES IN THE PERFORMANCE OF THEIR JOBS. YOUR PERSONAL SAFETY IS PROVIDED FOR BY USING SAFETY PRACTICES, PROCEDURES, AND EQUIPMENT AS DESCRIBED IN THE SAFETY TRAINING PROGRAMS AND MANUALS.</b></p><p><b>UNIT 0</b> <b>CIVIL ACCESS ROADS</b></p><p><b>CIVIL SITE PLAN T-2, T-3</b></p></div>				REV 1												
NO	ISSUED FOR CONSTRUCTION	ZONE	DATE	BY	CHK	ENG	NO	ZONE	DATE	BY	CHK	ENG	DWG NO.	MANUFACTURER	DESCRIPTION																						
0	ISSUED FOR CONSTRUCTION		05/29/2020	MDR	AA	MDR																															
1	ISSUED FOR RECORD - CROWNED RIDGE 22590		11/12/2020	MDR	AA	MDR																															
<div><p>NORTHERN STATES POWER COMPANY <b>CROWNED RIDGE II WIND FARM</b> CODINGTON, DEUEL, GRANT COUNTIES, SOUTH DAKOTA</p><table><tr><td>DWN: MDR</td><td>DATE: 11/12/2020</td><td>CHK: AA</td><td>DATE: 11/12/2020</td></tr><tr><td>ENG: MDR</td><td>DATE: 11/12/2020</td><td>CHK:</td><td>DATE:</td></tr><tr><td>PM: AA</td><td>DATE: 11/12/2020</td><td>PROJ. NO: 22590</td><td></td></tr><tr><td>APVD:</td><td>DATE:</td><td>SCALE: 1" = 300'</td><td></td></tr></table></div>																		DWN: MDR	DATE: 11/12/2020	CHK: AA	DATE: 11/12/2020	ENG: MDR	DATE: 11/12/2020	CHK:	DATE:	PM: AA	DATE: 11/12/2020	PROJ. NO: 22590		APVD:	DATE:	SCALE: 1" = 300'		ENERGY SUPPLY ENGINEERING & CONSTRUCTION		NH-275900-8-3	
DWN: MDR	DATE: 11/12/2020	CHK: AA	DATE: 11/12/2020																																		
ENG: MDR	DATE: 11/12/2020	CHK:	DATE:																																		
PM: AA	DATE: 11/12/2020	PROJ. NO: 22590																																			
APVD:	DATE:	SCALE: 1" = 300'																																			






EASEMENT LINES

EASEMENT LINES

Legend for map symbols:

- POH: OVERHEAD POWER
- GAS: GAS PIPELINE
- Stream Channel: STREAM CHANNEL
- EX: WETLAND
- Water Setback Line: WATER SETBACK LINE
- FEMA Flood Zone: FEMA FLOOD ZONE
- Protected Wildlife Buffer Line (Final Borders Will Be Defined by Final SWCA Plan): PROTECTED WILDLIFE BUFFER LINE (FINAL BORDERS WILL BE DEFINED BY FINAL SWCA PLAN)
- Archaeological Avoidance Area: ARCHEOLOGICAL AVOIDANCE AREA
- Existing Lake: EXISTING LAKE
- Record Low Water Crossing: RECORD LOW WATER CROSSING
- Record Culvert: RECORD CULVERT
- EX: INDEX CONTOUR
- EX: INTERVAL CONTOUR

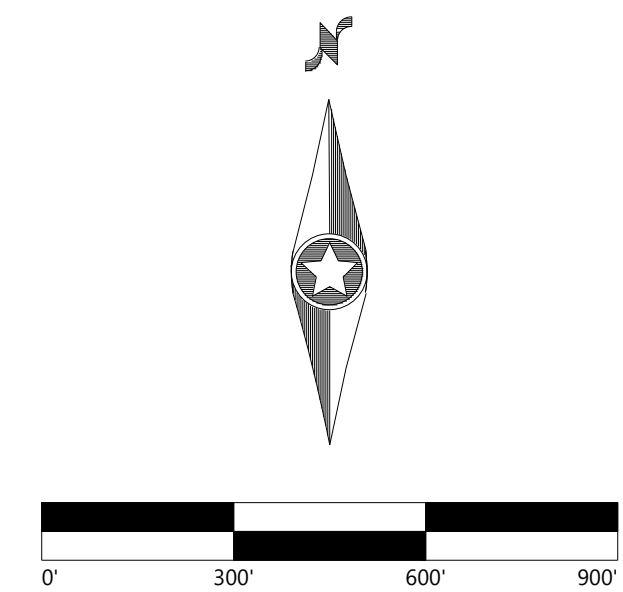

Phone (214) 473-4640 2740 Dallas Parkway, Suite 280  
Toll Free (888) 937-5150 Plano, TX 75093  
**westwoodps.com**  
Westwood Professional Services, Inc.



**BLATTNER**  
ENERGY

392 COUNTY RD 50  
AVON, MN 56310

ISSUE FOR RECORD

	REFERENCE DRAWINGS		
	DWG NO.	MANUFACTURER	DESCRIPTION

DWN: MDR	DATE: 11/12/2020	CHK: AA	DATE: 11/12/2020
ENG: MDR	DATE: 11/12/2020	CHK:	DATE:
PM: AA	DATE: 11/12/2020	PROJ. NO: 22590	
APVD:	DATE:	SCALE: 1" = 300'	

ENERGY SUPPLY  
ENGINEERING & CONSTRUCTION

NH-275900-8-4

REV
1





**SEE SHEET NH-275900-8-4**

ISSUE FOR RECORD


CIVIL SITE PLAN T-8, T-9

NH-275900-8-5

REV
1

392 COUNTY RD 50  
AVON, MN 56310



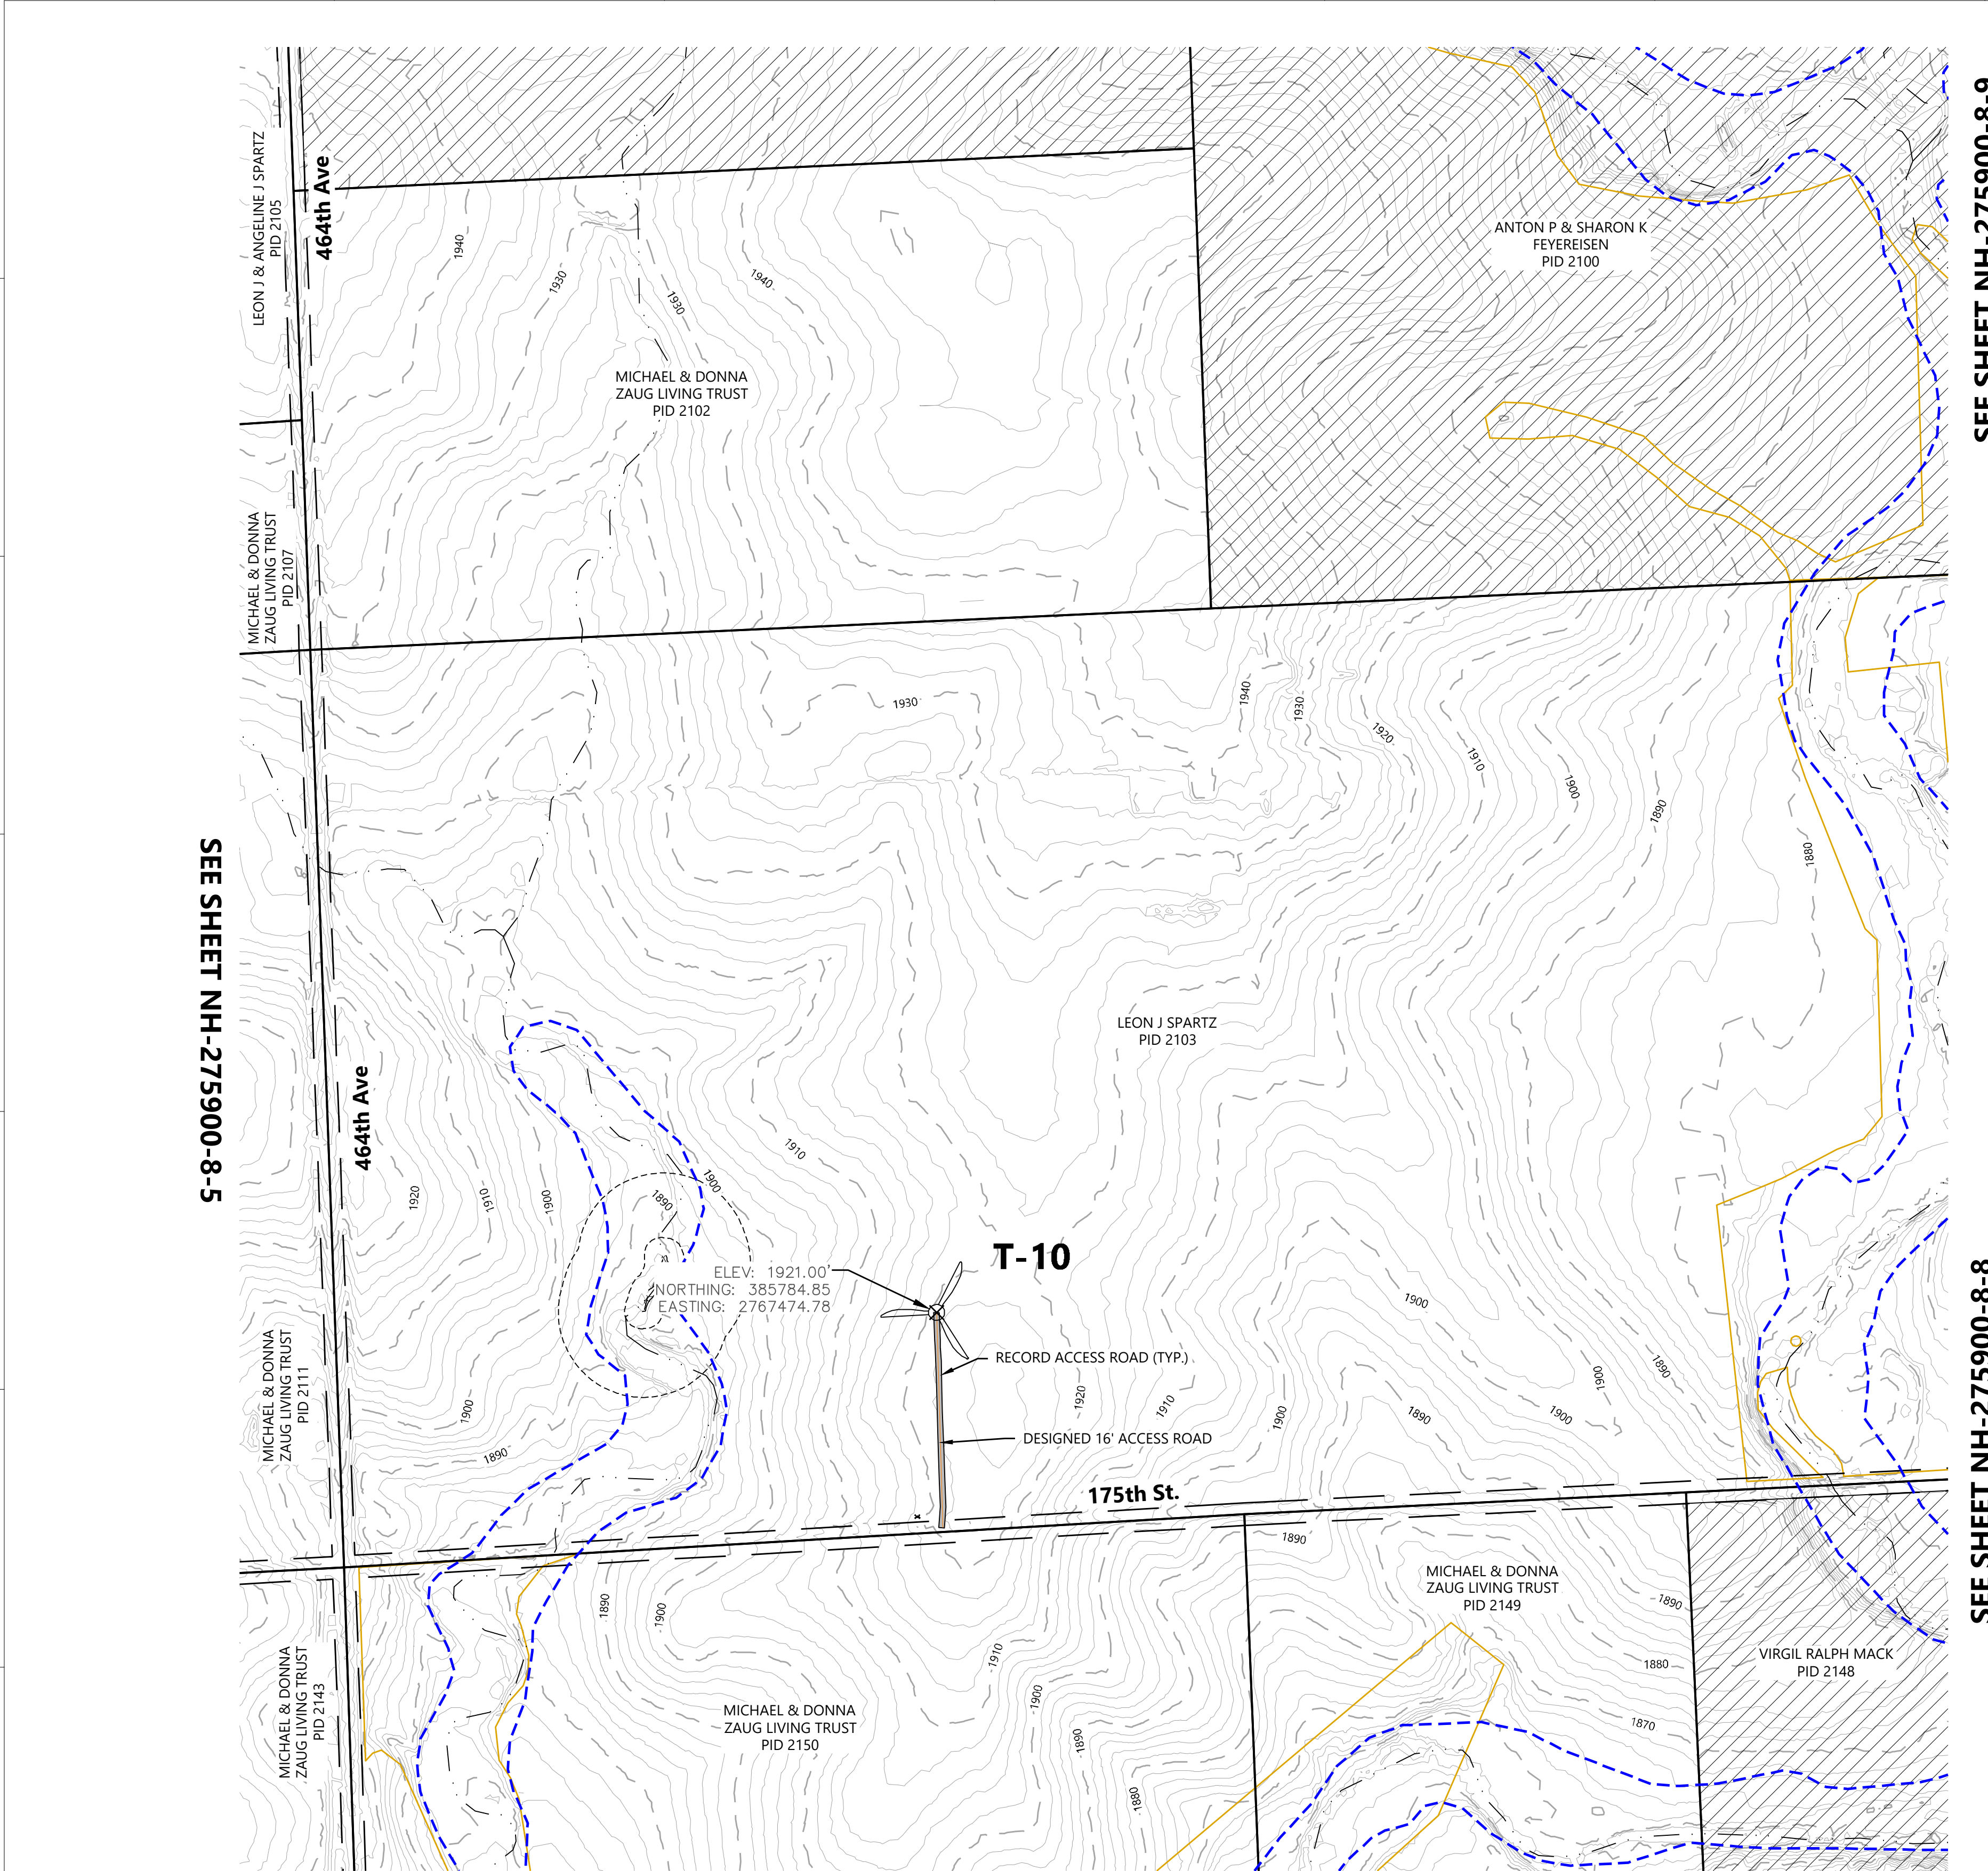

SEE SHEET NH-275900-8-9

SEE SHEET NH-275900-8-8

LEGEND:

T-#

RECORD TURBINE LOCATION

MET-XX

MET TOWER LOCATION

ADLS

ADLS RADAR LOCATION

P-PUG

DESIGNED UNDERGROUND COLLECTION

P-PON

DESIGNED OVERHEAD TRANSMISSION

NON-PARTICIPATING LAND

PROPERTY LINE

RIGHT-OF-WAY LINES

EASEMENT LINES

EX. OVERHEAD POWER

EX. GAS PIPELINE

EX. STREAM CHANNEL

EX. WETLAND

WATER SETBACK LINE

FEMA FLOOD ZONE

PROTECTED WILDLIFE BUFFER LINE  
(FINAL BORDERS WILL BE DEFINED  
BY FINAL SWCA PLAN)

ARCHEOLOGICAL AVOIDANCE AREA

EXISTING LAKE



RECORD LOW WATER CROSSING

RECORD CULVERT

EX. INDEX CONTOUR

EX. INTERVAL CONTOUR

KEY MAP:

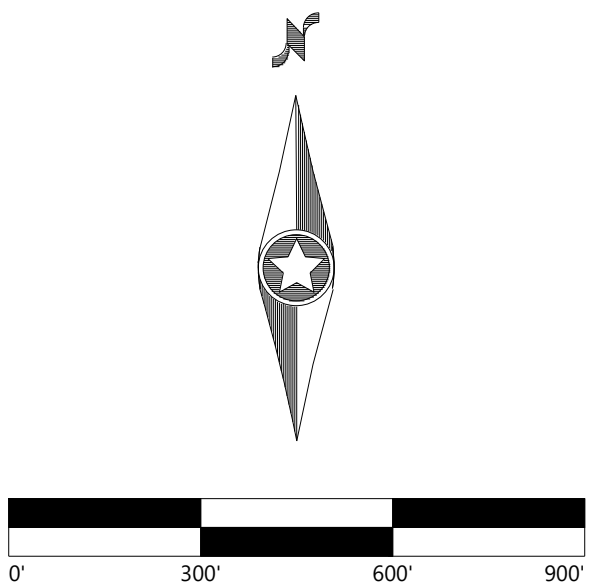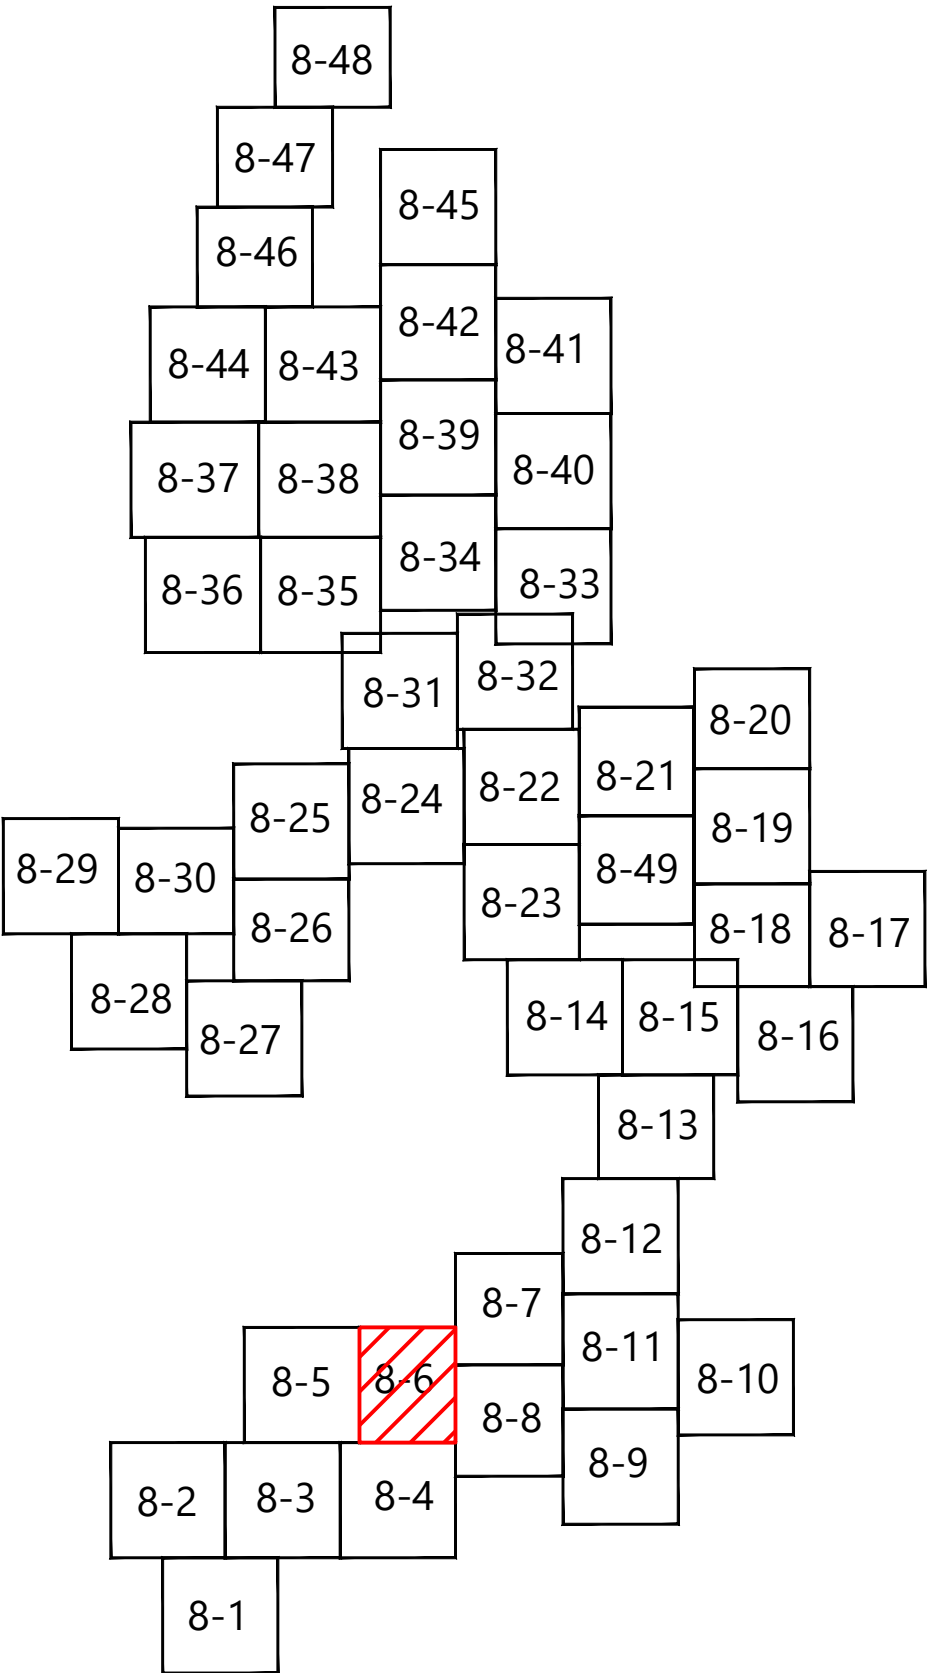

Westwood

Phone (214) 473-4640 2740 Dallas Parkway, Suite 280  
Toll Free (888) 937-5150 Plano, TX 75093  
westwoodps.com

Westwood Professional Services, Inc.

PREPARED FOR:

BLATTNER  
ENERGY

392 COUNTY RD 50  
AVON, MN 56310

ISSUE FOR RECORD

NO	REVISION	ZONE	DATE	BY	CHK	ENG	NO	REVISION	ZONE	DATE	BY	CHK	ENG	REFERENCE DRAWINGS		
														DWG NO.	MANUFACTURER	DESCRIPTION
0	ISSUED FOR CONSTRUCTION		05/29/2020	MDR	AA	MDR										
1	ISSUED FOR RECORD - CROWNED RIDGE 22590		11/12/2020	MDR	AA	MDR										

NORTHERN STATES POWER COMPANY  
CROWNED RIDGE II WIND FARM  
CODINGTON, DEUEL, GRANT COUNTIES, SOUTH DAKOTA

DWN: MDR

ENG: MDR

PM: AA

APVD:

DATE: 11/12/2020

DATE: 11/12/2020

DATE: 11/12/2020

DATE:

CHK: AA

CHK:

PROJ. NO: 22590

SCALE: 1" = 300'

DATE: 11/12/2020

DATE:

THIS MAP/DOCUMENT IS A TOOL TO ASSIST EMPLOYEES IN THE PERFORMANCE OF THEIR JOBS. YOUR PERSONAL SAFETY IS PROVIDED FOR BY USING SAFETY PRACTICES, PROCEDURES, AND EQUIPMENT AS DESCRIBED IN THE SAFETY TRAINING PROGRAMS AND MANUALS.

ENERGY SUPPLY  
ENGINEERING & CONSTRUCTION


UNIT 0  
CIVIL ACCESS ROADS

CIVIL SITE PLAN T-10

NH-275900-8-6

REV  
1



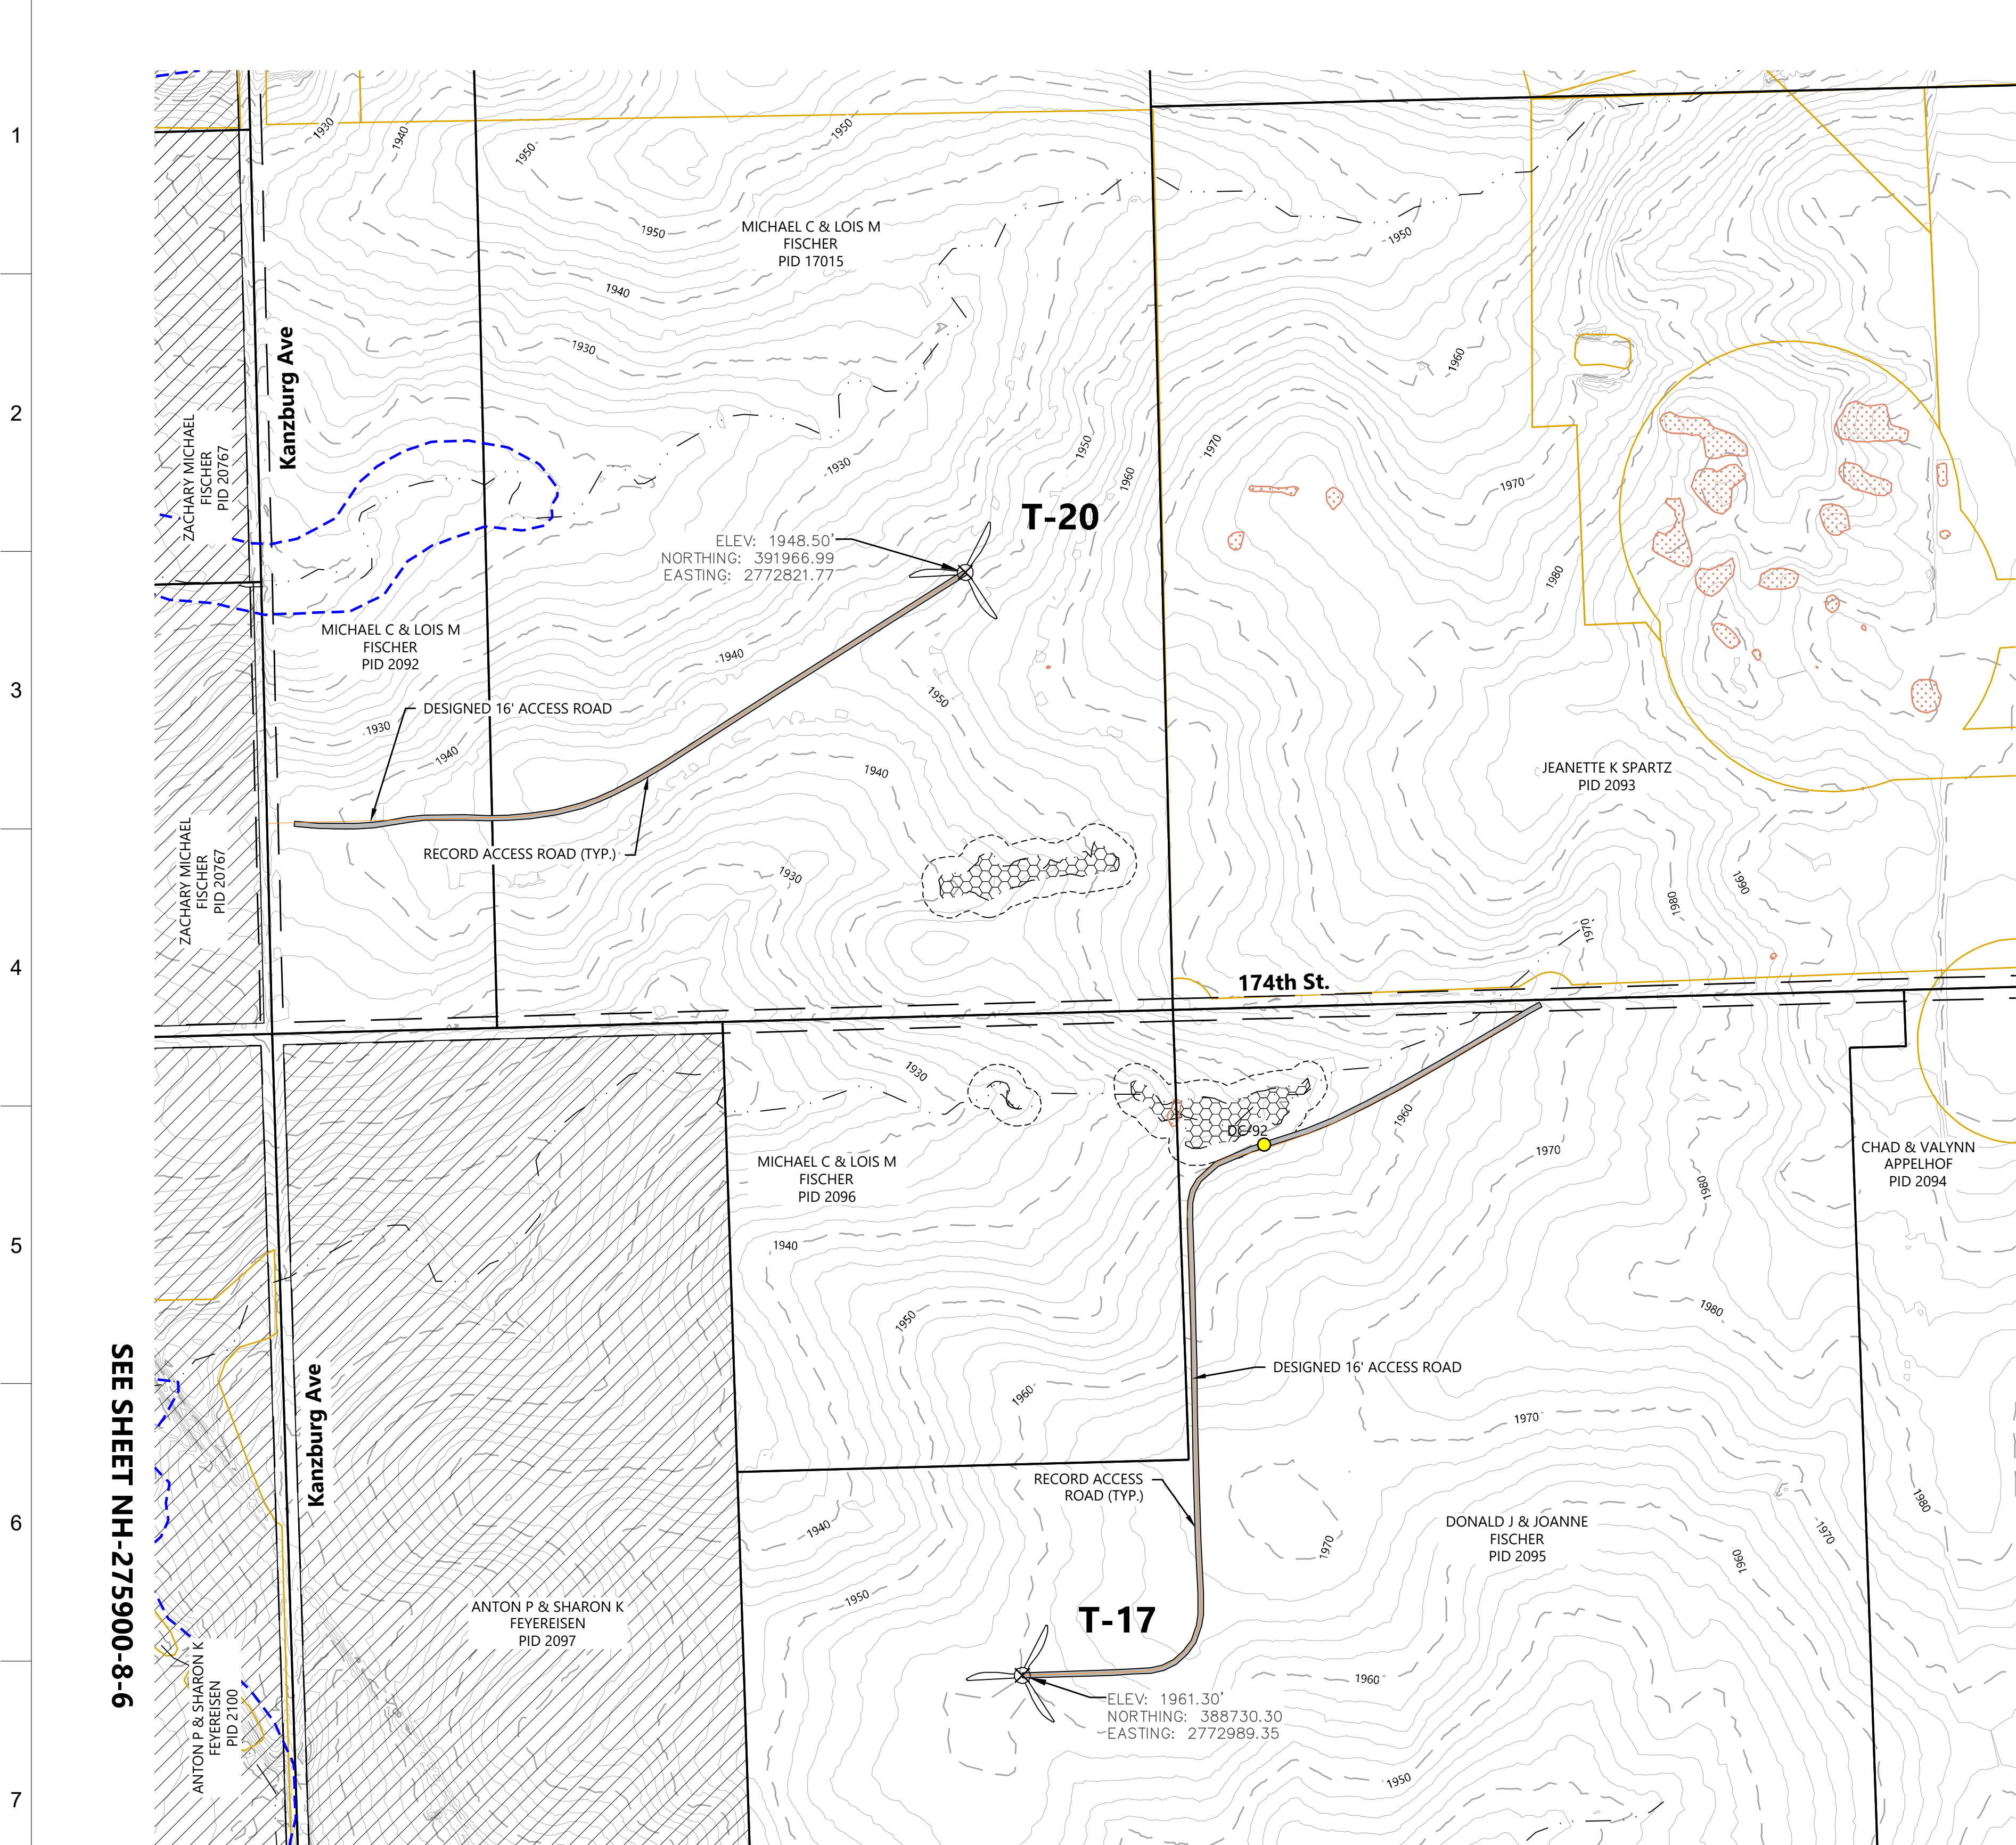

SEE SHEET NH-275900-8-12

SEE SHEET NH-275900-8-11

LEGEND:



- T-#

RECORD TURBINE LOCATION
- MET-XX

MET TOWER LOCATION
- ADLS

ADLS RADAR LOCATION
- DESIGNED ACCESS ROAD
- RECORD ACCESS ROAD
- DESIGNED UNDERGROUND COLLECTION
- DESIGNED OVERHEAD TRANSMISSION
- NON-PARTICIPATING LAND
- PROPERTY LINE
- RIGHT-OF-WAY LINES
- EASEMENT LINES
- EX. OVERHEAD POWER
- EX. GAS PIPELINE
- EX. STREAM CHANNEL
- EX. WETLAND
- WATER SETBACK LINE
- FEMA FLOOD ZONE
- PROTECTED WILDLIFE BUFFER LINE  
(FINAL BORDERS WILL BE DEFINED  
BY FINAL SWCA PLAN)
- ARCHEOLOGICAL AVOIDANCE AREA
- EXISTING LAKE
- RECORD LOW WATER CROSSING
- RECORD CULVERT
- EX. INDEX CONTOUR
- EX. INTERVAL CONTOUR

KEY MAP:

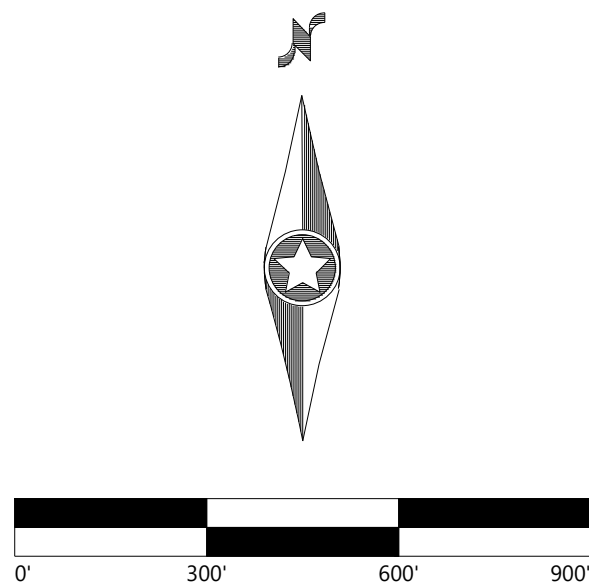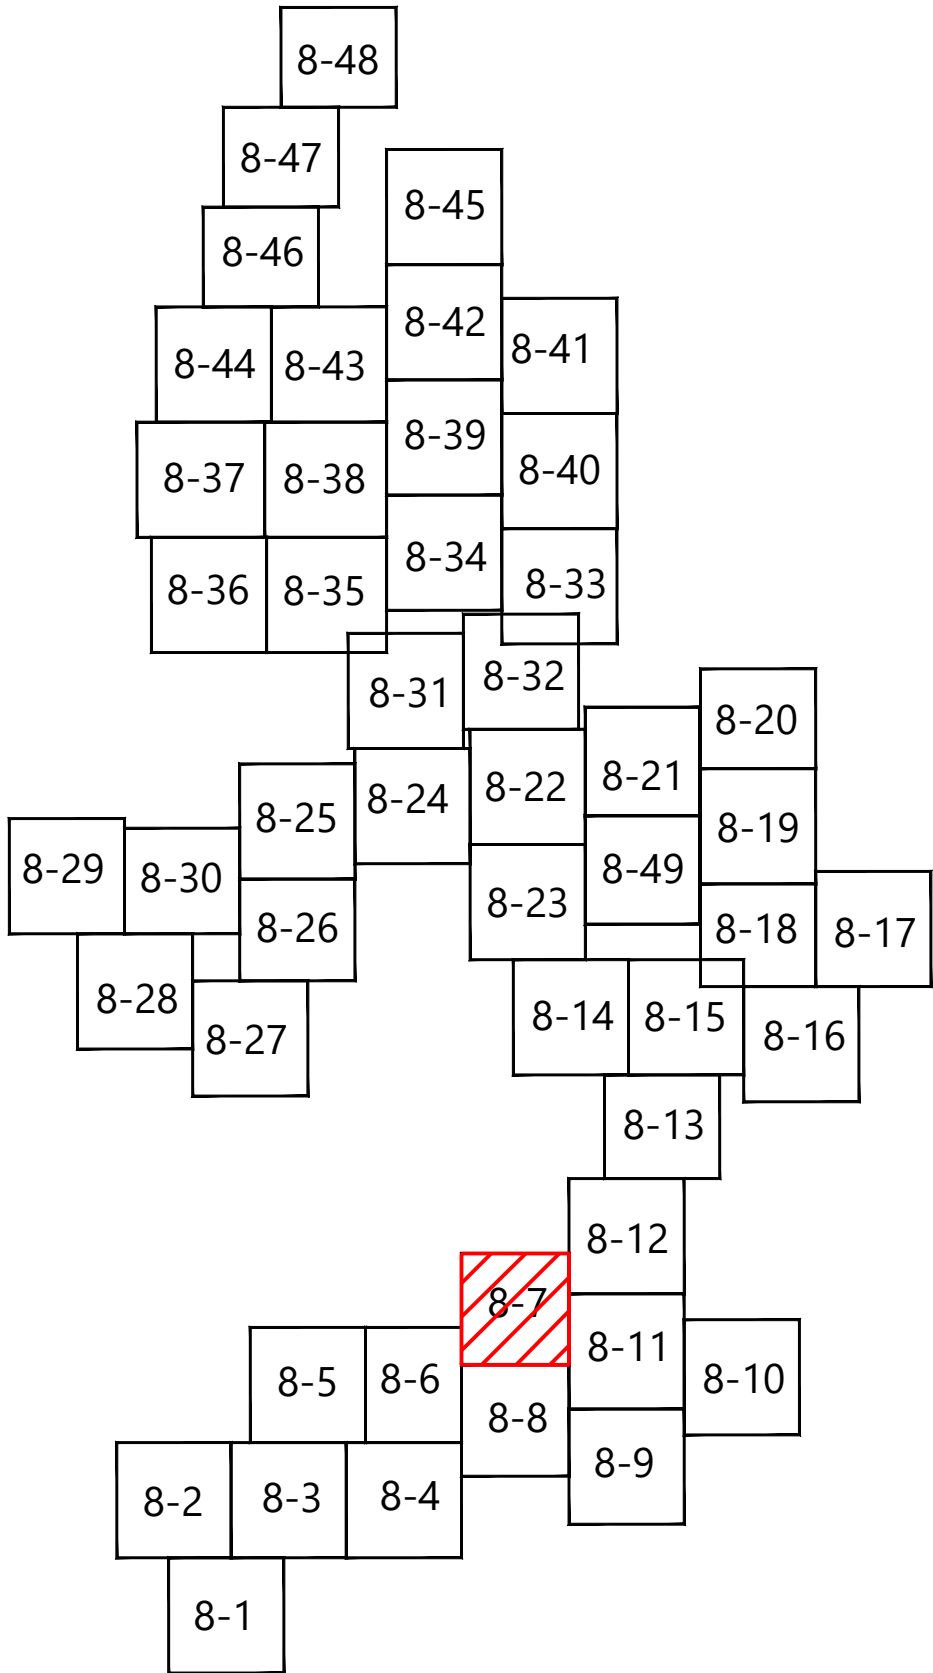

Westwood

Phone (214) 473-4640 2740 Dallas Parkway, Suite 280  
Toll Free (888) 937-5150 Plano, TX 75093  
westwoodps.com  
Westwood Professional Services, Inc.


PREPARED FOR:

BLATTNER  
ENERGY


392 COUNTY RD 50  
AVON, MN 56310

ISSUE FOR RECORD

NO	REVISION	ZONE	DATE	BY	CHK	ENG	NO	REVISION	ZONE	DATE	BY	CHK	ENG	REFERENCE DRAWINGS		
														DWG NO.	MANUFACTURER	DESCRIPTION
0	ISSUED FOR CONSTRUCTION		05/29/2020	MDR	AA	MDR										
1	ISSUED FOR RECORD - CROWNED RIDGE 22590		11/12/2020	MDR	AA	MDR										

 <b>Xcel Energy®</b>				THIS MAP/DOCUMENT IS A TOOL TO ASSIST EMPLOYEES IN THE PERFORMANCE OF THEIR JOBS. YOUR PERSONAL SAFETY IS PROVIDED FOR BY USING SAFETY PRACTICES, PROCEDURES, AND EQUIPMENT AS DESCRIBED IN THE SAFETY TRAINING PROGRAMS AND MANUALS.		UNIT 0		REV 1
NORTHERN STATES POWER COMPANY						CIVIL ACCESS ROADS		
CROWNED RIDGE II WIND FARM								
CODDINGTON, DEUEL, GRANT COUNTIES, SOUTH DAKOTA								
DWN: MDR	DATE: 11/12/2020	CHK: AA	DATE: 11/12/2020	ENERGY SUPPLY ENGINEERING & CONSTRUCTION		NH-275900-8-7		
ENG: MDR	DATE: 11/12/2020	CHK:	DATE:					
PM: AA	DATE: 11/12/2020	PROJ. NO: 22590						
APVD:	DATE:	SCALE: 1" = 300'						



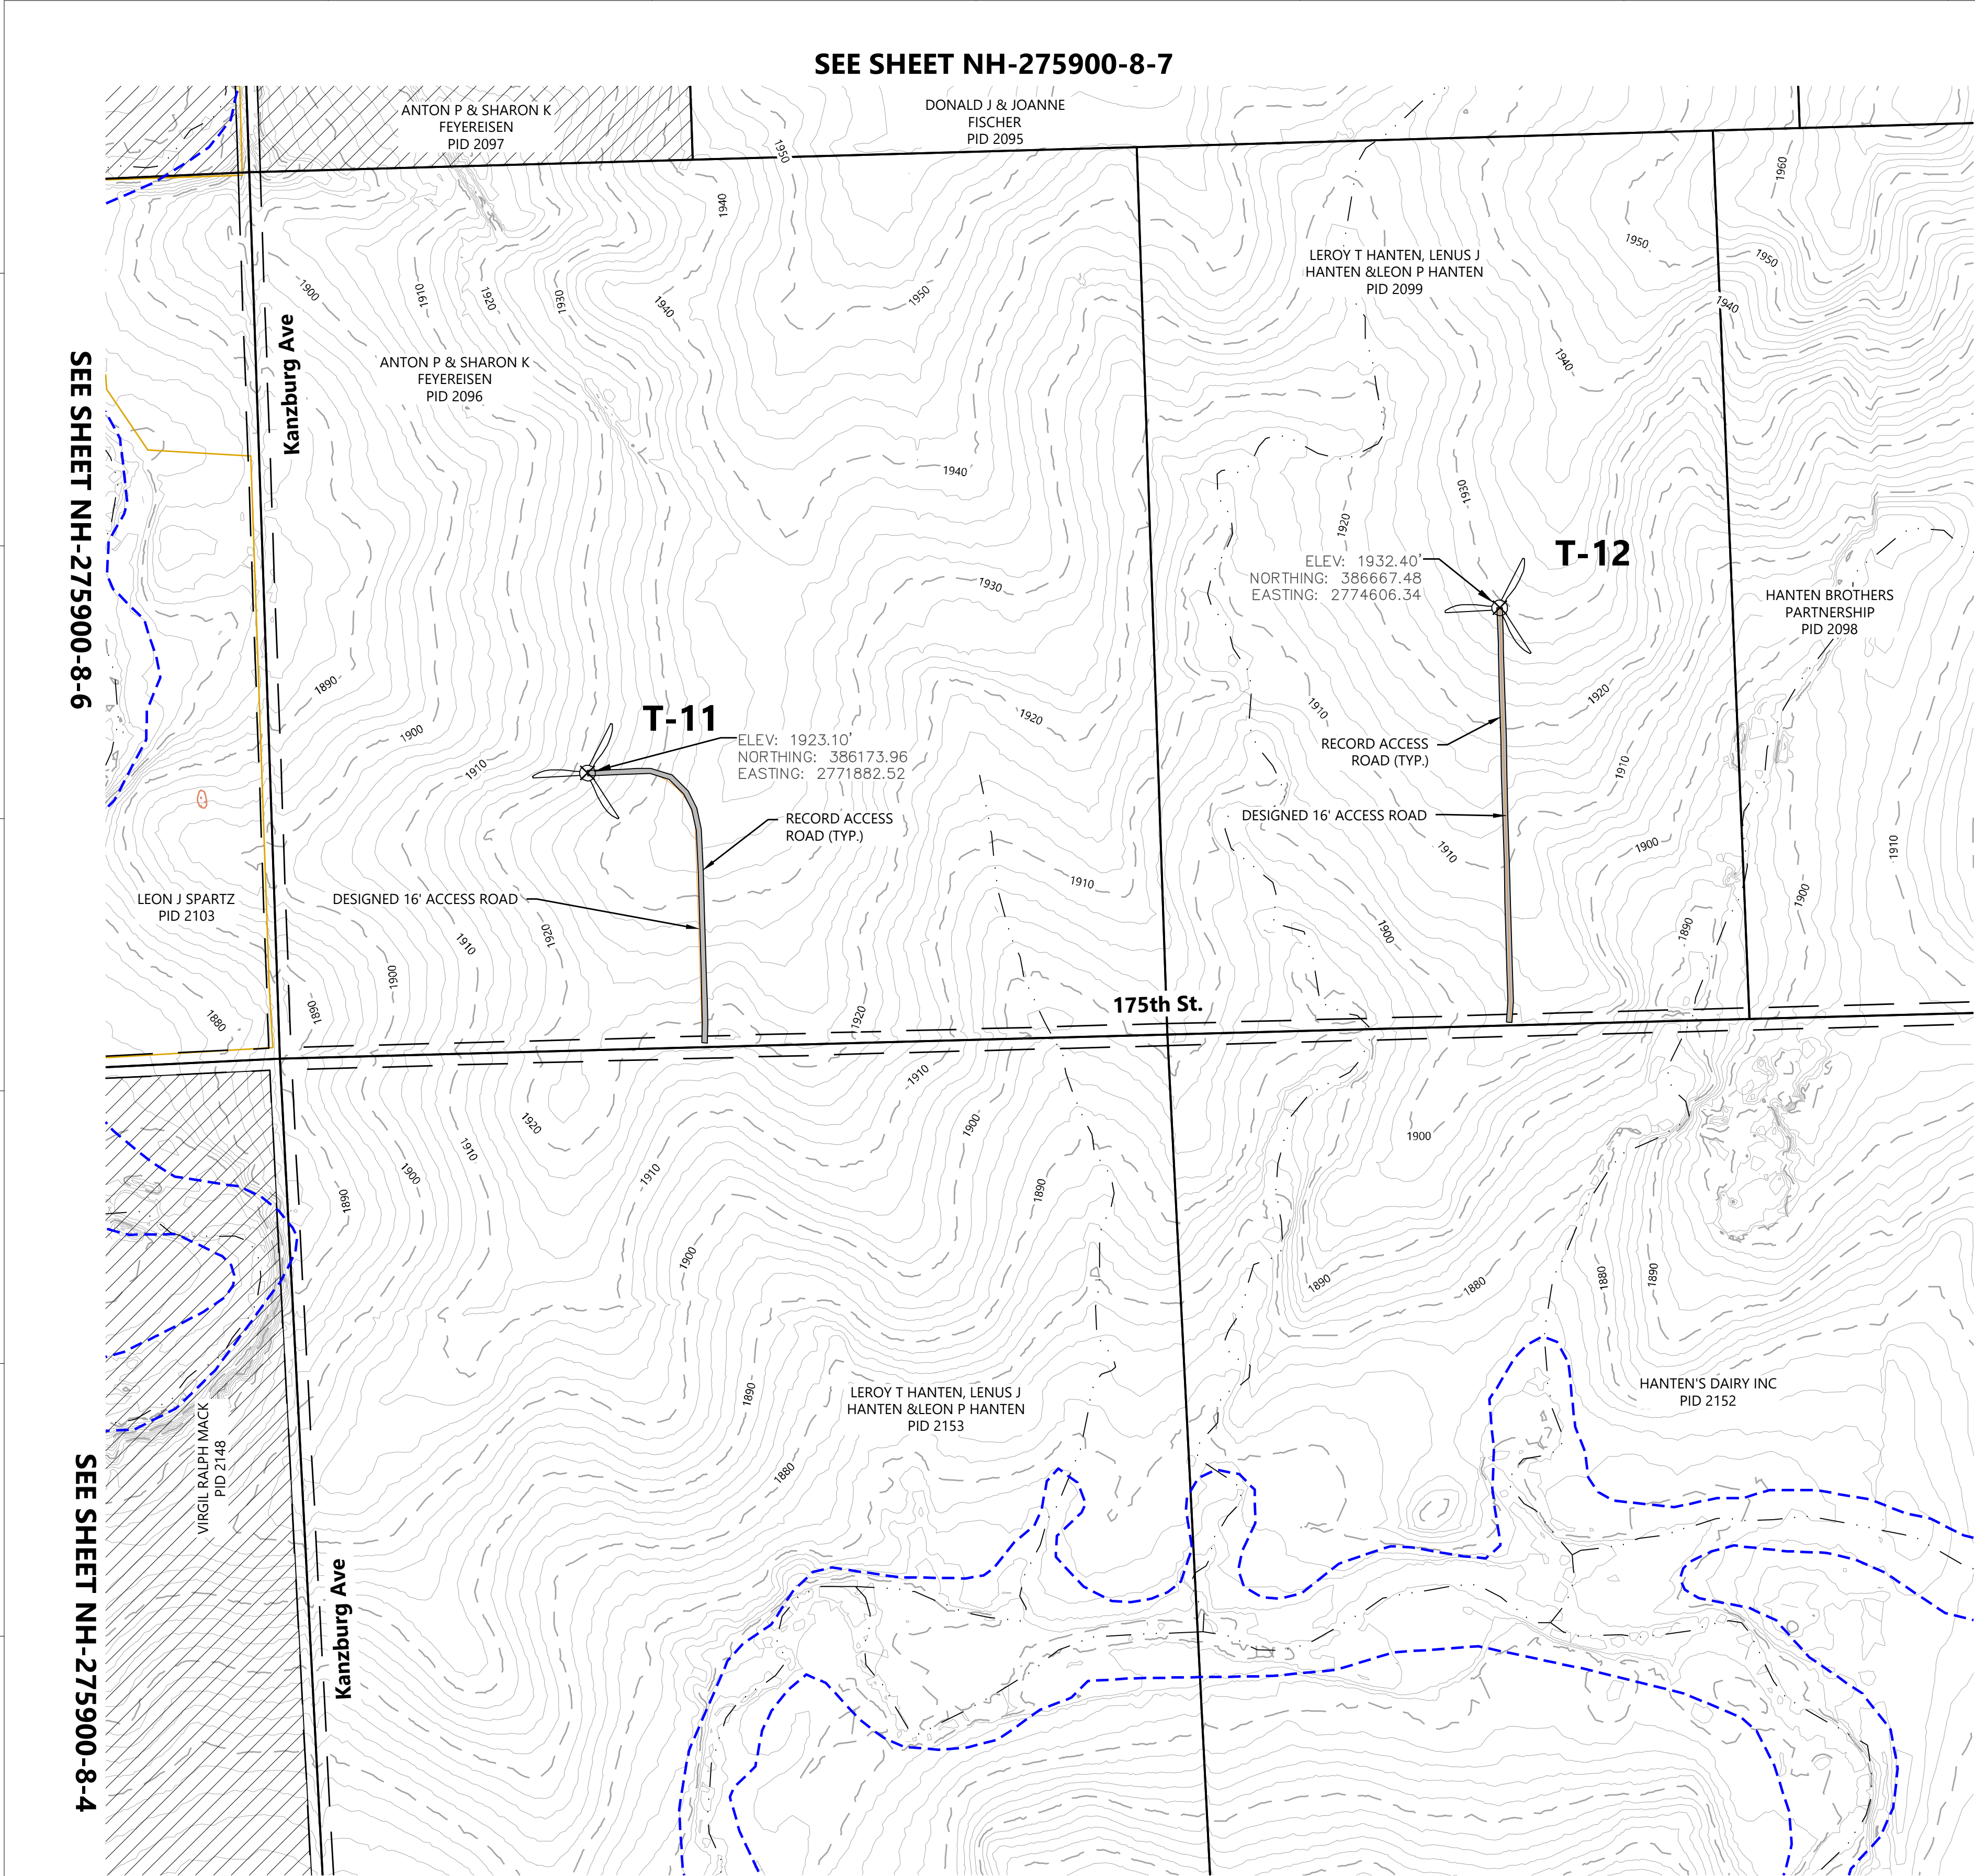

SEE SHEET NH-275900-8-11

SEE SHEET NH-275900-8-9

LEGEND:

T-#

RECORD TURBINE LOCATION

MET-XX

MET TOWER LOCATION

ADLS

ADLS RADAR LOCATION

DESIGNED ACCESS ROAD

RECORD ACCESS ROAD

P-FUG

DESIGNED UNDERGROUND COLLECTION

P-POH

DESIGNED OVERHEAD TRANSMISSION

NON-PARTICIPATING LAND

PROPERTY LINE

RIGHT-OF-WAY LINES

EASEMENT LINES

POH

EX. OVERHEAD POWER

GAS

EX. GAS PIPELINE

EX. STREAM CHANNEL

EX. WETLAND

WATER SETBACK LINE

FEMA FLOOD ZONE

PROTECTED WILDLIFE BUFFER LINE  
(FINAL BORDERS WILL BE DEFINED  
BY FINAL SWCA PLAN)

ARCHEOLOGICAL AVOIDANCE AREA

EXISTING LAKE

RECORD LOW WATER CROSSING



DC-XX

RECORD CULVERT

EX. INDEX CONTOUR

EX. INTERVAL CONTOUR

KEY MAP:

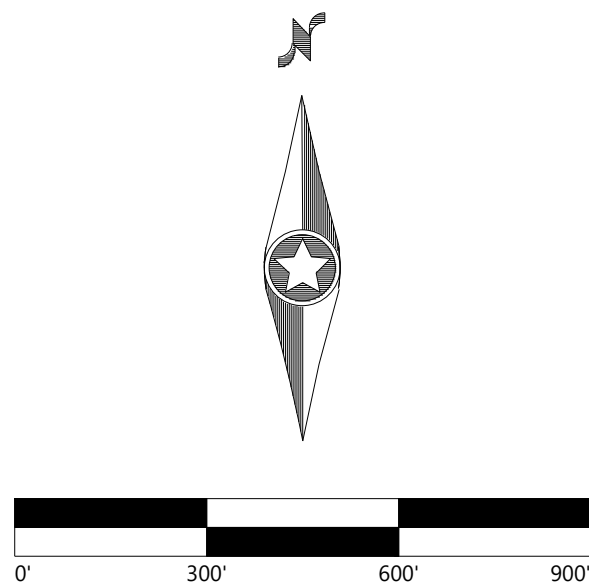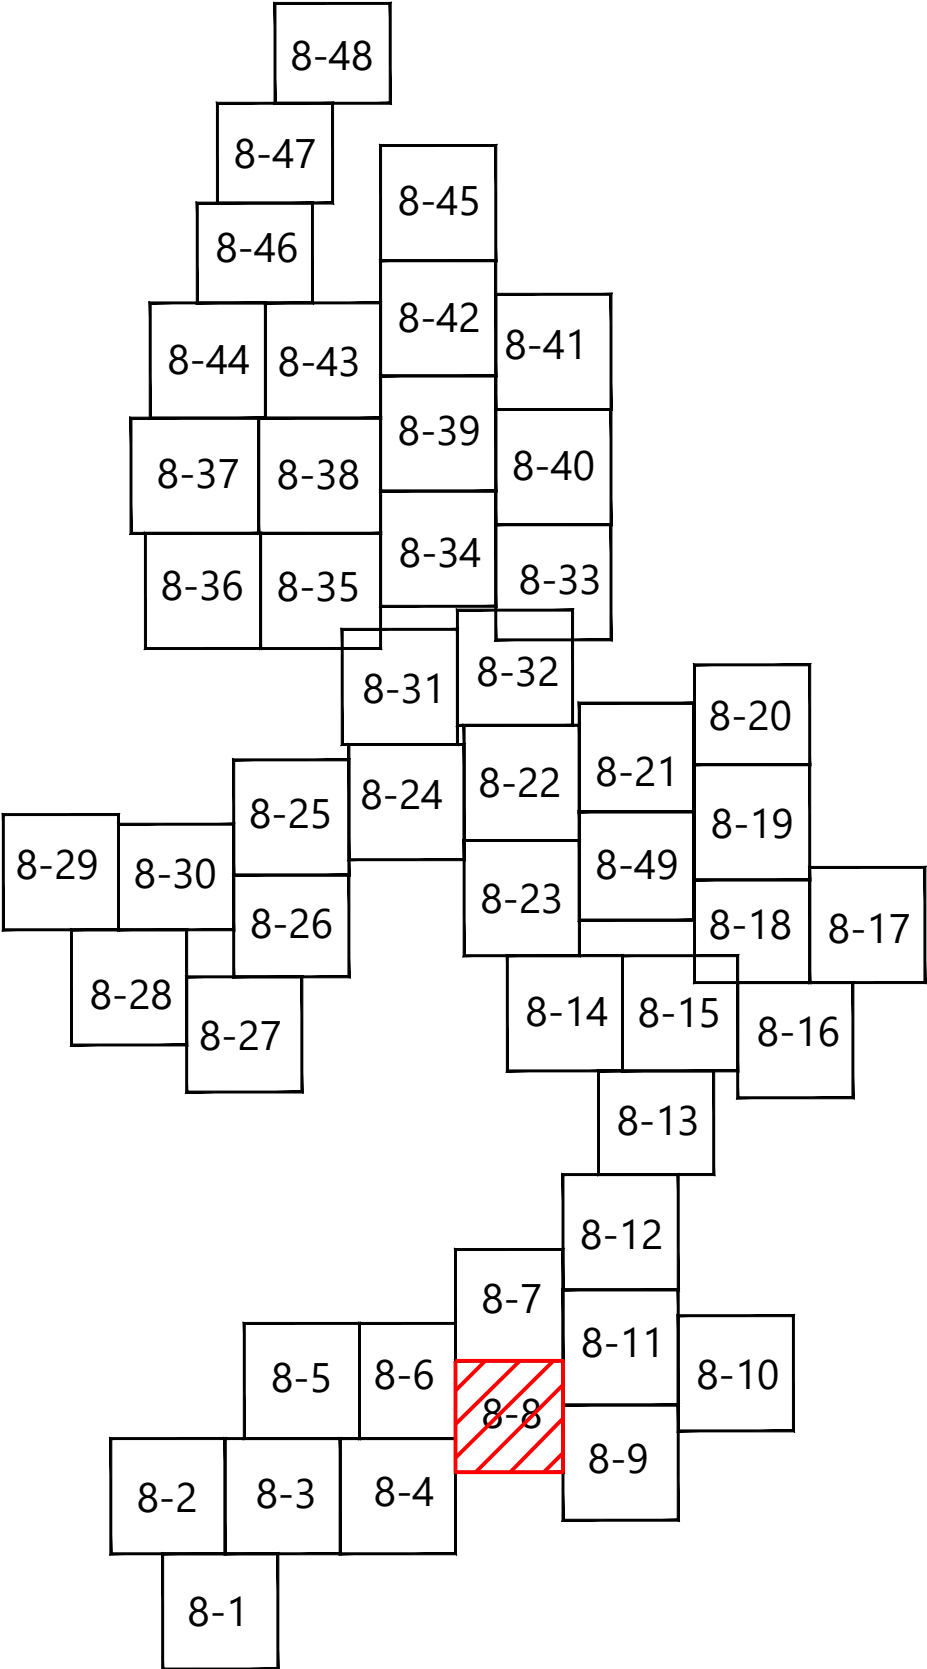

**Westwood**

Phone (214) 473-4640 2740 Dallas Parkway, Suite 280  
Toll Free (888) 937-5150 Plano, TX 75093  
westwoodps.com  
Westwood Professional Services, Inc.

PREPARED FOR:

**BLATTNER  
ENERGY**

392 COUNTY RD 50  
AVON, MN 56310

ISSUE FOR RECORD

NO	REVISION	ZONE	DATE	BY	CHK	ENG	NO	REVISION	ZONE	DATE	BY	CHK	ENG	REFERENCE DRAWINGS		
														DWG NO.	MANUFACTURER	DESCRIPTION
0	ISSUED FOR CONSTRUCTION		05/29/2020	MDR	AA	MDR										
1	ISSUED FOR RECORD - CROWNED RIDGE 22590		11/12/2020	MDR	AA	MDR										

NORTHERN STATES POWER COMPANY  
CROWNED RIDGE II WIND FARM  
CODINGTON, DEUEL, GRANT COUNTIES, SOUTH DAKOTA

DWN: MDR

ENG: MDR

PM: AA

APVD:

DATE: 11/12/2020

DATE: 11/12/2020

DATE: 11/12/2020

DATE:

CHK: AA

CHK:

SCALE: 1" = 300'

DATE: 11/12/2020

PROJ. NO: 22590

THIS MAP/DOCUMENT IS A TOOL TO ASSIST EMPLOYEES IN THE PERFORMANCE OF THEIR JOBS. YOUR PERSONAL SAFETY IS PROVIDED FOR BY USING SAFETY PRACTICES, PROCEDURES, AND EQUIPMENT AS DESCRIBED IN THE SAFETY TRAINING PROGRAMS AND MANUALS.

ENERGY SUPPLY  
ENGINEERING & CONSTRUCTION

UNIT 0  
CIVIL ACCESS ROADS

CIVIL SITE PLAN T-11, T-12

NH-275900-8-8

REV  
1



EV  
I






RE

DWN: MDR	DATE: 11/12/2020	CHK: AA	DATE: 11/12/2020
ENG: MDR	DATE: 11/12/2020	CHK:	DATE:
PM: AA	DATE: 11/12/2020	PROJ. NO: 22590	
APVD:	DATE:	SCALE: 1" = 300'	



REV  
1



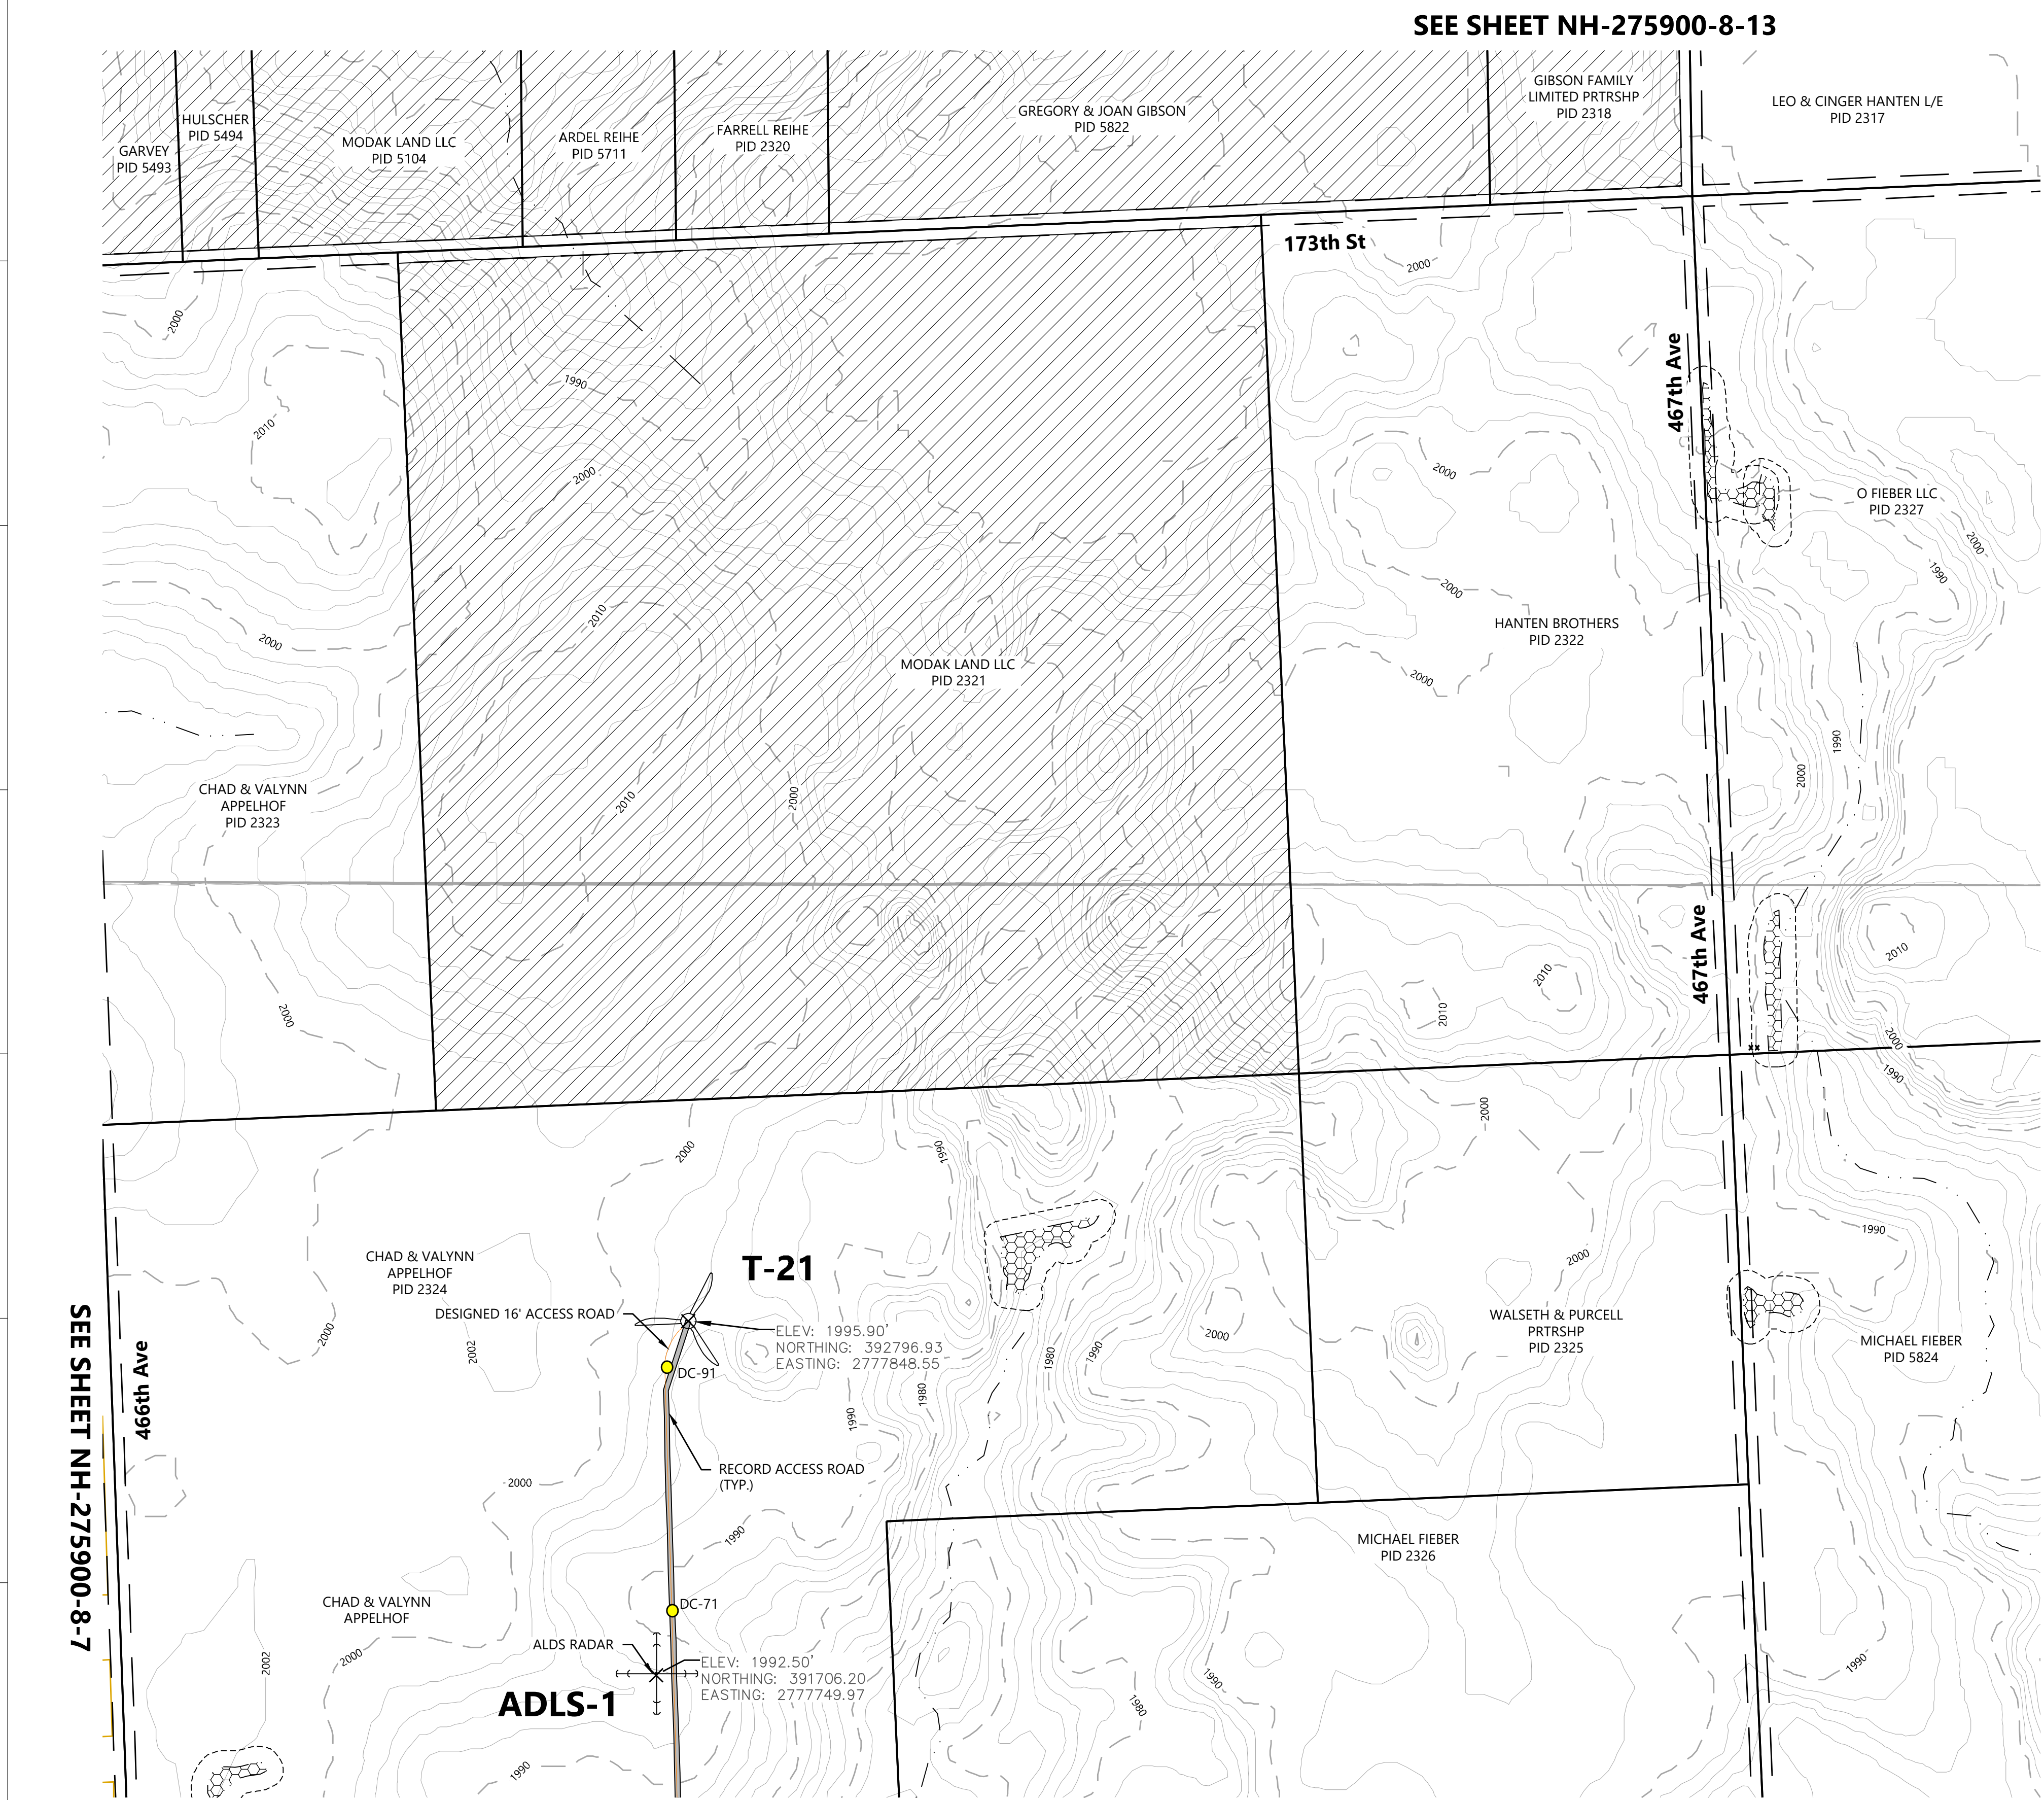

LEGEND:

T-#

RECORD TURBINE LOCATION

MET-XX

MET TOWER LOCATION

ADLS

ADLS RADAR LOCATION

DESIGNED ACCESS ROAD

RECORD ACCESS ROAD

P-PUG

DESIGNED UNDERGROUND COLLECTION

P-PON

DESIGNED OVERHEAD TRANSMISSION

NON-PARTICIPATING LAND

PROPERTY LINE

RIGHT-OF-WAY LINES

EASEMENT LINES

POH

EX. OVERHEAD POWER

GAS

EX. GAS PIPELINE

EX. STREAM CHANNEL

EX. WETLAND

WATER SETBACK LINE

FEMA FLOOD ZONE

PROTECTED WILDLIFE BUFFER LINE  
(FINAL BORDERS WILL BE DEFINED  
BY FINAL SWCA PLAN)

ARCHEOLOGICAL AVOIDANCE AREA

EXISTING LAKE



RECORD LOW WATER CROSSING

RECORD CULVERT

EX. INDEX CONTOUR

EX. INTERVAL CONTOUR

KEY MAP:

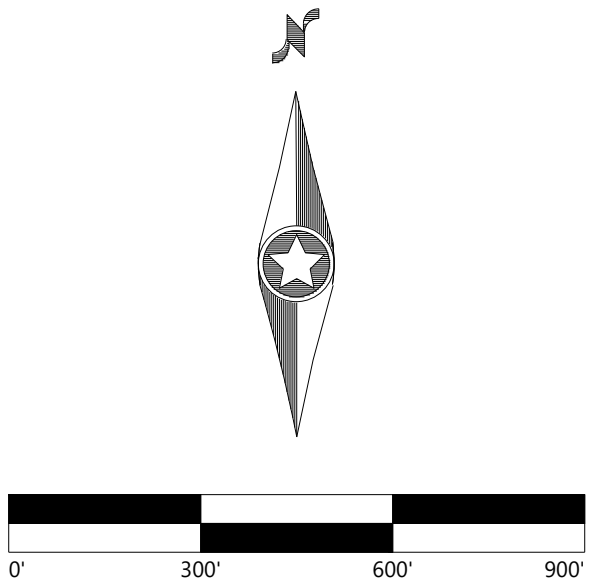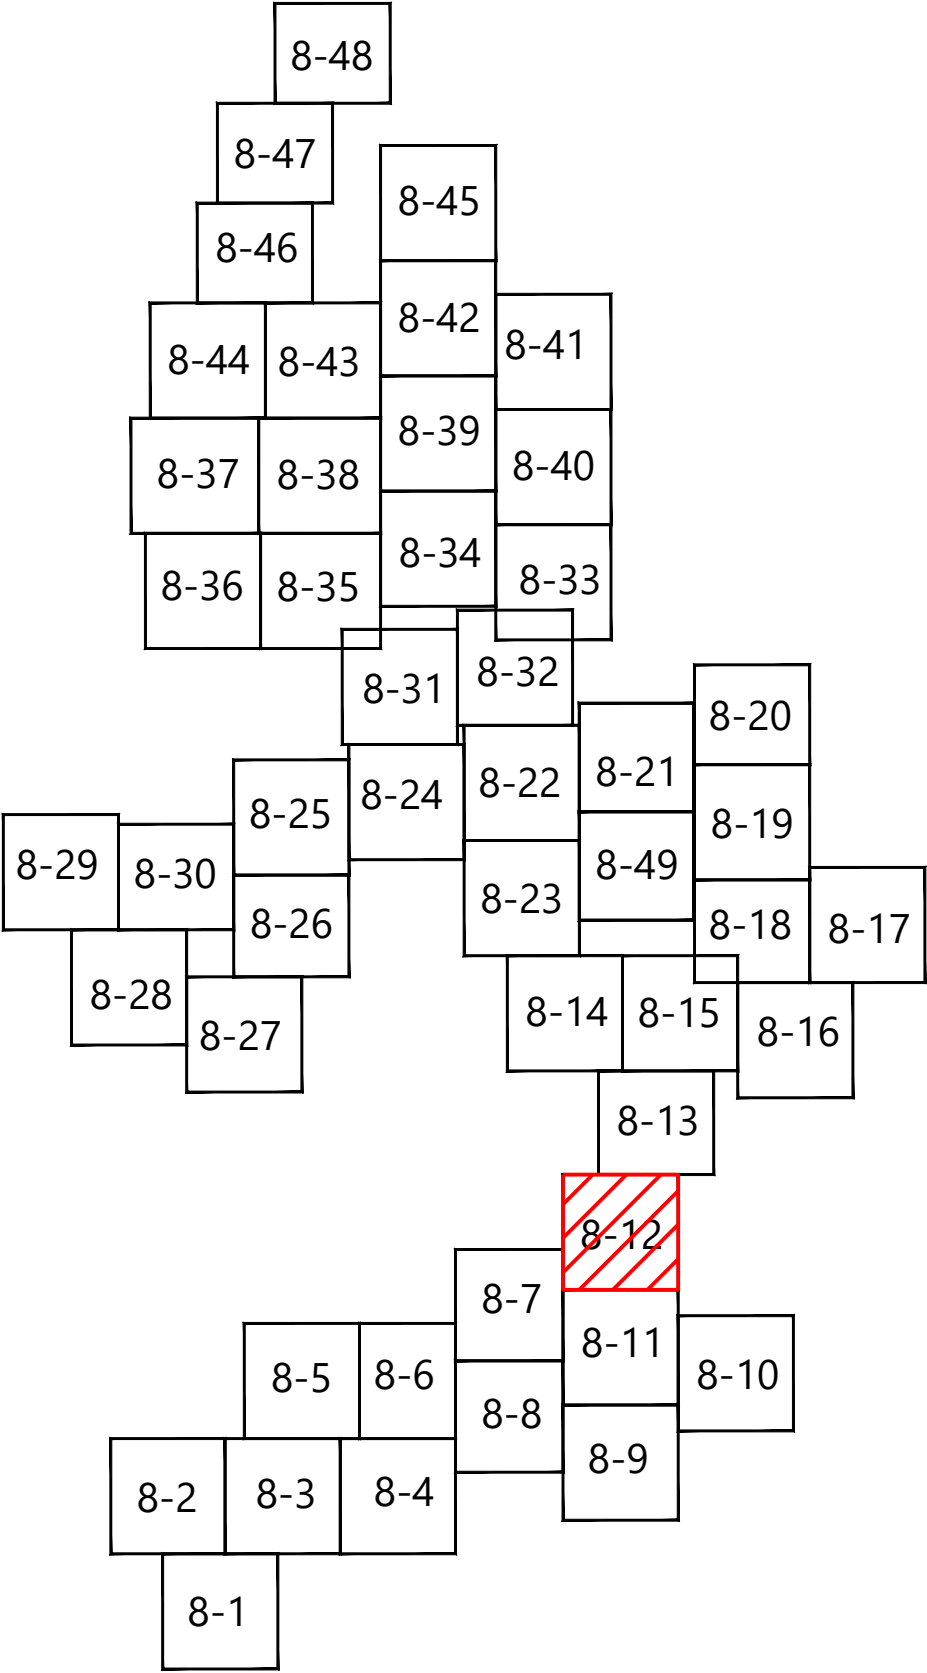

**Westwood**

Phone (214) 473-4640 2740 Dallas Parkway, Suite 280  
Toll Free (888) 937-5150 Plano, TX 75093  
westwoodps.com


Westwood Professional Services, Inc.

PREPARED FOR:


**BLATTNER  
ENERGY**

392 COUNTY RD 50  
AVON, MN 56310

ISSUE FOR RECORD

REVISION		ZONE	DATE	BY	CHK	ENG	NO	REVISION		ZONE	DATE	BY	CHK	ENG	REFERENCE DRAWINGS			<div><b>Xcel Energy</b><sup>®</sup></div> <div>NORTHERN STATES POWER COMPANY CROWNED RIDGE II WIND FARM CODINGTON, DEUEL, GRANT COUNTIES, SOUTH DAKOTA</div> <div>DWN: MDR    DATE: 11/12/2020    CHK: AA    DATE: 11/12/2020 ENG: MDR    DATE: 11/12/2020    CHK:    DATE:    PM: AA    DATE: 11/12/2020    PROJ. NO: 22590 APVD:    DATE:    SCALE: 1" = 300'</div>	THIS MAP/DOCUMENT IS A TOOL TO ASSIST EMPLOYEES IN THE PERFORMANCE OF THEIR JOBS. YOUR PERSONAL SAFETY IS PROVIDED FOR BY USING SAFETY PRACTICES, PROCEDURES, AND EQUIPMENT AS DESCRIBED IN THE SAFETY TRAINING PROGRAMS AND MANUALS.		UNIT 0 CIVIL ACCESS ROADS	
															DWG NO.	MANUFACTURER	DESCRIPTION		CIVIL SITE PLAN T-21, ADLS-1			
0	ISSUED FOR CONSTRUCTION		05/29/2020	MDR	AA	MDR																
1	ISSUED FOR RECORD - CROWNED RIDGE 22590		11/12/2020	MDR	AA	MDR																
																			ENERGY SUPPLY ENGINEERING & CONSTRUCTION		NH-275900-8-12	REV 1



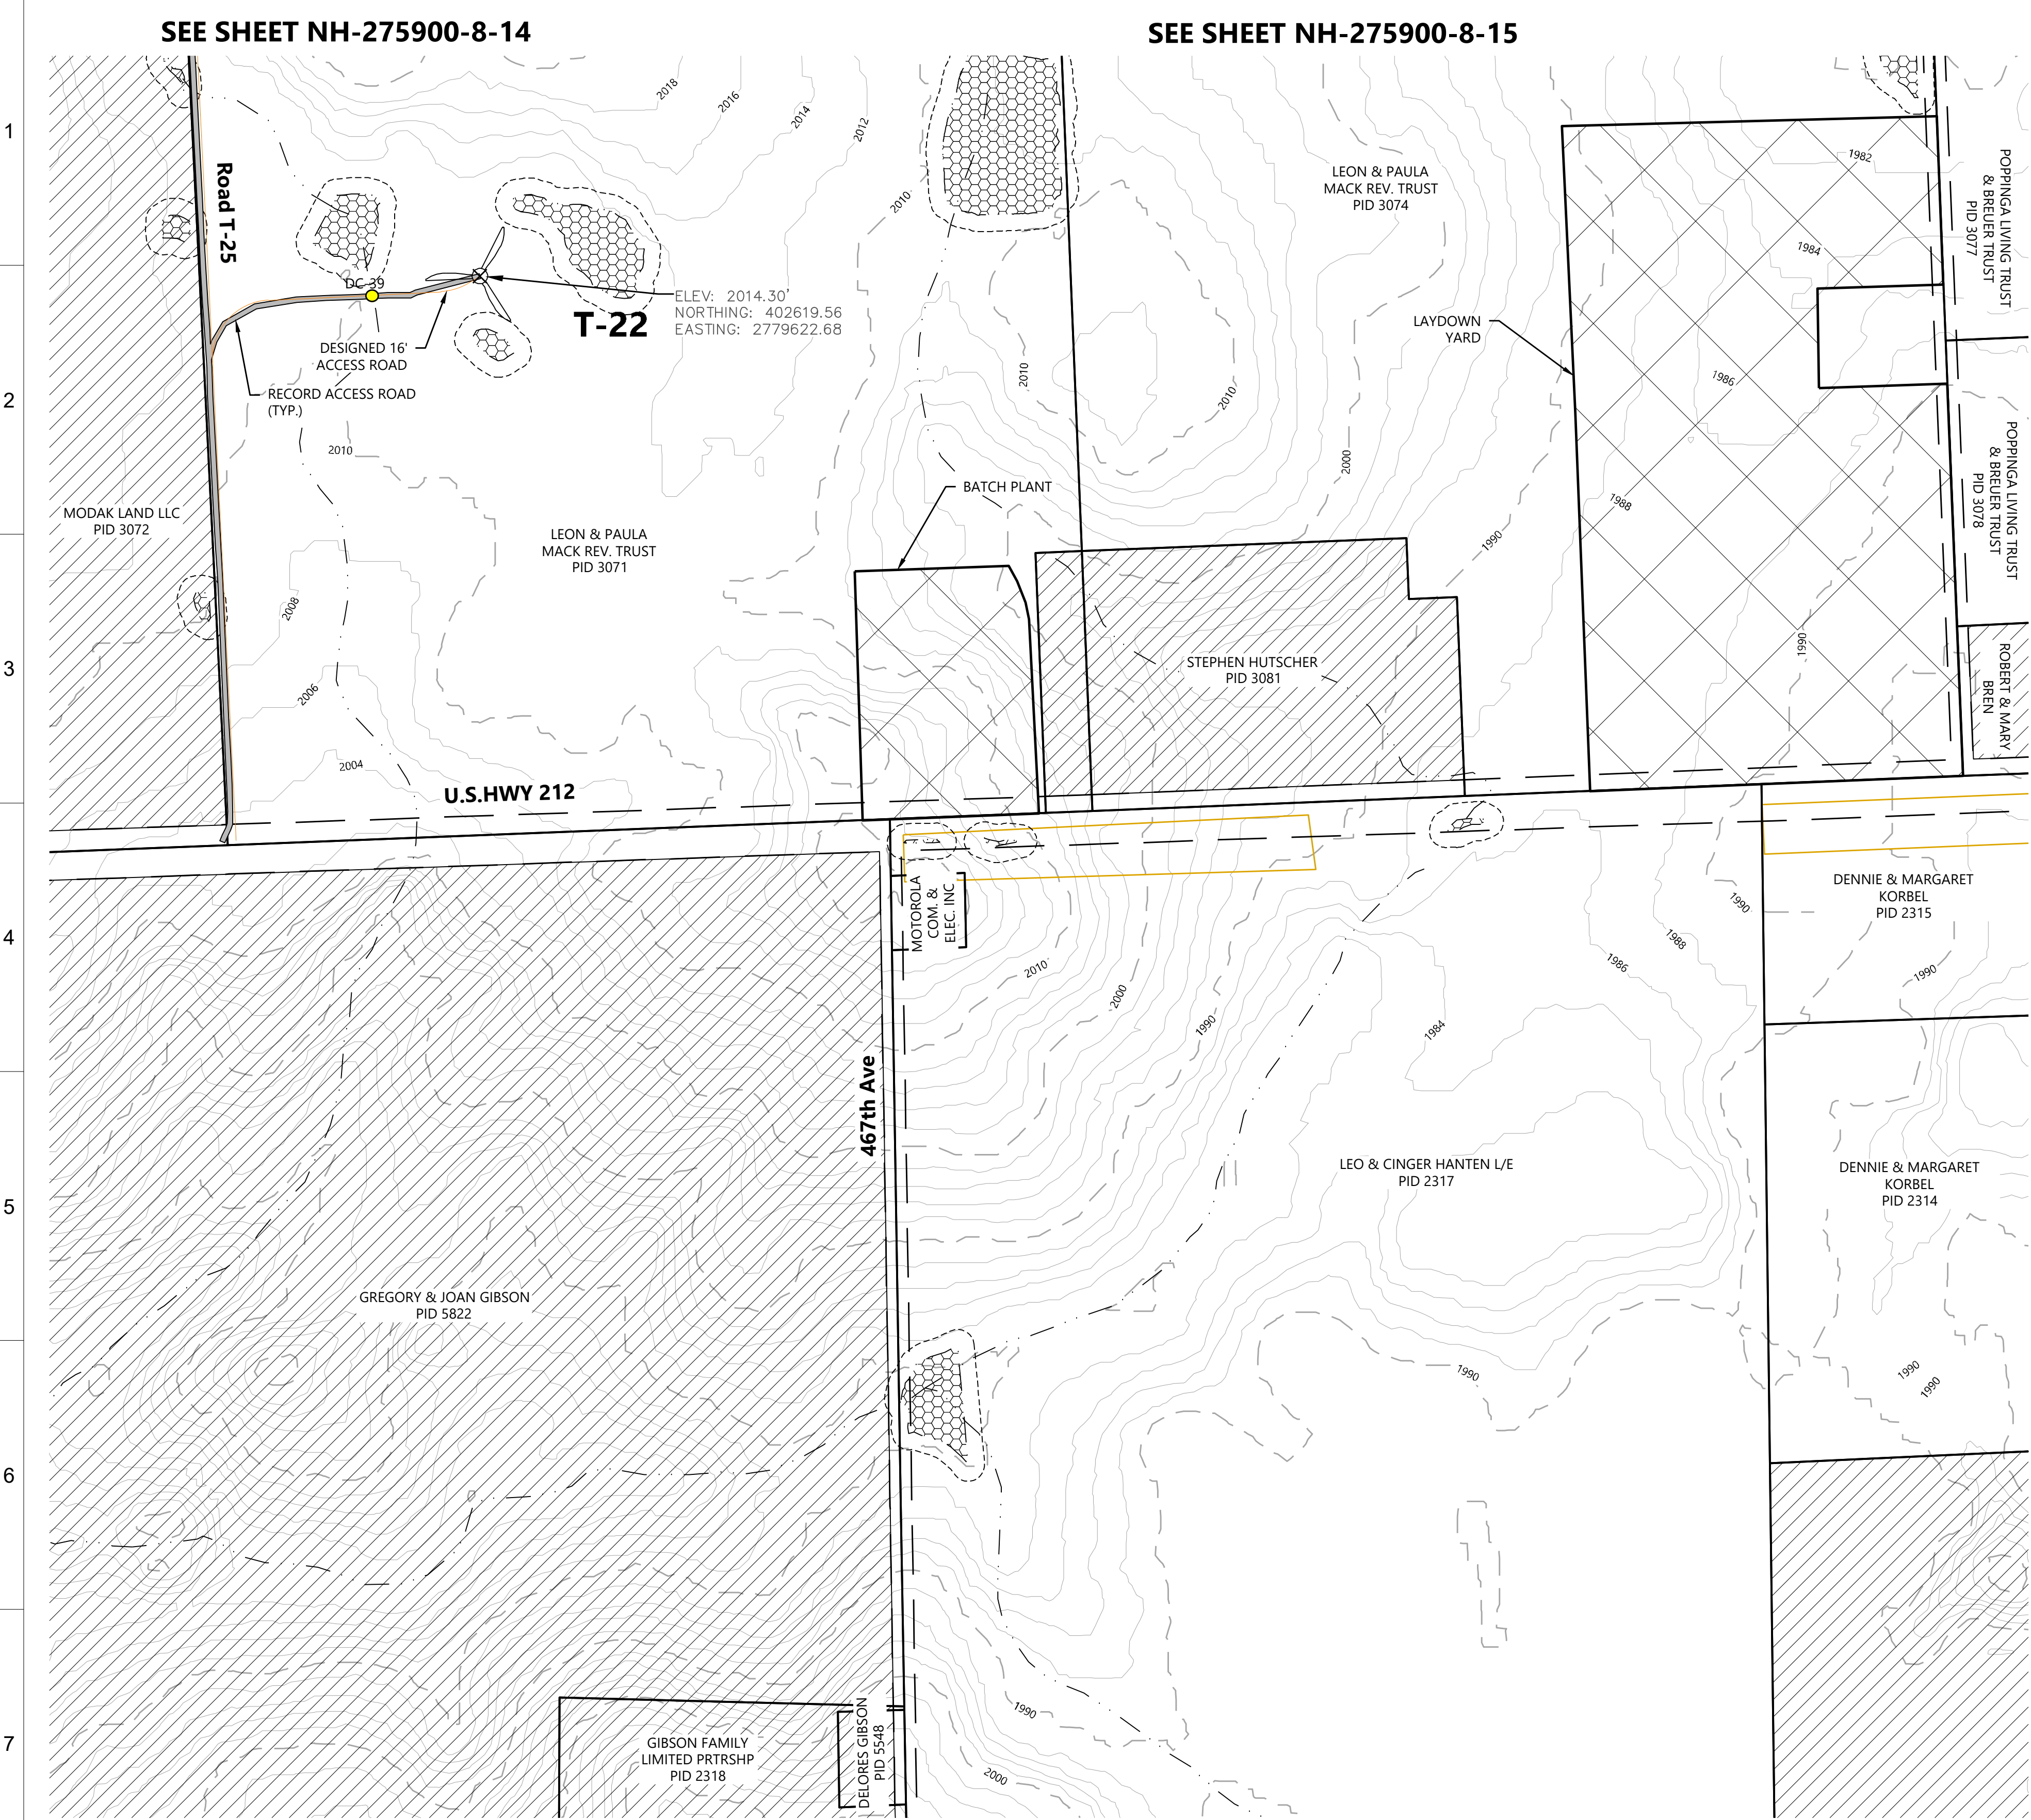

**LEGEND:**

T-#

MET-XX

ADLS

DESIGNED ACCESS ROAD

RECORD ACCESS ROAD

P-FUG

P-POH

NON-PARTICIPATING LAND

PROPERTY LINE

RIGHT-OF-WAY LINES

EASEMENT LINES

RECORD TURBINE LOCATION

MET TOWER LOCATION

ADLS RADAR LOCATION

DESIGNED UNDERGROUND COLLECTION

DESIGNED OVERHEAD TRANSMISSION

NON-PARTICIPATING LAND

PROPERTY LINE

RIGHT-OF-WAY LINES

EASEMENT LINES

POH

GAS

STREAM CHANNEL

WETLAND

WATER SETBACK LINE

FEMA FLOOD ZONE

PROTECTED WILDLIFE BUFFER LINE  
(FINAL BORDERS WILL BE DEFINED  
BY FINAL SWCA PLAN)

ARCHEOLOGICAL AVOIDANCE AREA

EXISTING LAKE

RECORD LOW WATER CROSSING

RECORD CULVERT

EX. INDEX CONTOUR

EX. INTERVAL CONTOUR

EX. OVERHEAD POWER

EX. GAS PIPELINE

EX. STREAM CHANNEL

EX. WETLAND

WATER SETBACK LINE

FEMA FLOOD ZONE

PROTECTED WILDLIFE BUFFER LINE  
(FINAL BORDERS WILL BE DEFINED  
BY FINAL SWCA PLAN)

ARCHEOLOGICAL AVOIDANCE AREA

EXISTING LAKE



RECORD LOW WATER CROSSING

RECORD CULVERT

EX. INDEX CONTOUR

EX. INTERVAL CONTOUR

KEY MAP:

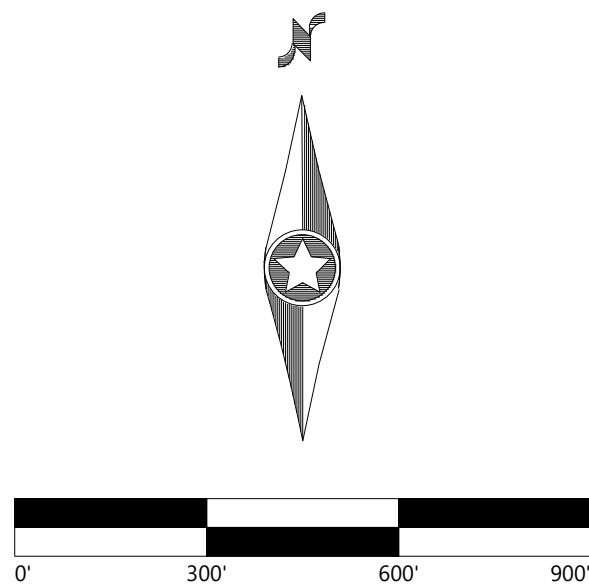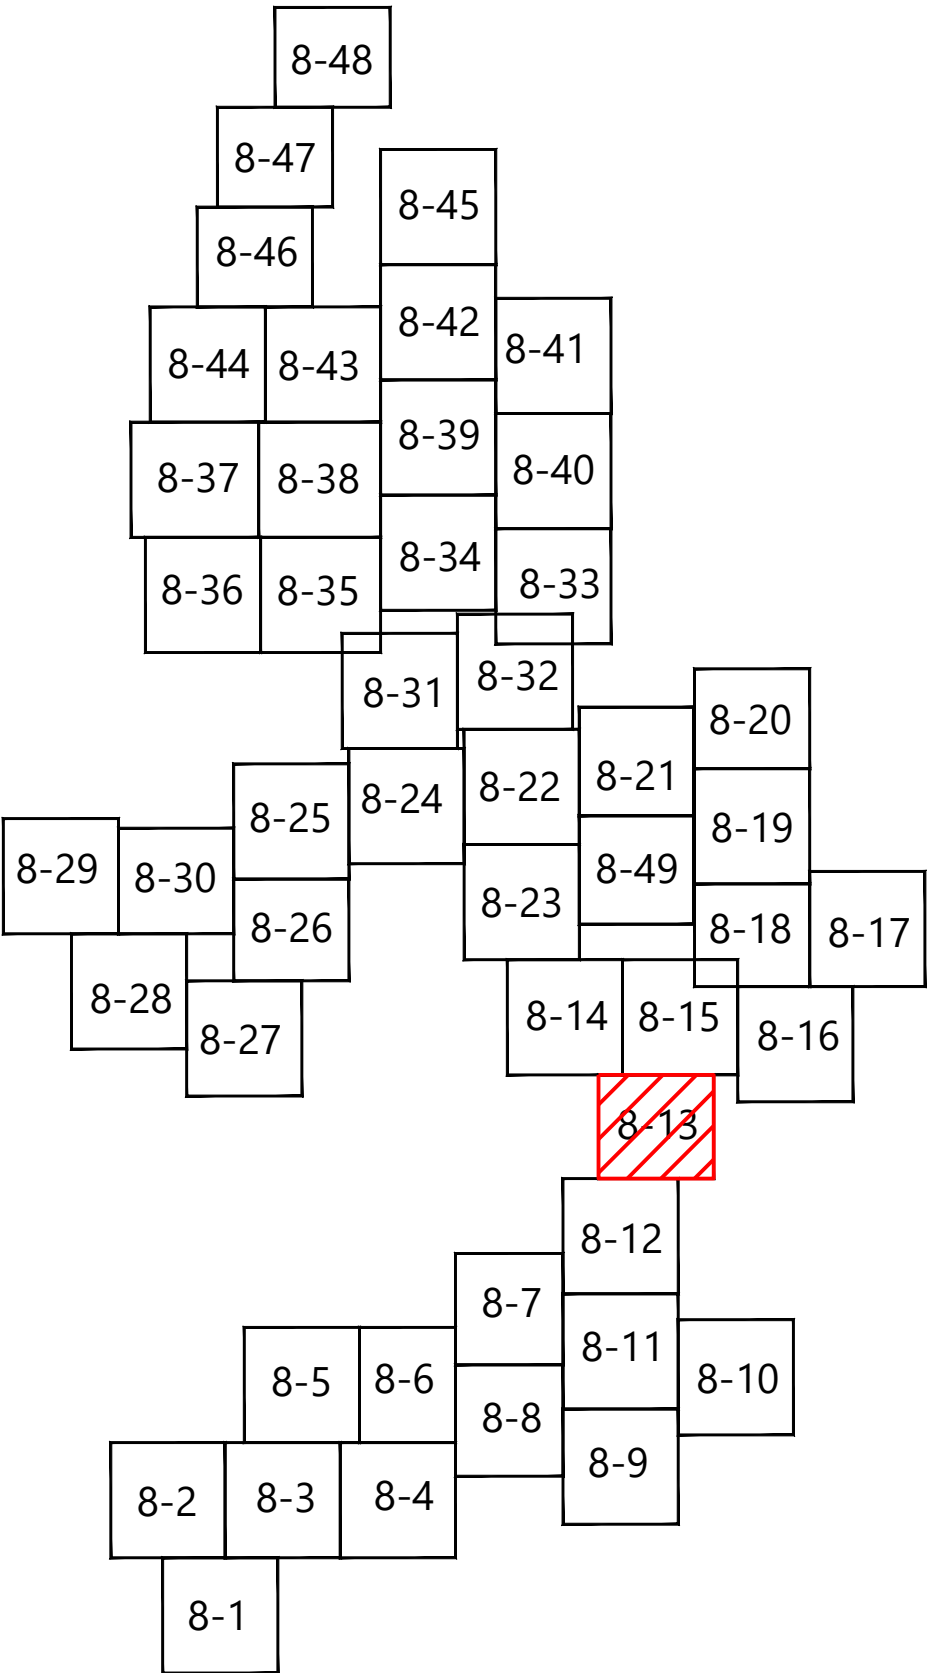

**Westwood**

Phone (214) 473-4640 2740 Dallas Parkway, Suite 280  
Toll Free (888) 937-5150 Plano, TX 75093  
westwoodps.com  
Westwood Professional Services, Inc.

PREPARED FOR:

**BLATTNER  
ENERGY**

392 COUNTY RD 50  
AVON, MN 56310

ISSUE FOR RECORD

NO	REVISION	ZONE	DATE	BY	CHK	ENG	NO	REVISION	ZONE	DATE	BY	CHK	ENG	REFERENCE DRAWINGS		
														DWG NO.	MANUFACTURER	DESCRIPTION
0	ISSUED FOR CONSTRUCTION		05/29/2020	MDR	AA	MDR										
1	ISSUED FOR RECORD - CROWNED RIDGE 22590		11/12/2020	MDR	AA	MDR										

<div><div></div><div>NORTHERN STATES POWER COMPANY</div><div>CROWNED RIDGE II WIND FARM</div><div>CODINGTON, DEUEL, GRANT COUNTIES, SOUTH DAKOTA</div></div>				DWN: MDR	DATE: 11/12/2020	CHK: AA	DATE: 11/12/2020
ENG: MDR	DATE: 11/12/2020	CHK:	DATE:	PM: AA	DATE: 11/12/2020	PROJ. NO: 22590	
APVD:	DATE:	SCALE: 1" = 300'					

THIS MAP/DOCUMENT IS A TOOL TO ASSIST EMPLOYEES IN THE PERFORMANCE OF THEIR JOBS. YOUR PERSONAL SAFETY IS PROVIDED FOR BY USING SAFETY PRACTICES, PROCEDURES, AND EQUIPMENT AS DESCRIBED IN THE SAFETY TRAINING PROGRAMS AND MANUALS.

ENERGY SUPPLY  
ENGINEERING & CONSTRUCTION

UNIT 0  
CIVIL ACCESS ROADS

CIVIL SITE PLAN T-22

NH-275900-8-13

REV  
1



[illegible]



**SEE SHEET NH-275900-8-18**

**SEE SHEET NH-275900-8-16**

**SEE SHEET NH-275900-8-18**

**T-#**  
RECORD TURBINE LOCATION

**MET-XX**  
MET TOWER LOCATION

**ADLS**  
ADLS RADAR LOCATION

DESIGNED ACCESS ROAD

RECORD ACCESS ROAD

DESIGNED UNDERGROUND COLLECTION

DESIGNED OVERHEAD TRANSMISSION

NON-PARTICIPATING LAND

PROPERTY LINE

RIGHT-OF-WAY LINES


EASEMENT LINES

POH  
GAS

EX. OVERHEAD POWER  
EX. GAS PIPELINE  
EX. STREAM CHANNEL  
EX. WETLAND  
WATER SETBACK LINE  
FEMA FLOOD ZONE  
PROTECTED WILDLIFE BUFFER LINE  
(FINAL BORDERS WILL BE DEFINED BY FINAL SWCA PLAN)  
ARCHAEOLOGICAL AVOIDANCE AREA  
EXISTING LAKE  
RECORD LOW WATER CROSSING

**DC-XX**  
RECORD CULVERT

EX. INDEX CONTOUR  
EX. INTERVAL CONTOUR

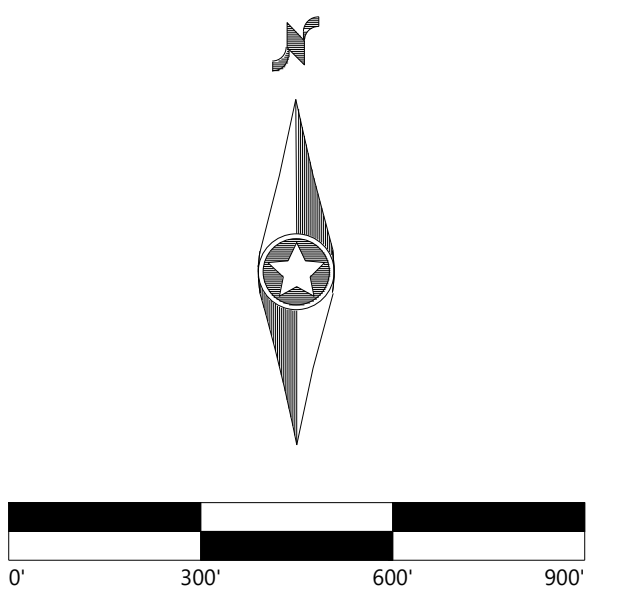

# Westwood

Phone (214) 473-4640 2740 Dallas Parkway, Suite 280  
Toll Free (888) 937-5150 Plano, TX 75093  
westwoodps.com  
Westwood Professional Services, Inc.

PREPARED FOR:




**BLATTNER**  
ENERGY

392 COUNTY RD 50  
AVON, MN 56310

ISSUE FOR RECORD

REVISION							ZONE	DATE	BY	CHK	ENG	NO
0	ISSUED FOR CONSTRUCTION							05/29/2020	MDR	AA	MDR	
1	ISSUED FOR RECORD - CROWNED RIDGE 22590							11/12/2020	MDR	AA	MDR	

REFERENCE DRAWINGS			
DWG NO.	MANUFACTURER	DESCRIPTION	


			
NORTHERN STATES POWER COMPANY CROWNED RIDGE II WIND FARM <small>CODINGTON, DEUEL, GRANT COUNTIES, SOUTH DAKOTA</small>			
DWN: MDR	DATE: 11/12/2020	CHK: AA	DATE: 11/12/2020
ENG: MDR	DATE: 11/12/2020	CHK:	DATE:
PM: AA	DATE: 11/12/2020	PROJ. NO: 22590	
APVD:	DATE:	SCALE: 1" = 300'	

THIS MAP/DOCUMENT IS A TOOL TO ASSIST EMPLOYEES IN THE PERFORMANCE OF THEIR JOBS YOUR PERSONAL SAFETY IS PROVIDED FOR BY USING SAFETY PRACTICES PROCEDURES, AND EQUIPMENT AS DESCRIBED IN THE SAFETY TRAINING PROGRAMS AND MANUALS.		UNIT 0 CIVIL ACCESS ROADS  CIVIL SITE PLAN T-26	
ENERGY SUPPLY ENGINEERING & CONSTRUCTION		NH-275900-8-15	REV 1



SEE SHEET NH-275900-8-18

SEE SHEET NH-275900-8-17

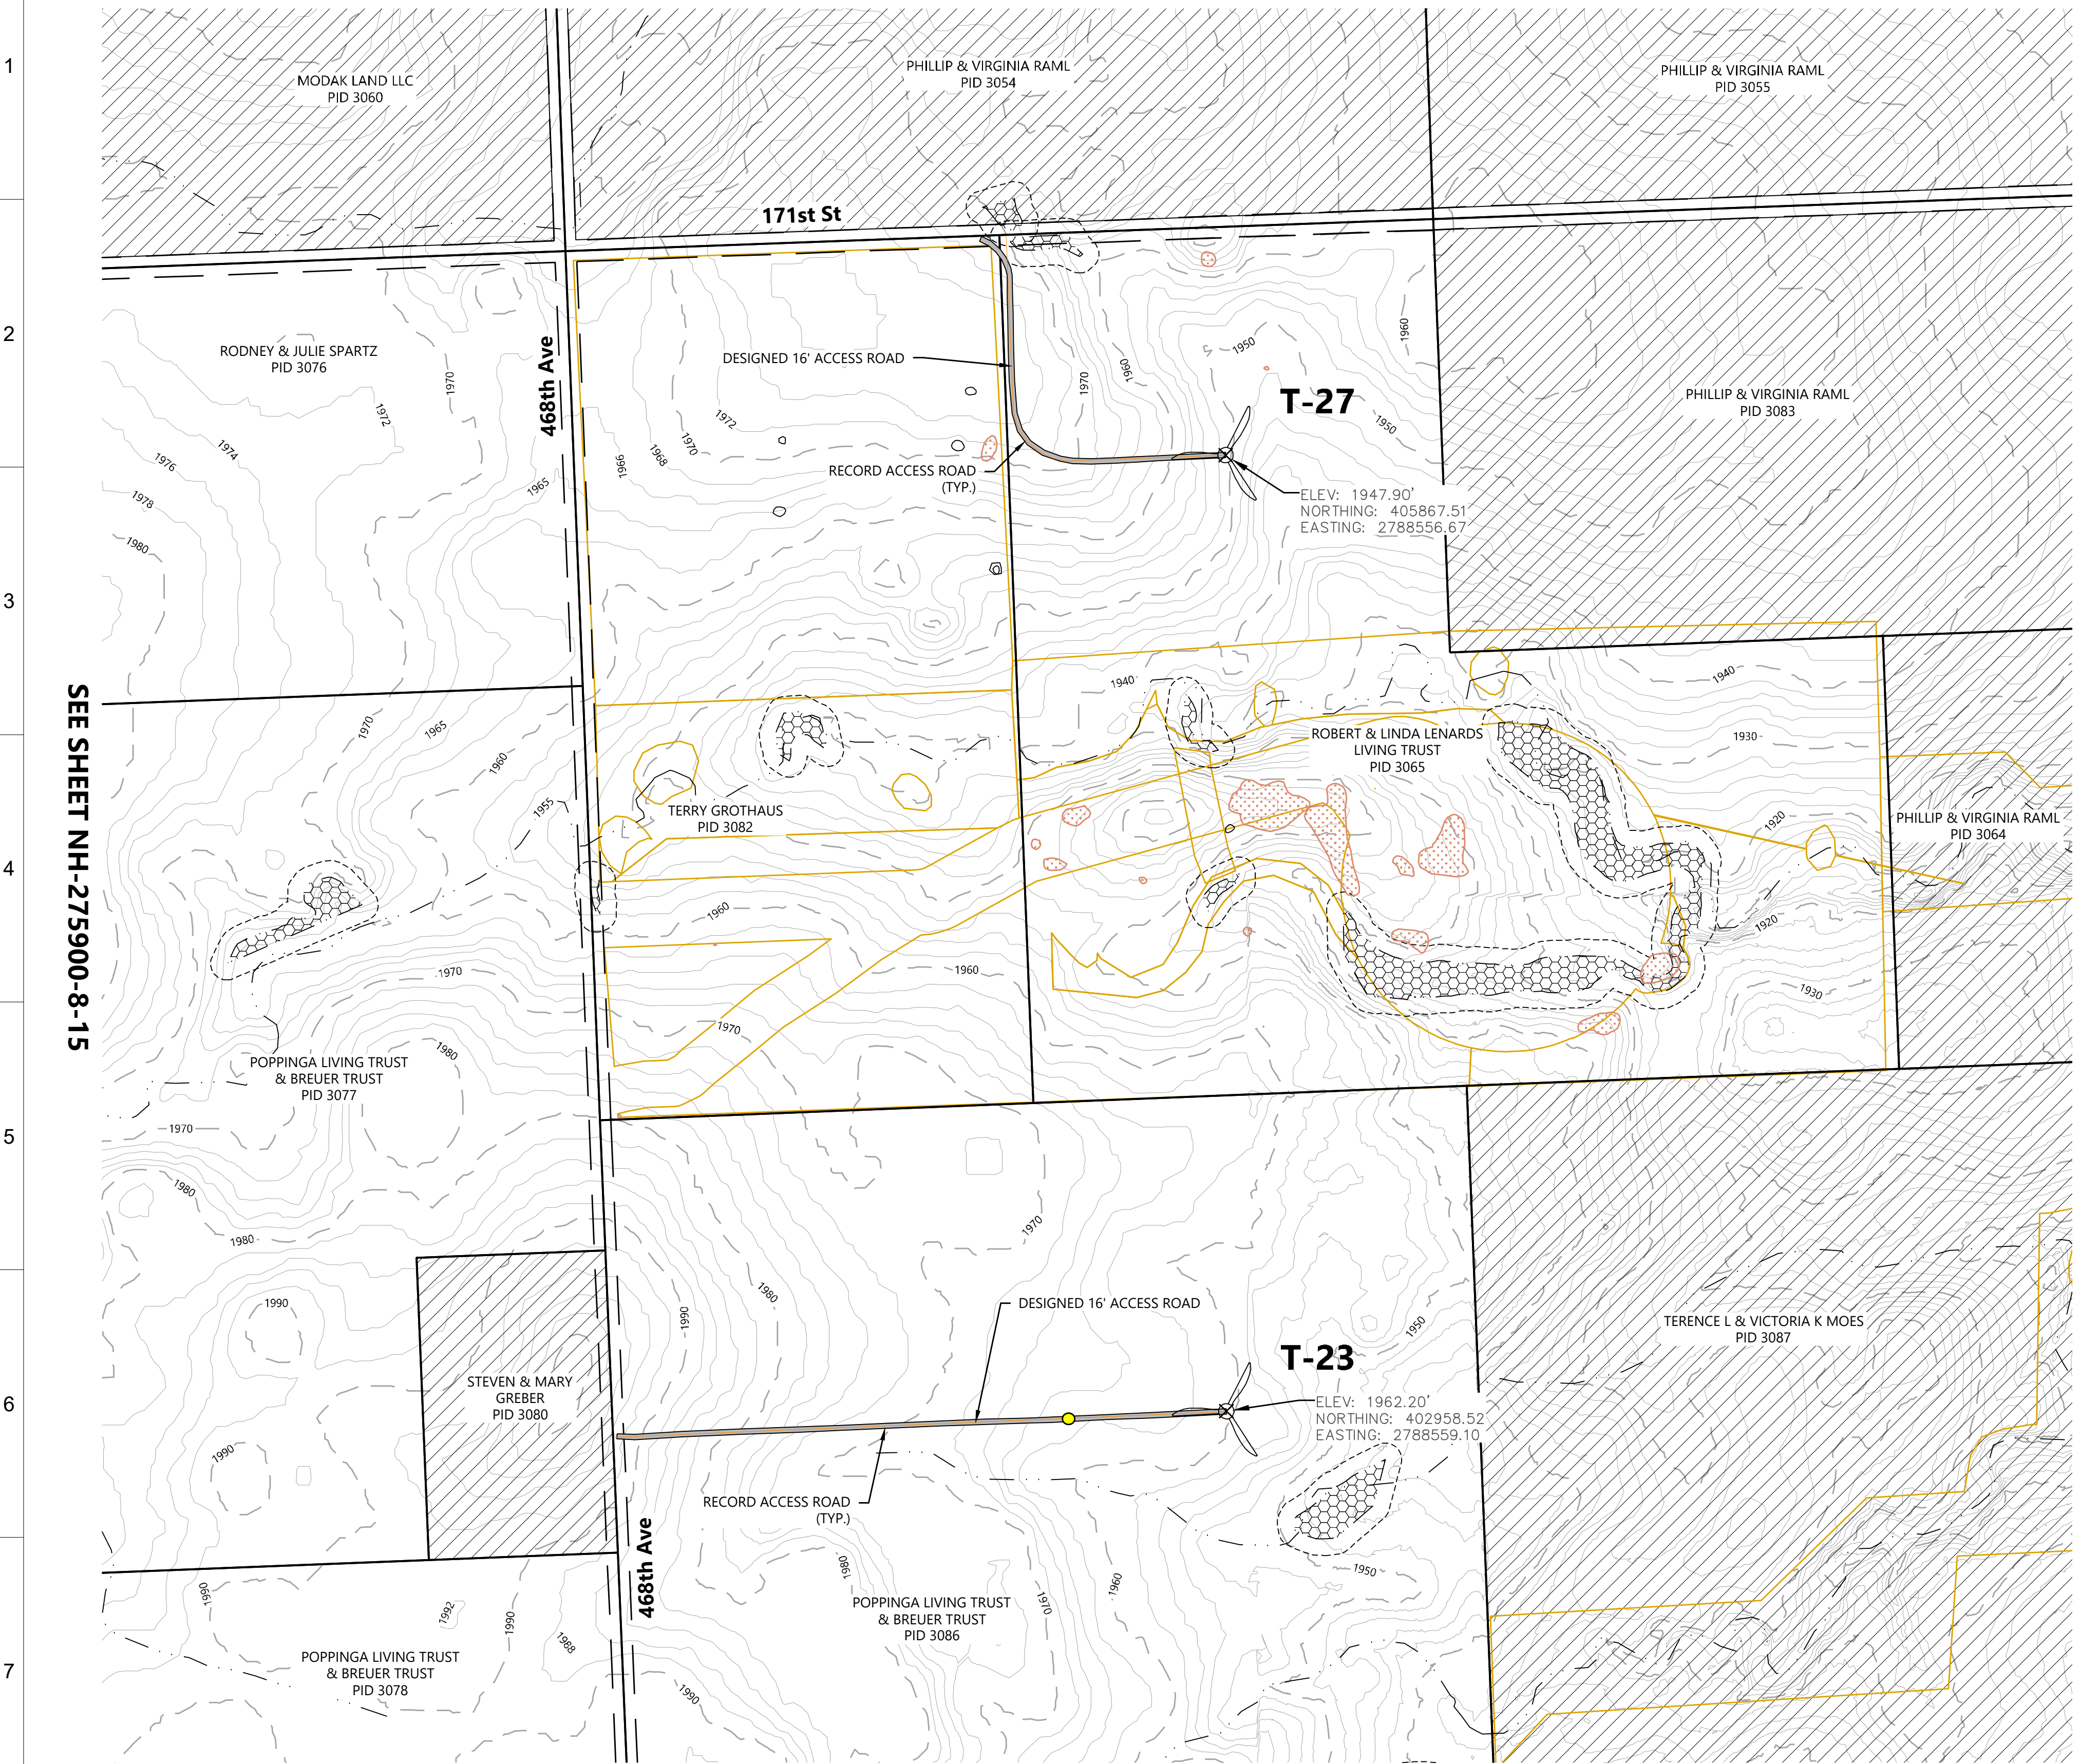

LEGEND:



- T-#

RECORD TURBINE LOCATION
- MET-XX

MET TOWER LOCATION
- ADLS

ADLS RADAR LOCATION
- DESIGNED ACCESS ROAD
- RECORD ACCESS ROAD
- DESIGNED UNDERGROUND COLLECTION
- DESIGNED OVERHEAD TRANSMISSION
- NON-PARTICIPATING LAND
- PROPERTY LINE
- RIGHT-OF-WAY LINES
- EASEMENT LINES
- EX. OVERHEAD POWER
- EX. GAS PIPELINE
- EX. STREAM CHANNEL
- EX. WETLAND
- WATER SETBACK LINE
- FEMA FLOOD ZONE
- PROTECTED WILDLIFE BUFFER LINE  
(FINAL BORDERS WILL BE DEFINED  
BY FINAL SWCA PLAN)
- ARCHEOLOGICAL AVOIDANCE AREA
- EXISTING LAKE
- RECORD LOW WATER CROSSING
- RECORD CULVERT
- EX. INDEX CONTOUR
- EX. INTERVAL CONTOUR

KEY MAP:

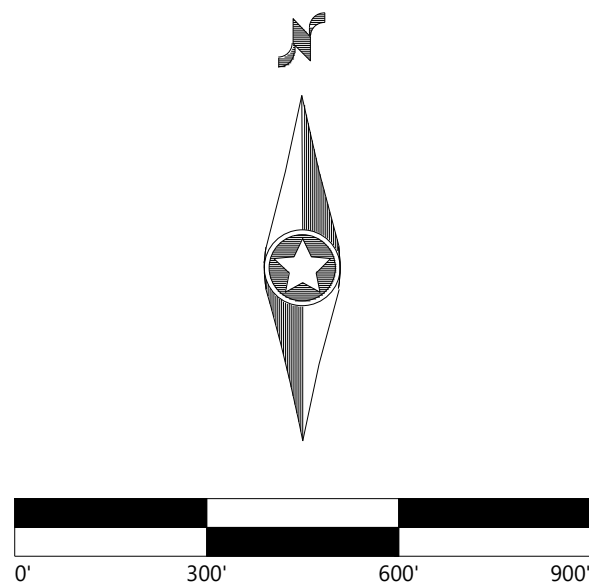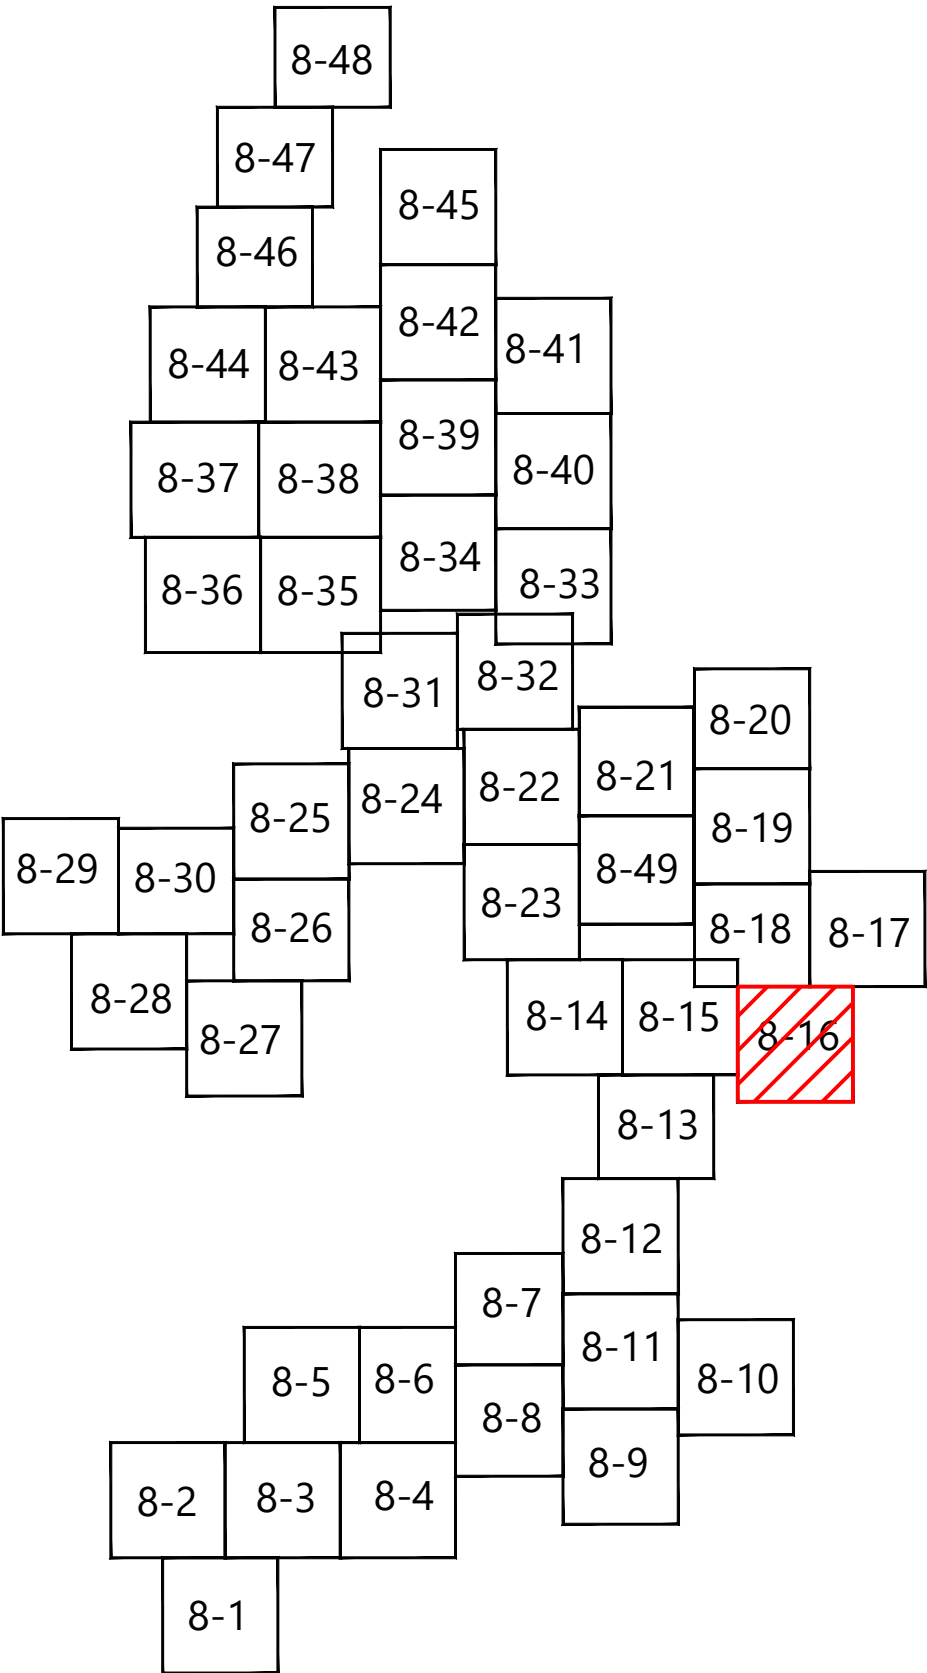

Westwood

Phone (214) 473-4640 2740 Dallas Parkway, Suite 280  
Toll Free (888) 937-5150 Plano, TX 75093  
westwoodps.com

Westwood Professional Services, Inc.

PREPARED FOR:

BLATTNER  
ENERGY

392 COUNTY RD 50  
AVON, MN 56310

ISSUE FOR RECORD

NO	REVISION	ZONE	DATE	BY	CHK	ENG	NO	REVISION	ZONE	DATE	BY	CHK	ENG	REFERENCE DRAWINGS		
														DWG NO.	MANUFACTURER	DESCRIPTION
0	ISSUED FOR CONSTRUCTION		05/29/2020	MDR	AA	MDR										
1	ISSUED FOR RECORD - CROWNED RIGE 22590		11/12/2020	MDR	AA	MDR										

NORTHERN STATES POWER COMPANY			
CROWNED RIDGE II WIND FARM			
CODINGTON, DEUEL, GRANT COUNTIES, SOUTH DAKOTA			
DWN: MDR	DATE: 11/12/2020	CHK: AA	DATE: 11/12/2020
ENG: MDR	DATE: 11/12/2020	CHK:	DATE:
PM: AA	DATE: 11/12/2020	PROJ. NO: 22590	
APVD:	DATE:	SCALE: 1" = 300'	

THIS MAP/DOCUMENT IS A TOOL  
TO ASSIST EMPLOYEES IN THE  
PERFORMANCE OF THEIR JOBS.  
YOUR PERSONAL SAFETY IS  
PROVIDED FOR BY USING  
SAFETY PRACTICES,  
PROCEDURES, AND EQUIPMENT  
AS DESCRIBED IN THE SAFETY  
TRAINING PROGRAMS AND  
MANUALS.

ENERGY SUPPLY  
ENGINEERING & CONSTRUCTION

UNIT 0  
CIVIL ACCESS ROADS

CIVIL SITE PLAN T-23, T-27


NH-275900-8-16

REV  
1






ISSUE FOR RECORD

NO	REVISION	ZONE	DATE	BY	CHK	ENG	NO	REVISION	ZONE	DATE	BY	CHK	ENG	REFERENCE DRAWINGS			 NORTHERN STATES POWER COMPANY CROWNED RIDGE II WIND FARM CODINGTON, DEUEL, GRANT COUNTIES, SOUTH DAKOTA	THIS MAP/DOCUMENT IS A TOOL TO ASSIST EMPLOYEES IN THE PERFORMANCE OF THEIR JOBS. YOUR PERSONAL SAFETY IS PROVIDED FOR BY USING SAFETY PRACTICES, PROCEDURES, AND EQUIPMENT AS DESCRIBED IN THE SAFETY TRAINING PROGRAMS AND MANUALS.	UNIT 0 CIVIL ACCESS ROADS  CIVIL SITE PLAN T-33	REV		
														DWG NO.	MANUFACTURER	DESCRIPTION						
0	ISSUED FOR CONSTRUCTION		05/29/2020	MDR	AA	MDR																
1	ISSUED FOR RECORD - CROWNED RIDGE 22590		11/12/2020	MDR	AA	MDR																
														DWN: MDR	DATE: 11/12/2020	CHK: AA	DATE: 11/12/2020			ENERGY SUPPLY ENGINEERING & CONSTRUCTION	NH-275900-8-17	1
														ENG: MDR	DATE: 11/12/2020	CHK:	DATE:					
														PM: AA	DATE: 11/12/2020	PROJ. NO: 22590						
														APVD:	DATE:	SCALE: 1" = 300'						

	EX. OVERHEAD POWER
	EX. GAS PIPELINE
	EX. STREAM CHANNEL
	EX. WETLAND
	WATER SETBACK LINE
	FEMA FLOOD ZONE
	PROTECTED WILDLIFE BUFFER LINE (FINAL BORDERS WILL BE DEFINED BY FINAL SWCA PLAN)
	ARCHEOLOGICAL AVOIDANCE AREA
	EXISTING LAKE
	RECORD LOW WATER CROSSING
	RECORD CULVERT
	EX. INDEX CONTOUR
	EX. INTERVAL CONTOUR

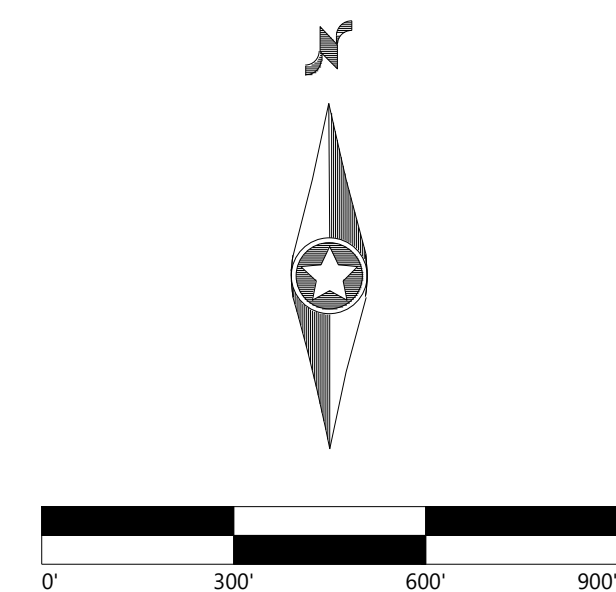

# Westwood

Phone (214) 473-4640 2740 Dallas Parkway, Suite 280  
Toll Free (888) 937-5150 Plano, TX 75093  
**westwoodps.com**

Westwood Professional Services, Inc.

PREPARED FOR:



**BLATTNER**  
**ENERGY**

392 COUNTY RD 50  
AVON, MN 56310

UNIT 0  
CIVIL ACCESS ROADS

CIVIL SITE PLAN T-33


THIS MAP/DOCUMENT IS A TOOL  
TO ASSIST EMPLOYEES IN THE  
PERFORMANCE OF THEIR JOBS.  
YOUR PERSONAL SAFETY IS  
PROVIDED FOR BY USING  
SAFETY PRACTICES,  
PROCEDURES, AND EQUIPMENT  
AS DESCRIBED IN THE SAFETY  
TRAINING PROGRAMS AND  
MANUALS.

ENERGY SUPPLY  
ENGINEERING & CONSTRUCTION

NH-275900-8-17

RE	1
----	---



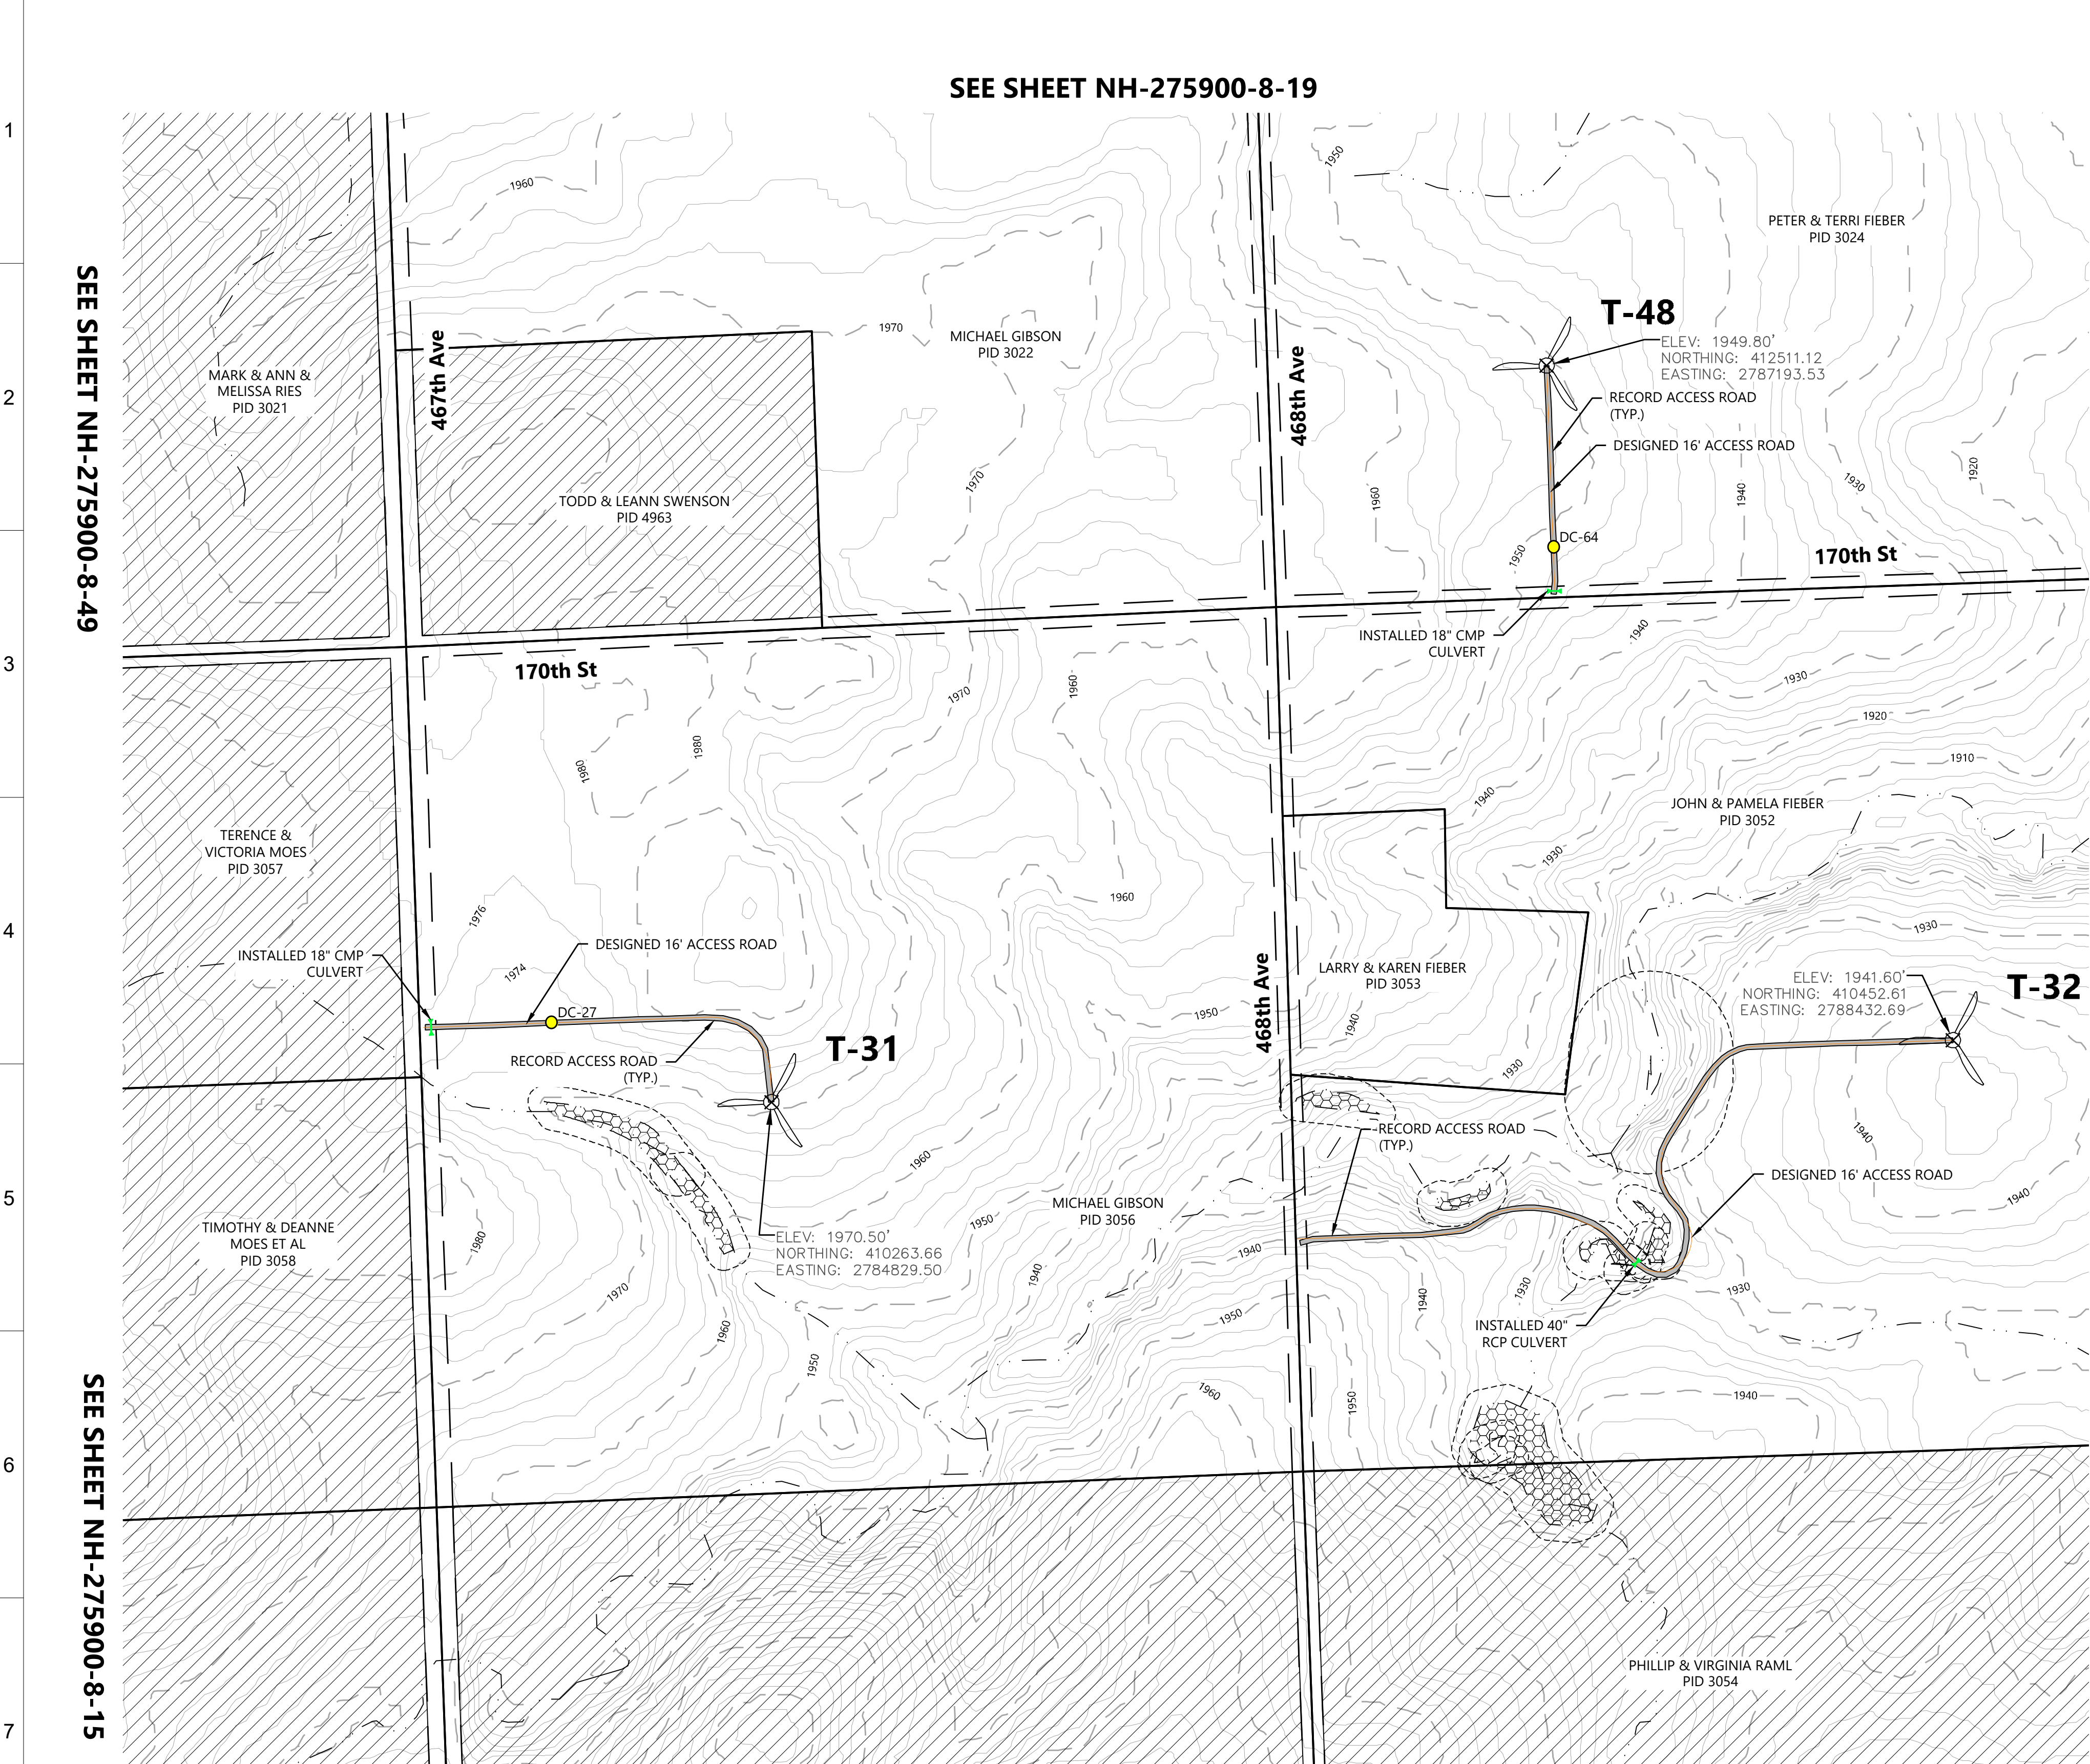

LEGEND:

T-#

RECORD TURBINE LOCATION

MET-XX

MET TOWER LOCATION

ADLS

ADLS RADAR LOCATION

DESIGNED ACCESS ROAD

RECORD ACCESS ROAD

P-PUG

DESIGNED UNDERGROUND COLLECTION

P-PON

DESIGNED OVERHEAD TRANSMISSION

NON-PARTICIPATING LAND

PROPERTY LINE

RIGHT-OF-WAY LINES

EASEMENT LINES

POH

EX. OVERHEAD POWER

GAS

EX. GAS PIPELINE

EX. STREAM CHANNEL

EX. WETLAND

WATER SETBACK LINE

FEMA FLOOD ZONE

PROTECTED WILDLIFE BUFFER LINE  
(FINAL BORDERS WILL BE DEFINED  
BY FINAL SWCA PLAN)

ARCHEOLOGICAL AVOIDANCE AREA

EXISTING LAKE

RECORD LOW WATER CROSSING

RECORD CULVERT

EX. INDEX CONTOUR

EX. INTERVAL CONTOUR

KEY MAP:

Westwood

Phone (214) 473-4640 2740 Dallas Parkway, Suite 280  
Toll Free (888) 937-5150 Plano, TX 75093  
westwoodps.com  
Westwood Professional Services, Inc.

PREPARED FOR:

**BLATTNER ENERGY**

392 COUNTY RD 50  
AVON, MN 56310


REVISION							REVISION							REFERENCE DRAWINGS			DWN: MDR ENG: MDR PM: AA APVD:	Xcel Energy® NORTHERN STATES POWER COMPANY CROWNED RIDGE II WIND FARM CODINGTON, DEUEL, GRANT COUNTIES, SOUTH DAKOTA	THIS MAP/DOCUMENT IS A TOOL TO ASSIST EMPLOYEES IN THE PERFORMANCE OF THEIR JOBS. YOUR PERSONAL SAFETY IS PROVIDED FOR BY USING SAFETY PRACTICES, PROCEDURES, AND EQUIPMENT AS DESCRIBED IN THE SAFETY TRAINING PROGRAMS AND MANUALS.	UNIT 0 CIVIL ACCESS ROADS  CIVIL SITE PLAN T-31, T-32, T-48	NH-275900-8-18	REV 1
NO							NO							DWG NO.	MANUFACTURER	DESCRIPTION						
0	ISSUED FOR CONSTRUCTION																					
1	ISSUED FOR RECORD - CROWNED RIDGE 22590																DATE: 11/12/2020 DATE: 11/12/2020 DATE: 11/12/2020 DATE:	CHK: AA CHK: SCALE: 1" = 300'	DATE: 11/12/2020 DATE: PROJ. NO: 22590			






REV
1



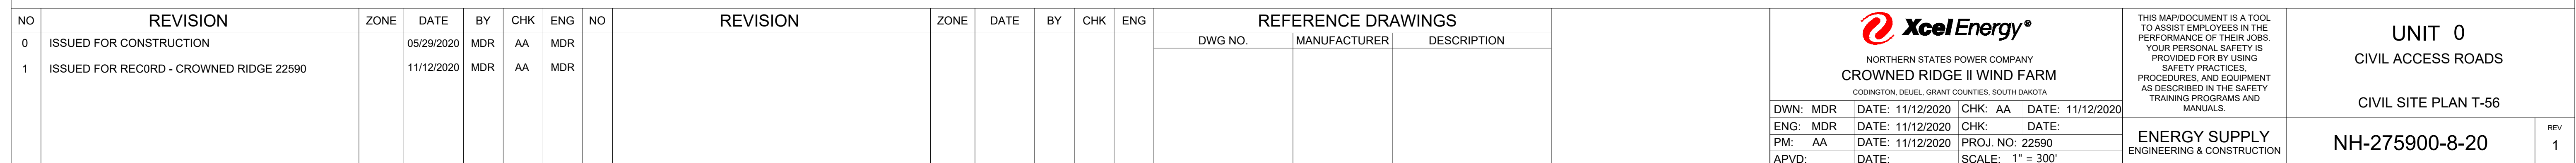



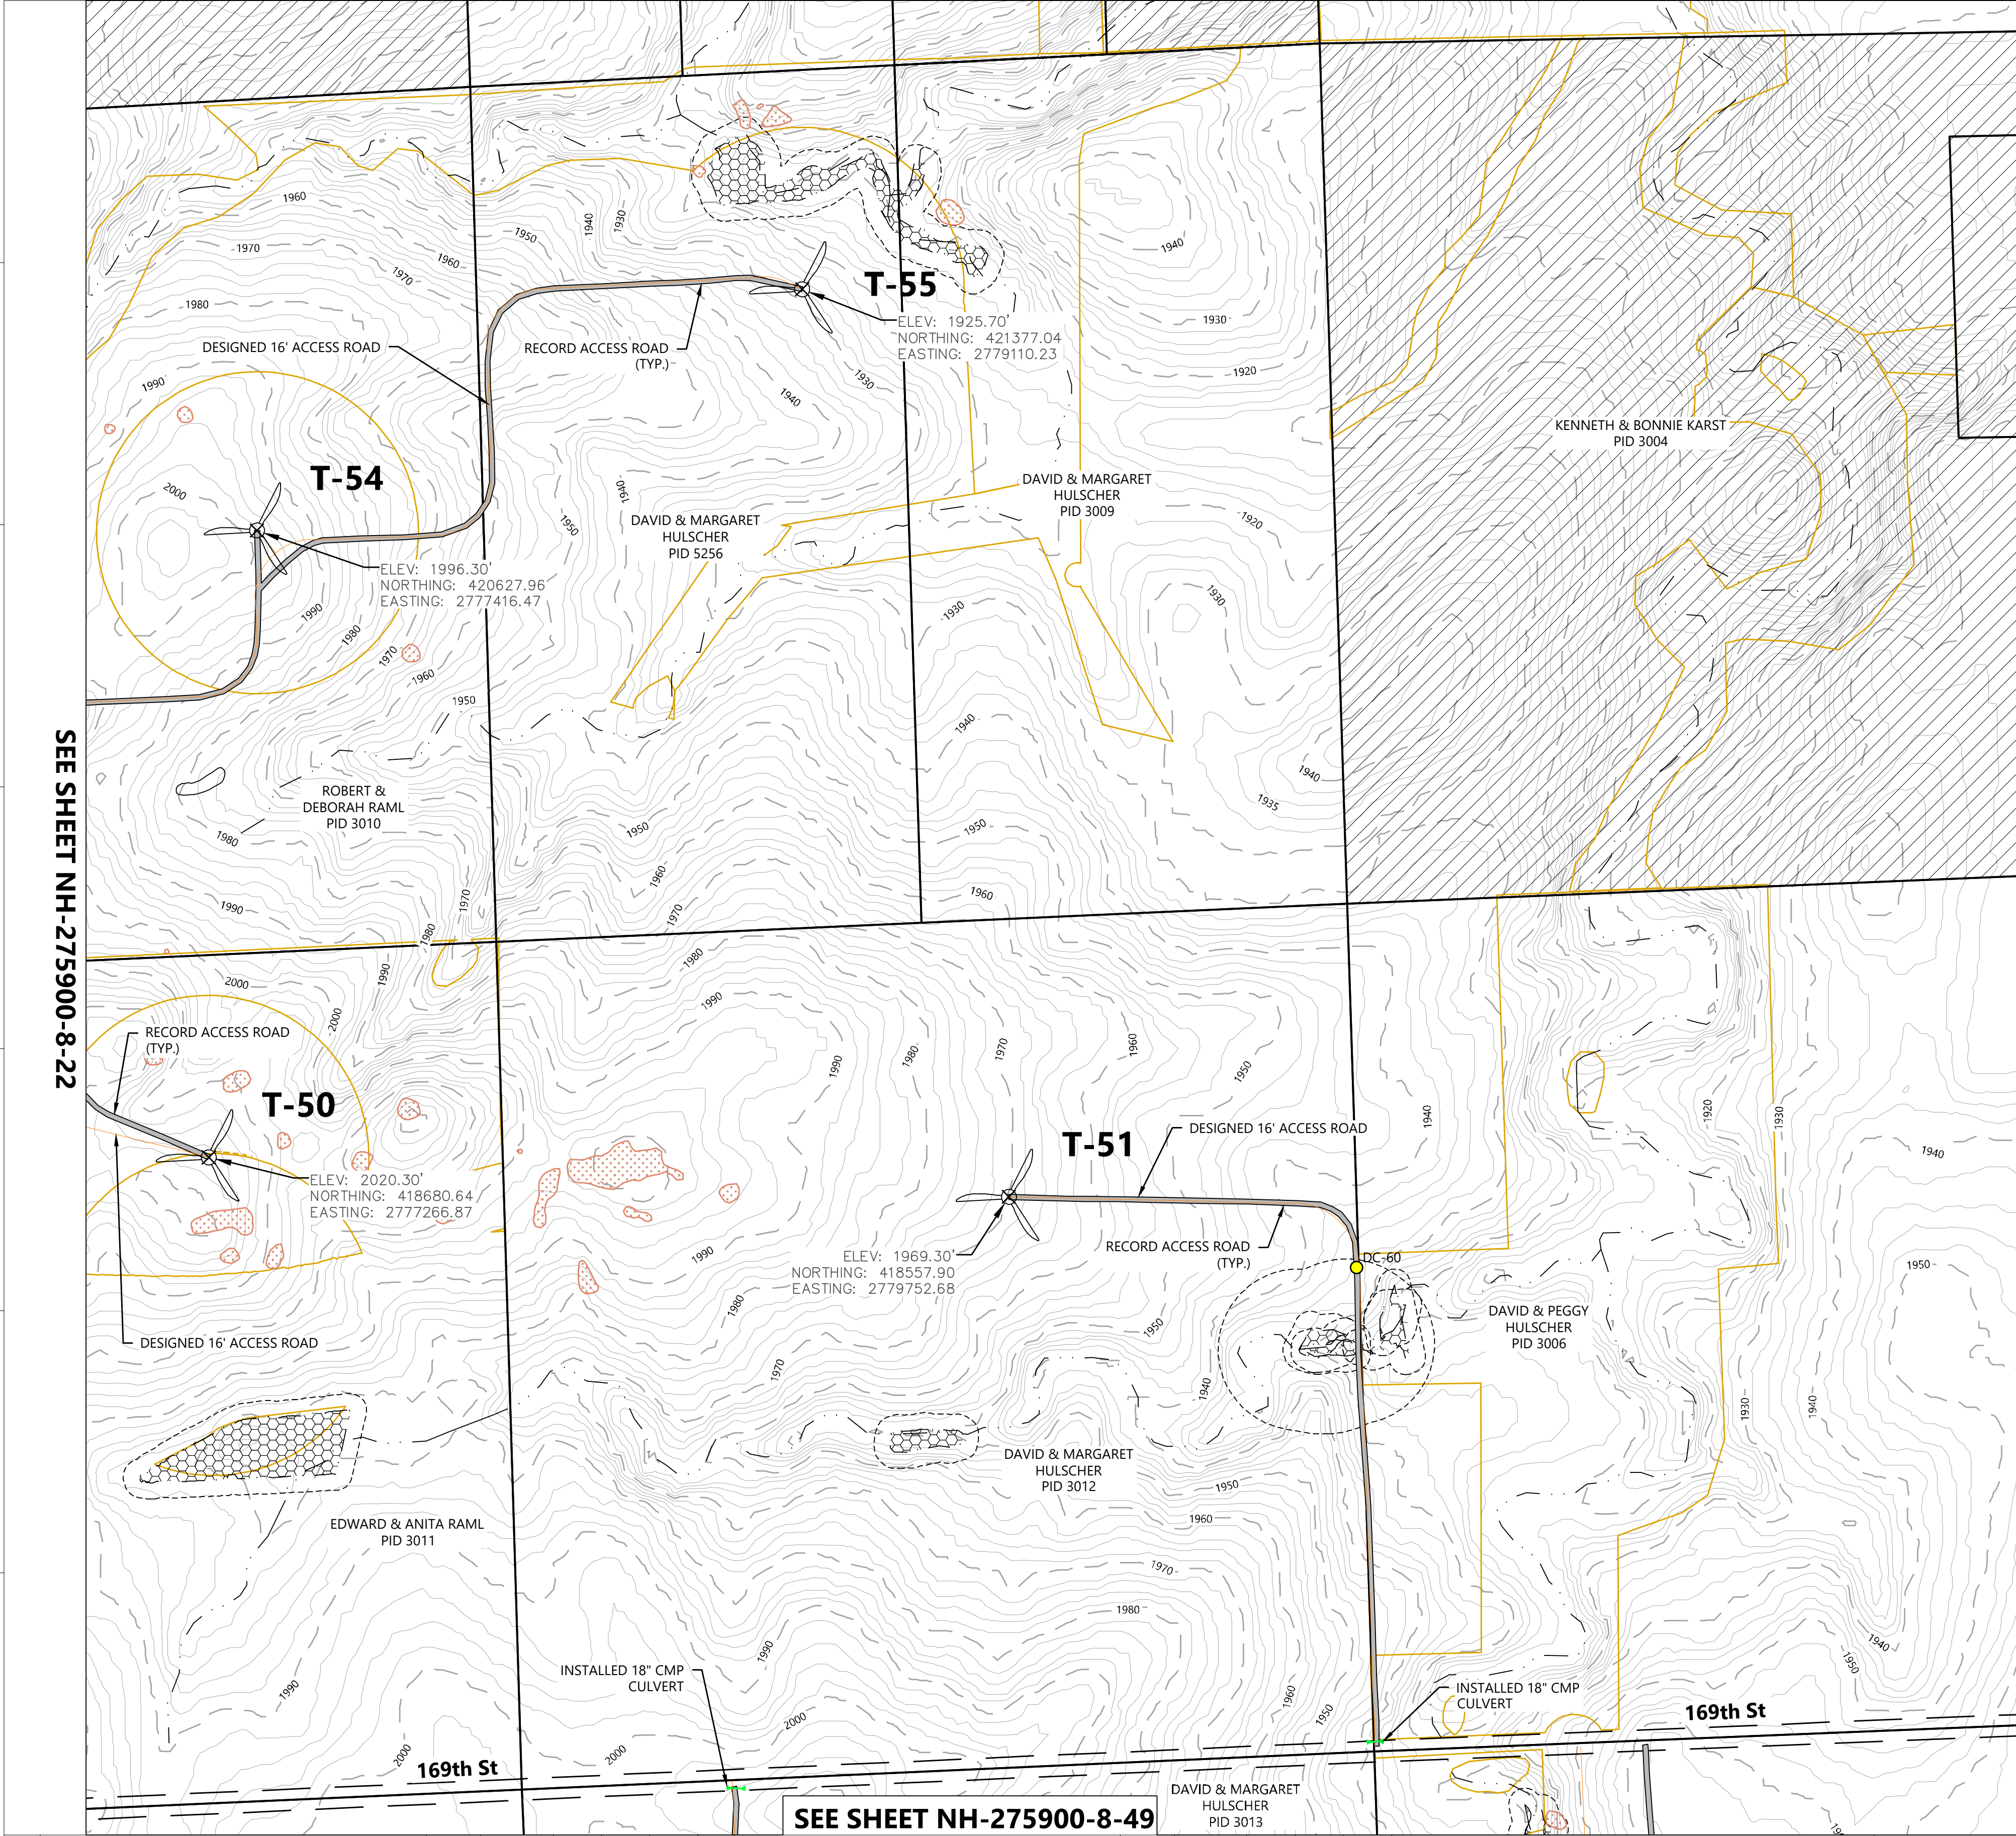

SEE SHEET NH-275900-8-20

SEE SHEET NH-275900-8-19

LEGEND:

T-#

RECORD TURBINE LOCATION

MET-XX

MET TOWER LOCATION

ADLS

ADLS RADAR LOCATION

DESIGNED ACCESS ROAD

RECORD ACCESS ROAD

P-PUG

DESIGNED UNDERGROUND COLLECTION

P-PON

DESIGNED OVERHEAD TRANSMISSION

NON-PARTICIPATING LAND

PROPERTY LINE

RIGHT-OF-WAY LINES

EASEMENT LINES

EX. OVERHEAD POWER

EX. GAS PIPELINE

EX. STREAM CHANNEL

EX. WETLAND

WATER SETBACK LINE

FEMA FLOOD ZONE

PROTECTED WILDLIFE BUFFER LINE  
(FINAL BORDERS WILL BE DEFINED  
BY FINAL SWCA PLAN)

ARCHEOLOGICAL AVOIDANCE AREA

EXISTING LAKE



RECORD LOW WATER CROSSING

RECORD CULVERT

EX. INDEX CONTOUR

EX. INTERVAL CONTOUR

KEY MAP:

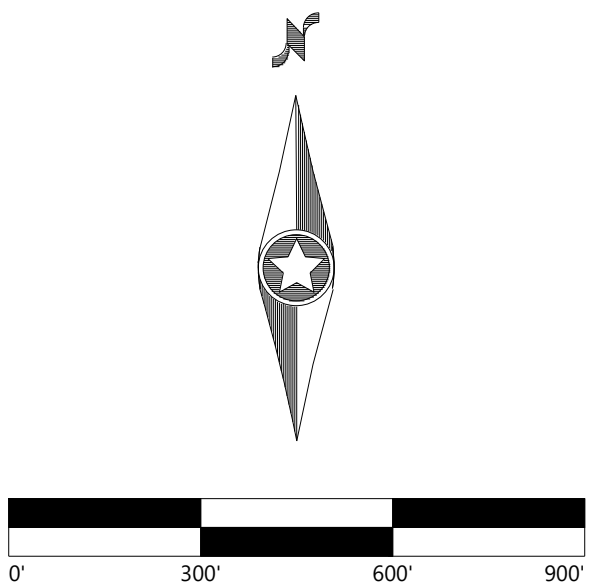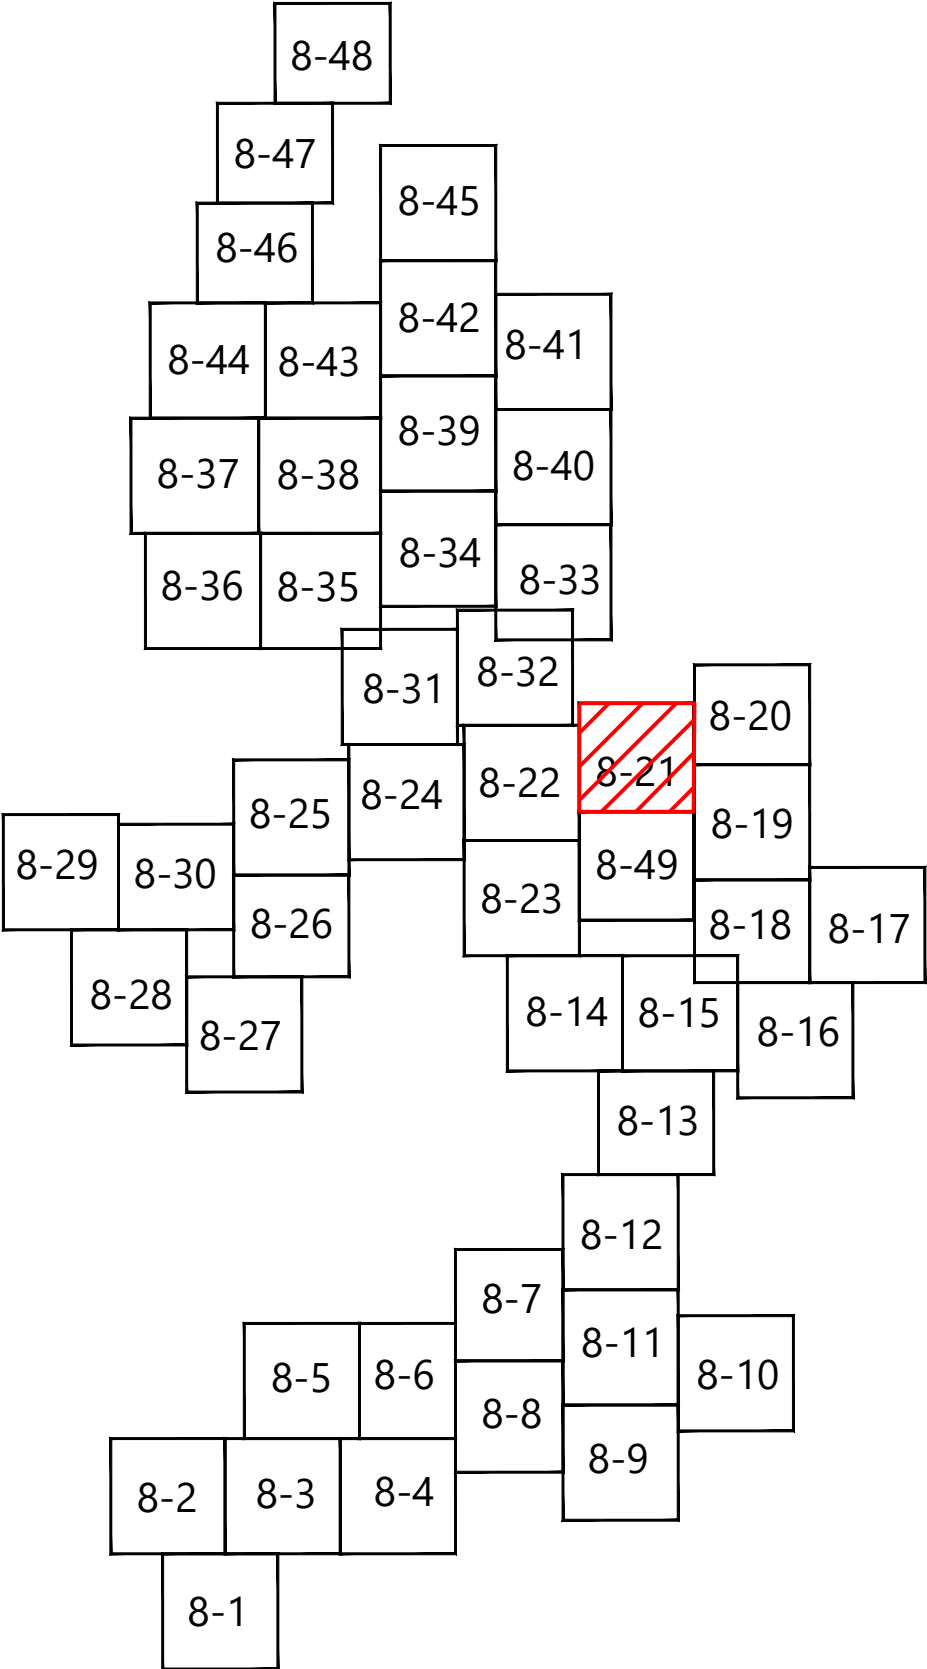

Westwood


Phone (214) 473-4640 2740 Dallas Parkway, Suite 280  
Toll Free (888) 937-5150 Plano, TX 75093  
westwoodps.com  
Westwood Professional Services, Inc.

PREPARED FOR:

BLATTNER  
ENERGY

392 COUNTY RD 50  
AVON, MN 56310

ISSUE FOR RECORD

NO		REVISION	ZONE	DATE	BY	CHK	ENG	NO	REVISION	ZONE	DATE	BY	CHK	ENG	REFERENCE DRAWINGS			<div><div>NORTHERN STATES POWER COMPANY CROWNED RIDGE II WIND FARM <small>CODINGTON, DEUEL, GRANT COUNTIES, SOUTH DAKOTA</small></div></div> <div><div><div>DWN: MDR</div><div>ENG: MDR</div><div>PM: AA</div><div>APVD:</div></div><div><div>DATE: 11/12/2020</div><div>DATE: 11/12/2020</div><div>DATE: 11/12/2020</div><div>DATE:</div></div><div><div>CHK: AA</div><div>CHK:</div><div>PROJ. NO: 22590</div><div>SCALE: 1" = 300'</div></div><div><div>DATE: 11/12/2020</div><div>DATE:</div></div></div> <div>THIS MAP/DOCUMENT IS A TOOL TO ASSIST EMPLOYEES IN THE PERFORMANCE OF THEIR JOBS. YOUR PERSONAL SAFETY IS PROVIDED FOR BY USING SAFETY PRACTICES, PROCEDURES, AND EQUIPMENT AS DESCRIBED IN THE SAFETY TRAINING PROGRAMS AND MANUALS.</div> <div>UNIT 0 CIVIL ACCESS ROADS</div> <div>CIVIL SITE PLAN T-50, T-51, T-54, T-55</div> <div>ENERGY SUPPLY ENGINEERING &amp; CONSTRUCTION</div> <div>NH-275900-8-21</div> <div>REV 1</div>			
															DWG NO.	MANUFACTURER	DESCRIPTION				
0		ISSUED FOR CONSTRUCTION		05/29/2020	MDR	AA	MDR														
1		ISSUED FOR RECORD - CROWNED RIDGE 22590		11/12/2020	MDR	AA	MDR														





ISSUE FOR RECORD

RE	1
----	---





<p style="text-align: center;"><b>UNIT 0</b></p> <p style="text-align: center;"><b>CIVIL ACCESS ROADS</b></p>	
<p style="text-align: center;"><b>CIVIL SITE PLAN T-28, T-43</b></p>	
<p style="text-align: center;"><b>NH-275900-8-23</b></p>	<p style="text-align: center;"><b>REV 1</b></p>









**SEE SHEET NH-275900-8-30**

**SEE SHEET NH-275900-8-26**

ISSUE FOR RECORD

RE  
1













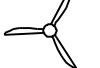




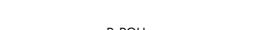


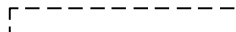









**SEE SHEET NH-275900-8-30**

**SEE SHEET NH-275900-8-27**

## LEGEND:

 <b>T-#</b>	RECORD TURBINE LOCATION	 PGH	EX. OVERHEAD POWER
 <b>MET-XX</b>		 GAS	EX. GAS PIPELINE
 <b>ADLS</b>	MET TOWER LOCATION		EX. STREAM CHANNEL
			EX. WETLAND
			WATER SETBACK LINE
			FEMA FLOOD ZONE
	DESIGNED ACCESS ROAD		PROTECTED WILDLIFE BUFFER LINE (FINAL BORDERS WILL BE DEFINED BY FINAL SWCA PLAN)
	RECORD ACCESS ROAD		ARCHAEOLOGICAL AVOIDANCE AREA
	DESIGNED UNDERGROUND COLLECTION		EXISTING LAKE
	DESIGNED OVERHEAD TRANSMISSION		RECORD LOW WATER CROSSING
	NON-PARTICIPATING LAND		RECORD CULVERT
	PROPERTY LINE	 900	EX. INDEX CONTOUR
	RIGHT-OF-WAY LINES	 902	EX. INTERVAL CONTOUR
	EASEMENT LINES		

KEY MAP:

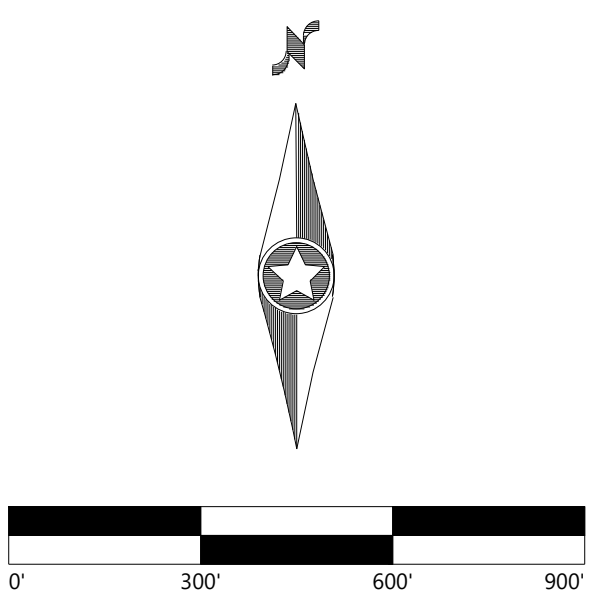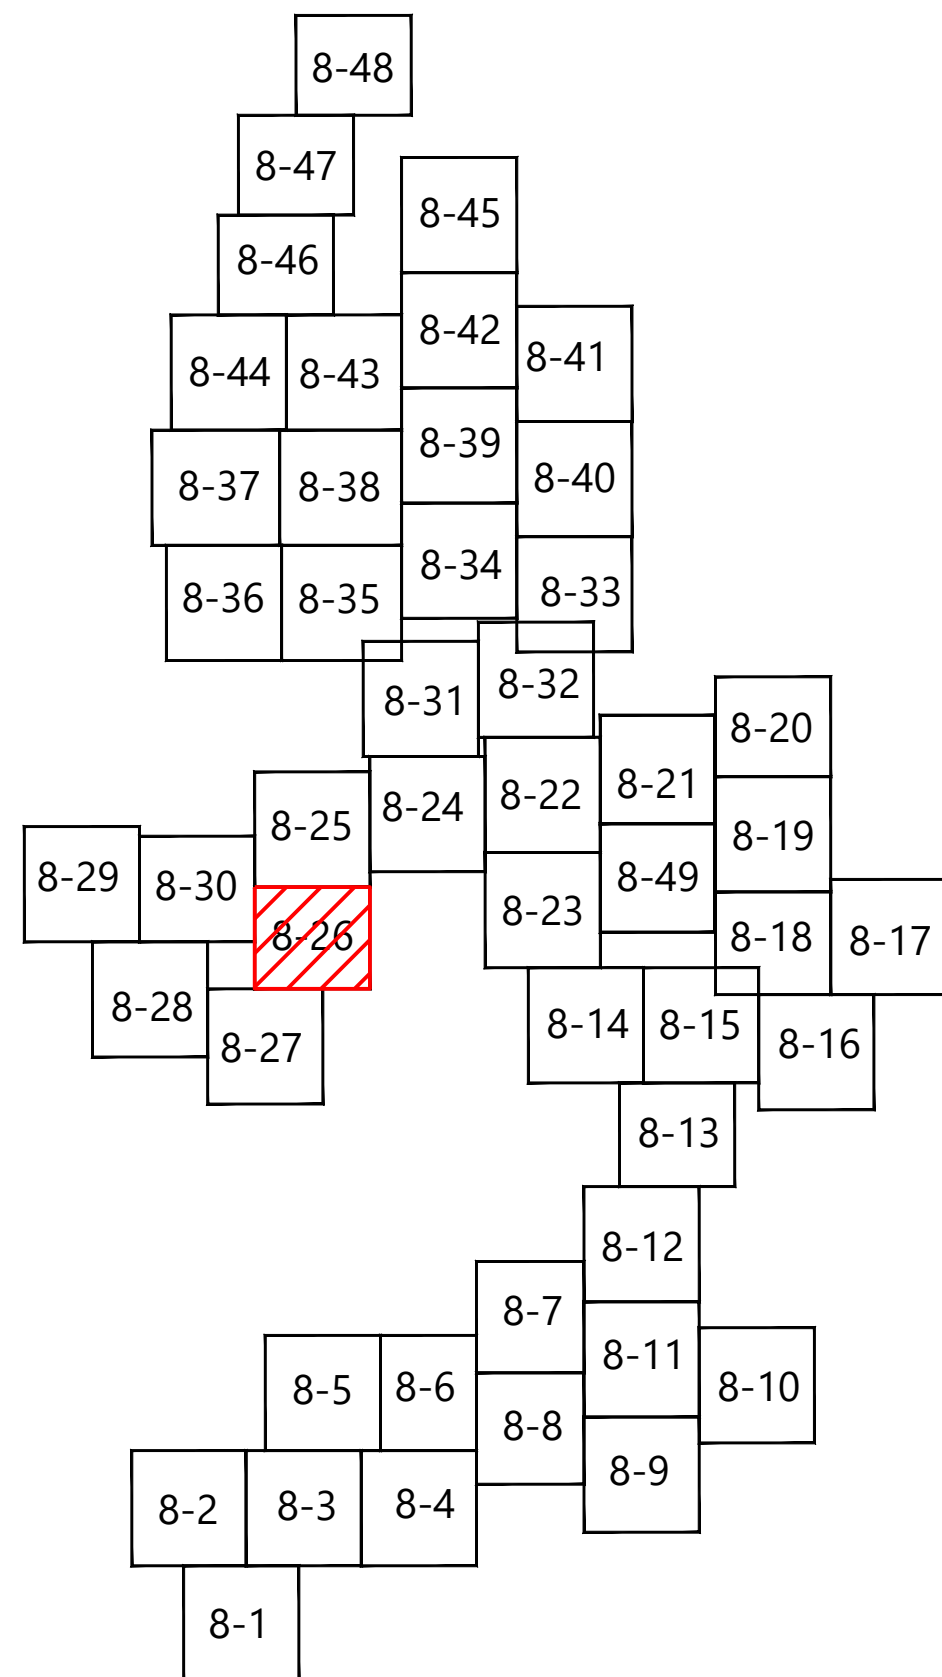

# Westwood

Phone (214) 473-4640 2740 Dallas Parkway, Suite 280  
Toll Free (888) 937-5150 Plano, TX 75093  
westwoodps.com

Westwood Professional Services, Inc.


PREPARED FOR:



**BLATTNER**  
**ENERGY**

392 COUNTY RD 50  
AVON, MN 56310

ISSUE FOR RECORD

NO		REVISION	ZONE	DATE	BY	CHK	ENG	NO	REVISION	ZONE	DATE	BY	CHK	ENG	REFERENCE DRAWINGS			<div><div><p>NORTHERN STATES POWER COMPANY CROWNED RIDGE II WIND FARM CODINGTON, DEUEL, GRANT COUNTIES, SOUTH DAKOTA</p><table><tr><td>DWN: MDR</td><td>DATE: 11/12/2020</td><td>CHK: AA</td><td>DATE: 11/12/2020</td></tr><tr><td>ENG: MDR</td><td>DATE: 11/12/2020</td><td>CHK:</td><td>DATE:</td></tr><tr><td>PM: AA</td><td>DATE: 11/12/2020</td><td colspan="2">PROJ. NO: 22590</td></tr><tr><td>APVD:</td><td>DATE:</td><td colspan="2">SCALE: 1" = 300'</td></tr></table></div><div>THIS MAP/DOCUMENT IS A TOOL TO ASSIST EMPLOYEES IN THE PERFORMANCE OF THEIR JOBS. YOUR PERSONAL SAFETY IS PROVIDED FOR BY USING SAFETY PRACTICES, PROCEDURES, AND EQUIPMENT AS DESCRIBED IN THE SAFETY TRAINING PROGRAMS AND MANUALS.</div><div>ENERGY SUPPLY ENGINEERING &amp; CONSTRUCTION</div></div>				DWN: MDR	DATE: 11/12/2020	CHK: AA	DATE: 11/12/2020	ENG: MDR	DATE: 11/12/2020	CHK:	DATE:	PM: AA	DATE: 11/12/2020	PROJ. NO: 22590		APVD:	DATE:	SCALE: 1" = 300'	
DWN: MDR	DATE: 11/12/2020	CHK: AA	DATE: 11/12/2020																																		
ENG: MDR	DATE: 11/12/2020	CHK:	DATE:																																		
PM: AA	DATE: 11/12/2020	PROJ. NO: 22590																																			
APVD:	DATE:	SCALE: 1" = 300'																																			
DWG NO.		MANUFACTURER	DESCRIPTION																																		
0	ISSUED FOR CONSTRUCTION			05/29/2020	MDR	AA	MDR											UNIT 0 CIVIL ACCESS ROADS																			
1	ISSUED FOR RECORD - CROWNED RIDGE 22590			11/12/2020	MDR	AA	MDR											CIVIL SITE PLAN T-39																			
																			NH-275900-8-26		REV 1																





REV
1





**T-#**  
RECORD TURBINE LOCATION

**MET-XX**  
MET TOWER LOCATION

**ADLS**  
ADLS RADAR LOCATION

DESIGNED ACCESS ROAD

RECORD ACCESS ROAD

DESIGNED UNDERGROUND COLLECTION

DESIGNED OVERHEAD TRANSMISSION

NON-PARTICIPATING LAND

PROPERTY LINE

RIGHT-OF-WAY LINES

EASEMENT LINES

EX. OVERHEAD POWER

EX. GAS PIPELINE

EX. STREAM CHANNEL

EX. WETLAND

WATER SETBACK LINE

FEMA FLOOD ZONE

PROTECTED WILDLIFE BUFFER LINE  
(FINAL BORDERS WILL BE DEFINED BY FINAL SWCA PLAN)

ARCHEOLOGICAL AVOIDANCE AREA


EXISTING LAKE

RECORD LOW WATER CROSSING

RECORD CULVERT

EX. INDEX CONTOUR

EX. INTERVAL CONTOUR

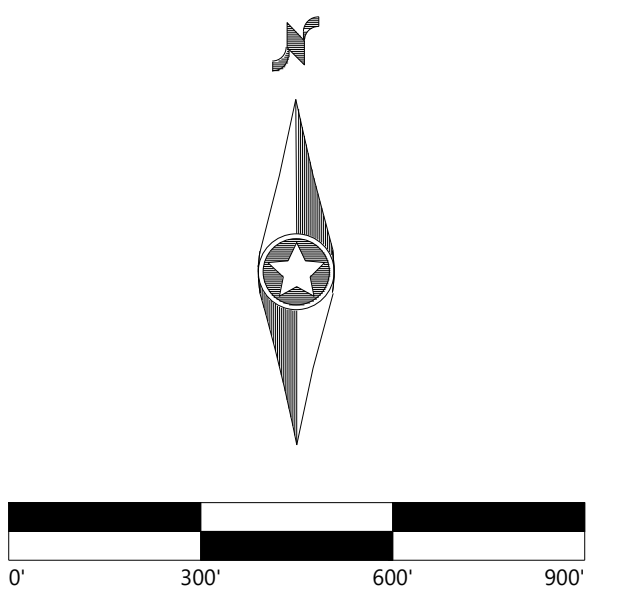

Phone (214) 473-4640 2740 Dallas Parkway, Suite 280  
Toll Free (888) 937-5150 Plano, TX 75093  
westwoodps.com

Westwood Professional Services, Inc.

PREPARED FOR:




**BLATTNER**  
**ENERGY**

392 COUNTY RD 50  
AVON, MN 56310

ISSUE FOR RECORD

NO	REVISION	ZONE	DATE	BY	CHK	ENG	NO	REVISION	ZONE	DATE	BY	CHK	ENG	REFERENCE DRAWINGS		
0	ISSUED FOR CONSTRUCTION		05/29/2020	MDR	AA	MDR								DWG NO.	MANUFACTURER	DESCRIPTION
1	ISSUED FOR RECORD - CROWNED RIDGE 22590		11/12/2020	MDR	AA	MDR										
<div><div><div>Xcel Energy®</div><div>NORTHERN STATES POWER COMPANY CROWNED RIDGE II WIND FARM <small>CODINGTON, DEUEL, GRANT COUNTIES, SOUTH DAKOTA</small></div><div><div>DWN: MDR   DATE: 11/12/2020   CHK: AA   DATE: 11/12/2020</div><div>ENG: MDR   DATE: 11/12/2020   CHK: CHK:   DATE:</div><div>PM: AA   DATE: 11/12/2020   PROJ. NO: 22590</div><div>APVD:   DATE:   SCALE: 1" = 300'</div></div></div><div><div>THIS MAP/DOCUMENT IS A TOOL TO ASSIST EMPLOYEES IN THE PERFORMANCE OF THEIR JOBS. YOUR PERSONAL SAFETY IS PROVIDED FOR BY USING SAFETY PRACTICES, PROCEDURES, AND EQUIPMENT AS DESCRIBED IN THE SAFETY TRAINING PROGRAMS AND MANUALS.</div><div>ENERGY SUPPLY ENGINEERING &amp; CONSTRUCTION</div></div><div><div>UNIT 0 CIVIL ACCESS ROADS</div><div>CIVIL SITE PLAN T-34, T-35</div><div>NH-275900-8-28</div><div>REV 1</div></div></div>																



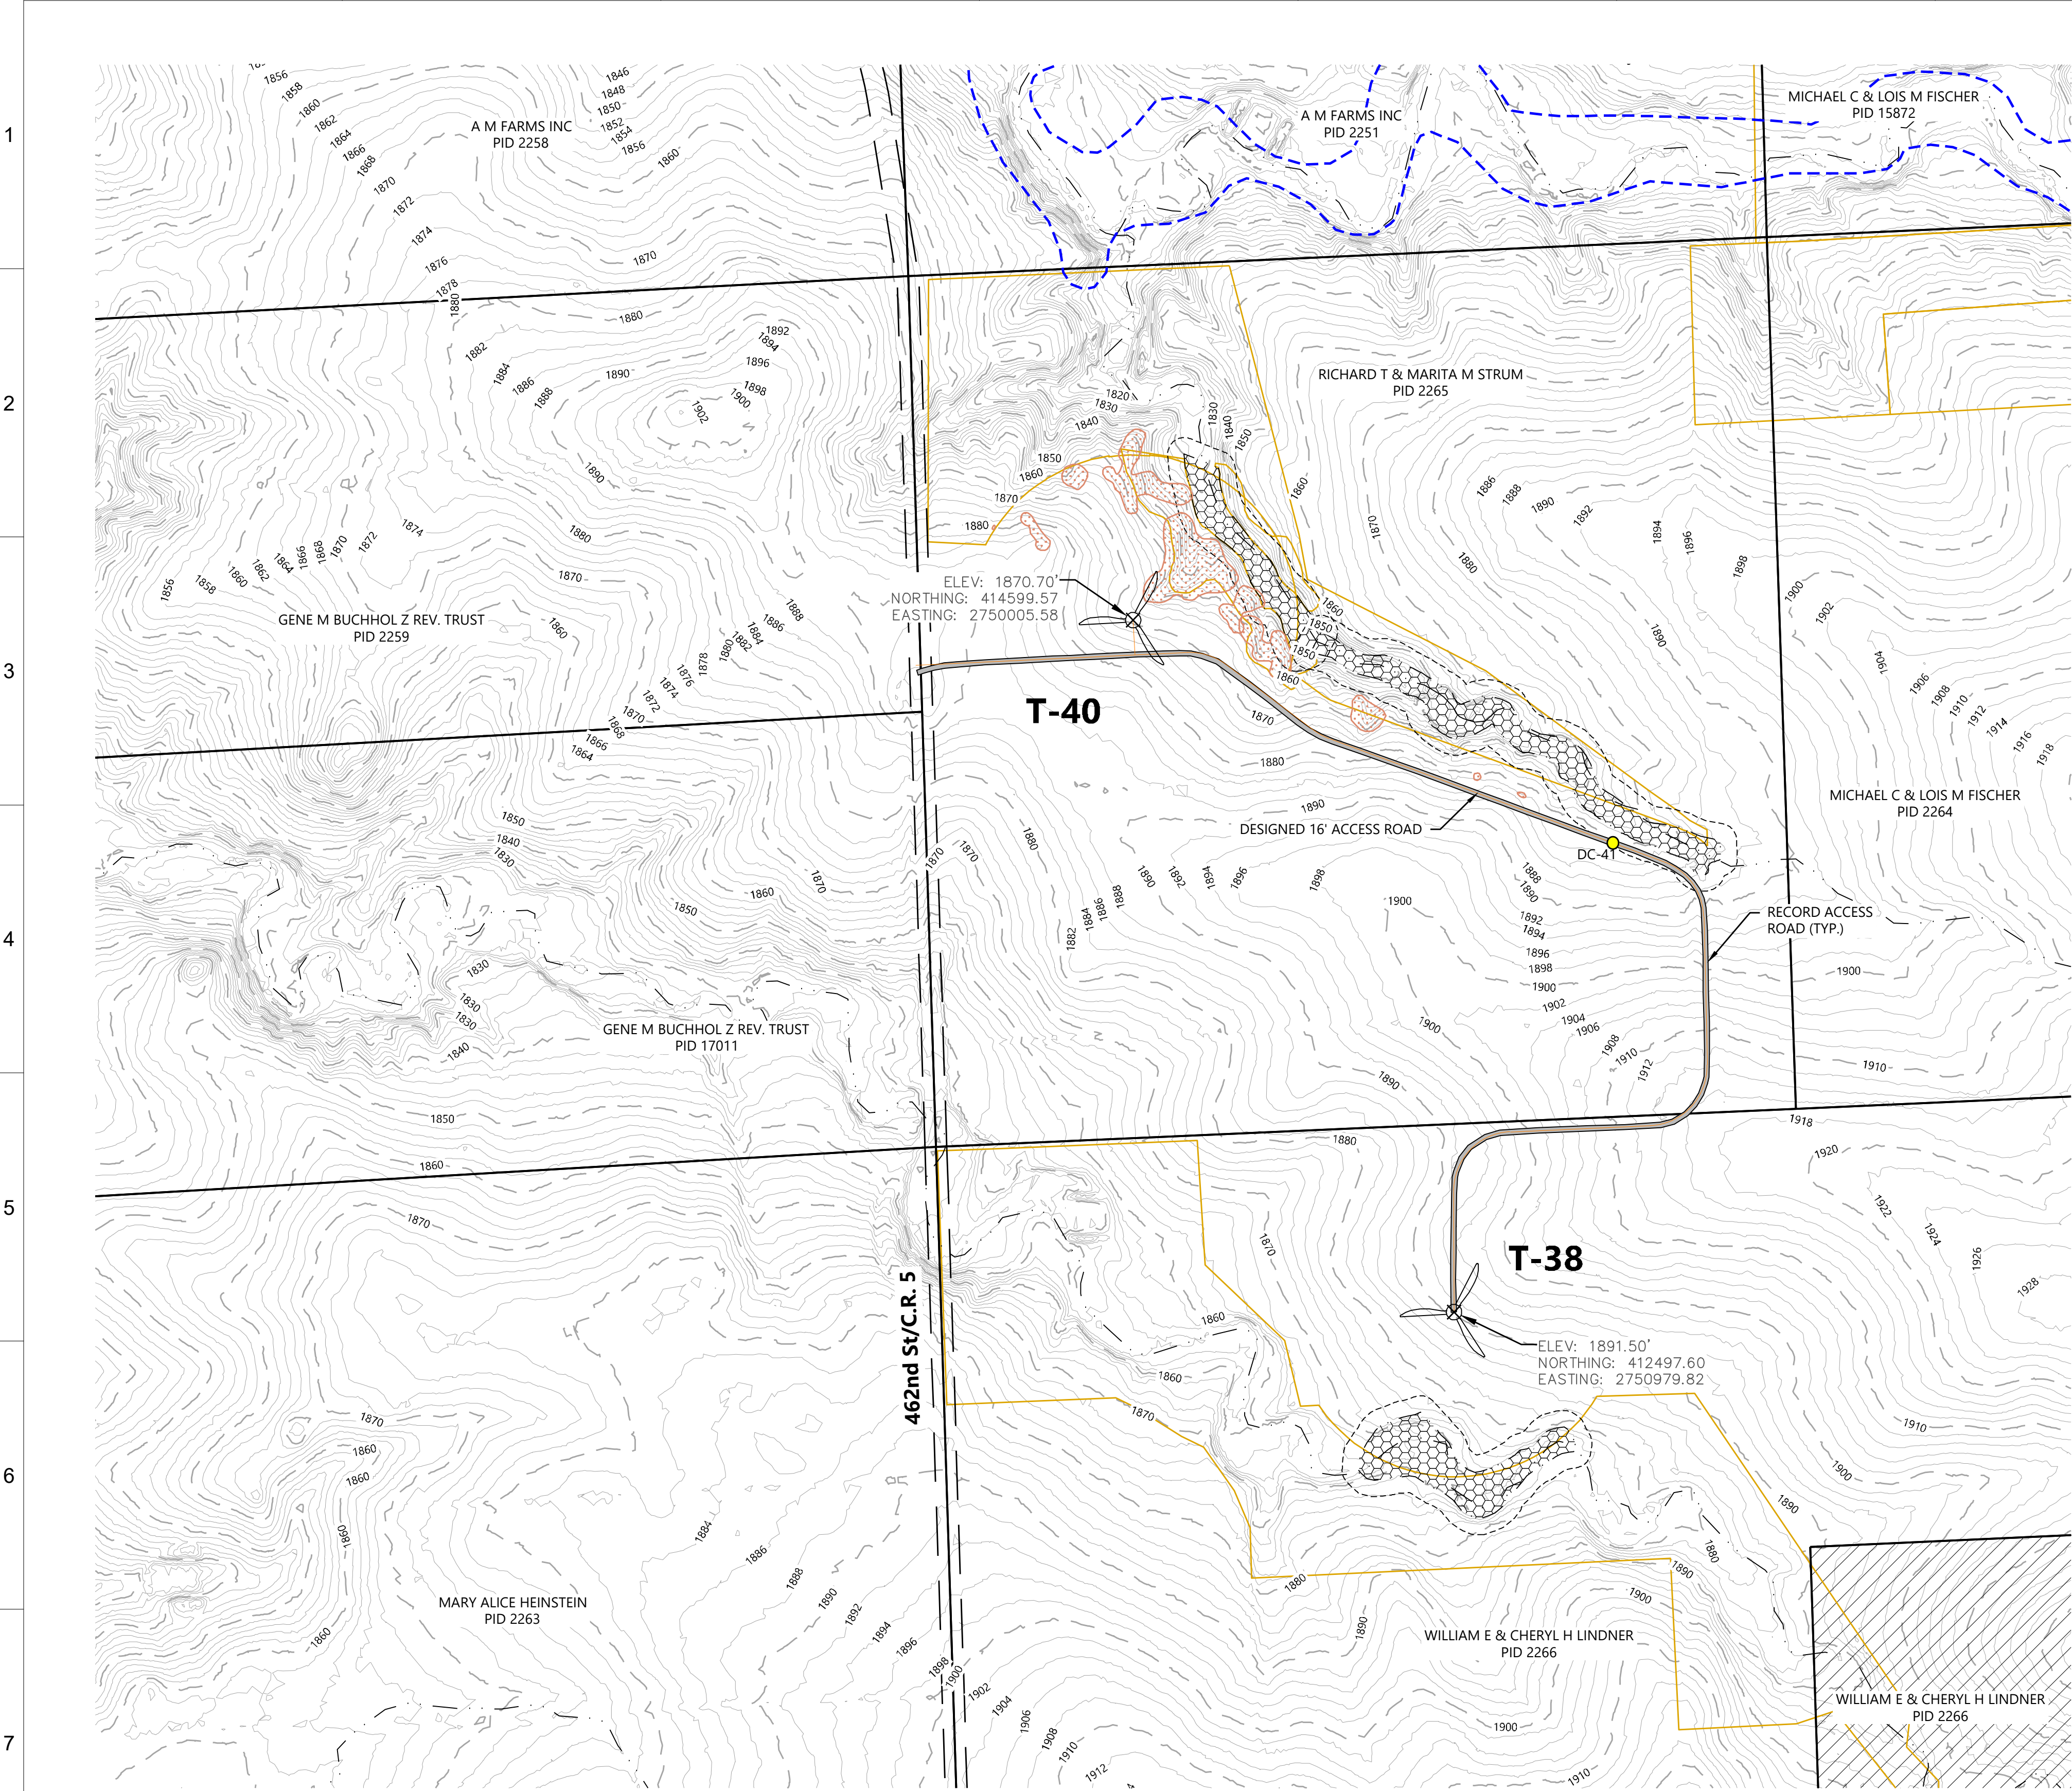

SEE SHEET NH-275900-8-28

LEGEND:

- T-#

MET-XX

ADLS

DESIGNED ACCESS ROAD

RECORD ACCESS ROAD

P-FUG

P-PON

NON-PARTICIPATING LAND

PROPERTY LINE

RIGHT-OF-WAY LINES

EASEMENT LINES
- RECORD TURBINE LOCATION

MET TOWER LOCATION

ADLS RADAR LOCATION

DESIGNED UNDERGROUND COLLECTION

DESIGNED OVERHEAD TRANSMISSION

NON-PARTICIPATING LAND

PROPERTY LINE

RIGHT-OF-WAY LINES

EASEMENT LINES
- POH

GAS

EX. OVERHEAD POWER

EX. GAS PIPELINE

EX. STREAM CHANNEL

EX. WETLAND

WATER SETBACK LINE

FEMA FLOOD ZONE

PROTECTED WILDLIFE BUFFER LINE  
(FINAL BORDERS WILL BE DEFINED  
BY FINAL SWCA PLAN)

ARCHEOLOGICAL AVOIDANCE AREA

EXISTING LAKE



RECORD LOW WATER CROSSING

RECORD CULVERT

EX. INDEX CONTOUR

EX. INTERVAL CONTOUR

KEY MAP:

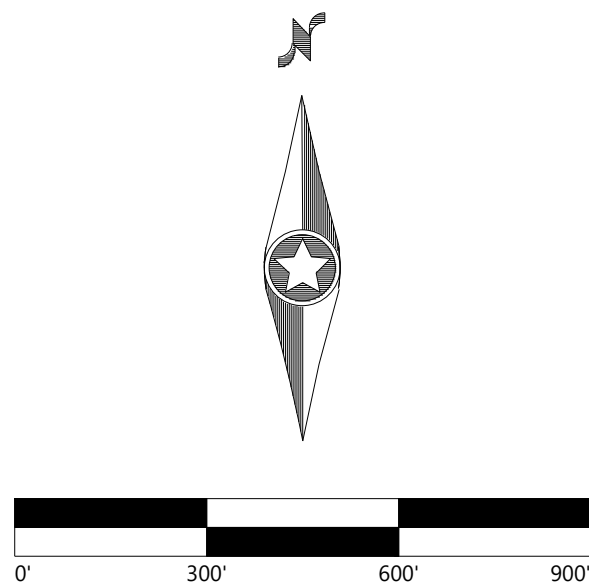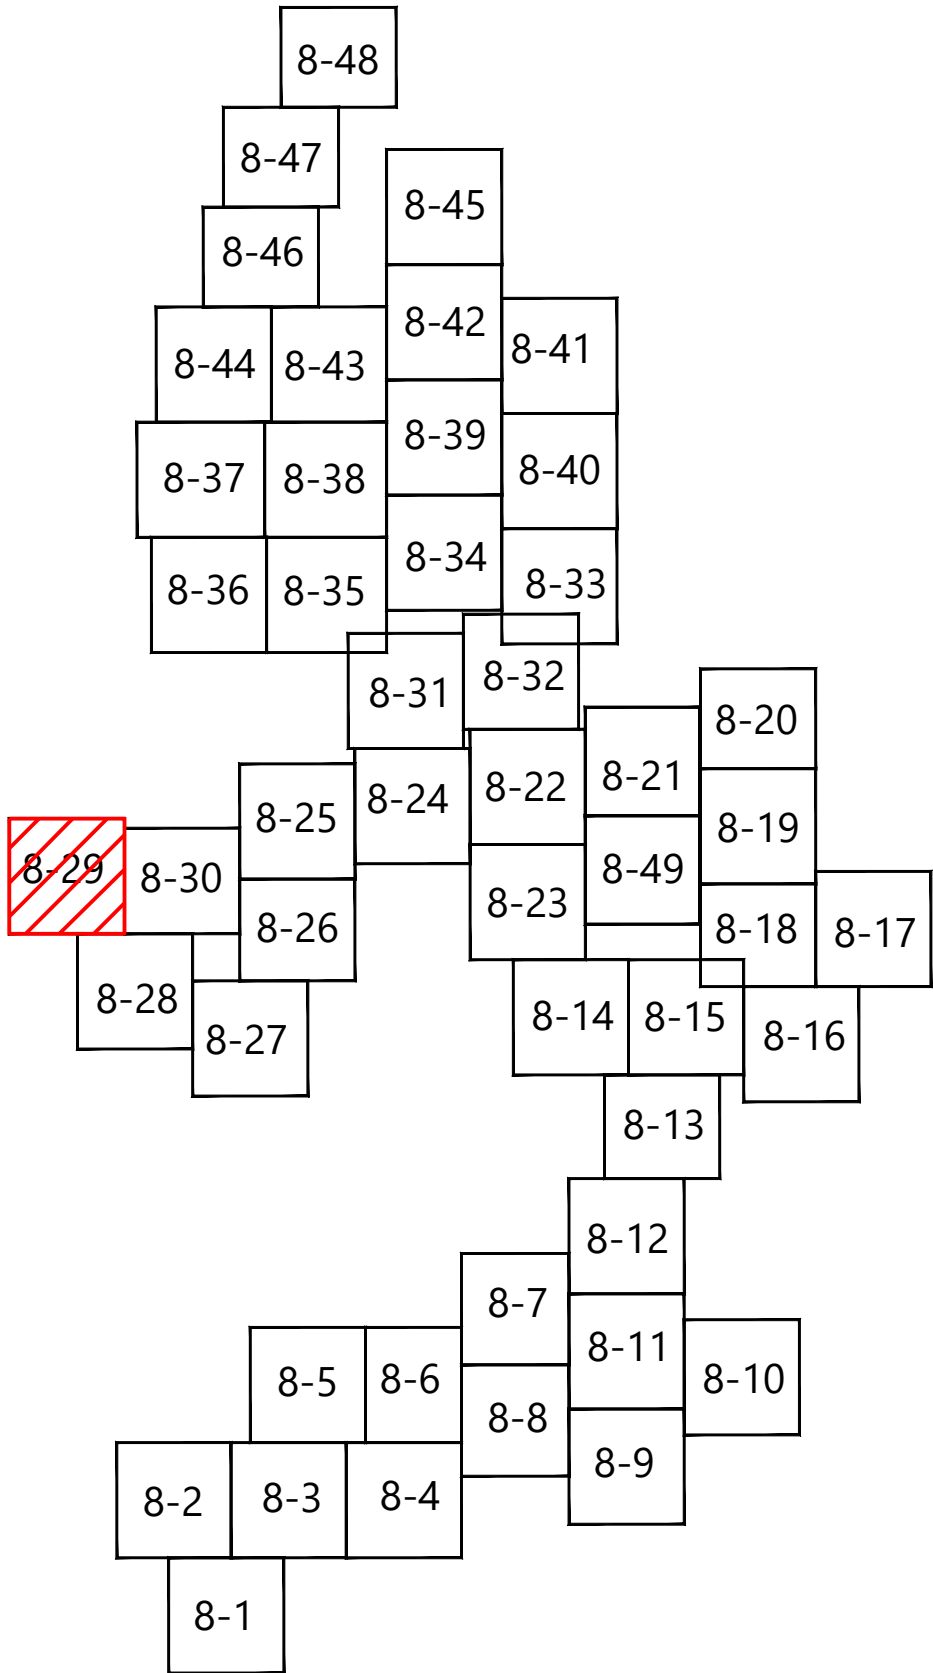

**Westwood**

Phone (214) 473-4640 2740 Dallas Parkway, Suite 280  
Toll Free (888) 937-5150 Plano, TX 75093  
westwoodps.com  
Westwood Professional Services, Inc.

PREPARED FOR:

**BLATTNER  
ENERGY**

392 COUNTY RD 50  
AVON, MN 56310

ISSUE FOR RECORD

NO	REVISION	ZONE	DATE	BY	CHK	ENG	NO	REVISION	ZONE	DATE	BY	CHK	ENG	REFERENCE DRAWINGS		
														DWG NO.	MANUFACTURER	DESCRIPTION
0	ISSUED FOR CONSTRUCTION		05/29/2020	MDR	AA	MDR										
1	ISSUED FOR RECOR - CROWNED RIDGE 22590		11/12/2020													

<div>NORTHERN STATES POWER COMPANY CROWNED RIDGE II WIND FARM CODINGTON, DEUEL, GRANT COUNTIES, SOUTH DAKOTA</div>				THIS MAP/DOCUMENT IS A TOOL TO ASSIST EMPLOYEES IN THE PERFORMANCE OF THEIR JOBS. YOUR PERSONAL SAFETY IS PROVIDED FOR BY USING SAFETY PRACTICES, PROCEDURES, AND EQUIPMENT AS DESCRIBED IN THE SAFETY TRAINING PROGRAMS AND MANUALS.
DWN: MDR	DATE: 11/12/2020	CHK: AA	DATE: 11/12/2020	
ENG: MDR	DATE: 11/12/2020	CHK:	DATE:	
PM: AA	DATE: 11/12/2020	PROJ. NO: 22590		
APVD:	DATE:	SCALE: 1" = 300'		

ENERGY SUPPLY  
ENGINEERING & CONSTRUCTION

UNIT 0  
CIVIL ACCESS ROADS

CIVIL SITE PLAN T-38, T-40

NH-275900-8-29

REV  
1












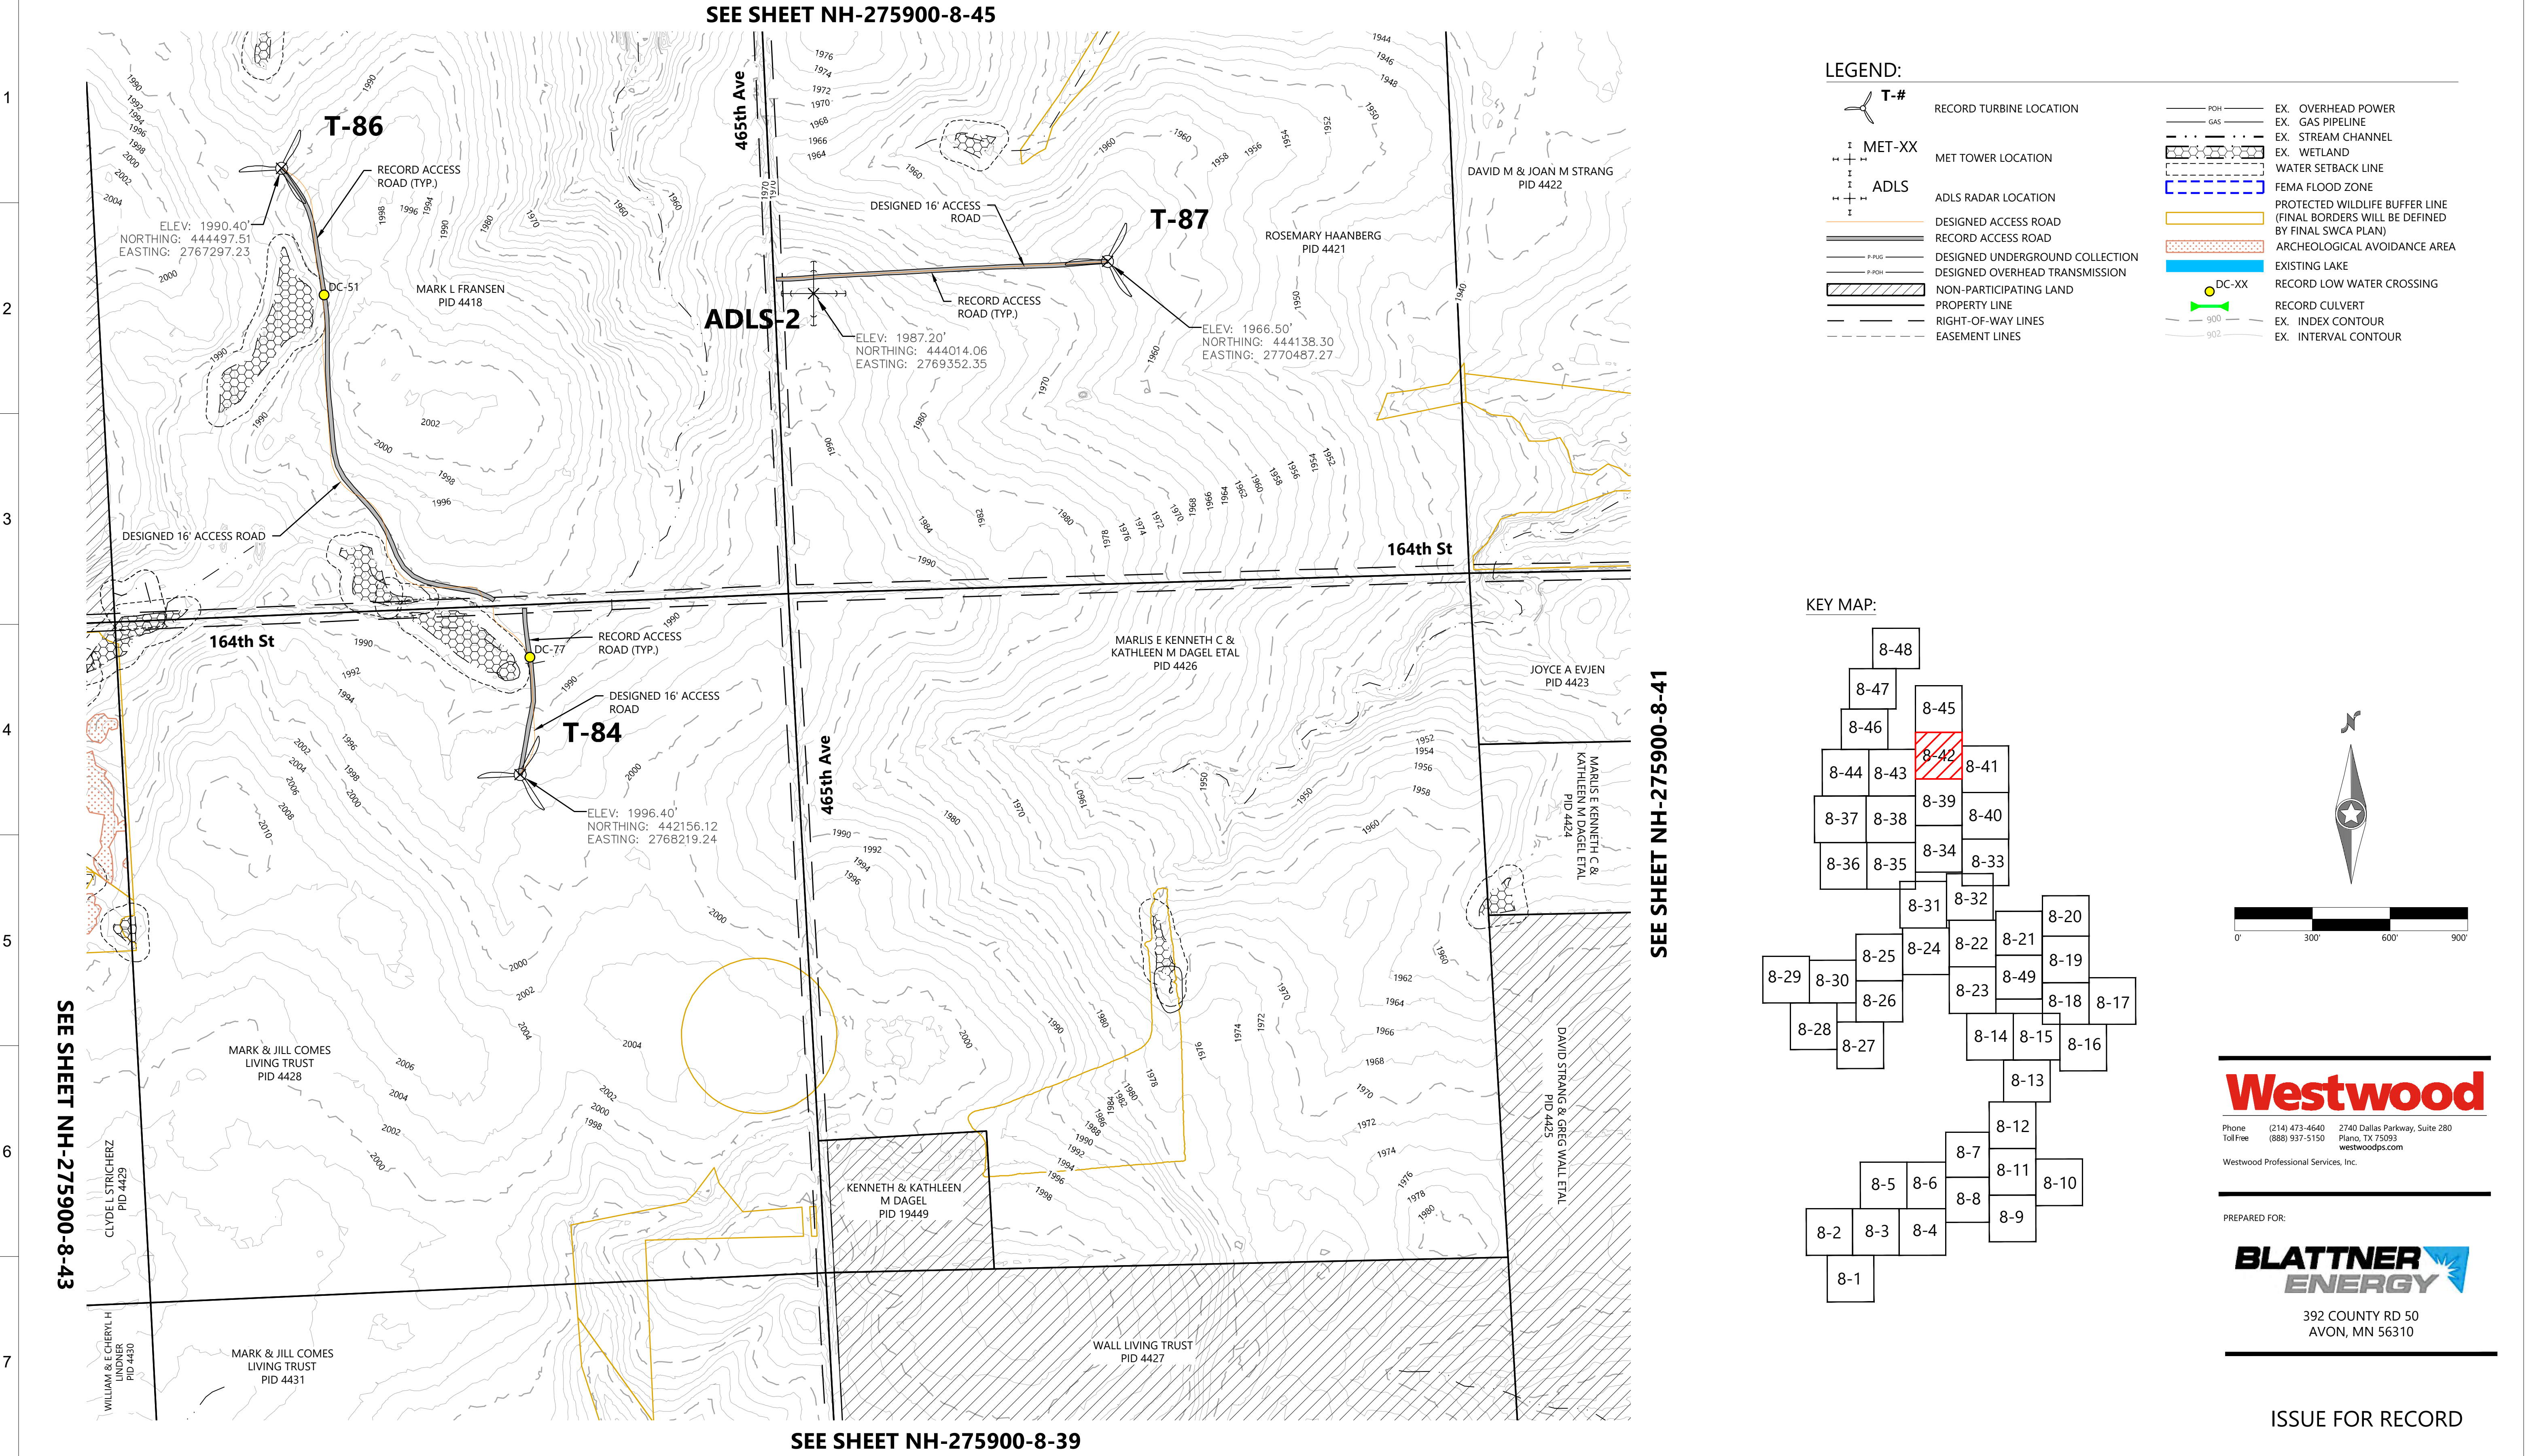





REV
1


DWN: MDR	DATE: 11/12/2020	CHK: AA	DATE: 11/12/2020
ENG: MDR	DATE: 11/12/2020	CHK:	DATE:
PM: AA	DATE: 11/12/2020	PROJ. NO: 22590	
APVD:	DATE:	SCALE: 1" = 300'	




EV  
I






REVISION		ZONE	DATE	BY	CHK	ENG	NO	REVISION	ZONE	DATE	BY	CHK	ENG	REFERENCE DRAWINGS			<div><p>NORTHERN STATES POWER COMPANY CROWNED RIDGE II WIND FARM CODINGTON, DEUEL, GRANT COUNTIES, SOUTH DAKOTA</p><table><tr><td>DWN: MDR</td><td>DATE: 11/12/2020</td><td>CHK: AA</td><td>DATE: 11/12/2020</td></tr><tr><td>ENG: MDR</td><td>DATE: 11/12/2020</td><td>CHK:</td><td>DATE:</td></tr><tr><td>PM: AA</td><td>DATE: 11/12/2020</td><td colspan="2">PROJ. NO: 22590</td></tr><tr><td>APVD:</td><td>DATE:</td><td colspan="2">SCALE: 1" = 300'</td></tr></table></div> <div>THIS MAP/DOCUMENT IS A TOOL TO ASSIST EMPLOYEES IN THE PERFORMANCE OF THEIR JOBS. YOUR PERSONAL SAFETY IS PROVIDED FOR BY USING SAFETY PRACTICES, PROCEDURES, AND EQUIPMENT AS DESCRIBED IN THE SAFETY TRAINING PROGRAMS AND MANUALS.</div>	DWN: MDR	DATE: 11/12/2020	CHK: AA	DATE: 11/12/2020	ENG: MDR	DATE: 11/12/2020	CHK:	DATE:	PM: AA	DATE: 11/12/2020	PROJ. NO: 22590		APVD:	DATE:	SCALE: 1" = 300'		UNIT 0 CIVIL ACCESS ROADS	
DWN: MDR	DATE: 11/12/2020	CHK: AA	DATE: 11/12/2020																																
ENG: MDR	DATE: 11/12/2020	CHK:	DATE:																																
PM: AA	DATE: 11/12/2020	PROJ. NO: 22590																																	
APVD:	DATE:	SCALE: 1" = 300'																																	
0	ISSUED FOR CONSTRUCTION		05/29/2020	MDR	AA	MDR								DWG NO.	MANUFACTURER	DESCRIPTION	CIVIL SITE PLAN T-88																		
1	ISSUED FOR RECORD - CROWNED RIDGE 22590		11/12/2020	MDR	AA	MDR												NH-275900-8-45	REV 1																





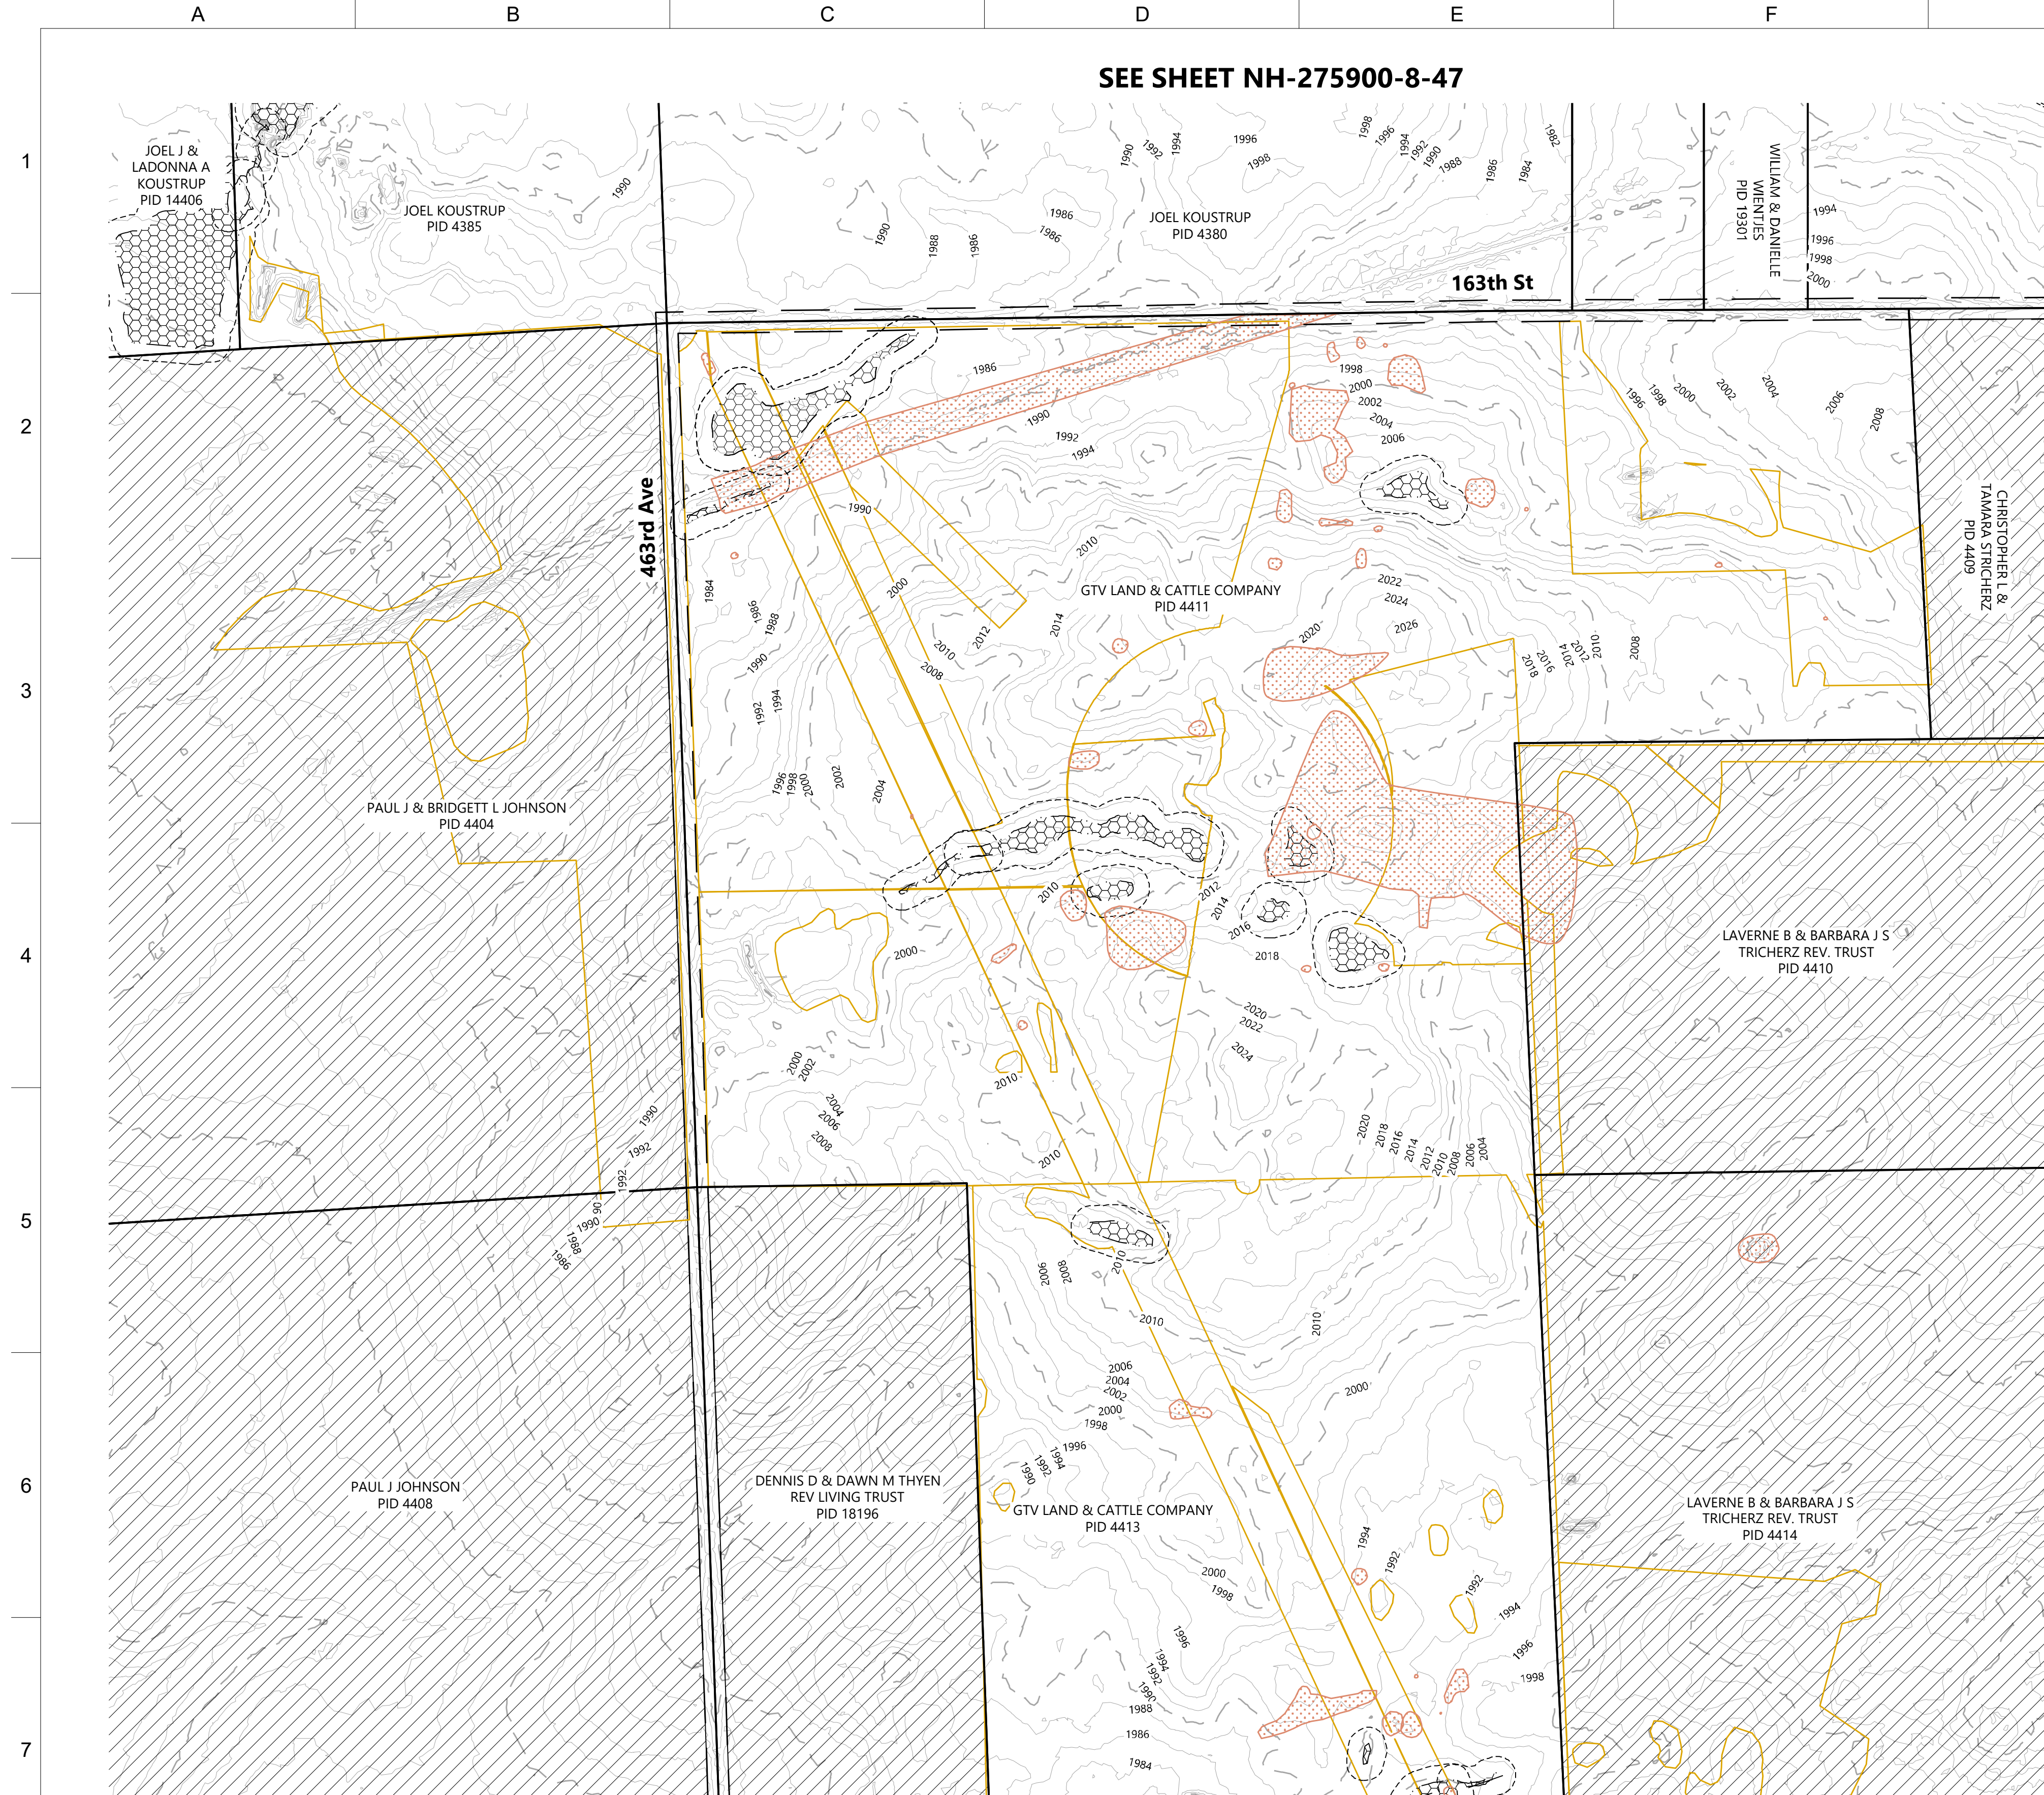

LEGEND:

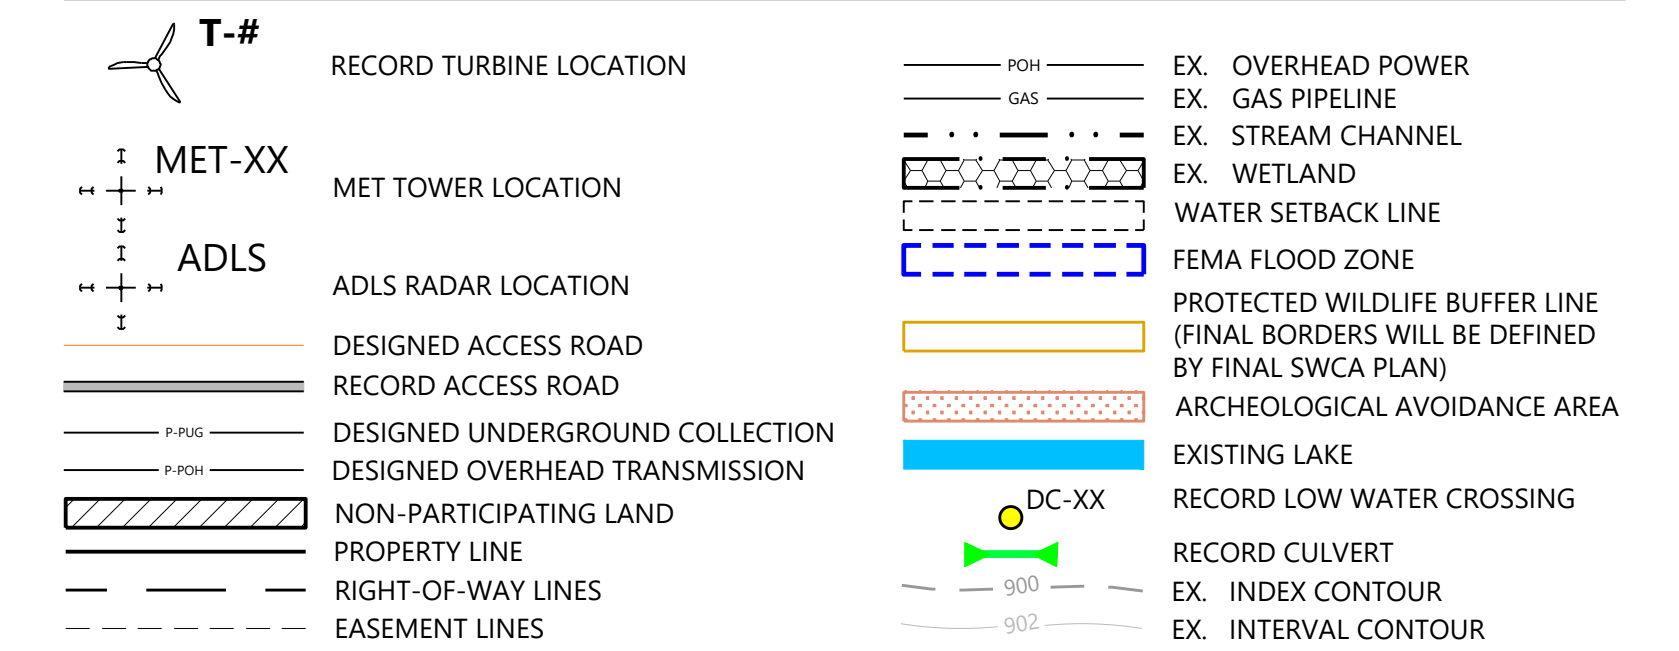

KEY MAP:

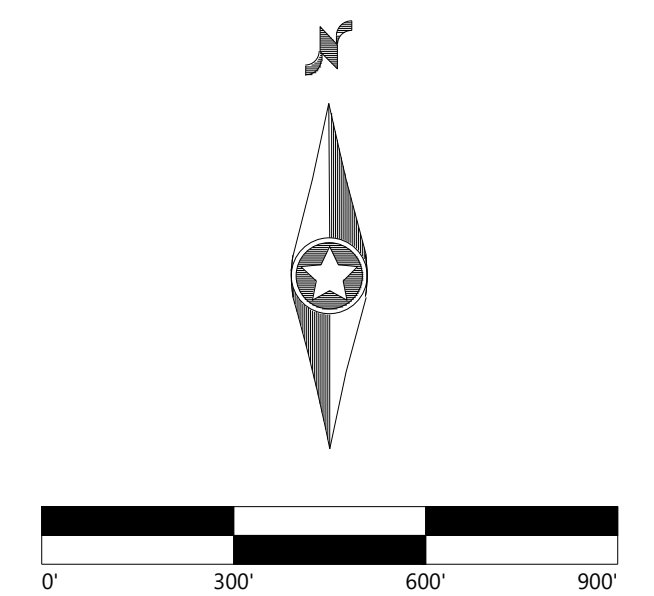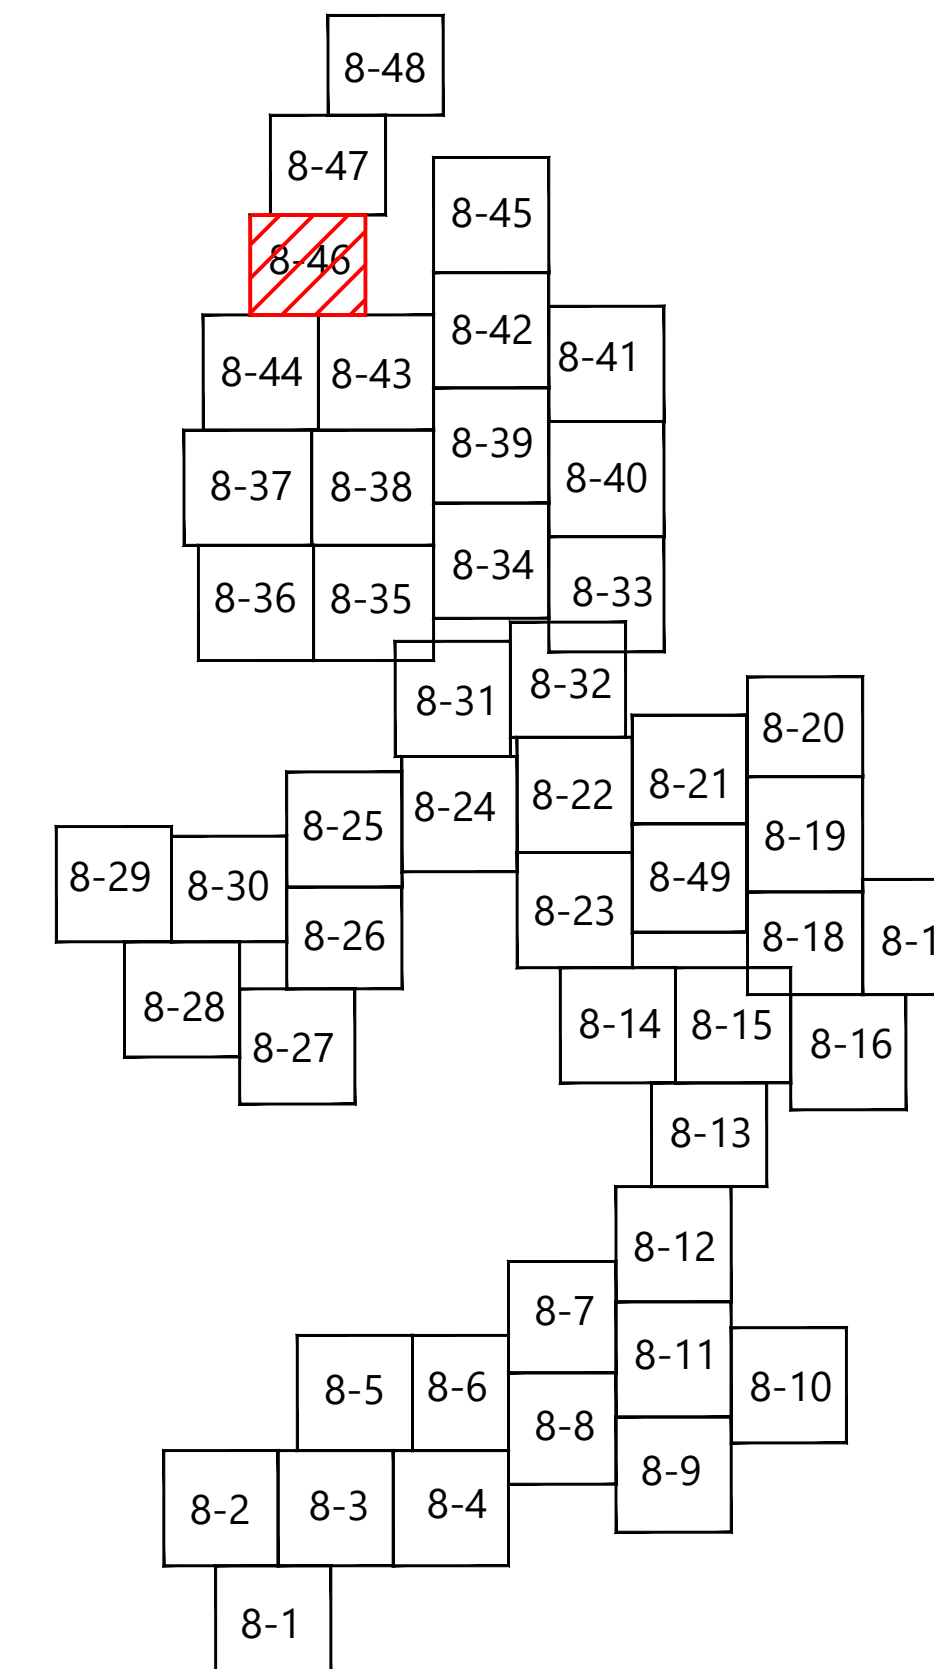

# Westwood

Phone (214) 473-4640 2740 Dallas Parkway, Suite 280  
Toll Free (888) 937-5150 Plano, TX 75093  
**westwoodps.com**  
Westwood Professional Services, Inc.


PREPARED FOR:





**BLATTNER**  
ENERGY

392 COUNTY RD 50  
AVON, MN 56310

ISSUE FOR RECORD

REVISION							ZONE	DATE	BY	CHK	ENG	NO	REVISION							ZONE	DATE	BY	CHK	ENG	REFERENCE DRAWINGS			<div><b>Xcel Energy®</b>  NORTHERN STATES POWER COMPANY <b>CROWNED RIDGE II WIND FARM</b> <small>CODINGTON, DEUEL, GRANT COUNTIES, SOUTH DAKOTA</small> <table><tr><td>DWN:</td><td>MDR</td><td>DATE:</td><td>11/12/2020</td><td>CHK:</td><td>AA</td><td>DATE:</td><td>11/12/2020</td></tr><tr><td>ENG:</td><td>MDR</td><td>DATE:</td><td>11/12/2020</td><td>CHK:</td><td></td><td>DATE:</td><td></td></tr><tr><td>PM:</td><td>AA</td><td>DATE:</td><td>11/12/2020</td><td>PROJ. NO:</td><td colspan="3">22590</td></tr><tr><td>APVD:</td><td></td><td>DATE:</td><td></td><td>SCALE:</td><td colspan="3">1" = 300'</td></tr></table></div>				DWN:	MDR	DATE:	11/12/2020	CHK:	AA	DATE:	11/12/2020	ENG:	MDR	DATE:	11/12/2020	CHK:		DATE:		PM:	AA	DATE:	11/12/2020	PROJ. NO:	22590			APVD:		DATE:		SCALE:	1" = 300'			THIS MAP/DOCUMENT IS A TOOL TO ASSIST EMPLOYEES IN THE PERFORMANCE OF THEIR JOBS. YOUR PERSONAL SAFETY IS PROVIDED FOR BY USING SAFETY PRACTICES, PROCEDURES, AND EQUIPMENT AS DESCRIBED IN THE SAFETY TRAINING PROGRAMS AND MANUALS.				UNIT 0 CIVIL ACCESS ROADS	
DWN:	MDR	DATE:	11/12/2020	CHK:	AA	DATE:	11/12/2020																																																														
ENG:	MDR	DATE:	11/12/2020	CHK:		DATE:																																																															
PM:	AA	DATE:	11/12/2020	PROJ. NO:	22590																																																																
APVD:		DATE:		SCALE:	1" = 300'																																																																
DWG NO.			MANUFACTURER		DESCRIPTION																																																																
CROWNED RIDGE II WIND FARM																																																																					
NO	REVISION						ZONE	DATE	BY	CHK	ENG	NO	REVISION						ZONE	DATE	BY	CHK	ENG				ENERGY SUPPLY ENGINEERING & CONSTRUCTION				NH-275900-8-46		REV 1																																				
0	ISSUED FOR CONSTRUCTION							05/29/2020	MDR	AA	MDR																																																										
1	ISSUED FOR RECORD - CROWNED RIDGE 22590							11/12/2020	MDR	AA	MDR																					CIVIL SITE PLAN 2																																					



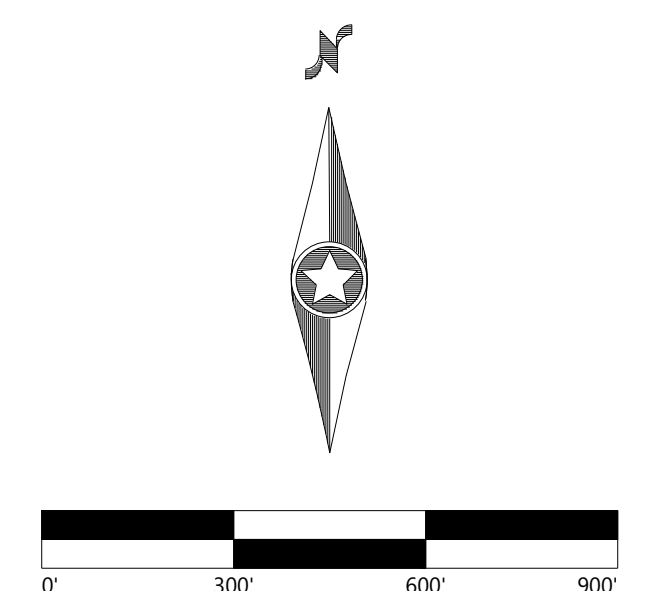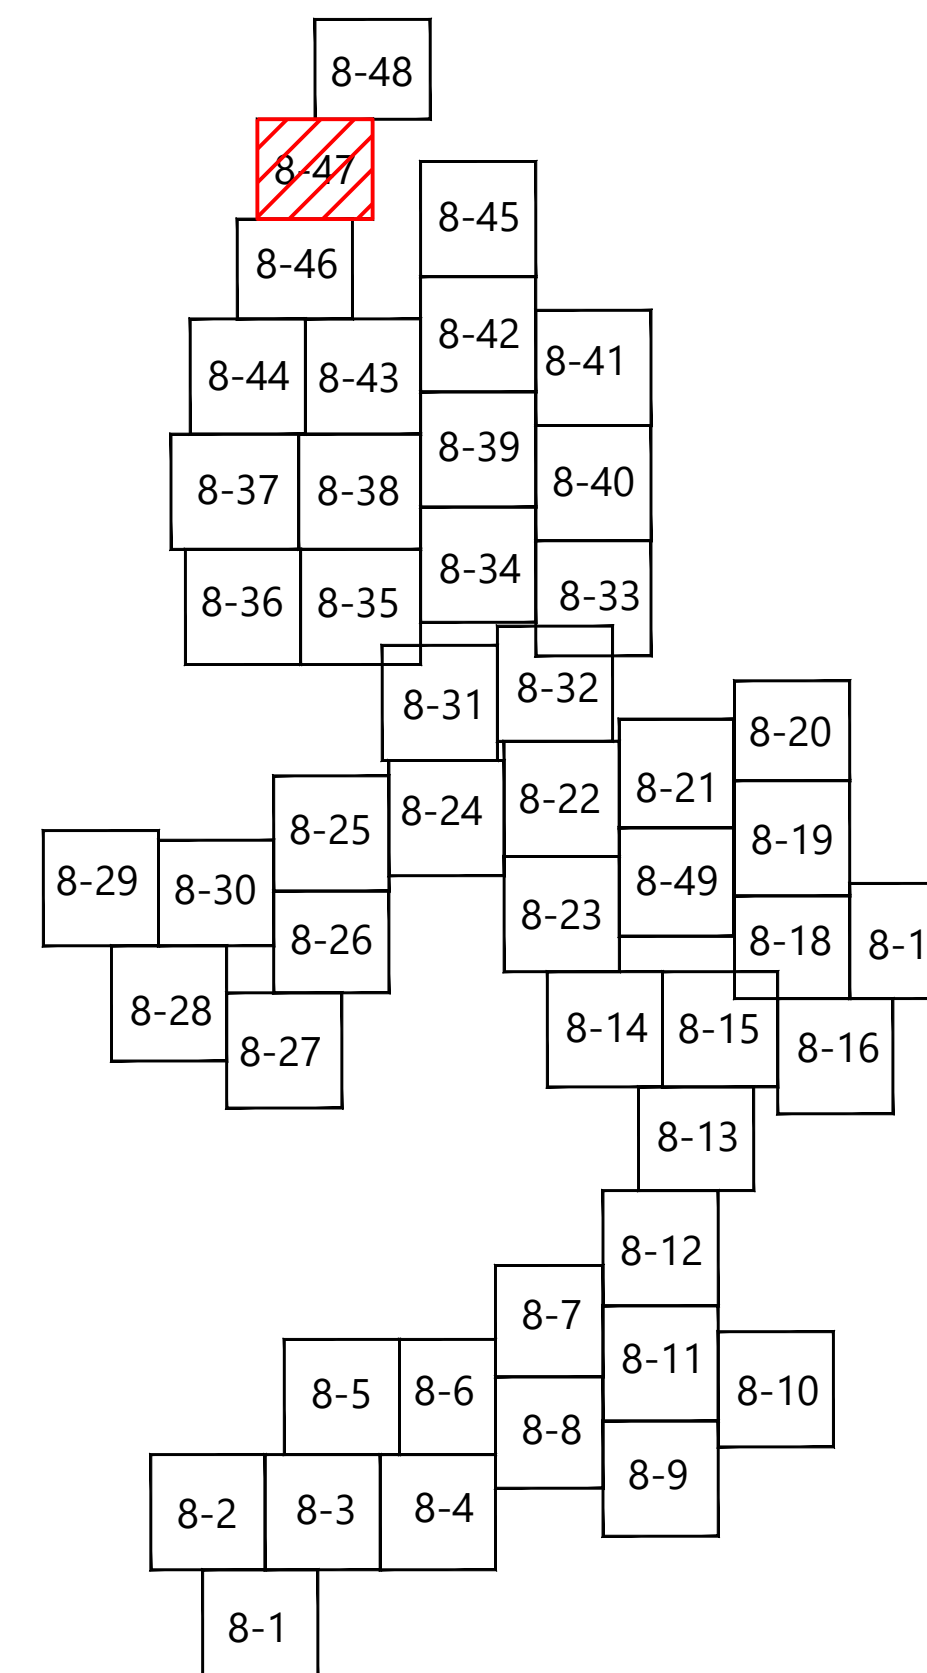

# Westwood

Phone (214) 473-4640 2740 Dallas Parkway, Suite 280  
Toll Free (888) 937-5150 Plano, TX 75093  
westwoodps.com


Westwood Professional Services, Inc.

PREPARED FOR:



392 COUNTY RD 50  
AVON, MN 56310


ISSUE FOR RECORD

NO	REVISION	ZONE	DATE	BY	CHK	ENG	NO	REVISION	ZONE	DATE	BY	CHK	ENG	REFERENCE DRAWINGS			<div><div>NORTHERN STATES POWER COMPANY CROWNED RIDGE II WIND FARM CODINGTON, DEUEL, GRANT COUNTIES, SOUTH DAKOTA</div></div>	<div>THIS MAP/DOCUMENT IS A TOOL TO ASSIST EMPLOYEES IN THE PERFORMANCE OF THEIR JOBS. YOUR PERSONAL SAFETY IS PROVIDED FOR BY USING SAFETY PRACTICES, PROCEDURES, AND EQUIPMENT AS DESCRIBED IN THE SAFETY TRAINING PROGRAMS AND MANUALS.</div>	<div>UNIT 0 CIVIL ACCESS ROADS  CIVIL SITE PLAN 3</div>	REV		
														DWG NO.	MANUFACTURER	DESCRIPTION						
0	ISSUED FOR CONSTRUCTION		05/29/2020	MDR	AA	MDR																
1	ISSUED FOR RECORD - CROWNED RIDGE 22590		11/12/2020	MDR	AA	MDR																
														DWN: MDR	DATE: 11/12/2020	CHK: AA	DATE: 11/12/2020			ENERGY SUPPLY ENGINEERING & CONSTRUCTION	NH-275900-8-47	1
														ENG: MDR	DATE: 11/12/2020	CHK:	DATE:					
														PM: AA	DATE: 11/12/2020	PROJ. NO: 22590						
														APVD:	DATE:	SCALE: 1" = 300'						






ISSUE FOR RECORD

<div><b>Xcel Energy®</b></div> <div>NORTHERN STATES POWER COMPANY</div> <div>CROWNED RIDGE II WIND FARM</div> <div>CODINGTON, DEUEL, GRANT COUNTIES, SOUTH DAKOTA</div>				<div>THIS MAP/DOCUMENT IS A TOOL TO ASSIST EMPLOYEES IN THE PERFORMANCE OF THEIR JOBS. YOUR PERSONAL SAFETY IS PROVIDED FOR BY USING SAFETY PRACTICES, PROCEDURES, AND EQUIPMENT AS DESCRIBED IN THE SAFETY TRAINING PROGRAMS AND MANUALS.</div>		<div>UNIT 0</div> <div>CIVIL ACCESS ROADS</div>		
DWN: MDR	DATE: 11/12/2020	CHK: AA	DATE: 11/12/2020	<div>ENERGY SUPPLY</div> <div>ENGINEERING &amp; CONSTRUCTION</div>		<div>CIVIL SITE PLAN SUBSTATION</div>		<div>REV</div> <div>1</div>
ENG: MDR	DATE: 11/12/2020	CHK:	DATE:					
PM: AA	DATE: 11/12/2020	PROJ. NO: 22590						
APVD:	DATE:	SCALE: 1" = 300'						
				<div>NH-275900-8-48</div>				



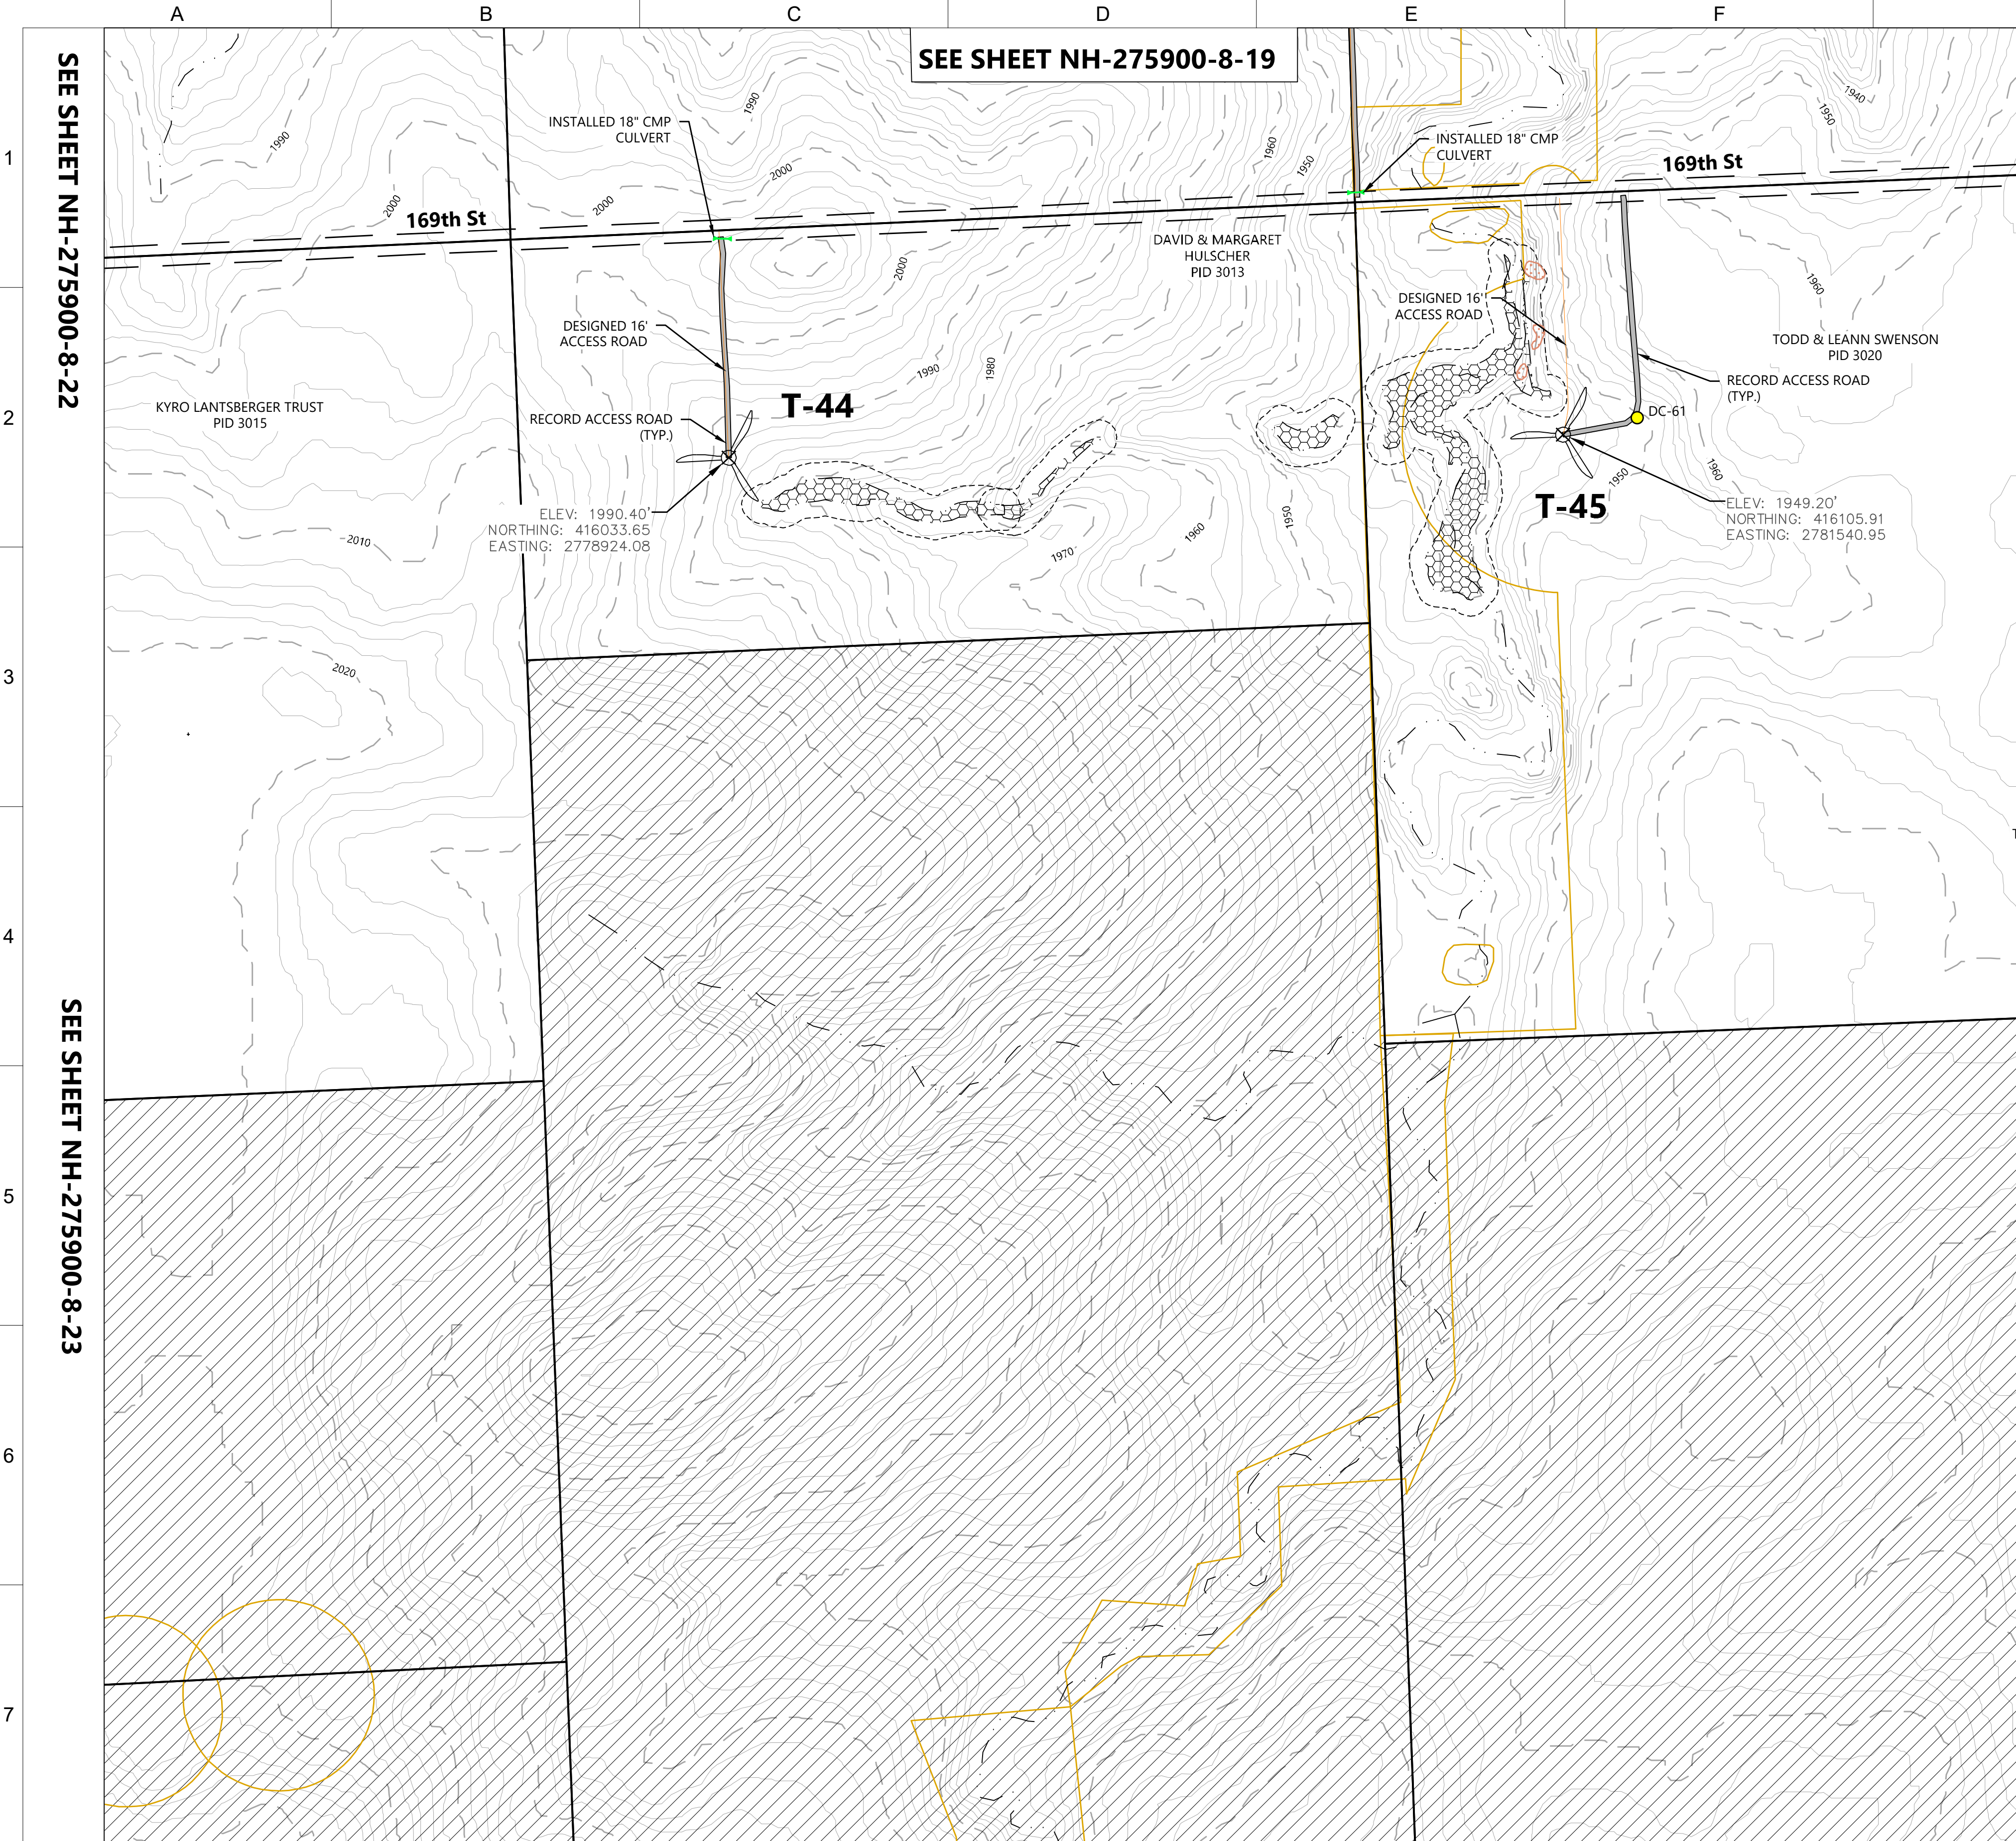

SEE SHEET NH-275900-8-22

SEE SHEET NH-275900-8-23

SEE SHEET NH-275900-8-19

SEE SHEET NH-275900-8-18

**LEGEND:**

**T-#**  
RECORD TURBINE LOCATION

**MET-XX**  
MET TOWER LOCATION

**ADLS**  
ADLS RADAR LOCATION



DESIGNED ACCESS ROAD  
RECORD ACCESS ROAD

DESIGNED UNDERGROUND COLLECTION  
DESIGNED OVERHEAD TRANSMISSION

NON-PARTICIPATING LAND  
PROPERTY LINE  
RIGHT-OF-WAY LINES  
EASEMENT LINES

EX. OVERHEAD POWER  
 EX. GAS PIPELINE  
 EX. STREAM CHANNEL  
 EX. WETLAND  
 WATER SETBACK LINE  
 FEMA FLOOD ZONE  
 PROTECTED WILDLIFE BUFFER LINE  
(FINAL BORDERS WILL BE DEFINED BY FINAL SWCA PLAN)  
 ARCHEOLOGICAL AVOIDANCE AREA  
 EXISTING LAKE  
 RECORD LOW WATER CROSSING  
 RECORD CULVERT  
 EX. INDEX CONTOUR  
 EX. INTERVAL CONTOUR

KEY MAP:

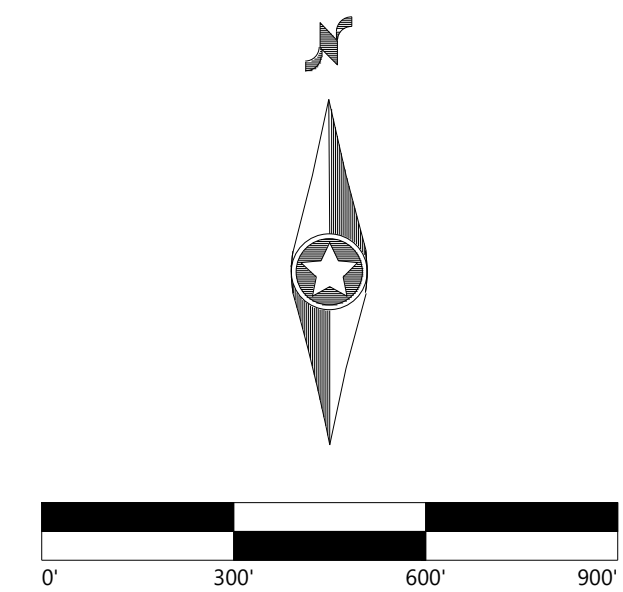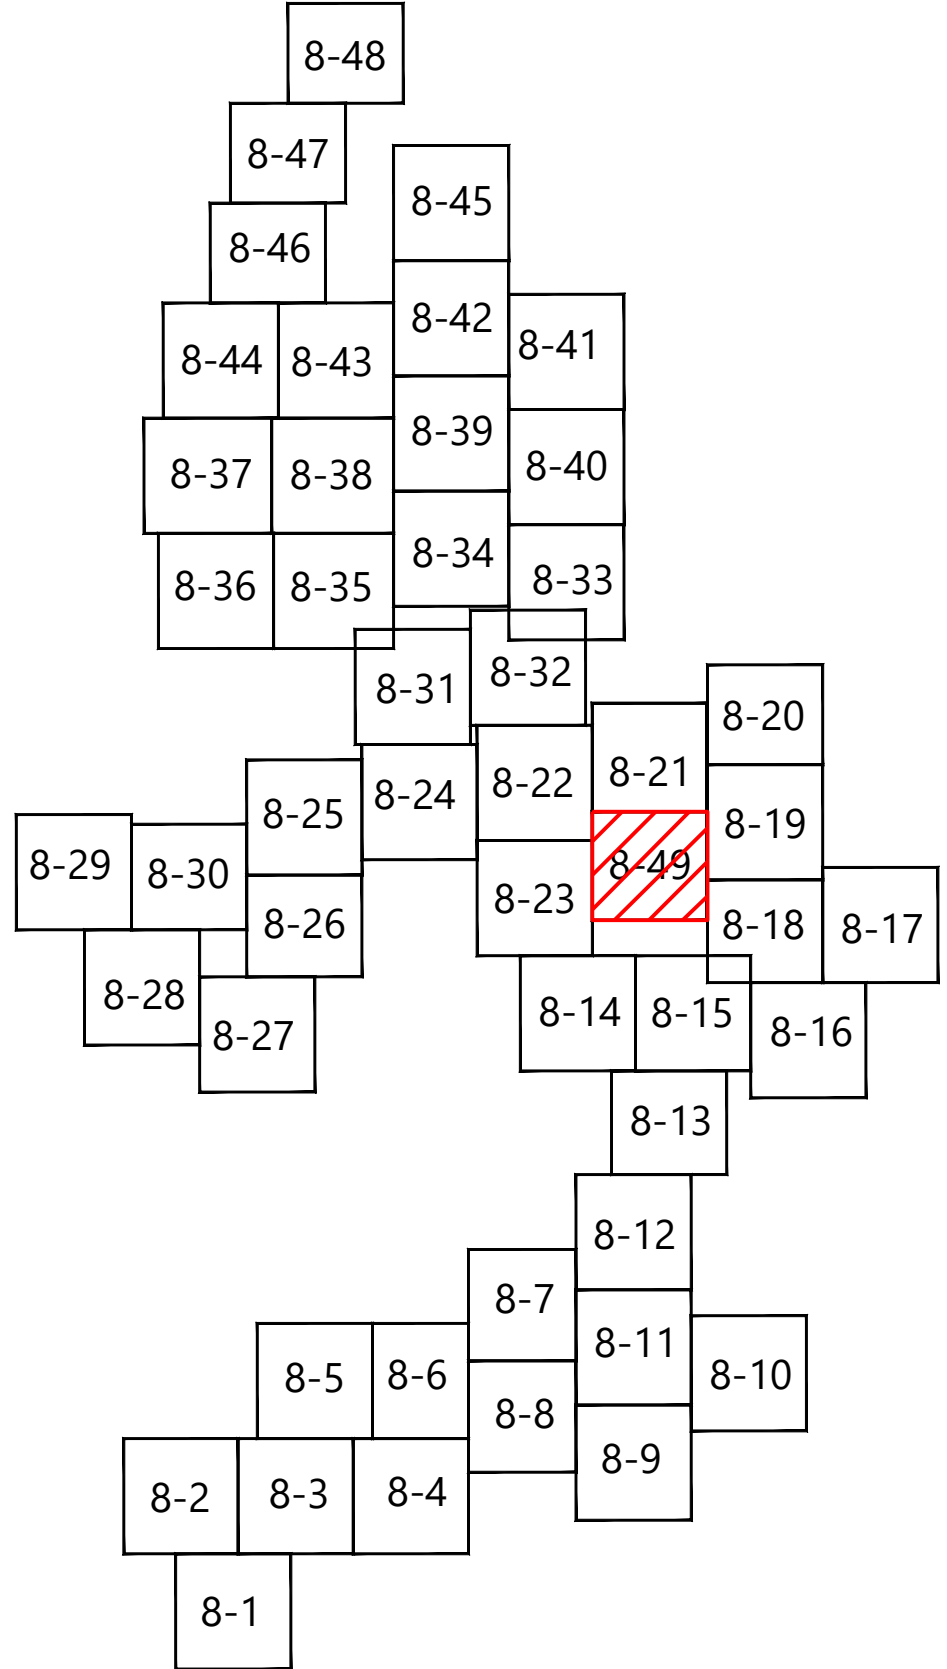

**Westwood**

Phone (214) 473-4640 2740 Dallas Parkway, Suite 280  
Toll Free (888) 937-5150 Plano, TX 75093  
westwoodps.com


Westwood Professional Services, Inc.

PREPARED FOR:


**BLATTNER ENERGY**

392 COUNTY RD 50  
AVON, MN 56310

ISSUE FOR RECORD

REVISION						ZONE	DATE	BY	CHK	ENG	NO	REVISION						ZONE	DATE	BY	CHK	ENG	REFERENCE DRAWINGS			<div><div></div><div>NORTHERN STATES POWER COMPANY CROWNED RIDGE II WIND FARM CODINGTON, DEUEL, GRANT COUNTIES, SOUTH DAKOTA</div></div>	<div>THIS MAP/DOCUMENT IS A TOOL TO ASSIST EMPLOYEES IN THE PERFORMANCE OF THEIR JOBS. YOUR PERSONAL SAFETY IS PROVIDED FOR BY USING SAFETY PRACTICES, PROCEDURES, AND EQUIPMENT AS DESCRIBED IN THE SAFETY TRAINING PROGRAMS AND MANUALS.</div>	UNIT 0 CIVIL ACCESS ROADS							
																			DWG NO.			MANUFACTURER	DESCRIPTION												
0	ISSUED FOR CONSTRUCTION							05/29/2020	MDR	AA	MDR																								
1	ISSUED FOR REC0RD - CROWNED RIDGE 22590							11/12/2020	MDR	AA	MDR																								




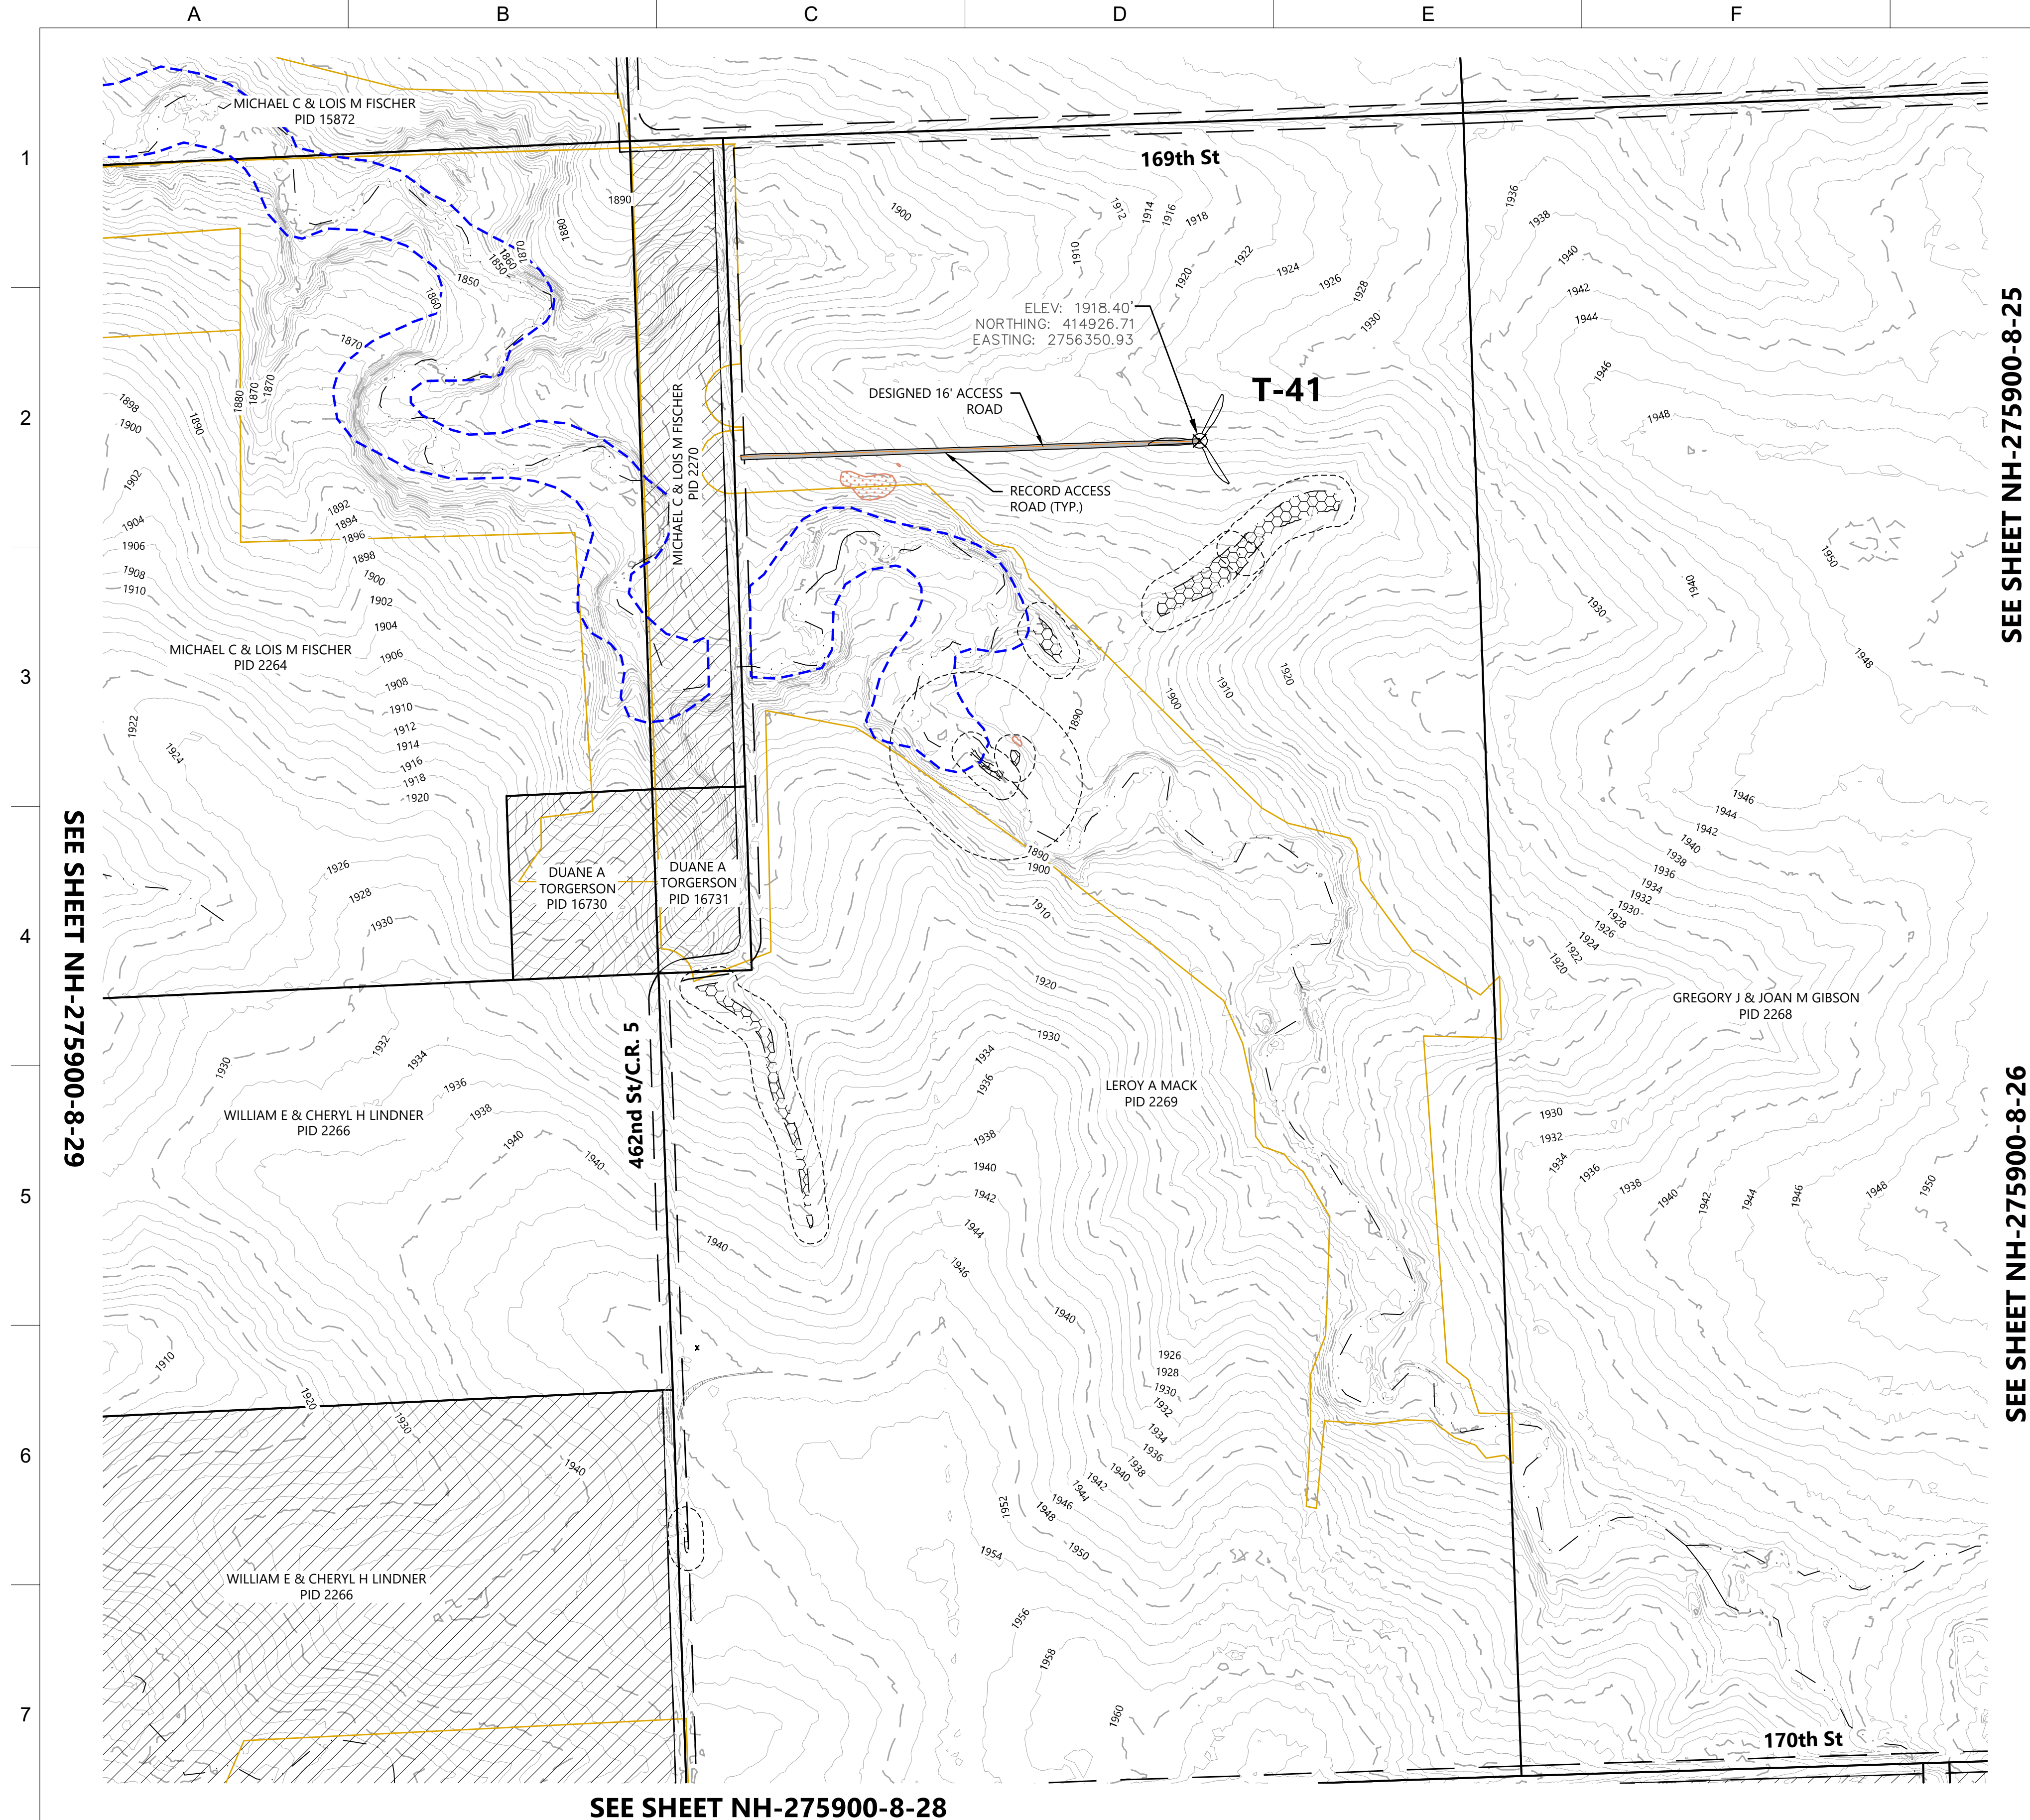



**SEE SHEET NH-275900-8-25**

**SEE SHEET NH-275900-8-26**

LEGEND:

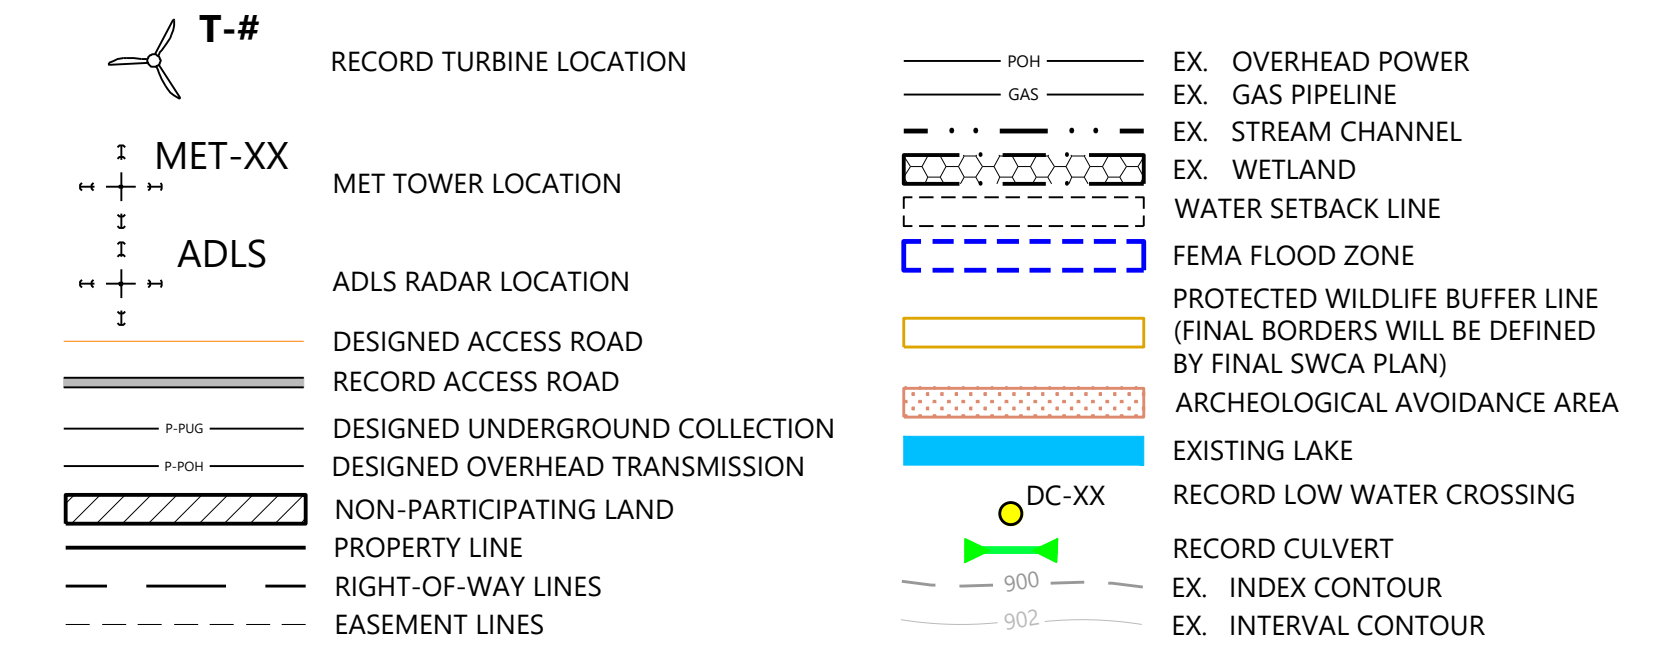

KEY MAP:

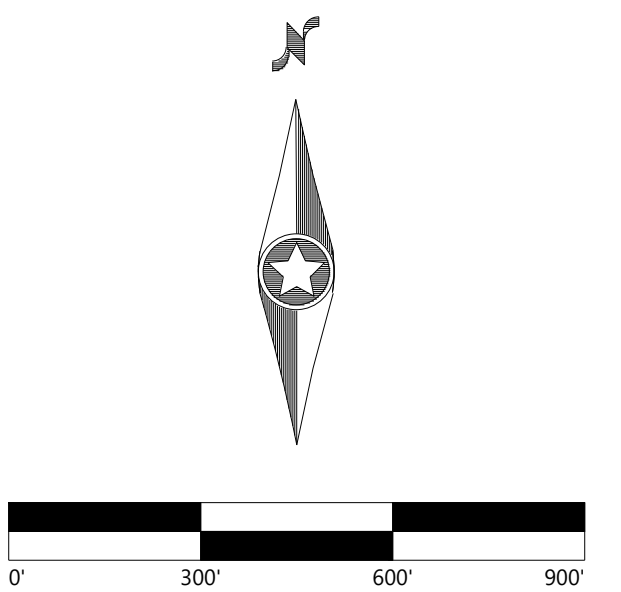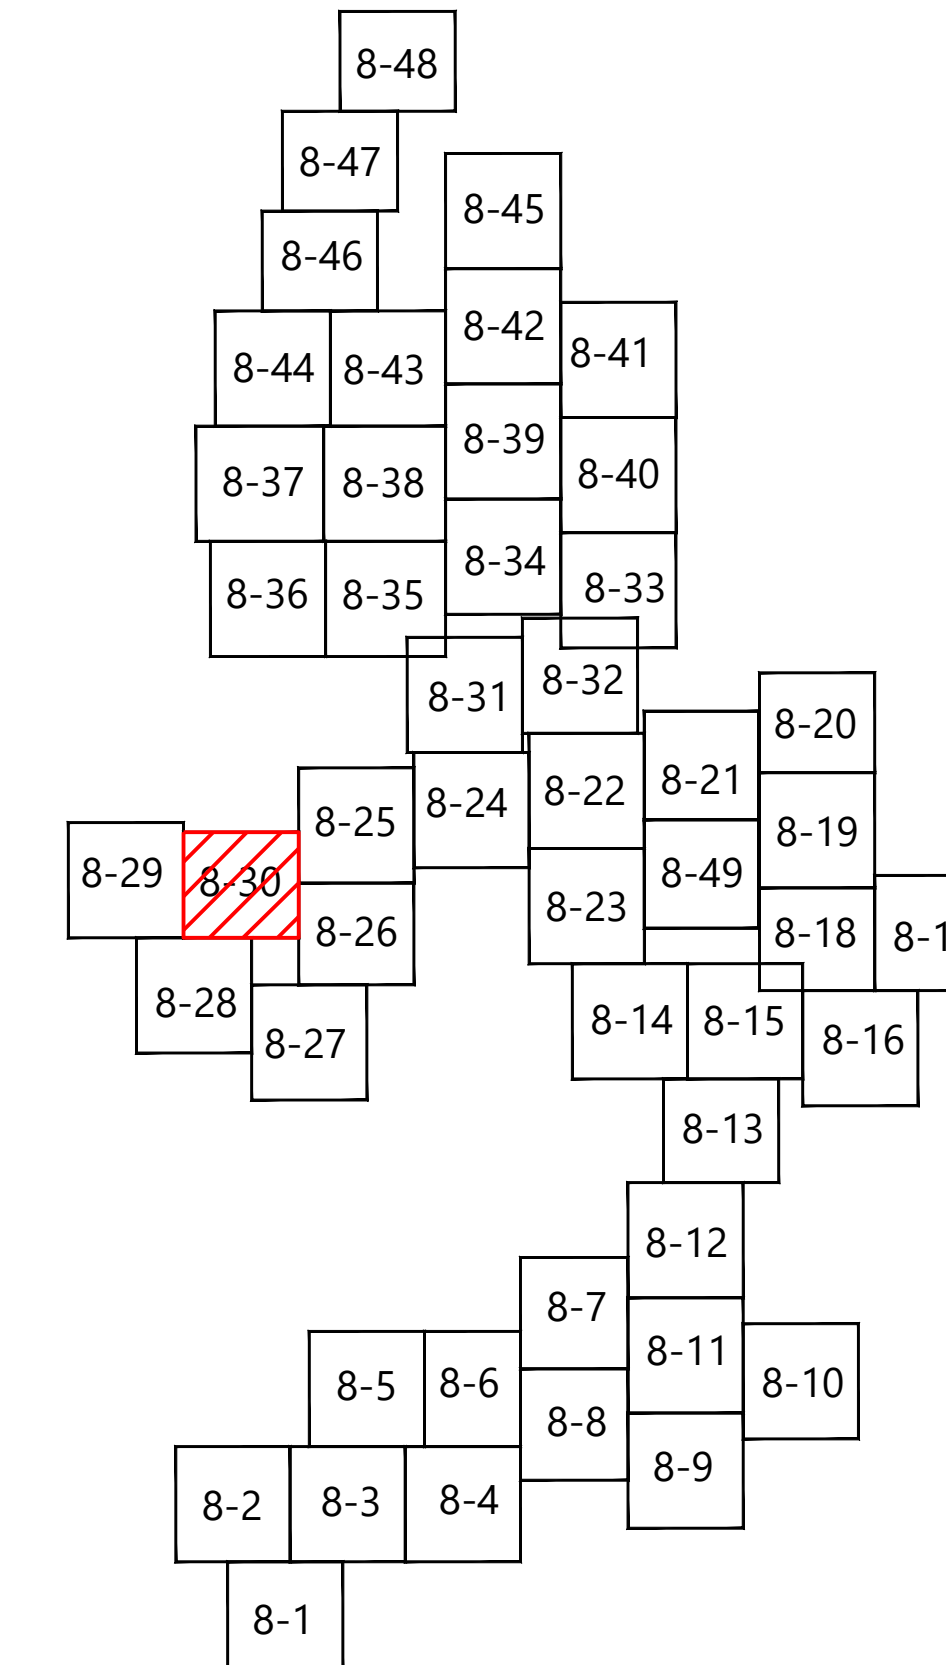

# Westwood

Phone (214) 473-4640 2740 Dallas Parkway, Suite 280  
Toll Free (888) 937-5150 Plano, TX 75093  
westwoodps.com

Westwood Professional Services, Inc.

PREPARED FOR:



392 COUNTY RD 50  
AVON, MN 56310

ISSUE FOR RECORD

[illegible]



Topographic map showing property boundaries and owner information for the T-58 area. The map includes the following labels:

- Property Owners and IDs:**
  - MYRON E KEMP, PID 20498
  - LEON P MACK & MARC R MACK, PID 2225
  - LEON P MACK & MARC R MACK, PID 2226
  - RODNEY P & JULIE A SPARTZ, PID 2227
  - BELINDA LORENZEN, PID 2227
  - GREG J & JOAN M GIBSON, PID 2236
  - CHARLES H RAML & MELBA B RAML, PID 2241
  - CHARLES H RAML, VINCENT R RAML ET AL, PID 2235
  - GREGORY J & JOAN GIBSON, PID 2233
  - GREGORY J & JOAN GIBSON, PID 2233
- Streets:**
  - 168th St
  - 465th Ave
- Infrastructure:**
  - DESIGNED 16' ACCESS ROAD
  - RECORD ACCESS ROAD (TYP.)
- Topographic Features:**
  - ELEV: 1985.40'
  - NORTHING: 421018.72
  - EASTING: 2769005.50

SEE SHEET NH-275900-8-32

**T-#**  
RECORD TURBINE LOCATION

**MET-XX**  
MET TOWER LOCATION

**ADLS**  
ADLS RADAR LOCATION

DESIGNED ACCESS ROAD

RECORD ACCESS ROAD

DESIGNED UNDERGROUND COLLECTION

DESIGNED OVERHEAD TRANSMISSION

NON-PARTICIPATING LAND


PROPERTY LINE

RIGHT-OF-WAY LINES

EASEMENT LINES

POH  
GAS  
EX. OVERHEAD POWER  
EX. GAS PIPELINE  
EX. STREAM CHANNEL  
EX. WETLAND  
WATER SETBACK LINE  
FEMA FLOOD ZONE  
PROTECTED WILDLIFE BUFFER LINE  
(FINAL BORDERS WILL BE DEFINED BY FINAL SWCA PLAN)  
ARCHAEOLOGICAL AVOIDANCE AREA  
EXISTING LAKE  
RECORD LOW WATER CROSSING  
DC-XX  
RECORD CULVERT  
EX. INDEX CONTOUR  
EX. INTERVAL CONTOUR

A triangular arrangement of 28 boxes, each containing a subtraction problem. The boxes are arranged in a roughly triangular shape, with the number of boxes per row increasing from the top. The problems are: Row 1: 8-48; Row 2: 8-47, 8-45; Row 3: 8-46, 8-42, 8-41; Row 4: 8-44, 8-43, 8-39, 8-40; Row 5: 8-37, 8-38, 8-34, 8-33; Row 6: 8-36, 8-35, 8-32, 8-20; Row 7: 8-29, 8-30, 8-25, 8-24, 8-22, 8-21, 8-19; Row 8: 8-28, 8-26, 8-23, 8-18, 8-17; Row 9: 8-27, 8-14, 8-15, 8-16; Row 10: 8-13; Row 11: 8-12; Row 12: 8-7, 8-11, 8-10; Row 13: 8-8, 8-9; Row 14: 8-5, 8-6; Row 15: 8-2, 8-3, 8-4; Row 16: 8-1. The box containing '8-31' is highlighted with a red diagonal hatching pattern.

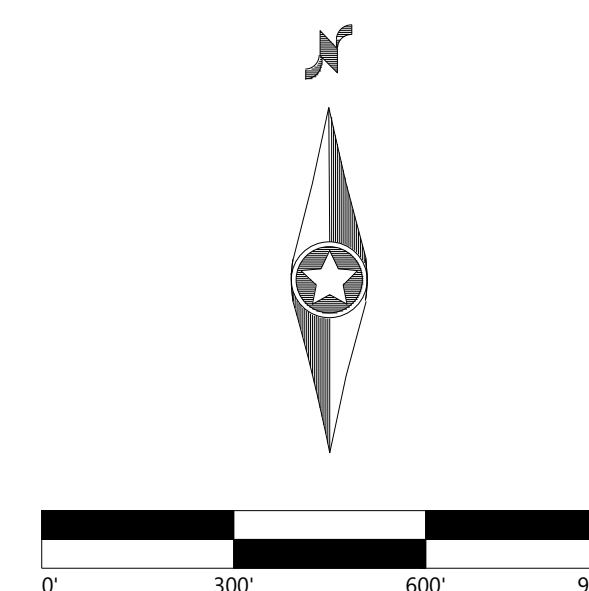

Phone (214) 473-4640 2740 Dallas Parkway, Suite 280  
Toll Free (888) 937-5150 Plano, TX 75093  
westwoodps.com

Westwood Professional Services, Inc.


PREPARED FOR:



**BLATTNER**  
**ENERGY**

392 COUNTY RD 5  
AVON, MN 56310

ISSUE FOR RECORD

NO		REVISION	ZONE	DATE	BY	CHK	ENG	NO	REVISION	ZONE	DATE	BY	CHK	ENG	REFERENCE DRAWINGS			<div><div><p>NORTHERN STATES POWER COMPANY CROWNED RIDGE II WIND FARM CODDINGTON, DEUEL, GRANT COUNTIES, SOUTH DAKOTA</p><table><tr><td>DWN: MDR</td><td>DATE: 11/12/2020</td><td>CHK: AA</td><td>DATE: 11/12/2020</td></tr><tr><td>ENG: MDR</td><td>DATE: 11/12/2020</td><td>CHK:</td><td>DATE:</td></tr><tr><td>PM: AA</td><td>DATE: 11/12/2020</td><td colspan="2">PROJ. NO: 22590</td></tr><tr><td>APVD:</td><td>DATE:</td><td colspan="2">SCALE: 1" = 300'</td></tr></table></div><div>THIS MAP/DOCUMENT IS A TOOL TO ASSIST EMPLOYEES IN THE PERFORMANCE OF THEIR JOBS. YOUR PERSONAL SAFETY IS PROVIDED FOR BY USING SAFETY PRACTICES, PROCEDURES, AND EQUIPMENT AS DESCRIBED IN THE SAFETY TRAINING PROGRAMS AND MANUALS.</div><div>ENERGY SUPPLY ENGINEERING &amp; CONSTRUCTION</div></div>				DWN: MDR	DATE: 11/12/2020	CHK: AA	DATE: 11/12/2020	ENG: MDR	DATE: 11/12/2020	CHK:	DATE:	PM: AA	DATE: 11/12/2020	PROJ. NO: 22590		APVD:	DATE:	SCALE: 1" = 300'	
DWN: MDR	DATE: 11/12/2020	CHK: AA	DATE: 11/12/2020																																		
ENG: MDR	DATE: 11/12/2020	CHK:	DATE:																																		
PM: AA	DATE: 11/12/2020	PROJ. NO: 22590																																			
APVD:	DATE:	SCALE: 1" = 300'																																			
															DWG NO.	MANUFACTURER	DESCRIPTION																				
0	ISSUED FOR CONSTRUCTION			05/29/2020	MDR	AA	MDR																														
1	ISSUED FOR RECORD - CROWNED RIDGE 22590			11/12/2020	MDR	AA	MDR																														
																		UNIT 0 CIVIL ACCESS ROADS																			
																		CIVIL SITE PLAN T-58																			
																		NH-275900-8-31		REV 1																	





**T-#**  
RECORD TURBINE LOCATION

**MET-XX**  
MET TOWER LOCATION

**ADLS**  
ADLS RADAR LOCATION

DESIGNED ACCESS ROAD

RECORD ACCESS ROAD

P-PUG  
DESIGNED UNDERGROUND COLLECTION

P-PQH  
DESIGNED OVERHEAD TRANSMISSION

NON-PARTICIPATING LAND

PROPERTY LINE

RIGHT-OF-WAY LINES

EASEMENT LINES

POH  
EX. OVERHEAD POWER

GAS  
EX. GAS PIPELINE

EX. STREAM CHANNEL

EX. WETLAND

WATER SETBACK LINE

FEMA FLOOD ZONE

PROTECTED WILDLIFE BUFFER LINE  
(FINAL BORDERS WILL BE DEFINED BY FINAL SWCA PLAN)

ARCHAEOLOGICAL AVOIDANCE AREA

EXISTING LAKE

RECORD LOW WATER CROSSING

DC-XX  
RECORD CULVERT

900  
EX. INDEX CONTOUR


902  
EX. INTERVAL CONTOUR

ISSUE FOR RECORD



RE  
1






NO		REVISION	ZONE	DATE	BY	CHK	ENG	NO	REVISION	ZONE	DATE	BY	CHK	ENG	REFERENCE DRAWINGS			<div><div><div>NORTHERN STATES POWER COMPANY CROWNED RIDGE II WIND FARM CODINGTON, DEUEL, GRANT COUNTIES, SOUTH DAKOTA</div></div><div><table><tr><td>DWN:</td><td>MDR</td><td>DATE:</td><td>11/12/2020</td><td>CHK:</td><td>AA</td><td>DATE:</td><td>11/12/2020</td></tr><tr><td>ENG:</td><td>MDR</td><td>DATE:</td><td>11/12/2020</td><td>CHK:</td><td></td><td>DATE:</td><td></td></tr><tr><td>PM:</td><td>AA</td><td>DATE:</td><td>11/12/2020</td><td>PROJ. NO:</td><td colspan="3">22590</td></tr><tr><td>APVD:</td><td></td><td>DATE:</td><td></td><td>SCALE:</td><td colspan="3">1" = 300'</td></tr></table></div><div>THIS MAP/DOCUMENT IS A TOOL TO ASSIST EMPLOYEES IN THE PERFORMANCE OF THEIR JOBS. YOUR PERSONAL SAFETY IS PROVIDED FOR BY USING SAFETY PRACTICES, PROCEDURES, AND EQUIPMENT AS DESCRIBED IN THE SAFETY TRAINING PROGRAMS AND MANUALS.</div></div>				DWN:	MDR	DATE:	11/12/2020	CHK:	AA	DATE:	11/12/2020	ENG:	MDR	DATE:	11/12/2020	CHK:		DATE:		PM:	AA	DATE:	11/12/2020	PROJ. NO:	22590			APVD:		DATE:		SCALE:	1" = 300'			UNIT 0 CIVIL ACCESS ROADS	
DWN:	MDR	DATE:	11/12/2020	CHK:	AA	DATE:	11/12/2020																																																
ENG:	MDR	DATE:	11/12/2020	CHK:		DATE:																																																	
PM:	AA	DATE:	11/12/2020	PROJ. NO:	22590																																																		
APVD:		DATE:		SCALE:	1" = 300'																																																		
															DWG NO.	MANUFACTURER	DESCRIPTION	CIVIL SITE PLAN T-68																																					
																		NH-275900-8-33																																					
																		ENERGY SUPPLY ENGINEERING & CONSTRUCTION	REV 1																																				



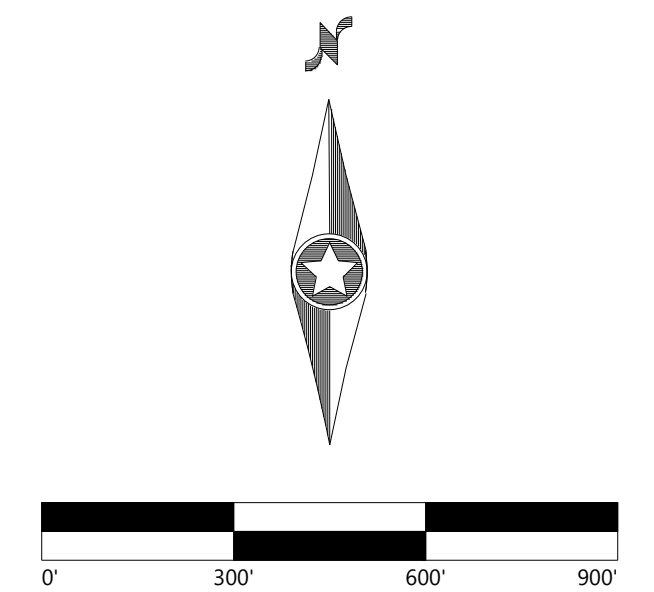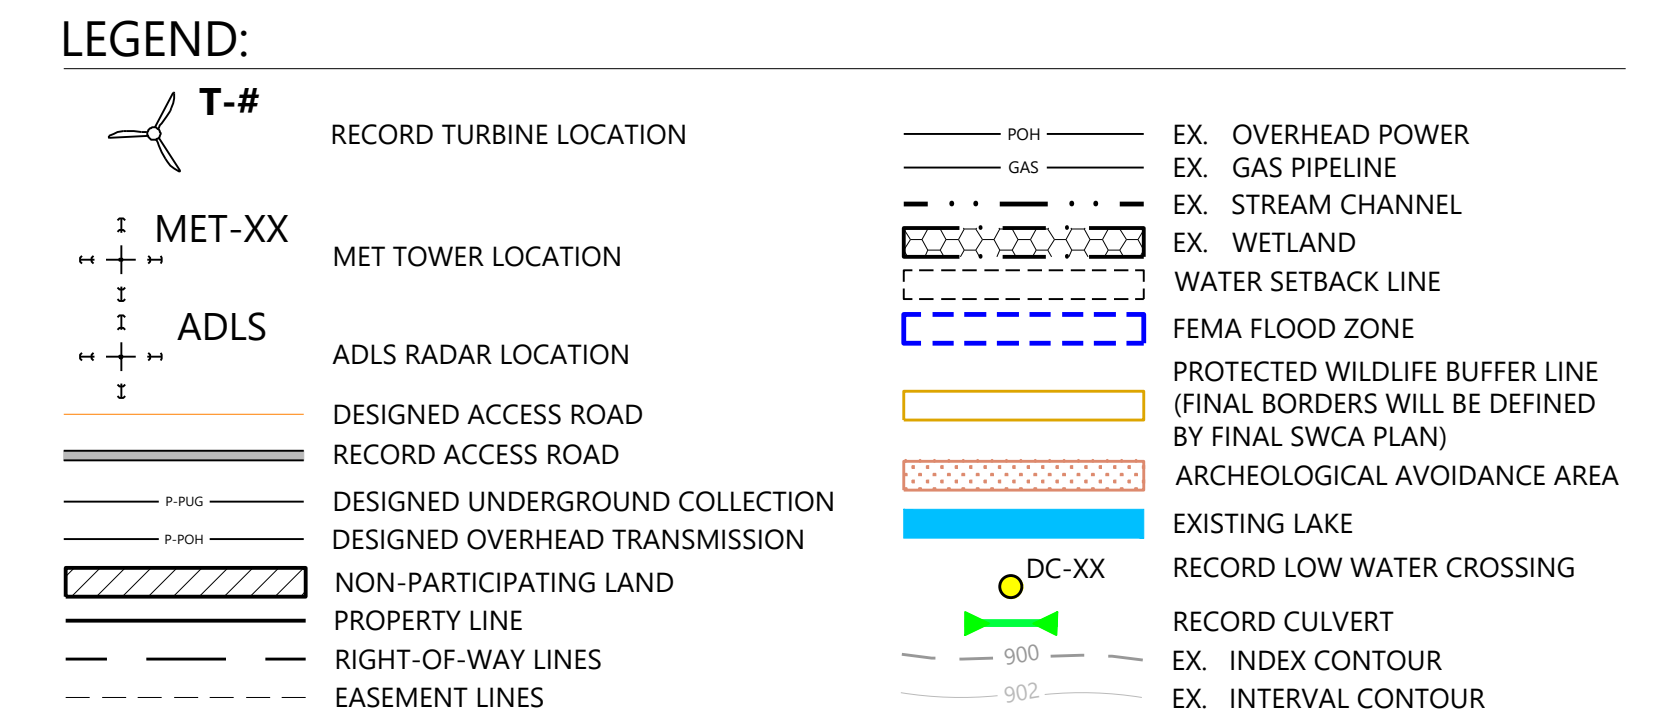

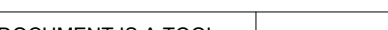NO		REVISION	ZONE	DATE	BY	CHK	ENG	NO	REVISION	ZONE	DATE	BY	CHK	ENG	REFERENCE DRAWINGS			<div><div><div>NORTHERN STATES POWER COMPANY CROWNED RIDGE II WIND FARM CODINGTON, DEUEL, GRANT COUNTIES, SOUTH DAKOTA</div></div><div><div><div>DWN: MDR</div><div>ENG: MDR</div><div>PM: AA</div><div>APVD:</div></div><div><div>DATE: 11/12/2020</div><div>DATE: 11/12/2020</div><div>DATE: 11/12/2020</div><div>DATE:</div></div><div><div>CHK:AA</div><div>CHK:</div><div>PROJ. NO: 22590</div><div>SCALE: 1" = 300'</div></div><div><div>DATE:11/12/2020</div><div>DATE:</div></div></div><div>THIS MAP/DOCUMENT IS A TOOL TO ASSIST EMPLOYEES IN THE PERFORMANCE OF THEIR JOBS. YOUR PERSONAL SAFETY IS PROVIDED FOR BY USING SAFETY PRACTICES, PROCEDURES, AND EQUIPMENT AS DESCRIBED IN THE SAFETY TRAINING PROGRAMS AND MANUALS.</div><div>ENERGY SUPPLY ENGINEERING &amp; CONSTRUCTION</div></div>				UNIT 0 CIVIL ACCESS ROADS	
															DWG NO.	MANUFACTURER	DESCRIPTION						
0		ISSUED FOR CONSTRUCTION		05/29/2020	MDR	AA	MDR																
1		ISSUED FOR RECORD - CROWNED RIDGE 22590		11/12/2020	MDR	AA	MDR																
																		CIVIL SITE PLAN T-66, T-67, T-70					
																		NH-275900-8-34		REV 1			






PREPARED FOR:

**BLATTNER**  
**ENERGY**


392 COUNTY RD 50  
AVON, MN 56310

**SEE SHEET NH-275900-8-31**

NO	REVISION	ZONE	DATE	BY	CHK	ENG	NO	REVISION	ZONE	DATE	BY	CHK	ENG	REFERENCE DRAWINGS			 NORTHERN STATES POWER COMPANY CROWNED RIDGE II WIND FARM CODINGTON, DEUEL, GRANT COUNTIES, SOUTH DAKOTA	THIS MAP/DOCUMENT IS A TOOL TO ASSIST EMPLOYEES IN THE PERFORMANCE OF THEIR JOBS. YOUR PERSONAL SAFETY IS PROVIDED FOR BY USING SAFETY PRACTICES, PROCEDURES, AND EQUIPMENT AS DESCRIBED IN THE SAFETY TRAINING PROGRAMS AND MANUALS.	UNIT 0 CIVIL ACCESS ROADS  CIVIL SITE PLAN T-64, T-65	REV		
														DWG NO.	MANUFACTURER	DESCRIPTION						
0	ISSUED FOR CONSTRUCTION		05/29/2020	MDR	AA	MDR																
1	ISSUED FOR RECORD - CROWNED RIDGE 22590		11/12/2020	MDR	AA	MDR																
														DWN: MDR	DATE: 11/12/2020	CHK: AA	DATE: 11/12/2020			ENERGY SUPPLY ENGINEERING & CONSTRUCTION	NH-275900-8-35	1
														ENG: MDR	DATE: 11/12/2020	CHK:	DATE:					
														PM: AA	DATE: 11/12/2020	PROJ. NO: 22590						
														APVD:	DATE:	SCALE: 1" = 300'						



SEE SHEET NH-275900-8-37

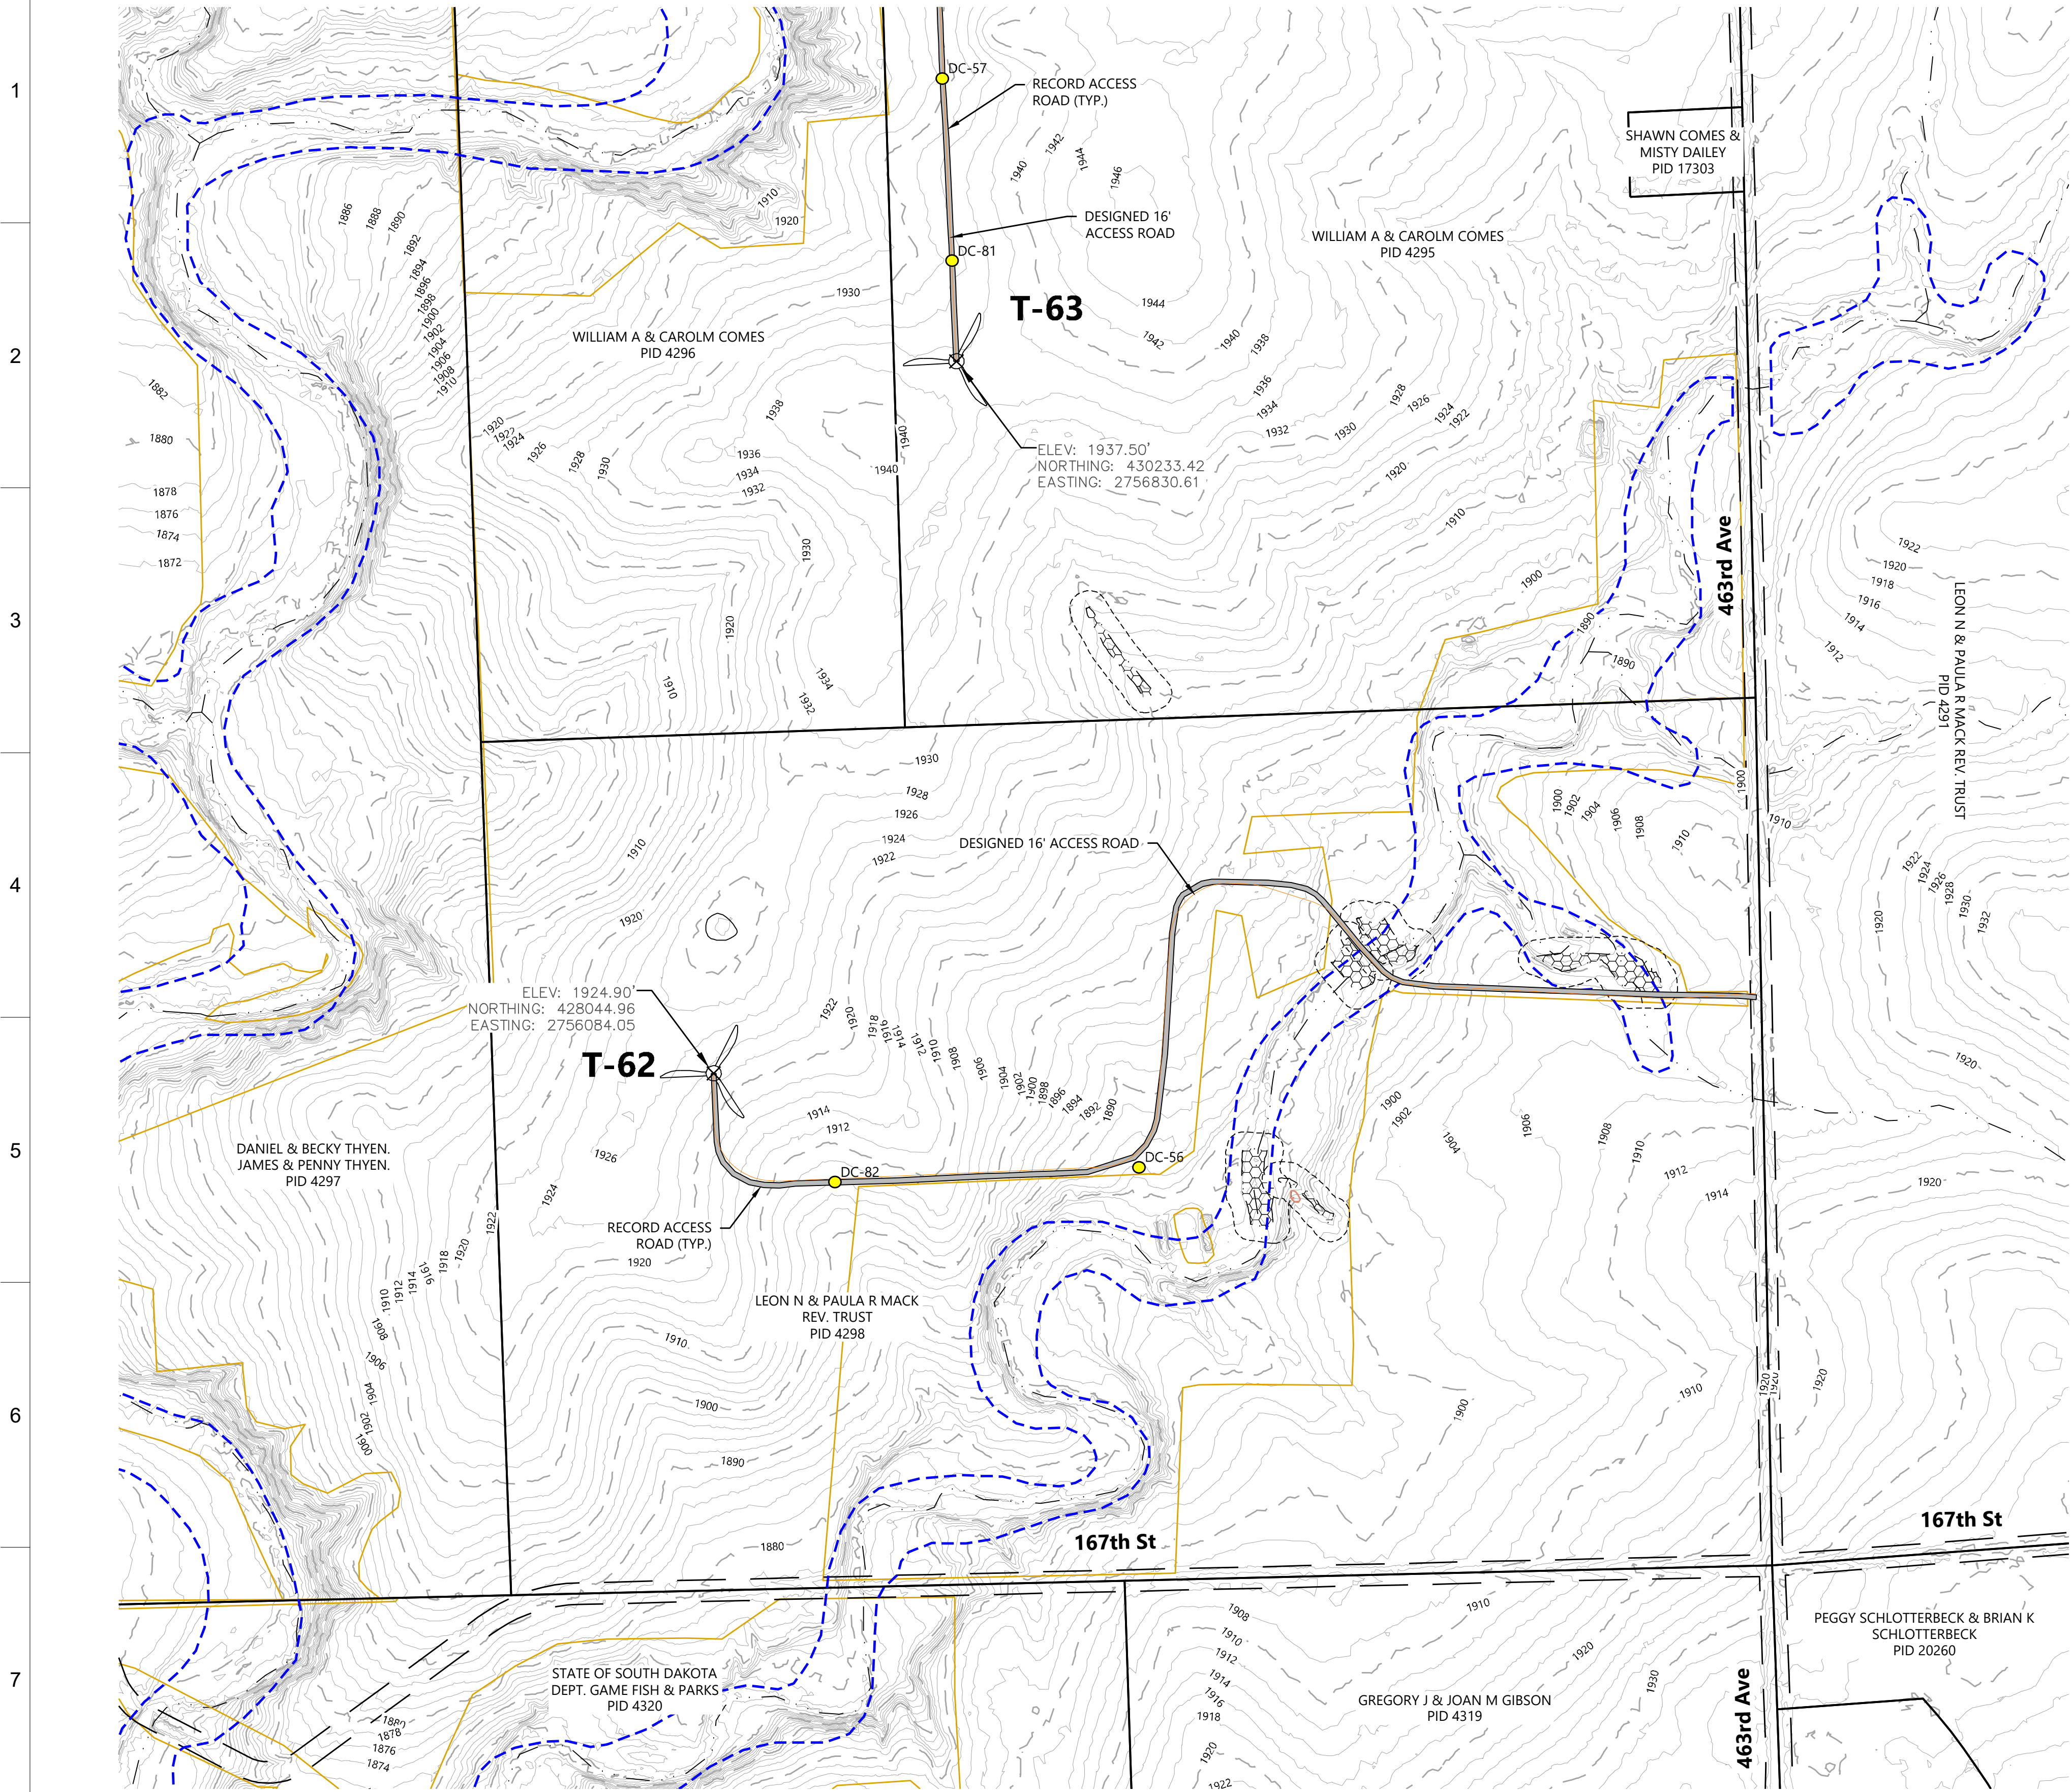

LEGEND:

- T-#

RECORD TURBINE LOCATION
- MET-XX

MET TOWER LOCATION
- ADLS

ADLS RADAR LOCATION
- DESIGNED ACCESS ROAD

RECORD ACCESS ROAD
- P-PUG

DESIGNED UNDERGROUND COLLECTION
- P-PON

DESIGNED OVERHEAD TRANSMISSION
- NON-PARTICIPATING LAND

PROPERTY LINE
- RIGHT-OF-WAY LINES

EASEMENT LINES
- POH

EX. OVERHEAD POWER
- GAS

EX. GAS PIPELINE
- STREAM CHANNEL

EX. STREAM CHANNEL
- WETLAND

EX. WETLAND
- WATER SETBACK LINE

EX. WATER SETBACK LINE
- FEMA FLOOD ZONE

EX. FEMA FLOOD ZONE
- PROTECTED WILDLIFE BUFFER LINE

EX. PROTECTED WILDLIFE BUFFER LINE
- ARCHEOLOGICAL AVOIDANCE AREA

EX. ARCHEOLOGICAL AVOIDANCE AREA
- EXISTING LAKE

EX. EXISTING LAKE
- RECORD LOW WATER CROSSING



EX. RECORD LOW WATER CROSSING
- RECORD CULVERT

EX. RECORD CULVERT
- INDEX CONTOUR

EX. INDEX CONTOUR
- INTERVAL CONTOUR

EX. INTERVAL CONTOUR

KEY MAP:

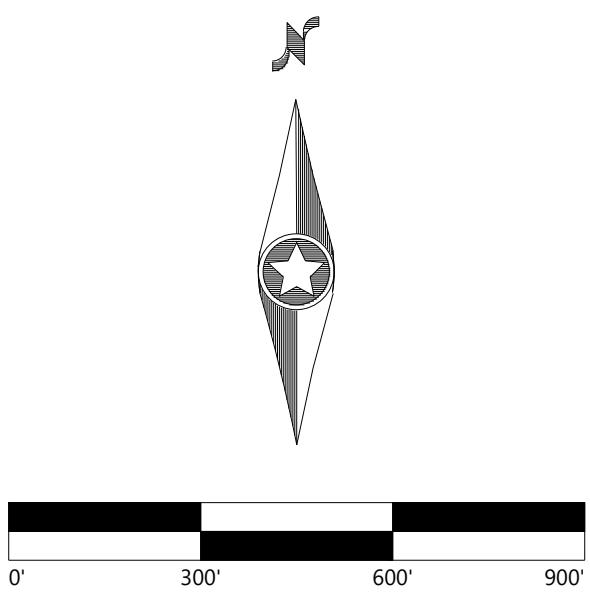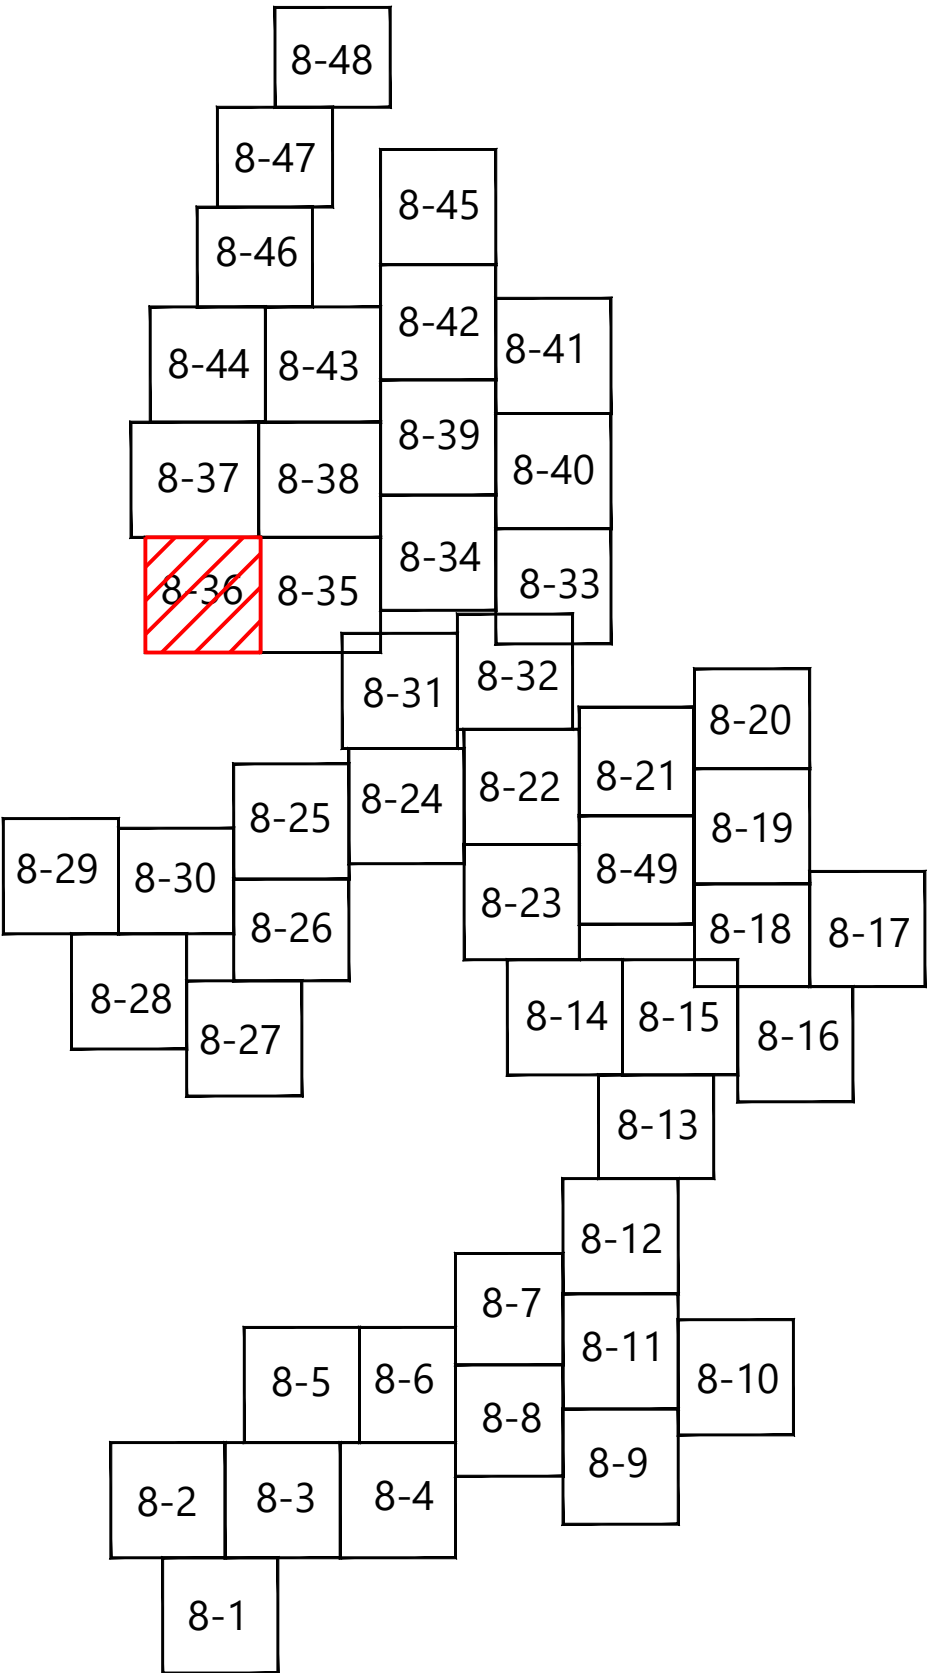

Westwood

Phone (214) 473-4640 2740 Dallas Parkway, Suite 280  
Toll Free (888) 937-5150 Plano, TX 75093  
westwoodps.com

Westwood Professional Services, Inc.

PREPARED FOR:

BLATTNER ENERGY

392 COUNTY RD 50  
AVON, MN 56310

ISSUE FOR RECORD

NO	REVISION	ZONE	DATE	BY	CHK	ENG	NO	REVISION	ZONE	DATE	BY	CHK	ENG	REFERENCE DRAWINGS		
														DWG NO.	MANUFACTURER	DESCRIPTION
0	ISSUE FOR CONSTRUCTION		05/29/2020	MDR	AA	MDR										
1	ISSUED FOR RECORD - CROWNED RIDGE 22590		11/12/2020	MDR	AA	MDR										

<div><div>XcelEnergy®</div><div>NORTHERN STATES POWER COMPANY</div><div>CROWNED RIDGE II WIND FARM</div><div>CODINGTON, DEUEL, GRANT COUNTIES, SOUTH DAKOTA</div></div>				DATE: 11/12/2020	CHK: AA	DATE: 11/12/2020
DWN: MDR	ENG: MDR	PM: AA	APVD:	DATE: 11/12/2020	CHK:	DATE:
				DATE: 11/12/2020	PROJ. NO: 22590	
				DATE:	SCALE: 1" = 300'	

THIS MAP/DOCUMENT IS A TOOL TO ASSIST EMPLOYEES IN THE PERFORMANCE OF THEIR JOBS. YOUR PERSONAL SAFETY IS PROVIDED FOR BY USING SAFETY PRACTICES, PROCEDURES, AND EQUIPMENT AS DESCRIBED IN THE SAFETY TRAINING PROGRAMS AND MANUALS.

ENERGY SUPPLY  
ENGINEERING & CONSTRUCTION

UNIT 0  
CIVIL ACCESS ROADS

CIVIL SITE PLAN T-62, T-63

NH-275900-8-36

REV  
1



[illegible]





ISSUE FOR RECORD

RE



