


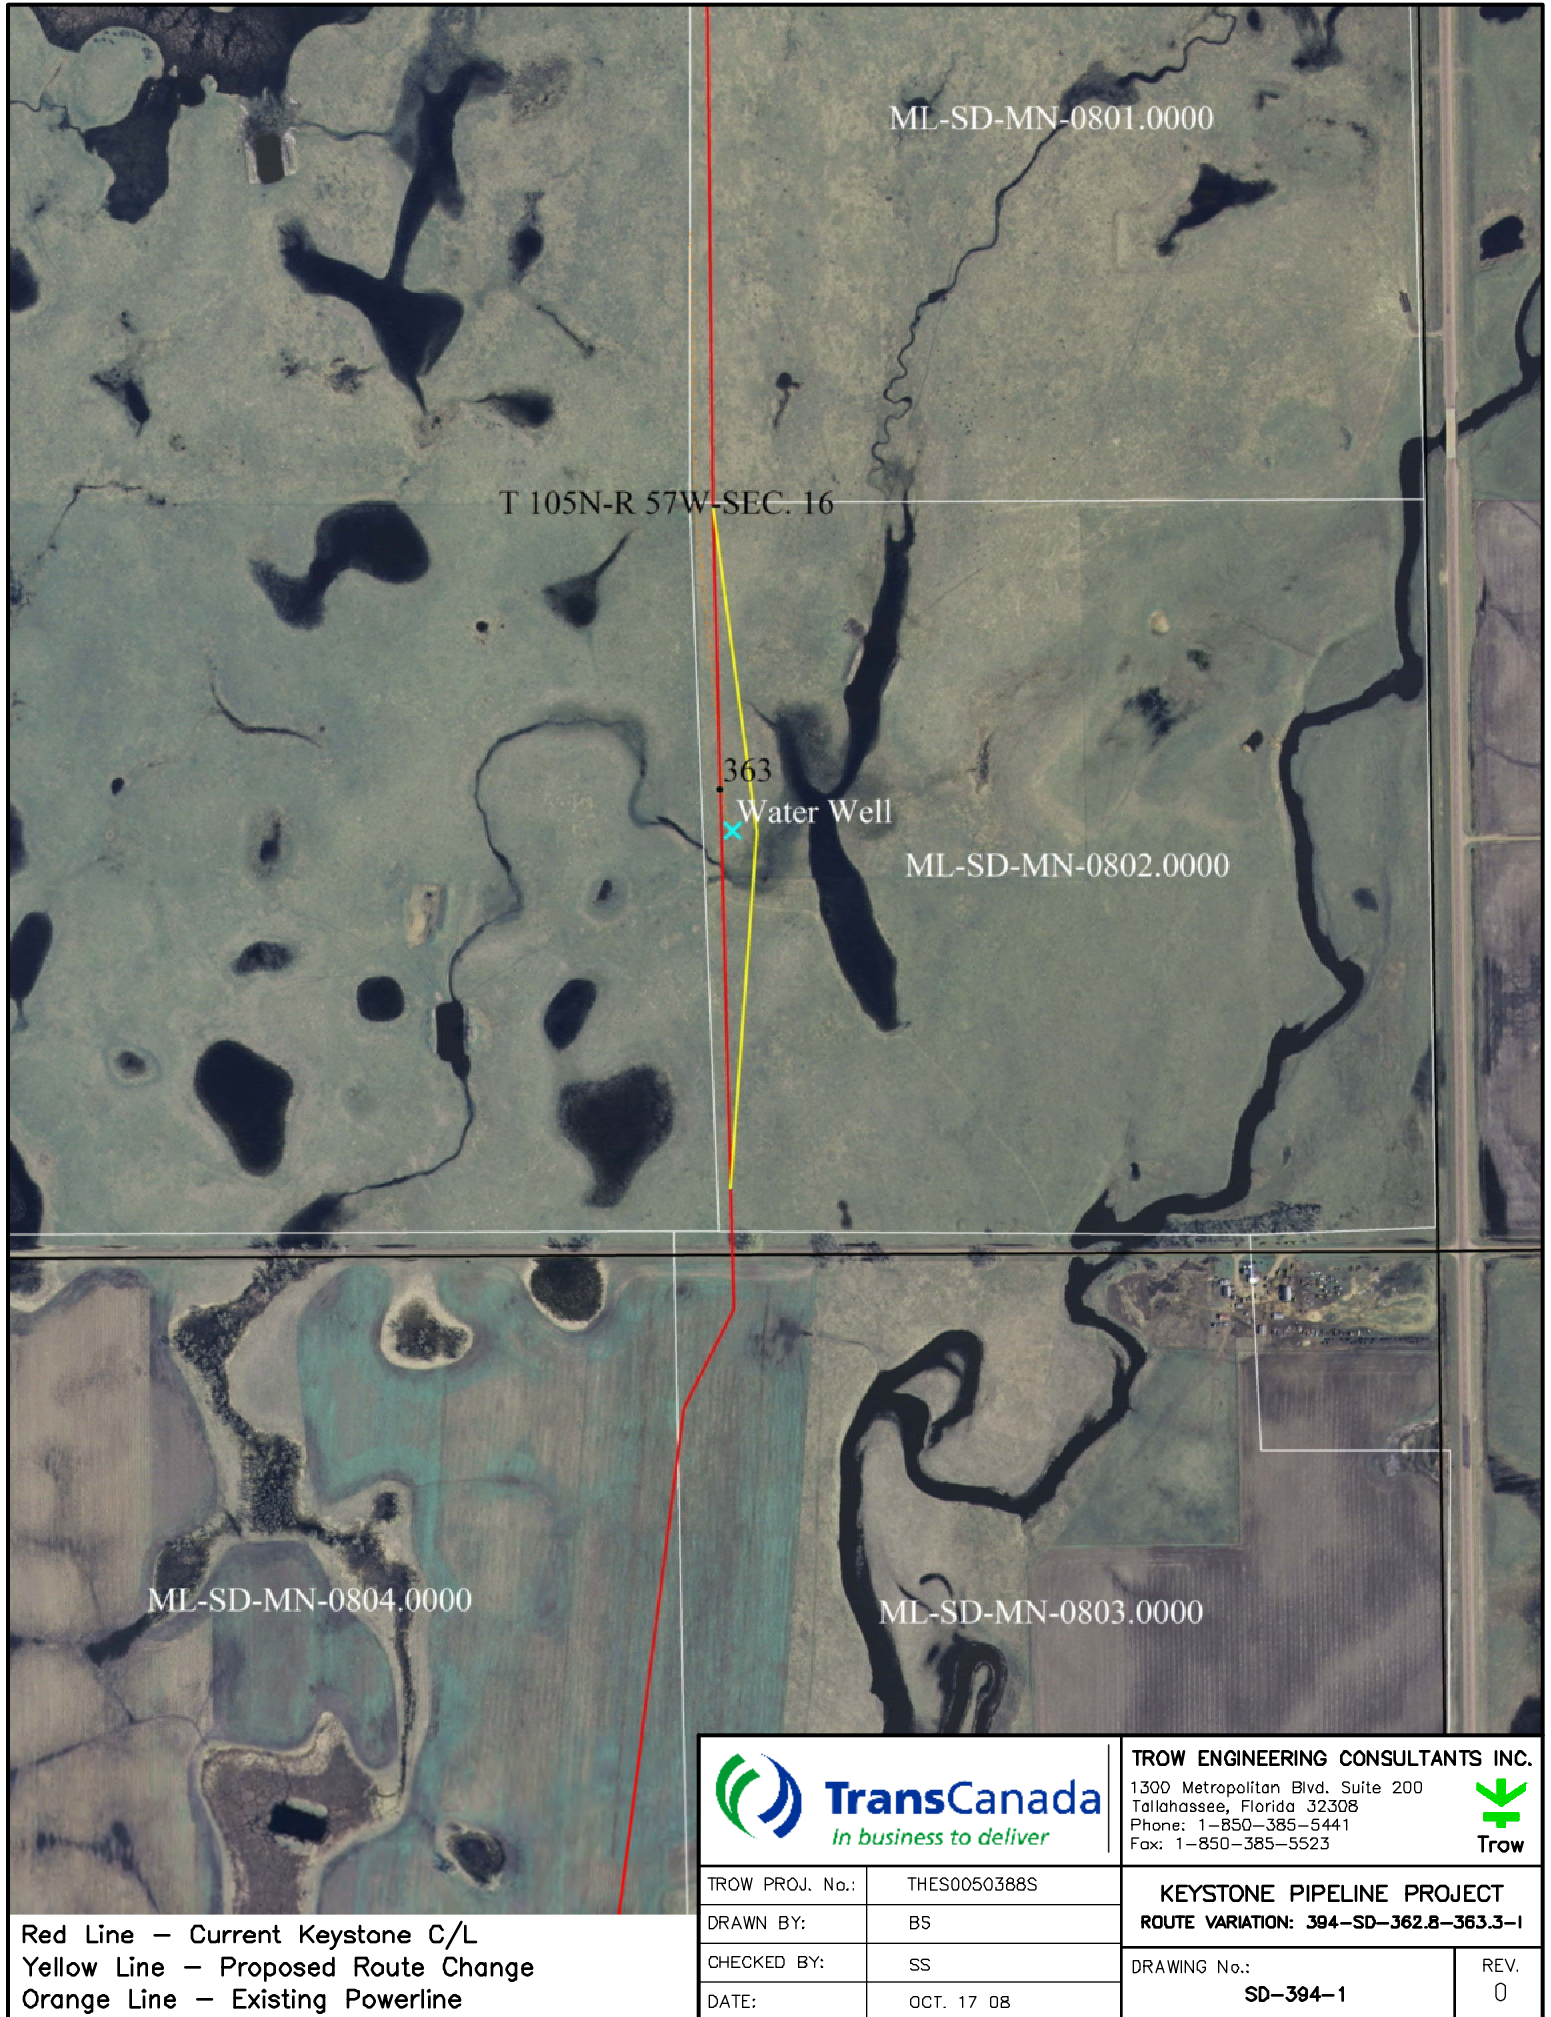

T 105N-R 57W-SEC. 16

ML-SD-MN-0801.0000

ML-SD-MN-0802.0000

ML-SD-MN-0803.0000

ML-SD-MN-0804.0000



TROW ENGINEERING CONSULTANTS INC.
1300 Metropolitan Blvd. Suite 200
Tallahassee, Florida 32308
Phone: 1-850-385-5441
Fax: 1-850-385-5523



Red Line — Current Keystone C/L
Yellow Line — Proposed Route Change
Orange Line — Existing Powerline

TROW PROJ. No.:	THES0050388S
DRAWN BY:	BS
CHECKED BY:	SS
DATE:	OCT. 17 08

KEYSTONE PIPELINE PROJECT	
ROUTE VARIATION: 394-SD-362.8-363.3-1	
DRAWING No.:	REV.
SD-394-1	0