



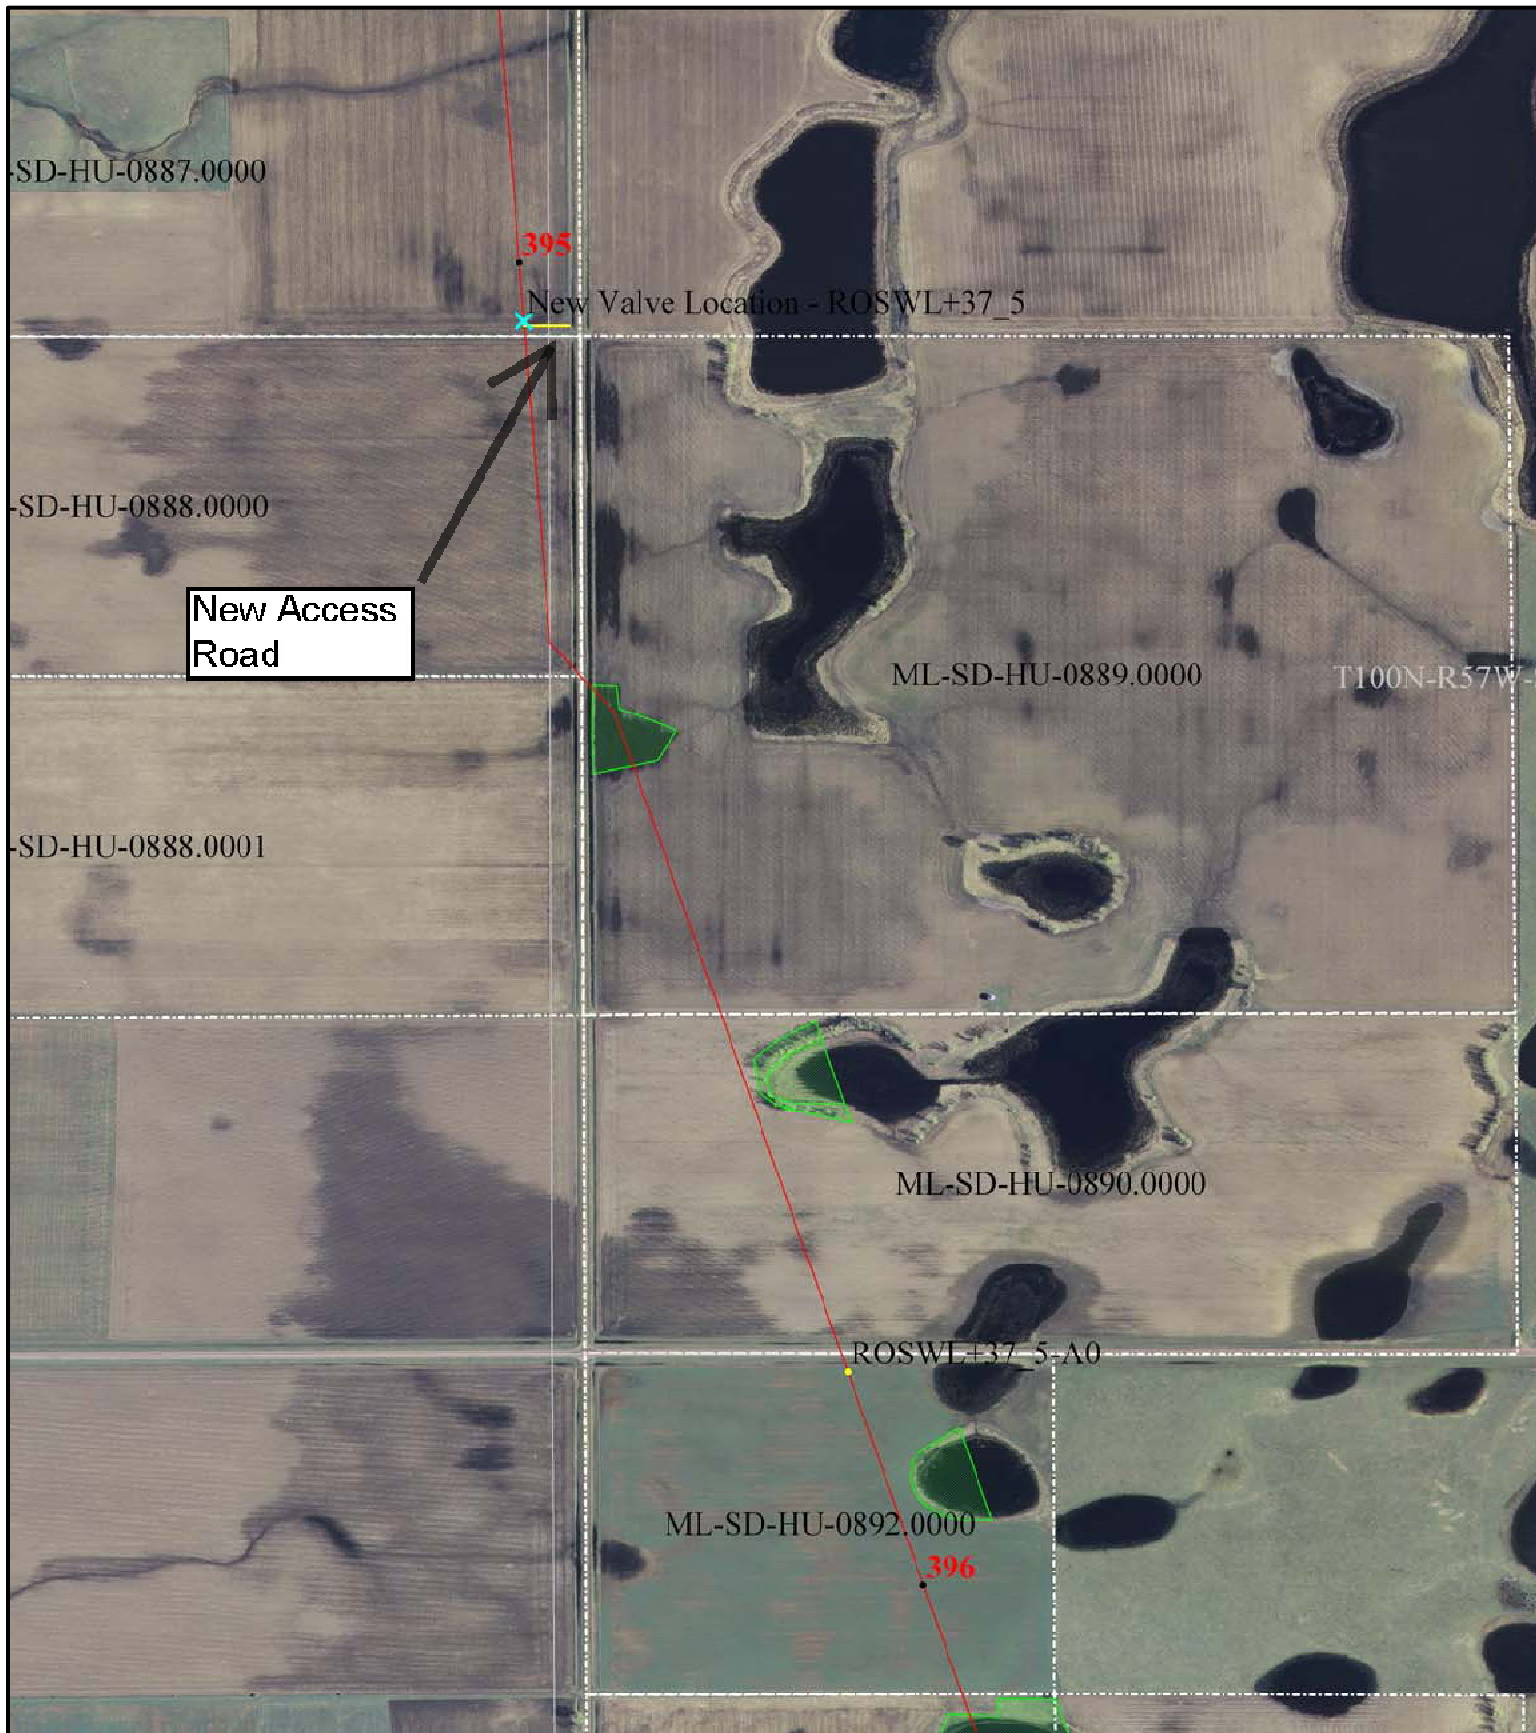

SCALE:

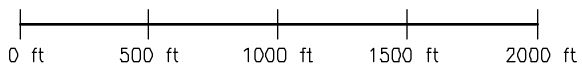

Red Line — Current Keystone Route
Yellow Line — Proposed Change



TROW PROJ. No.:	THES0050388S
DRAWN BY:	BS
CHECKED BY:	SS
DATE:	OCT. 17 08

TROW ENGINEERING CONSULTANTS INC.

1300 Metropolitan Blvd. Suite 200
Tallahassee, Florida 32308
Phone: 1-850-385-5441
Fax: 1-850-385-5523



KEYSTONE PIPELINE PROJECT
ROUTE VARIATION: 403-XX-XX.X-XX.X-S

DRAWING No.:
SD-403-1

REV.
0