





SCALE:

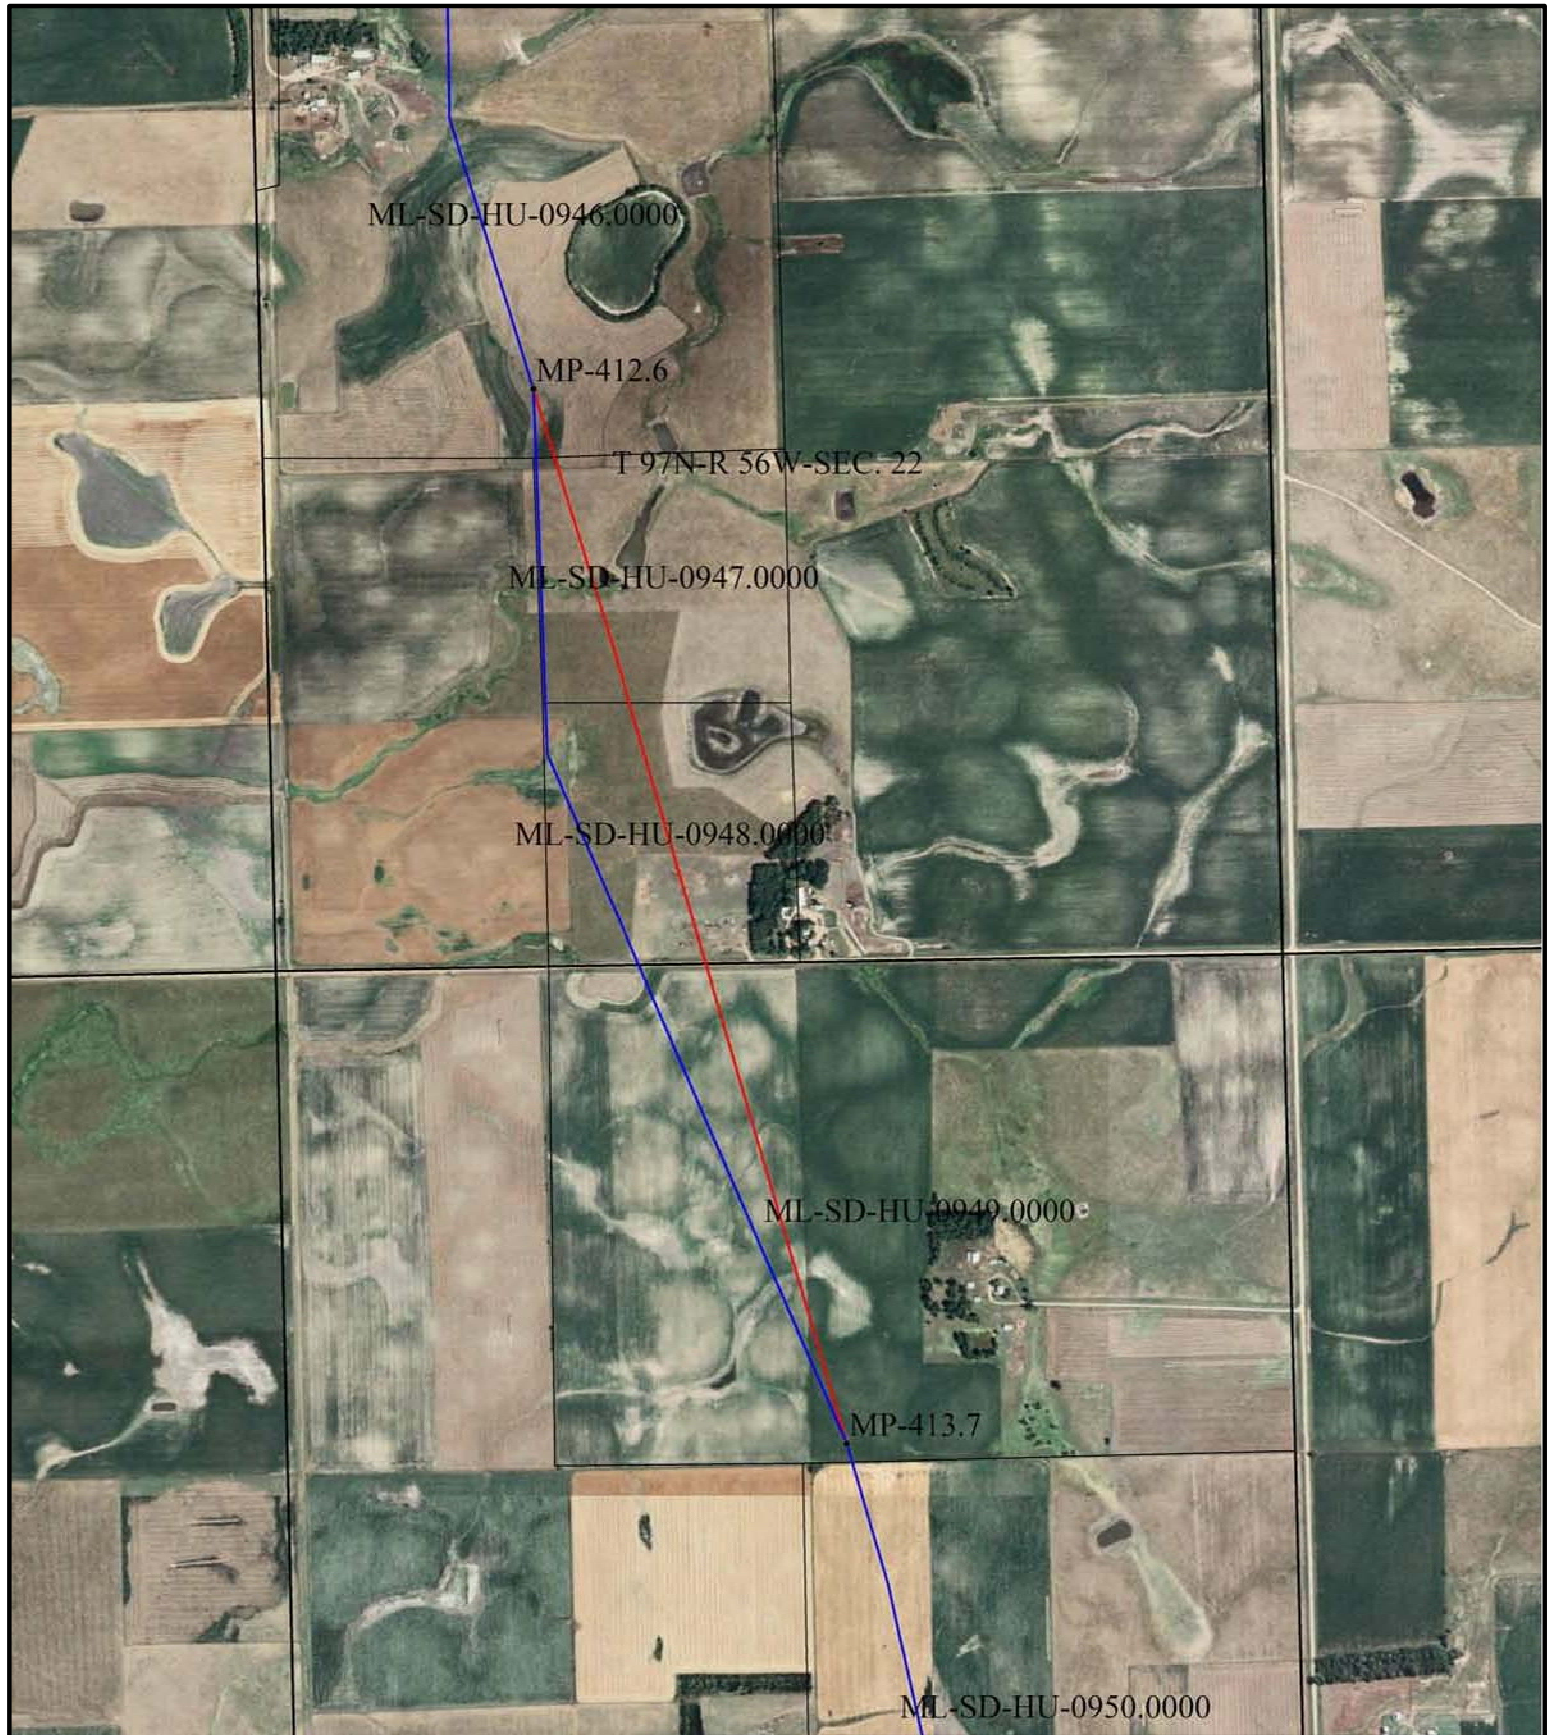

Blue Line – Current Keystone Center Line
Red Line – Route Variation

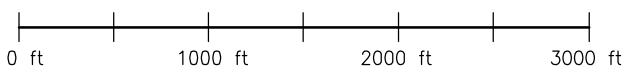

TransCanada
In business to deliver

TROW PROJ. No.: THES0050388S

DRAWN BY: TB

CHECKED BY: SS

DATE: OCT 17 08

TROW ENGINEERING CONSULTANTS INC.

1300 Metropolitan Blvd. Suite 200
Tallahassee, Florida 32308
Phone: 1-850-385-5441
Fax: 1-850-385-5523



Trow

KEYSTONE PIPELINE PROJECT
ROUTE VARIATION: 347-SD-412.6-413.7-I

DRAWING No.:
SD-347-1

REV.
0