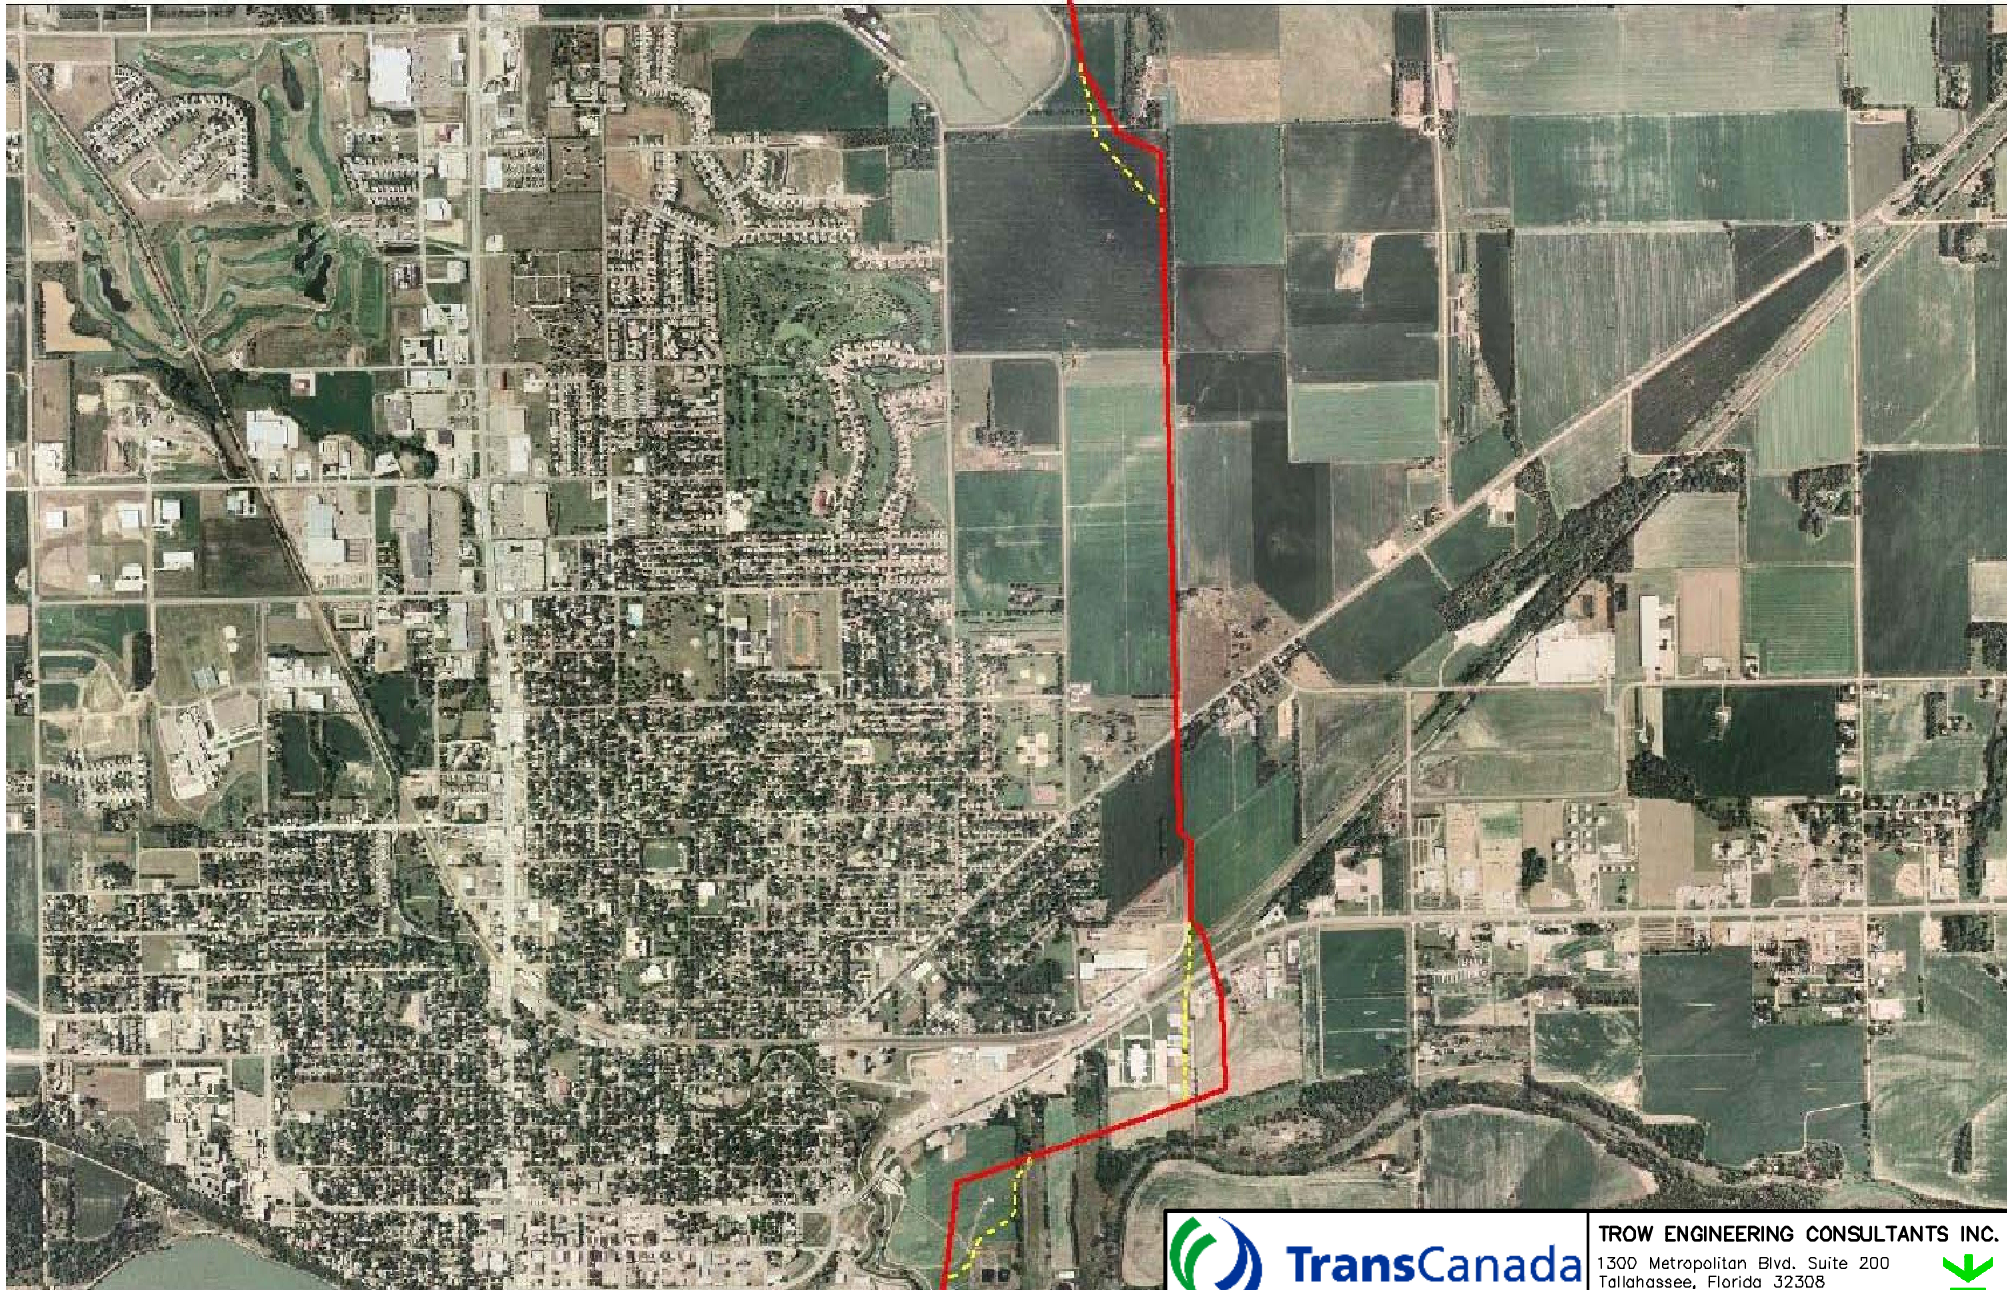


Red Line – Current Route
Yellow Line – Route Variation

 TransCanada <i>In business to deliver</i>		TROW ENGINEERING CONSULTANTS INC. 1300 Metropolitan Blvd, Suite 200 Tallahassee, Florida 32308 Phone: 1-850-385-5441 Fax: 1-850-385-5523		 Trow
		KEYSTONE PIPELINE PROJECT ROUTE VARIATION: 339-SD-434.2-437.4-S		
TROW PROJ. No.:	THES0050388S	DRAWING No.:		REV.
DRAWN BY:	TB	SD-339-1		0
CHECKED BY:	SS			
DATE:	OCT 17 08			