

RICHARD HASTINGS


219

DARLENE HASTINGS - RICHARD HASTINGS


DARLENE HASTINGS

Marshall County, SD

Red Line – Current Keystone Centerline  
 Yellow Line – Route Variation

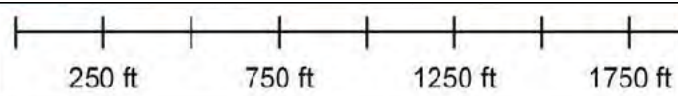

**TROW ENGINEERING CONSULTANTS INC.**  
 1300 Metropolitan Blvd. Suite 200  
 Tallahassee, Florida 32308  
 Phone: 1-850-385-5441  
 Fax: 1-850-385-5523



TROW PROJ. No.:	THES0050388S
DRAWN BY:	TB
CHECKED BY:	SS
DATE:	OCT 17 08

<b>KEYSTONE PIPELINE PROJECT</b>	
<b>ROUTE VARIATION: 376-SD-219.1-219.7-1</b>	
DRAWING No.:	REV.
<b>SD-376-1</b>	<b>0</b>