



MIDAMERICAN ENERGY COMPANY  
P.O. Box 4350  
Davenport, Iowa 52808-4350

SOUTH DAKOTA GAS TARIFF SCHEDULE NO. 2  
SD P.U.C. Sec. No. 2  
~~3<sup>rd</sup> 2<sup>nd</sup> Revised Sheet No. 1~~  
Canceling ~~2<sup>nd</sup> 4<sup>th</sup> Revised Sheet No. 1~~

## SECTION 2 – PRELIMINARY STATEMENT

### TERRITORY SERVED

Listed below are the communities (in whole or part) to which this schedule is applicable.

Akron	Elk Point	Mission Hill*	D/T
Alcester	<b>Ellis</b>	<del>Mitchell</del>	N/D
Alexandria*	Flandreau	Montrose	T
Arlington*	Frankfort*	Moody County	T/T
Baltic	Fulton*	North Sioux City	T
Beadle County*	Gayville	Oldham*	T/T
Beresford	Harrisburg	<del>Parker</del>	D
Brandon	Hamlin County*	Ramona	T
Brookings*	Hanson County*	Raymond*	T/T/T
Brookings County*	Hartford	Salem	T
Brown County*	<del>Hawarden</del>	Sioux Falls	T/D
Bryant*	Hazel*	Spink County*	T/T/T
<b>Burbank*</b>	Howard*	Stratford*	N/T/T
Canton	Humboldt*	Tea	T
<b>Carpenter*</b>	Huron*	Turner County	N/T
Centerville	Iroquois*	Union County	T
<del>Clark</del>	Jefferson	Valley Springs	D
Clark County*	Kingsbury County*	Vermillion	T/T
Clay County	Lake County	Volga*	T
<del>Colman</del>	Lake Preston*	Willow Lake*	D/T/T
Colton	Lennox	<b>Winfred*</b>	N
Conde*	Lincoln County	Worthing	T
<b>Corson</b>	Madison*	Yankton	N/T
Dakota Dunes	McCook County	Yankton County	
<del>Davison County</del>	<b>McCook Lake</b>		D/N
De Smet*	<b>Meckling</b>		T/N
Dell Rapids	Minnehaha County		
Doland*	Miner County*		T/T

\* **Indicates Farm Tap customers only**


N

Date Filed: **August 23, 2021** ~~October 10, 2017~~ Effective Date: **September 30, 2021** ~~November 1, 2017~~  
Effective on less than 30 days notice by authority of the  
Public Utilities Commission of South Dakota, dated October 24, 2017 in Docket No. NG17-014

Issued By: **Timothy J. Whipple** ~~Rob Berntsen~~  
Senior V.P. & **Vice President**, General Counsel

**SECTION 2 – PRELIMINARY STATEMENT (continued)**


**TERRITORY MAP**

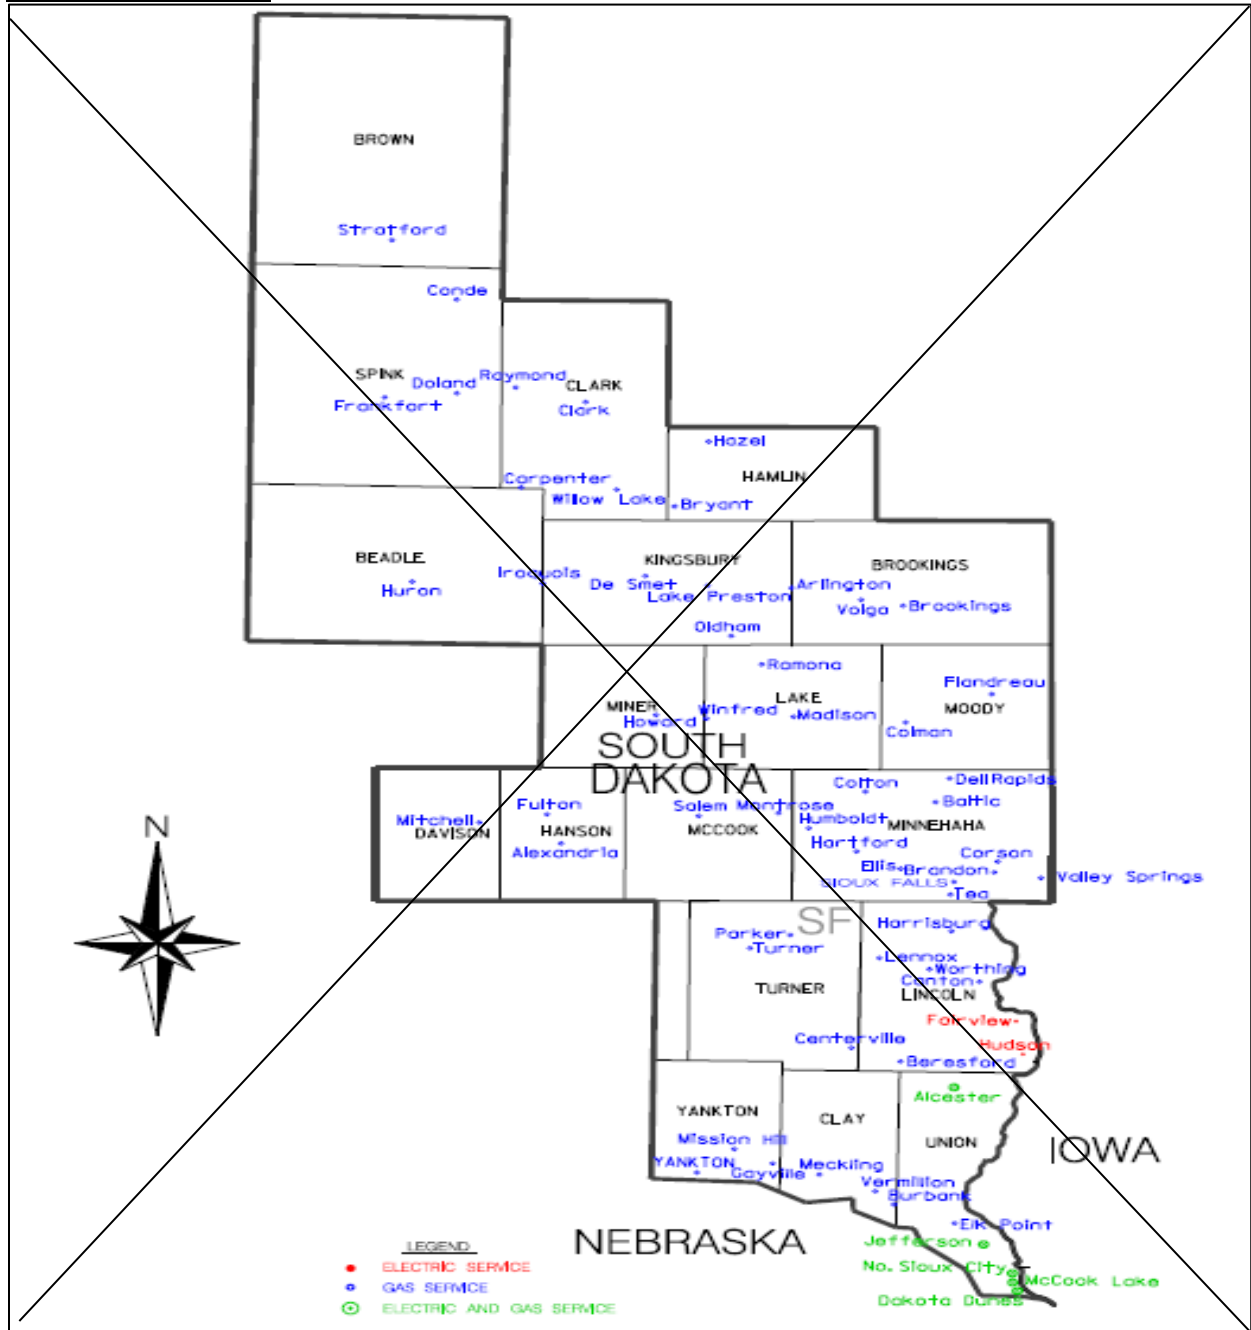

T

Date Filed: **August 23, 2021** October 10, 2017 Effective Date: **September 30, 2021** November 1, 2017  
Effective on less than 30 days notice by authority of the  
Public Utilities Commission of South Dakota, dated October 24, 2017 in Docket No. NG17-014

Issued By: **Timothy J. Whipple** Rob Bortson  
Senior V.P. & **Vice President**, General Counsel

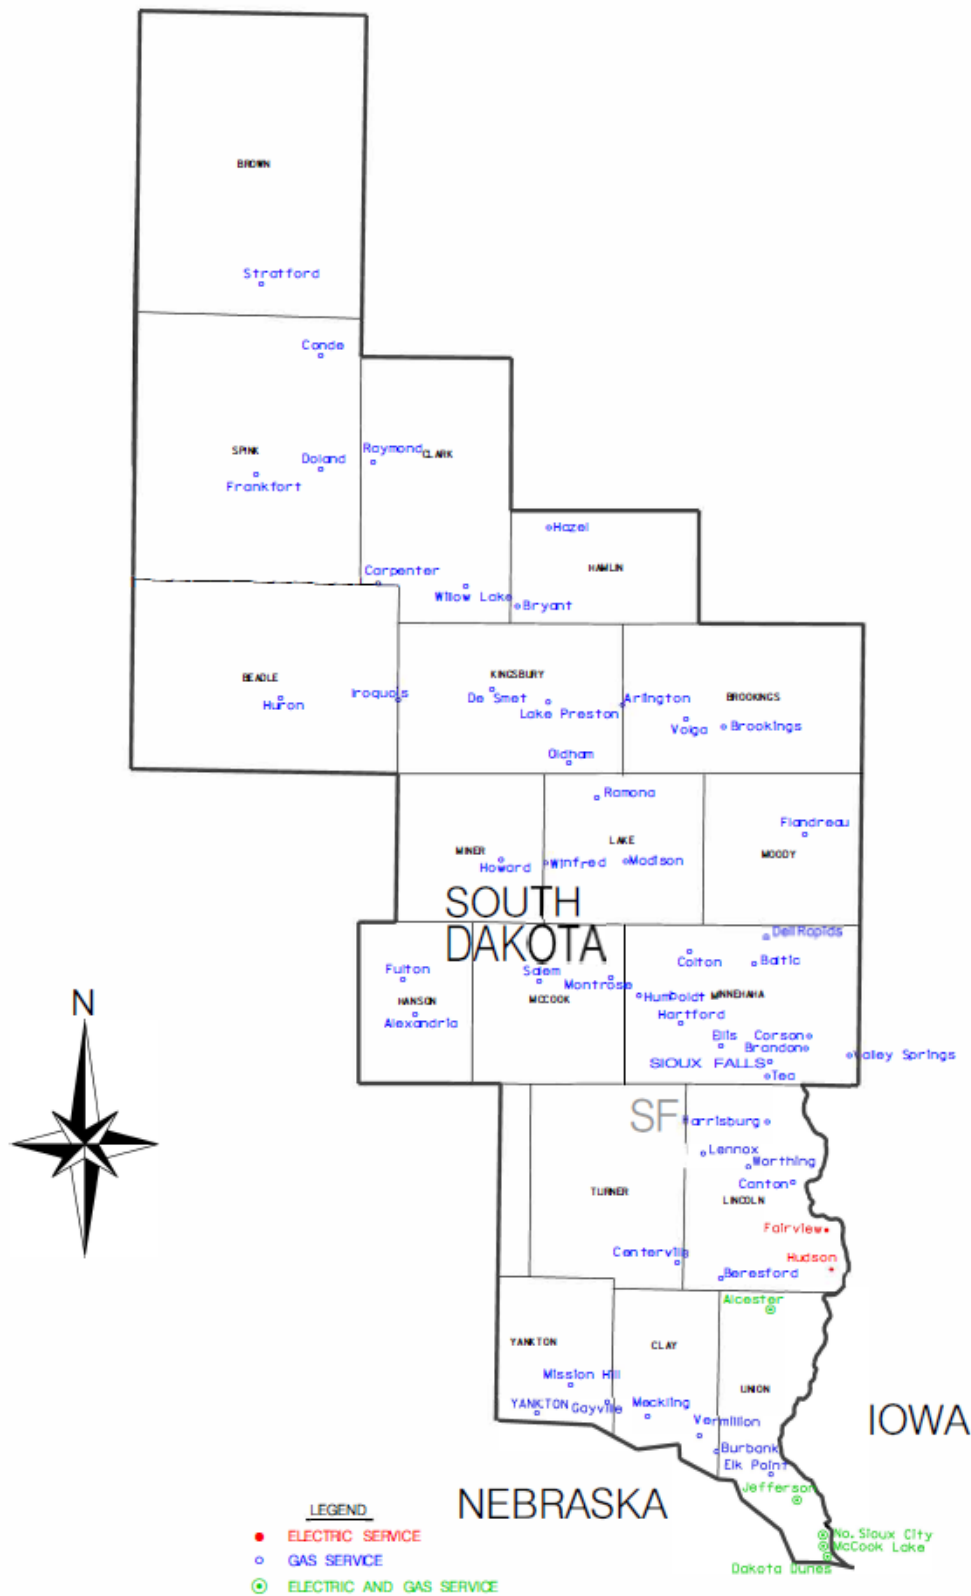

Date Filed: **August 23, 2021** October 10, 2017 Effective Date: **September 30, 2021** November 1, 2017  
 Effective on less than 30-days notice by authority of the  
 Public Utilities Commission of South Dakota, dated October 24, 2017 in Docket No. NG17-014

Issued By: **Timothy J. Whipple** Rob Bortson  
 Senior V.P. & **Vice President**, General Counsel