RIGHT-OF-WAY
HORIZONTAL REPRESENTATION (2D)
TRACT NUMBER
OWNERSHIP/AGENCY
LENGTH
APPLICABLE DWG. NO.

LAND USE

PIPELINE PROFILE

HORIZ. 1"=500' VER. 1"=100'
HORIZONTAL REPRESENTATION (2D)

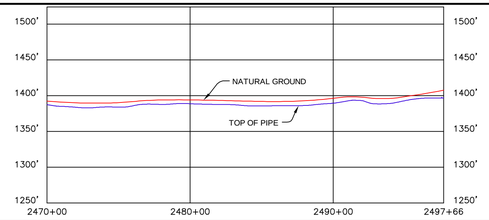

PIPELINE PLAN (SCALE 1" = 500')HORIZONTAL REPRESENTATION (2D)

DISCLAIMER

UNIVERSALPEGASUS MAKES NO WARRANTY (EXPRESS, IMPLIED OR OTHERWISE) THAT THE INFORMATION CONTAINED HEREIN IS ACCURATE OR COMPLETE AS TO ANY AND ALL SUBSURFACE CONDITIONS AND CONFORMATION. ANY RELIANCE CONTRACTOR PLACES ON THE INFORMATION CONTAINED HEREIN AS TO SUCH CONDITIONS IS DONE SO AT ITS OWN RISK AND EXPENSE. IT IS THE SOLE RESPONSIBILITY OF THE CONTRACTOR TO CONTACT THE STATE "ONE CALL" SYSTEM PRIOR TO ANY EXCAVATION.

LEGEND

- KEYSTONE PIPELINE
- STATE BOUNDARY
- COUNTY/TOWNSHIP
- SECTIONS
- NATIONAL OR STATE RESERVATION BOUNDARY
- PROPERTY LINE
- FENCE
- EXCLUSIONARY FENCE
- POWER LINE
- TELEPHONE LINE
- BURIED CABLE
- WATER LINE
- SANITARY SEWER LINE
- STORM SEWER / DRAIN
- FOREIGN PIPELINE
- RAILROAD
- HIGHWAY / ROAD
- STREAM / DITCH
- WETLAND
- INTERSTATE ROUTE
- U.S. ROUTE
- STATE ROUTE
- POINT OF INTERSECTION (PI)
- PIPELINE MILEPOST (MP 95)
- DIRECTION OF FLOW
- HOUSE
- BUILDING (B)
- WATER WELL (W)
- MAINLINE VALVE
- ML-XX-XX-0000.0000 TRACT NUMBER

PIPELINE SCHEMATIC

- HEAVYWALL PIPE
- WELD FITTING
- TRANSITION PIECE
- CASING PIPE
- CONCRETE COATING
- (3) SET-ON WEIGHTS
- PIPELINE WARNING SIGN
- PIPELINE MARKER
- (1) MATERIAL ITEM
- (GM) GROUNDING MAT
- ZINC RIBBON
- (AM) AERIAL MARKER
- CATHODIC TEST STATION
- MAINLINE VALVE
- CHECK VALVE
- O.C. OPEN CUT
- BR. BORE

PIPELINE DATA — STATION/DESCRIPTION

- D DRINKING WATER USA
- E ECOLOGICAL USA
- H HIGHLY POPULATED AREA
- K OPERATOR (KEYSTONE) DEFINED
- O OTHER POPULATED AREA
- S SOURCE WATER PROTECTION AREA
- W WELLHEAD PROTECTION AREA

HORIZONTAL STATIONS (2D)

MATCHLINE 2470+00 | 2476+64 P.I. 05°27'23" LT. | 2491+24 P.I. 00°33'26" RT. | 2493+83 P.I. 08°23'22" RT. | 2494+09 P.I. 08°13'38" RT. | 2496+22 PUMP STATION PROPERTY LINE | 2497+66 CENTERLINE OF MAIN ROSWELL AD-NOV-0102

SLOPE STATIONS (3D)

MATCHLINE 2471+42 | 2478+06 P.I. 05°27'23" LT. | 2492+67 P.I. 00°33'26" RT. | 2495+26 P.I. 08°23'22" RT. | 2495+52 P.I. 08°13'38" RT. | 2497+66 PUMP STATION PROPERTY LINE | 2499+10 CENTERLINE OF MAIN ROSWELL AD-NOV-0102

PIPE SLOPE REPRESENTATION (2D)

2471+42 | 2472+13 (29) 2476+24 | (2) 2,611' FBE | 2497+53 (6) 13' FBE 2497+66 | (423) 144' FOR PUMP STATION ASSEMBLY MATERIAL SEE DWG. 1835-01-ML-03-124 | 2499+10

CPS (3D)

TEST SECTIONS (3D)

TEST SECTION 3B-3
ILTO-026-2010

ENVIRONMENTAL MITIGATION/RECLAMATION STATIONS (2D)

- TOPSOIL SALVAGE METHOD
- STREAMS
- WETLANDS
- TIMING CONSTRAINTS
- STATIONS
- MONITORING
- RECLAMATION
- SPECIAL CONSIDERATIONS

GENERAL NOTES

1) ALL CHAINAGES ARE IN FEET UNLESS OTHERWISE SPECIFIED.
2) DATUM ELEVATION AND PROJECTION ARE BASED ON MEAN SEA LEVEL AND NAD 83.
3) FIELD PIPE LOCATING REQUIRED TO DETERMINE PLACEMENT OF PIPELINE WITHIN PERMANENT EASEMENT.
4) UNLESS OTHERWISE NOTED, 48 INCHES MINIMUM COVER EXCEPT 36 INCHES IN AREAS OF CONSOLIDATED ROCK.
5) NO ACTUAL AS-BUILT GROUND SHOTS WERE TAKEN AT THIS LOCATION. THE PROFILE REPRESENTS A PROJECTION FROM SHOTS TAKEN AT 150' TO 250' INTERVALS.
6) THE TYPE OF COATING APPLIED TO THE FIELD WELDS DURING THE ORIGINAL CONSTRUCTION WAS TWO COMPONENT LIQUID EPOXY. THE COATING PRODUCTS USED WERE DENSO 7200 OR SPC SP-2888.
7) THE SUBSTANTIAL CONSTRUCTION COMPLETION DATE, BASED ON CALIPER PIG RUN, WAS OCTOBER 10, 2009 FOR M.P. 301.75 TO M.P. 343.98 AND OCTOBER 31, 2009 FOR M.P. 343.98 TO 377.31.
8) ORIGINAL IN-SERVICE DATE OF THE KEYSTONE PIPELINE (PHASE 1): JUNE 30, 2010.
9) CPS CALCULATION DATE: MAY 2010.
10) ORION STATION SERIES NUMBER: 1182700.
11) TO DETERMINE THE MILE POST AT A GIVEN LOCATION, ADD THE 3D STATION NUMBER FROM THIS SEGMENT TO STATION NUMBER 16432+39 AND DIVIDE BY 5280.

OPERATING AND TEST PRESSURE

1. THE MAXIMUM OPERATING PRESSURE (MOP) IS 1440 PSIG.
2. THE MINIMUM TEST PRESSURE WAS 1801 PSIG.

BILL OF MATERIALS (3D)

ITEM NO.	DESCRIPTION	QUANTITY
2	30" O.D. X 0.386" W.T., API-5LX-70 W/FBE COATING	2,611'
6	30" O.D. X 0.429" W.T., API-5LX-70 W/FBE COATING	13'
423	ROSWELL PUMP STATION ASSEMBLY (+144')	1 EA
	PIPELINE MARKERS	0 EA
	PIPELINE WARNING SIGNS	0 EA
	CATHODIC TEST STATION	0 EA
	AERIAL MARKER	0 EA

REFERENCE DRAWINGS

REF. NO.	DRAWING NO.	REV. NO.	DRAWING TITLE
423	1835-01-ML-03-124	5	ROSWELL PUMP STATION
	1835-01-ML-03-125	0	ROSWELL PUMP STATION
	1835-01-ML-03-126	0	ROSWELL PUMP STATION

REVISIONS

NO.	DATE	REV BY	CHCK BY	APPRD BY	ENV APPRD	DESCRIPTION
1	5/12/08	UEI	RDG	LAG	SEC	ISSUED FOR CONSTRUCTION
2	10/12/10	UEI				ISSUED FOR AS-BUILT
						1834-03-ML-02-020
						REPLACES COVERAGE OF
						IFC DRAWINGS
						1834-03-ML-02-031,
						1834-03-ML-02-032

ENGINEERING RECORDS

	INITIAL	DATE		INITIAL	DATE
DRAWN BY	UEI	10/02/15	ENV. APPRD.		
CHECKED BY			APPRD. BY		
			COMPANY APPROVED		

PROFESSIONAL ENGINEER

NAME	STATE	LIC#	REV#	DATE
LOYS ALVIN GRAY, III	SD	CE9004		

SCALE: 0 125 250 500 Feet

TransCanada
In business to deliver

UNIVERSAL ENVIRONMENTAL CONSULTING CORP.

KEYSTONE MAINLINE (NPS 30 2009) CARPENTER SECTION

F/A# 1834 | SPREAD 3B | DISCIPLINE 03

AS-BUILT ALIGNMENT

M.P. 358.03 TO M.P. 358.55

SHEET 20 OF 20 SHEETS

STA. 2471+42 TO STA. 2499+10

(3D)

DRAWING NO. 1834-03-ML-02-020 REV. 2