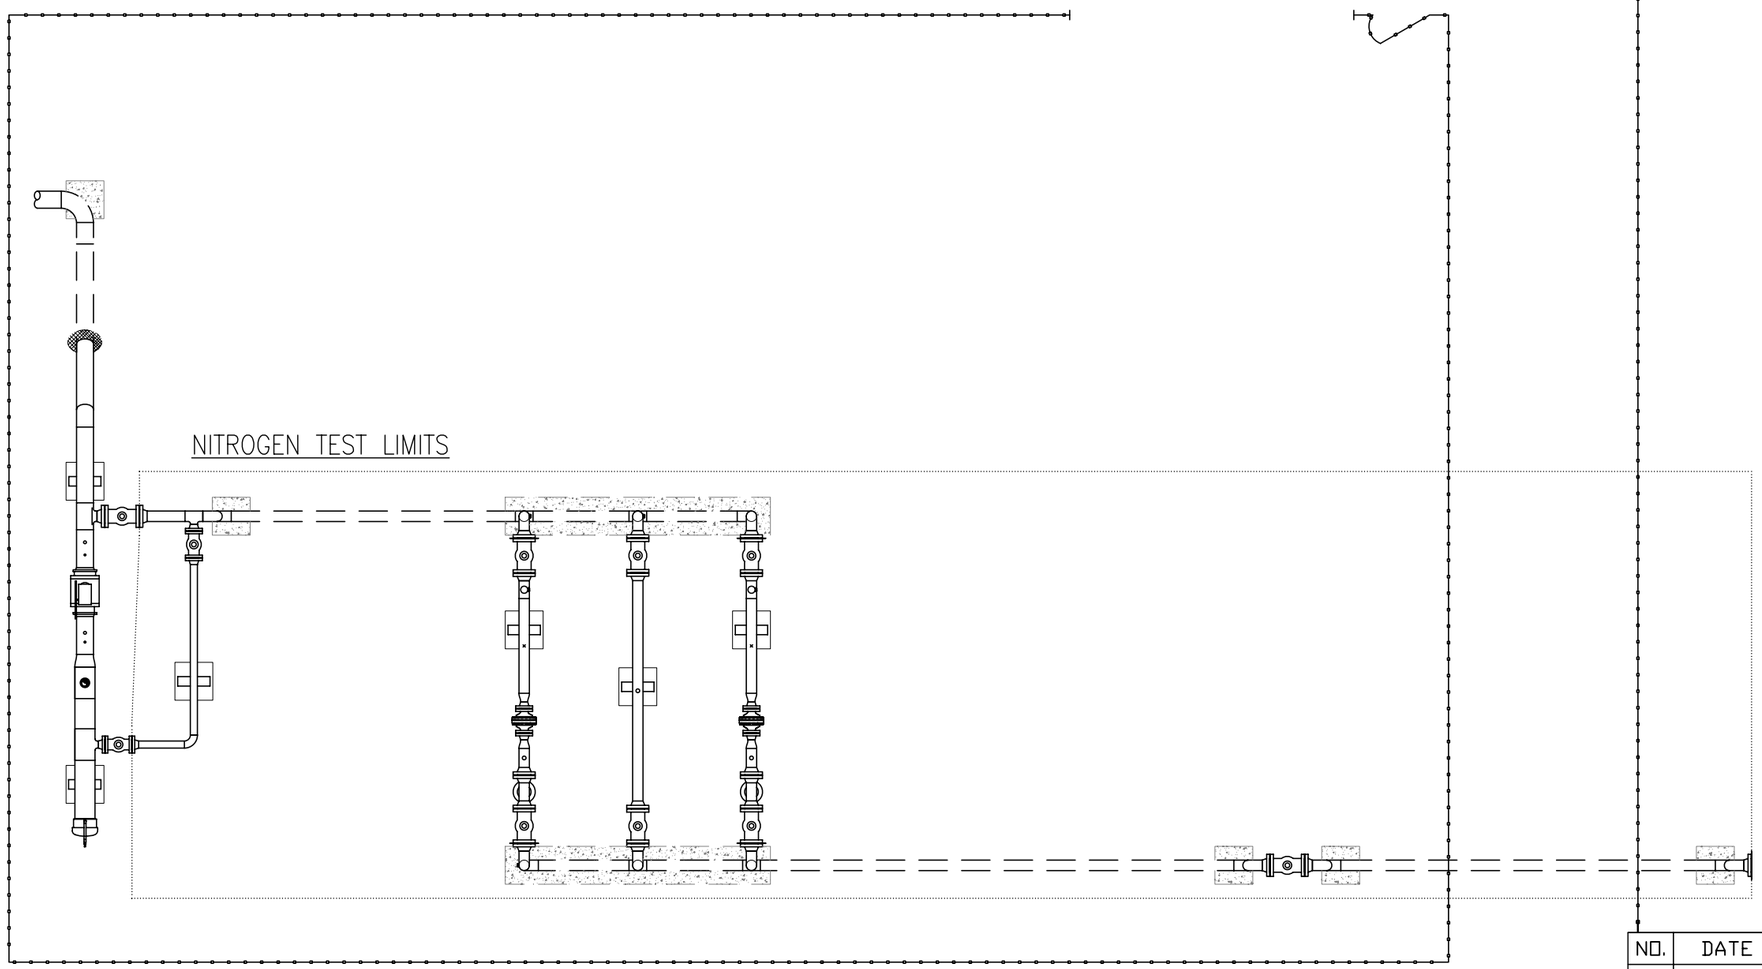

SEE PRESSURE TEST PLAN FOR SPECIFIC INSTRUCTIONS

PRESSURE TESTING SPECIFICATIONS/ PRESSURES								
TEST SECTION	TEST MEDIUM	TEST DURATION	MIN. PRESSURE	MAX. PRESSURE	DESIGN PRESSURE	MATERIAL TEST LIMITS	PRESSURE LIMITING COMPONENT	CLASS LOCATION
INTERCONNECT	NITROGEN	8 HRS	2160 psig	2250 psig	1440 psig	2250 psig	FITTINGS (6", .280" W.T., GR B)	3

AS BUILT

REGISTERED PROFESSIONAL ENGINEER
REG NO. 9918
DAVID P. YEXLEY
SOUTH DAKOTA

NO.	DATE	BY	REVISION
-	-	-	-

BASIN ELECTRIC POWER COOPERATIVE
A Touchstone Energy® Cooperative

MONTANA-DAKOTA UTILITIES CO.
A Division of MDU Resources Group, Inc.

GAS PIPELINE INTERCONNECT NITROGEN TEST LIMITS, DEER CREEK STATION

SCALE	DATE	DRAWN BY	APPROVED BY
1/4"=1'	6/2/10	CASSIE PETER	DAVE YEXLEY

DCS-ML-ONG-0001