RIGHT-OF-WAY
HORIZONTAL REPRESENTATION (2D)
TRACT NUMBER
OWNERSHIP/AGENCY
LENGTH
APPLICABLE DWG. NO.

520+00 | ML-SD-HA-0815.0000 | RD-SD-HA-0815.0000 248TH STREET | 544+67 | ML-SD-HA-0815.0001 | 557+85 | ML-SD-HA-0815.0002 | 571+52 | ML-SD-HA-0816.0000 | RD-SD-HA-0816.0000 247TH STREET | 598+25 | ML-SD-HA-0818.0000 | 621+43 | RD-SD-HA-0818.0000 STATE HIGHWAY 25 | 623+58 | ML-SD-HA-0819.0000 | 633+37 | ML-SD-HA-0820.0000 | 650+00

LAND USE

PIPELINE PROFILE

HORIZ: 1"=500' VER: 1"=100'
HORIZONTAL REPRESENTATION (2D)

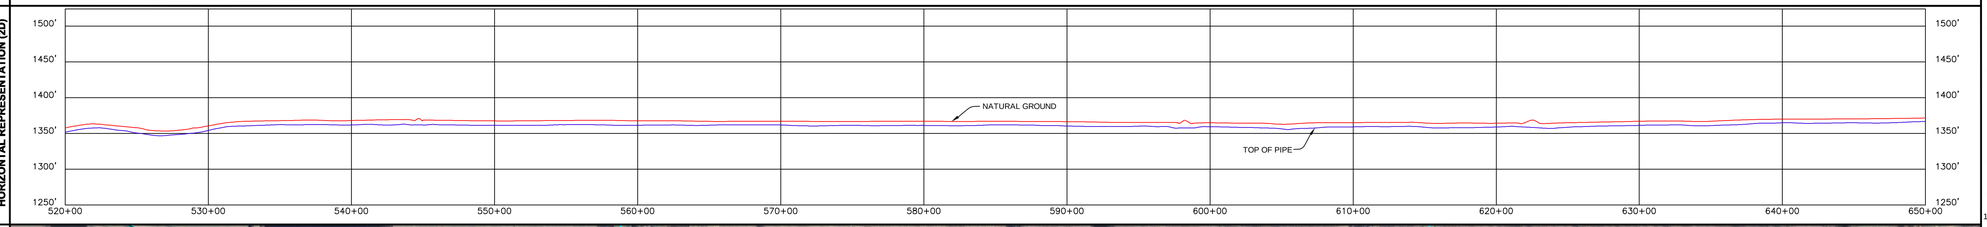

LEGEND

- KEYSTONE PIPELINE
- STATE BOUNDARY
- COUNTY/TOWNSHIP
- SECTIONS
- NATIONAL OR STATE RESERVATION BOUNDARY
- PROPERTY LINE
- FENCE
- EXCLUSIONARY FENCE
- POWER LINE
- TELEPHONE LINE
- BURIED CABLE
- WATER LINE
- SANITARY SEWER LINE
- SD STORM SEWER / DRAIN
- FOREIGN PIPELINE
- RAILROAD
- HIGHWAY / ROAD
- STREAM / DITCH
- WETLAND
- INTERSTATE ROUTE
- U.S. ROUTE
- STATE ROUTE
- POINT OF INTERSECTION (PI)
- MP 95 PIPELINE MILEPOST
- DIRECTION OF FLOW
- HOUSE
- B BUILDING
- WATER WELL
- MAINLINE VALVE
- ML-XX-XX-0000.0000 TRACT NUMBER

PIPELINE PLAN (SCALE 1" = 500')HORIZONTAL REPRESENTATION (2D)

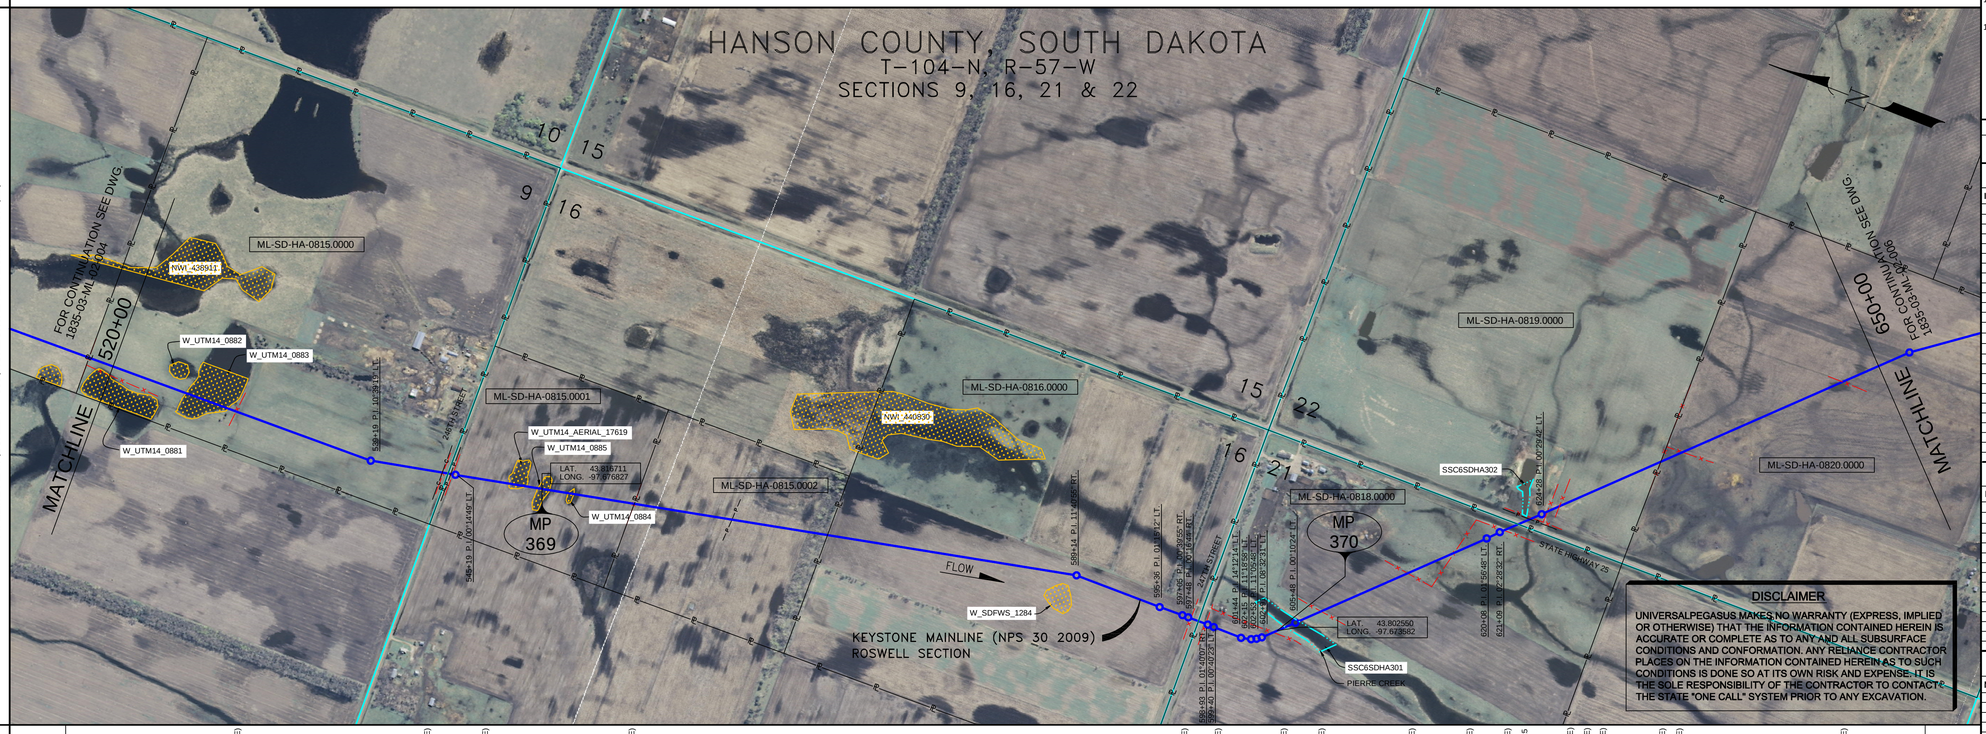

DISCLAIMER

UNIVERSALPEGASUS MAKES NO WARRANTY (EXPRESS, IMPLIED OR OTHERWISE) THAT THE INFORMATION CONTAINED HEREIN IS ACCURATE OR COMPLETE AS TO ANY AND ALL SUBSURFACE CONDITIONS AND CONFORMATION. ANY RELIANCE CONTRACTOR PLACES ON THE INFORMATION CONTAINED HEREIN AS TO SUCH CONDITIONS IS DONE SO AT ITS OWN RISK AND EXPENSE. IT IS THE SOLE RESPONSIBILITY OF THE CONTRACTOR TO CONTACT THE STATE "ONE CALL" SYSTEM PRIOR TO ANY EXCAVATION.

PIPELINE SCHEMATIC

- HEAVYWALL PIPE
- WELD FITTING
- TRANSITION PIECE
- CASING PIPE
- CONCRETE COATING
- (3) SET-ON WEIGHTS
- PIPELINE WARNING SIGN
- PIPELINE MARKER
- 1 MATERIAL ITEM
- GM GROUNDING MAT
- ZINC RIBBON
- ZAM AERIAL MARKER
- CATHODIC TEST STATION
- MAINLINE VALVE
- CHECK VALVE
- O.C. OPEN CUT
- BR. BORE
- D DRINKING WATER USA
- E ECOLOGICAL USA
- H HIGHLY POPULATED AREA
- K OPERATOR (KEYSTONE) DEFINED
- O OTHER POPULATED AREA
- S SOURCE WATER PROTECTION AREA
- W WELLHEAD PROTECTION AREA

HORIZONTAL STATIONS (2D)

MATCHLINE 520+00 | 525+42 TOP BANK | 526+90 CL DRY CREEK | 528+65 TOP BANK | 529+18 FENCE (BARBED WIRE) | 539+19 P.I. 10°39'19" LT. | 544+26 TELEPHONE LINE | 544+59 FENCE (BARBED WIRE) | 544+62 EDGE OF ROAD | 544+67 CL 248TH STREET | 544+74 CL 247TH STREET | 544+86 UNDERGROUND POWERLINE | 544+99 FENCE (BARBED WIRE) | 550+99 P.I. 09°44'45" LT. | 557+85 FENCE (BARBED WIRE) | 564+70 OVERHEAD POWERLINE | 589+14 P.I. 11°40'55" RT. | 595+36 P.I. 01°15'12" LT. | 597+05 P.I. 00°39'55" RT. | 597+48 P.I. 00°16'44" RT. | 597+70 FENCE (BARBED WIRE) | 598+25 CL 247TH STREET | 598+37 EDGE OF ROAD | 598+79 FENCE (BARBED WIRE) | 598+93 P.I. 01°40'07" RT. | 599+46 P.I. 09°58'55" LT. | 601+44 P.I. 14°12'14" LT. | 602+15 P.I. 11°35'58" LT. | 602+55 P.I. 11°35'58" LT. | 602+91 P.I. 08°32'31" LT. | 605+48 P.I. 00°10'24" LT. | 607+42 FENCE (BARBED WIRE) | 614+58 FENCE (BARBED WIRE) | 618+98 FENCE (BARBED WIRE) | 620+06 P.I. 01°56'48" LT. | 621+09 P.I. 02°28'32" RT. | 621+43 FENCE (BARBED WIRE) | 622+72 EDGE OF ROAD | 622+89 CL STATE HIGHWAY 25 | 623+58 EDGE OF ROAD | 623+99 UNDERGROUND POWERLINE | 624+28 FENCE (BARBED WIRE) | 624+68 P.I. 00°29'42" LT. | 625+11 FENCE (BARBED WIRE) | 626+48 FENCE (BARBED WIRE) | 633+37 FENCE (BARBED WIRE) | 633+67 5.7 CVR. | 633+78 FENCE (BARBED WIRE) | 635+00 FENCE (BARBED WIRE) | 635+41 FENCE (BARBED WIRE) | 646+17 5.0' CVR. | 647+56 FENCE (BARBED WIRE) | MATCHLINE 650+00

SLOPE STATIONS (3D)

MATCHLINE 520+36 | 523+12 5.0' CVR. | 525+78 TOP BANK | 527+25 CL DRY CREEK | 529+20 TOP BANK | 529+53 FENCE (BARBED WIRE) | 534+31 5.0' CVR. | 539+55 P.I. 10°39'19" LT. | 540+17 6.2' CVR. | 543+95 6.7' CVR. | 544+62 TELEPHONE LINE | 544+71 FENCE (BARBED WIRE) | 544+96 EDGE OF ROAD | 545+14 CL 248TH STREET | 545+23 UNDERGROUND POWERLINE | 545+36 FENCE (BARBED WIRE) | 550+99 P.I. 09°44'45" LT. | 551+71 M.P. 369 | 552+07 5.0' CVR. | 558+22 FENCE (BARBED WIRE) | 565+08 OVERHEAD POWERLINE, HT. = 37' | 572+30 5.0' CVR. | 584+06 5.0' CVR. | 589+52 P.I. 11°40'55" RT. | 595+75 P.I. 01°15'12" LT. | 597+44 P.I. 00°39'55" RT. | 597+97 P.I. 00°16'44" RT. | 598+08 FENCE (BARBED WIRE) | 598+25 CL 247TH STREET | 598+63 EDGE OF ROAD | 598+93 P.I. 01°40'07" RT. | 599+29 FENCE (BARBED WIRE) | 599+32 P.I. 01°40'07" RT. | 599+46 P.I. 09°58'55" LT. | 601+83 P.I. 14°12'14" LT. | 602+54 P.I. 11°35'58" LT. | 602+91 P.I. 08°32'31" LT. | 603+31 P.I. 08°32'31" LT. | 603+87 FENCE (BARBED WIRE) | 604+17 P.I. 00°10'24" LT. | 605+87 P.I. 00°10'24" LT. | 607+42 FENCE (BARBED WIRE) | 610+28 5.0' CVR. | 614+98 FENCE (BARBED WIRE) | 619+38 FENCE (BARBED WIRE) | 620+48 P.I. 01°56'48" LT. | 621+50 P.I. 02°28'32" RT. | 621+84 FENCE (BARBED WIRE) | 622+72 EDGE OF ROAD | 622+89 CL STATE HIGHWAY 25 | 623+58 EDGE OF ROAD | 623+99 UNDERGROUND POWERLINE | 624+28 FENCE (BARBED WIRE) | 624+68 P.I. 00°29'42" LT. | 625+11 FENCE (BARBED WIRE) | 626+48 FENCE (BARBED WIRE) | 633+67 5.7 CVR. | 633+78 FENCE (BARBED WIRE) | 635+41 FENCE (BARBED WIRE) | 646+97 FENCE (BARBED WIRE) | 647+17 5.0' CVR. | MATCHLINE 650+42

PIPE SLOPE REPRESENTATION (2D)

520+36 | 525+30 | 526+05 (26) | 529+00 | 529+53 | ② 2,429' FBE | 544+05 | ③ 77' FBE & ARO BR. | 545+42 | 558+20 | ② 5,261' FBE | 570+78 | 571+90 | 589+03 | ③ 116' FBE & ARO BR. | 599+19 | 604+19 604+20 (25) | 607+74 609+63 | ② 2,254' FBE | 614+43 | 621+73 | ⑦ 239' FBE BR. | 624+12 | 633+78 | 637+70 | ② 2,630' FBE | 650+42

CPS (3D)

TEST SECTIONS (3D) | TEST SECTION 3B-3 ILTO-027-2010

ENVIRONMENTAL MITIGATION/RECLAMATION STATIONS (2D)

- TOPSOIL SALVAGE METHOD
- STREAMS
- WETLANDS
- TIMING CONSTRAINTS
- **STATIONS**
- MONITORING
- RECLAMATION
- SPECIAL CONSIDERATIONS

GENERAL NOTES

1) ALL CHAINAGES ARE IN FEET UNLESS OTHERWISE SPECIFIED.
2) DATUM ELEVATION AND PROJECTION ARE BASED ON MEAN SEA LEVEL AND NAD 83.
3) FIELD PIPE LOCATING REQUIRED TO DETERMINE PLACEMENT OF PIPELINE WITHIN PERMANENT EASEMENT.
4) UNLESS OTHERWISE NOTED, 48 INCHES MINIMUM COVER EXCEPT 36 INCHES IN AREAS OF CONSOLIDATED ROCK.
5) NO ACTUAL AS-BUILT GROUND SHOTS WERE TAKEN AT THIS LOCATION. THE PROFILE REPRESENTS A PROJECTION FROM SHOTS TAKEN AT 150' TO 250' INTERVALS.
6) THE TYPE OF COATING APPLIED TO THE FIELD WELDS DURING THE ORIGINAL CONSTRUCTION WAS TWO COMPONENT LIQUID EPOXY. THE COATING PRODUCTS USED WERE DENSO 7200 OR SPC SP-2888.
7) THE SUBSTANTIAL CONSTRUCTION COMPLETION DATE, BASED ON CALIPER PIG RUN, WAS OCTOBER 31, 2009 FOR M.P. 343.98 TO 377.31, NOVEMBER 01, 2009 FOR M.P. 377.29 TO 403.97 AND AUGUST 17, 2009 FOR M.P. 403.90 TO 422.96.
8) ORIGINAL IN-SERVICE DATE OF THE KEYSTONE PIPELINE (PHASE 1): JUNE 30, 2010.
9) CPS CALCULATION DATE: MAY 2010.
10) ORION STATION SERIES NUMBER: 1182700.
11) TO DETERMINE THE MILE POST AT A GIVEN LOCATION, ADD THE 3D STATION NUMBER FROM THIS SEGMENT TO STATION NUMBER 18931+49 AND DIVIDE BY 5280.

OPERATING AND TEST PRESSURE

1. THE MAXIMUM OPERATING PRESSURE (MOP) IS 1440 PSIG.
2. THE MINIMUM TEST PRESSURE WAS 1801 PSIG.

BILL OF MATERIALS (3D)

ITEM NO.	DESCRIPTION	QUANTITY
2	30" O.D. X 0.386" W.T., API-5LX-70 W/FBE COATING	12,574'
3	30" O.D. X 0.516" W.T., API-5LX-70 W/FBE COATING & ABRASION RESISTANT OVERCOAT	193'
7	30" O.D. X 0.516" W.T., API-5LX-70 W/FBE COATING	239'
	PIPELINE MARKERS	0 EA
	PIPELINE WARNING SIGNS	14 EA
	CATHODIC TEST STATION	2 EA
	AERIAL MARKER	1 EA

REFERENCE DRAWINGS

REF. NO.	DRAWING NO.	REV. NO.	DRAWING TITLE

REVISIONS

NO.	DATE	REV BY	CHCK BY	APPRD BY	ENV APPRD	DESCRIPTION
1	5/12/08	UEI	RDG	LAG	SEC	ISSUED FOR CONSTRUCTION
2	10/12/14	UEI				ISSUED FOR AS-BUILT
						1835-03-ML-02-005 REPLACES COVERAGE OF IFC DRAWINGS 1835-03-ML-02-007, 1835-03-ML-02-008, 1835-03-ML-02-009

ENGINEERING RECORDS

	INITIAL	DATE		INITIAL	DATE
DRAWN BY	UEI	10/02/22	ENV. APPRD.		
CHECKED BY			APPRD. BY		
			COMPANY APPROVED		

PROFESSIONAL ENGINEER

NAME	STATE	LIC#	REV#	DATE
LOYS ALVIN GRAY, III	SD	CE9004		

SCALE: 0 125 250 500 Feet

TransCanada — In business to deliver

UNIVERSAL PEGASUS INTERNATIONAL

KEYSTONE MAINLINE (NPS 30 2009) ROSWELL SECTION

FIA# 1835 | SPREAD 3B | DISCIPLINE 03

AS-BUILT ALIGNMENT

M.P. 368.41 TO M.P. 370.87

SHEET 5 OF 20 SHEETS

STA. 520+36 TO STA. 650+42

(3D)

DRAWING NO. 1835-03-ML-02-005 REV. 2