




Day County, SD

SCALE:

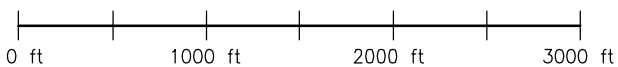

Red Line — Original Keystone Centerline
Yellow Line — Route Variation



TROW ENGINEERING CONSULTANTS INC.

1300 Metropolitan Blvd. Suite 200
Tallahassee, Florida 32308
Phone: 1-850-385-5441
Fax: 1-850-385-5523



TROW PROJ. No.: THES0050388S

DRAWN BY: BS

CHECKED BY: SS

DATE: OCT. 17 08

KEYSTONE PIPELINE PROJECT
ROUTE VARIATION: 410-SD-246.8-248.1-I

DRAWING No.:
SD-410-1

REV.
0